



**EXTERIOR CHAIRS**

460w 525d 855h powder coated metal framed chair in black with teak shaped slats inset and fixed along rear elevation & underside, slot dim 410x60, refer to nuts & bolts SD-200-10.



**SMALL EXTERIOR TABLES**

500w 500d 730h moulded hinge to table top allowing table to fold away for ease of storage, stainless steel table support & base, rubber stoppers to feet, tops pastel grey laminate with black profile, ref. Irespa exterior grade A.03.1.0 refer to nuts & bolts SD-200-12.




**SEATING BALUSTRADES**

1500 wide with logo applied by AEL Leisure Ltd nuts & bolts SD-200-13. Free standing branded canvas balustrades on weighted aluminium posts.

**FURNITURE : TOTAL COVERS = 30 No.**  
 exterior furniture to be brought in to store outside trading hours

	SMALL EXTERIOR TABLES - 15no. refer to adjacent details.		SEATING BALUSTRADES - 07no. refer to adjacent details. 4no with logos applied where shown
	EXTERIOR CHAIRS BLACK - 30no. refer to adjacent details.		

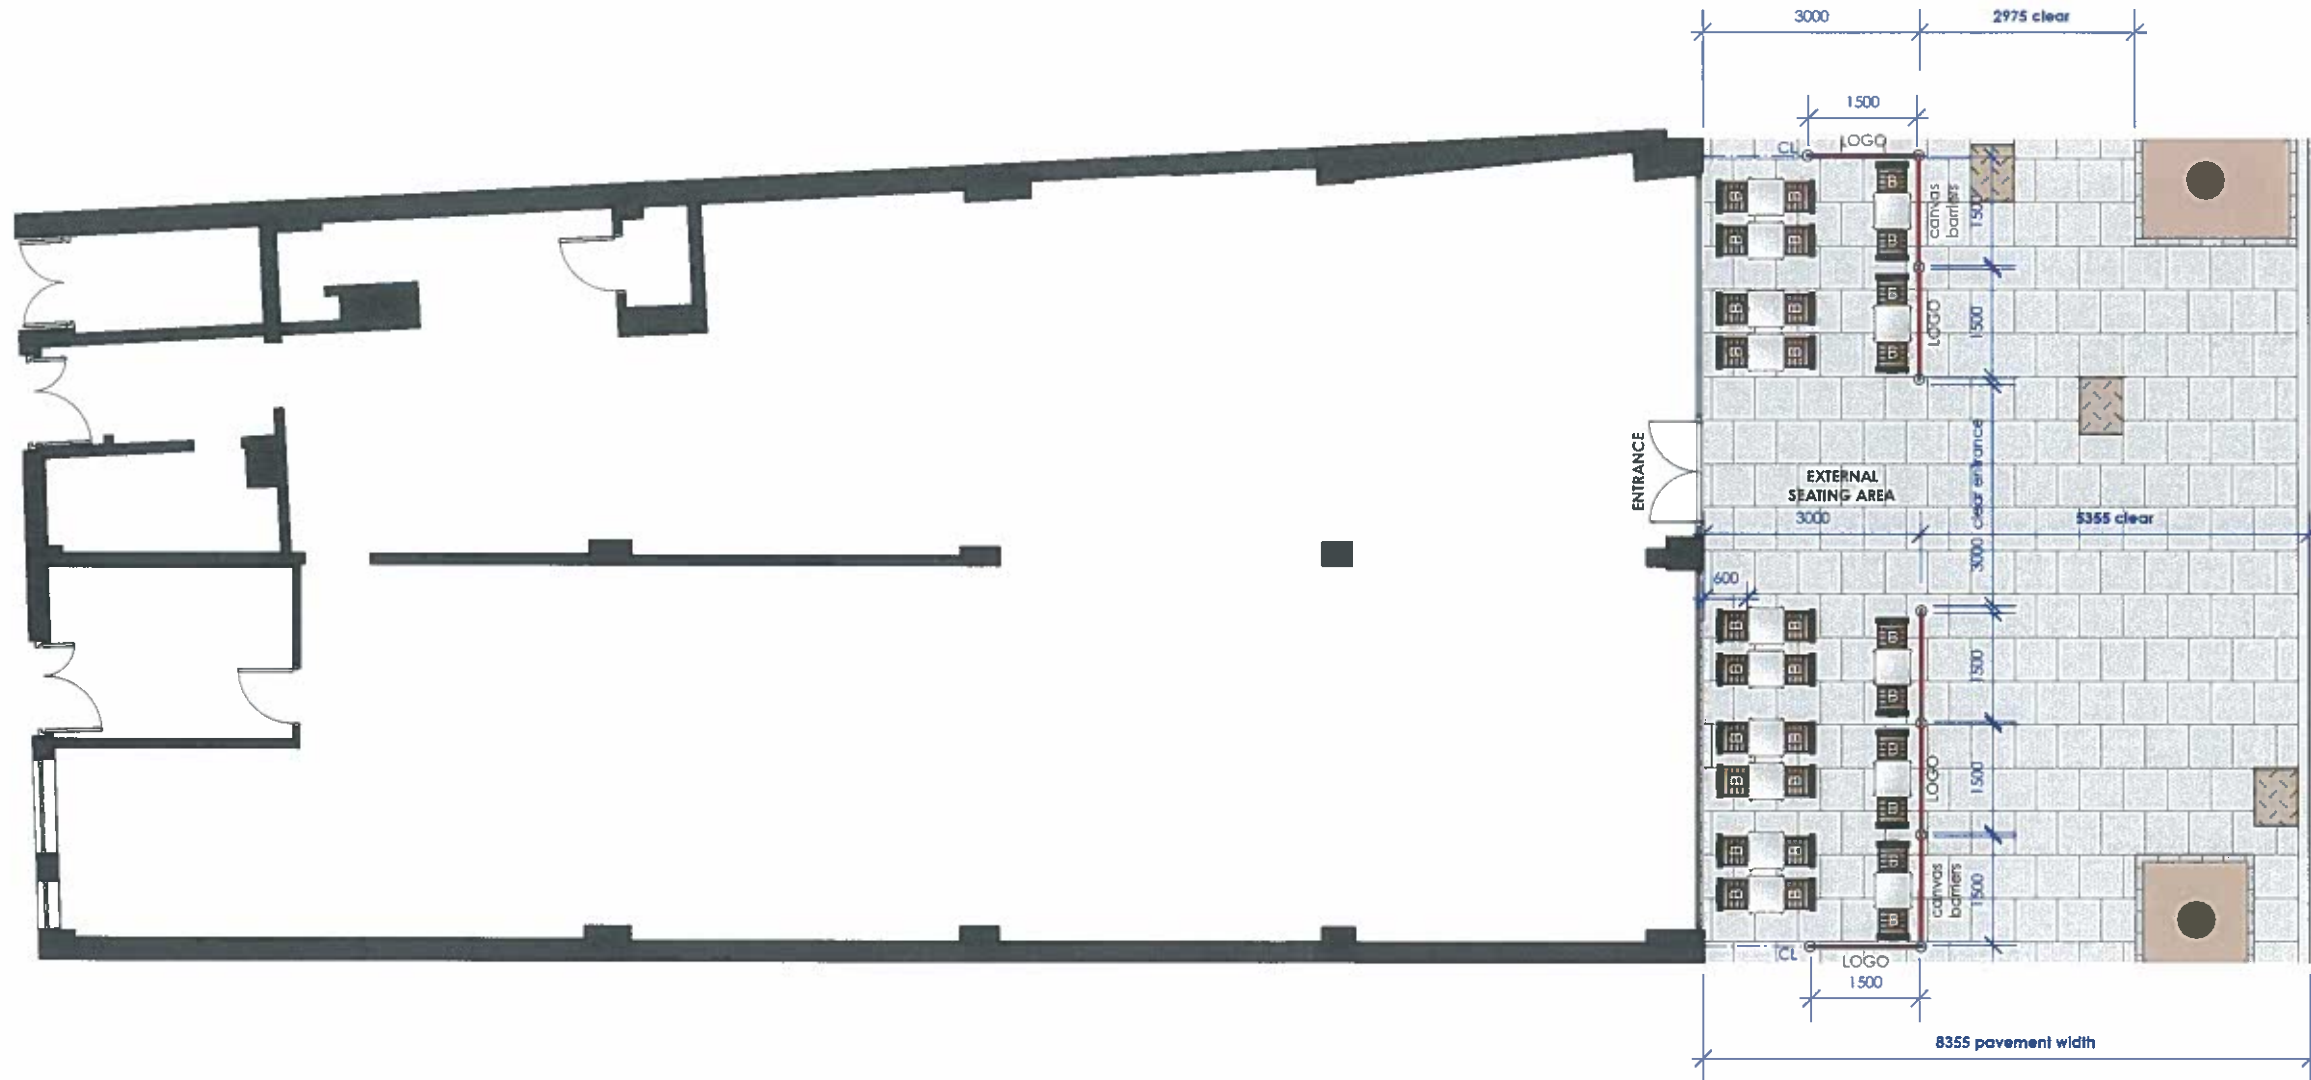

REVISIONS

---

PROJECT  
**★ PRET A MANGER ★**

LOCATION  
 100 Tottenham Court Road  
 LONDON W1T 4TT

TITLE  
 proposed  
 external seating plan

DRAWING No.  
 TD12-PM15-02

REVISION DATE SCALE @ A3  
 AS BUILT 08.05.15 1:100

**TANNERdesign**  
 2b/4b gosport street lynton hampshire SO41 9BE  
 TEL 01590 689609 EMAIL studio@tannerdesign.co.uk

please do not scale from this drawing  
 all dimensions to be confirmed on site by contractor  
 all elements to comply with statutory requirements  
 copyright TANNERdesign limited