

REVISIONS

Rev. Date By



ALL BRICK WORKS TO MATCH EXISTING.
ALL METAL GATE & RAILINGS MADE OF
BLACK CAST IRON

77K Ltd
Design Development

Town Planners
and
Architects

77K Limited
151 Askew Road
LONDON W12 8JU
Mobile: 07977 152 698


Client
77K Limited
Property Development
151 Askew Road
LONDON W12 9AU

Project Title
366 Finchy Road
London NW3 7AU


Drawing Title
(As built)
Ground Floor &
Rear Garden Plans

Scale 1:100 Date 05/04/2016
Drawn ZN Checked DL
Drawing No. T212/EX-001 Rev. -

CAD plot date:

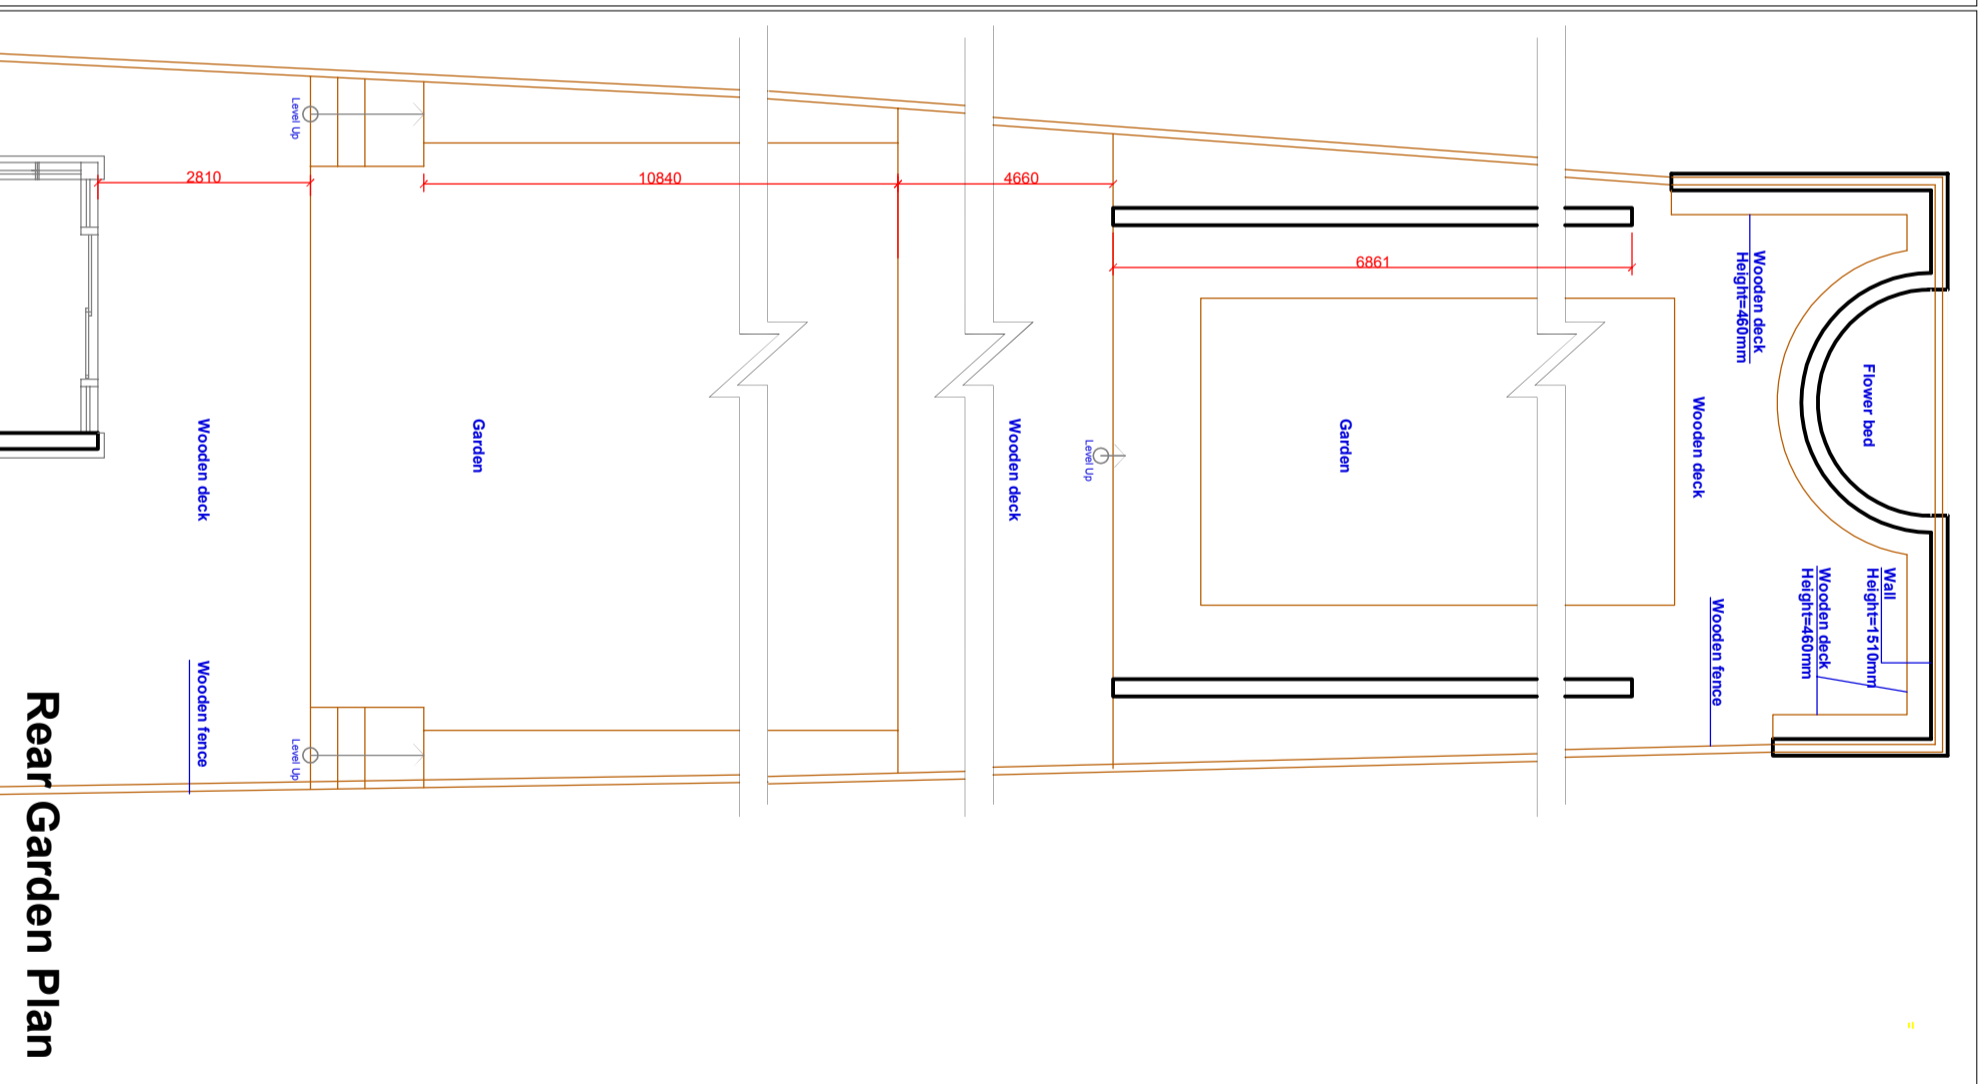

Rear Garden Plan

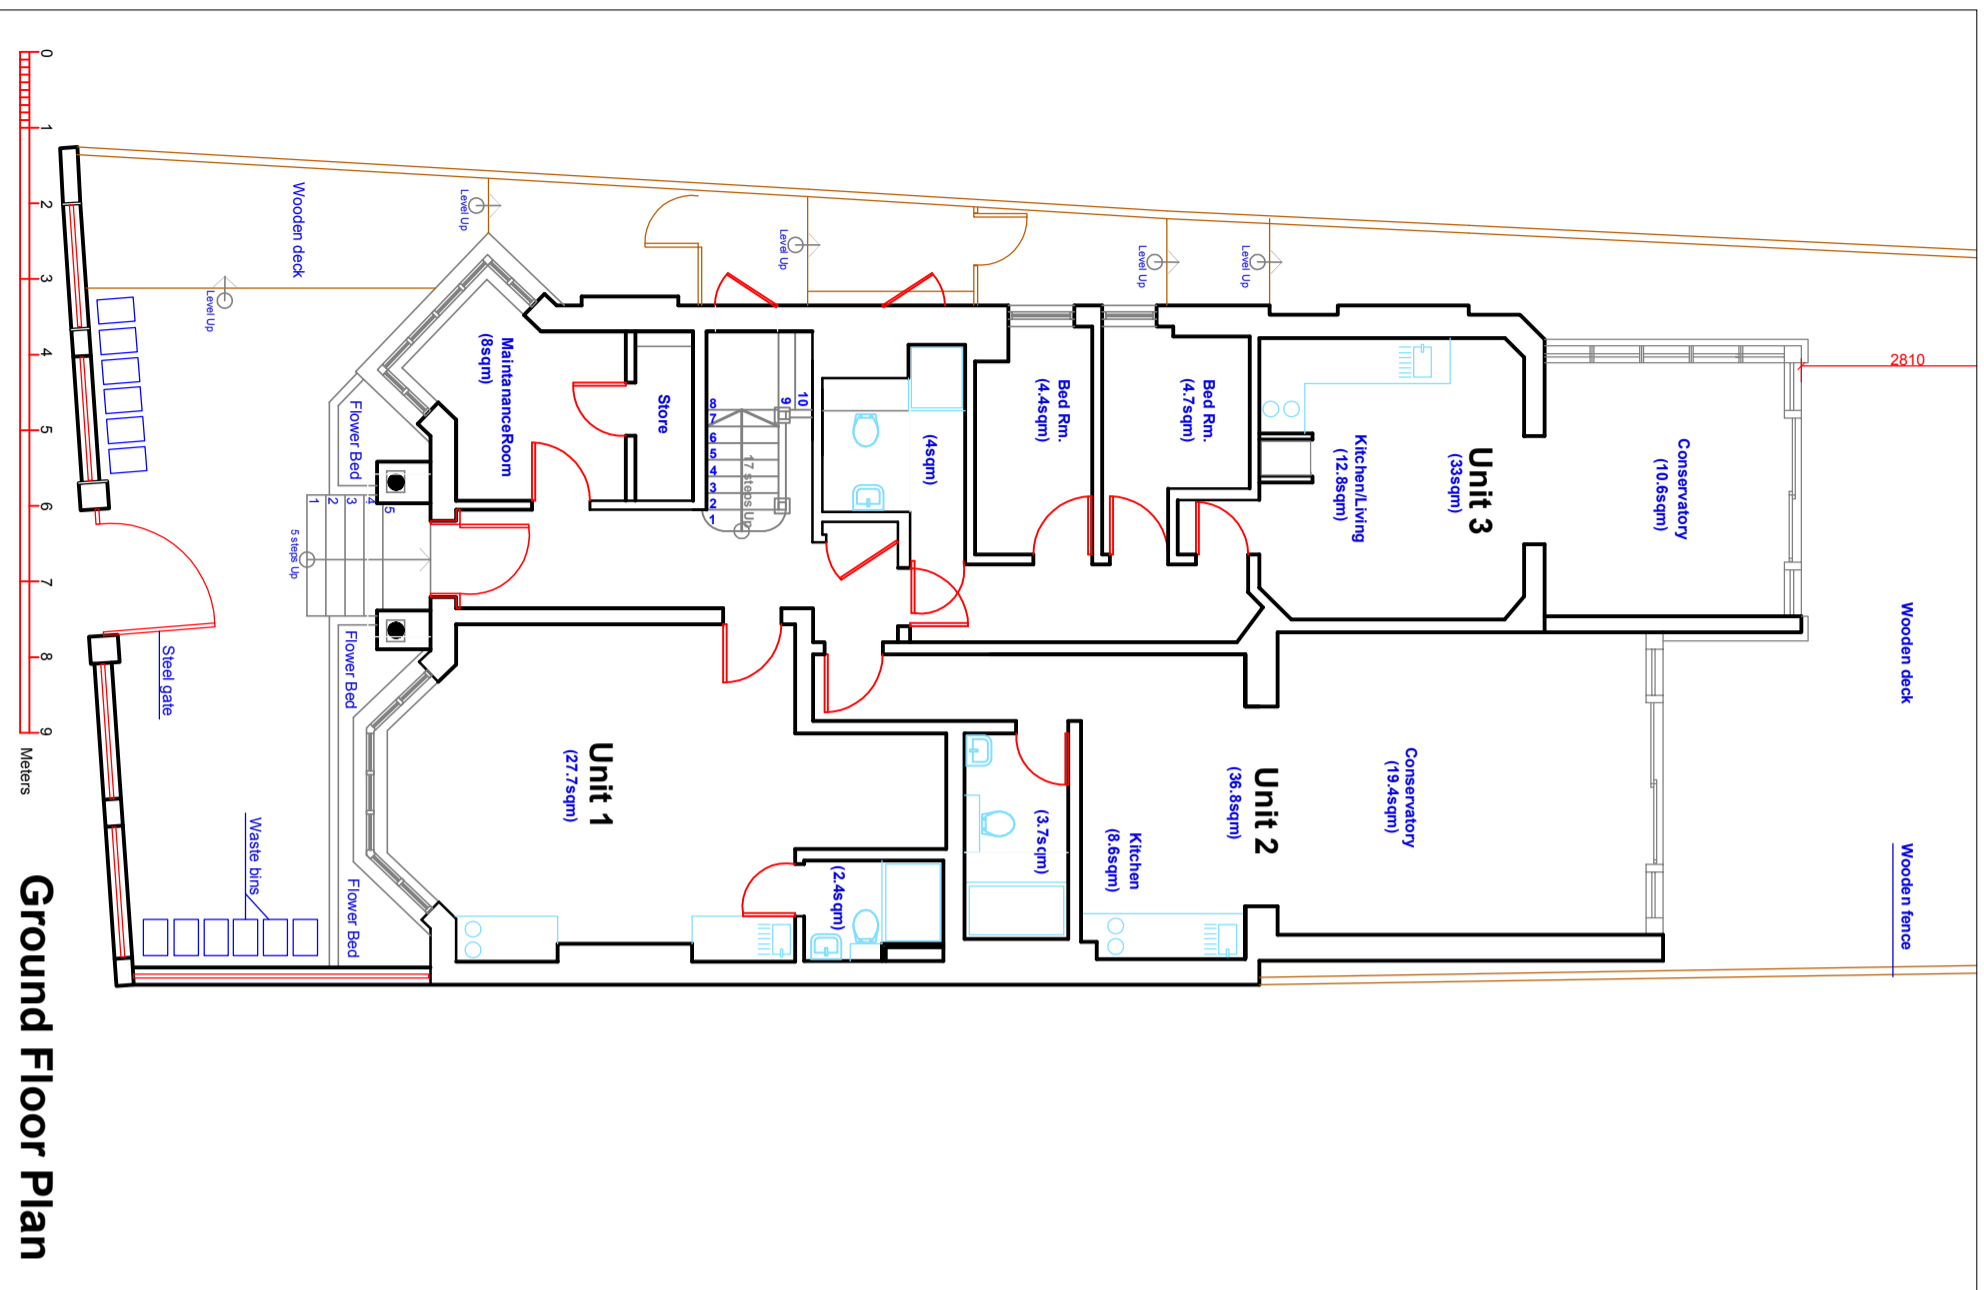

Ground Floor Plan

As Built Ground Floor and Rear Garden Plans SCALE 1:100