

REVISIONS

Rev. By Date



ALL BRICK WORKS TO MATCH EXISTING.
ALL METAL GATE & RAILINGS MADE OF
BLACK CAST IRON

77K Ltd
Design Development

Town Planners
and
Architects


77K Limited
151 Askew Road
LONDON W12 9AU
Mobile: 07977 152 888

Client
77K Limited
Property Development
151 Askew Road
LONDON W12 9AU



Project Title
366 Finchley Road
London NW3 7AU

Drawing Title
(As built)
First Floor&second floor plans

Scale 1: 100 Date 05/04/2016
Drawn ZIN Checked DL Rev.
Drawing No. T212/EX-002
CAD plot date: -

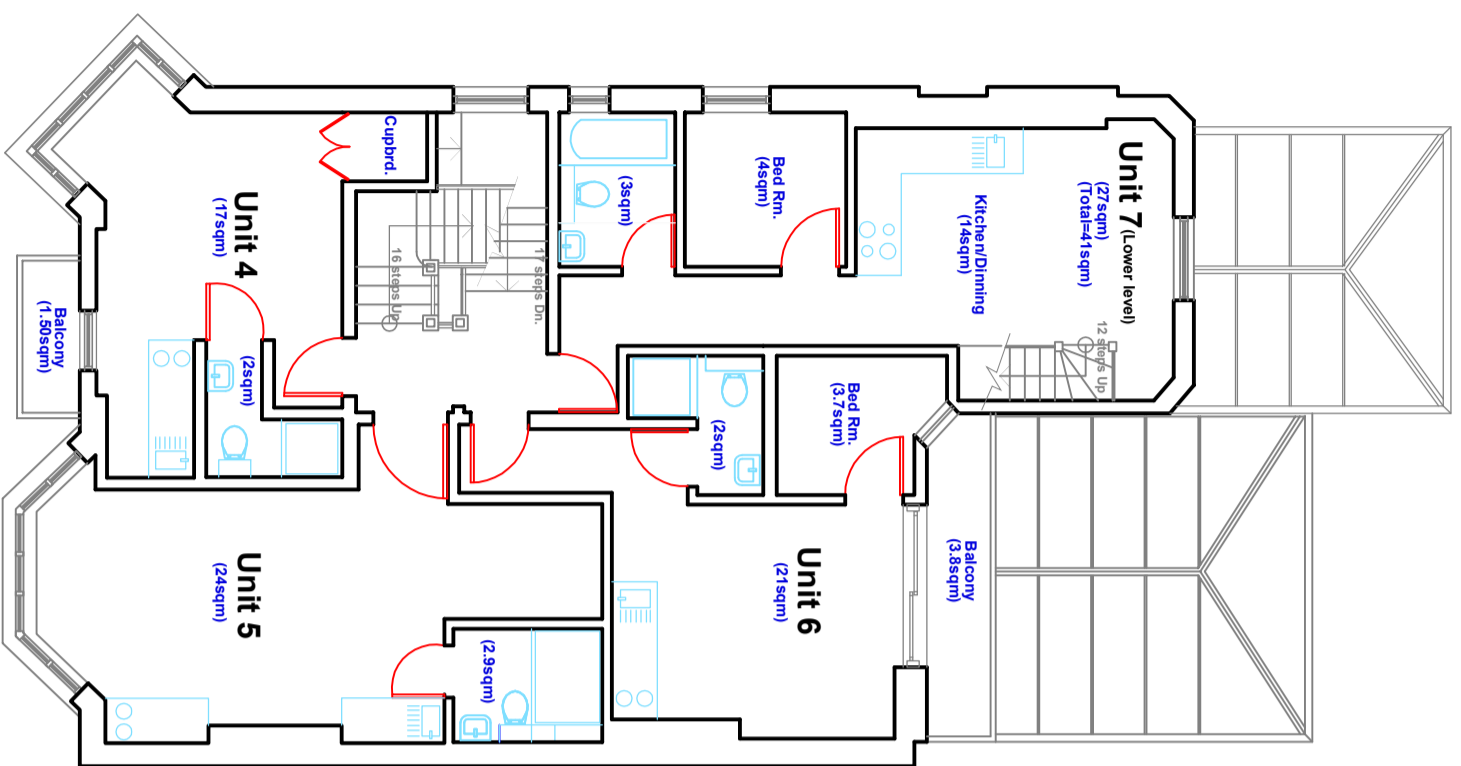

First Floor Plan

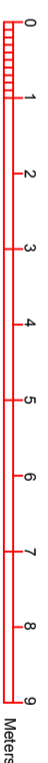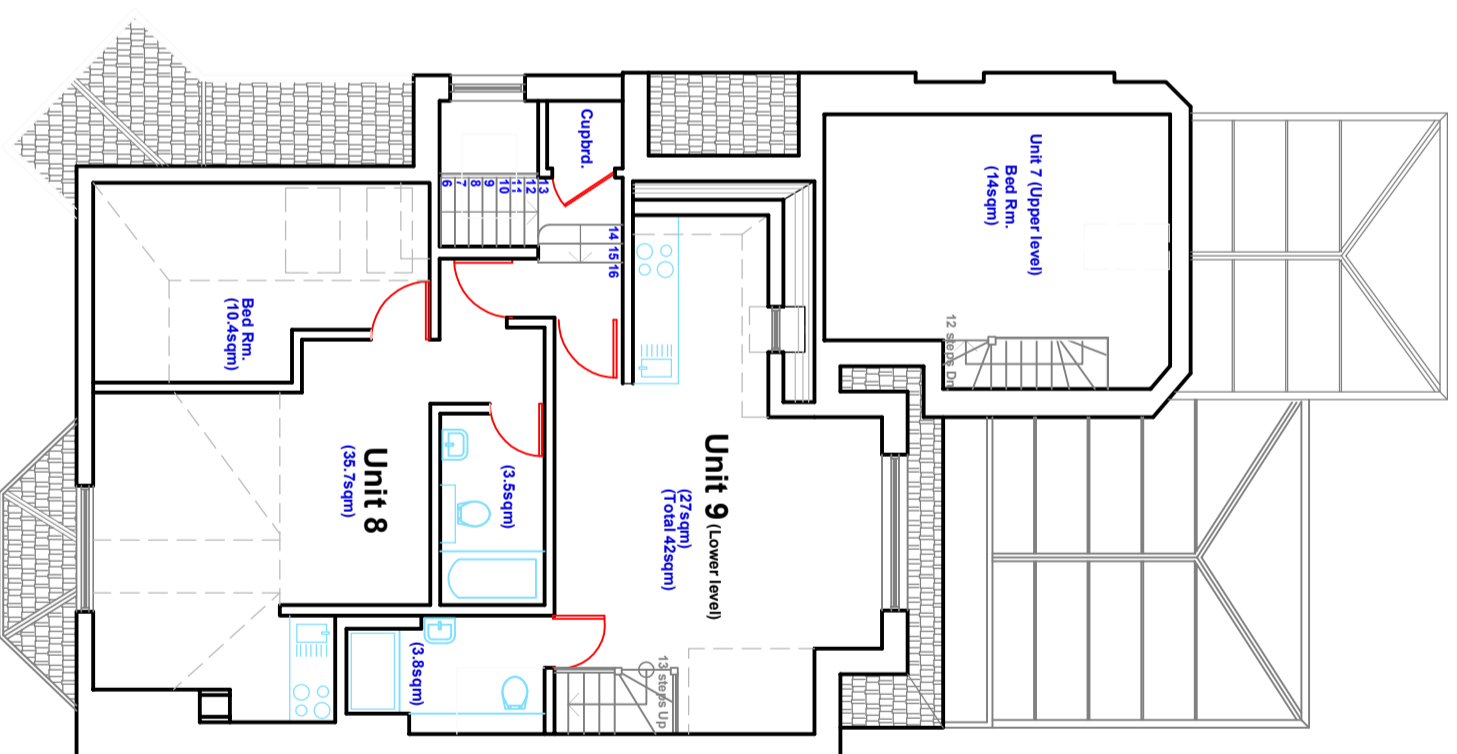

Second Floor Plan

As Built First Floor & Second Floor Plans 1:100