

REVISIONS

Rev. Date



ALL BRICKWORKS TO MATCH EXISTING.
ALL METAL GATE & RAILINGS MADE OF
BLACK CAST IRON

77K Ltd
Design Development

Town Planners
and
Architects

77K Limited
151 Askew Road
LONDON W12 9AU
Mobile: 07977 152 888


Client
77K Limited
Property Development
151 Askew Road
LONDON W12 9AU

Project Title
366 Finchley Road
London NW3 7AU


Drawing Title
(As built)
Loft and Roof plans

Scale 1:100 Date 05/04/2016
Drawn ZIN Checked DL
Drawing No. Rev.
T212/EX-003 -

CAD plot date:

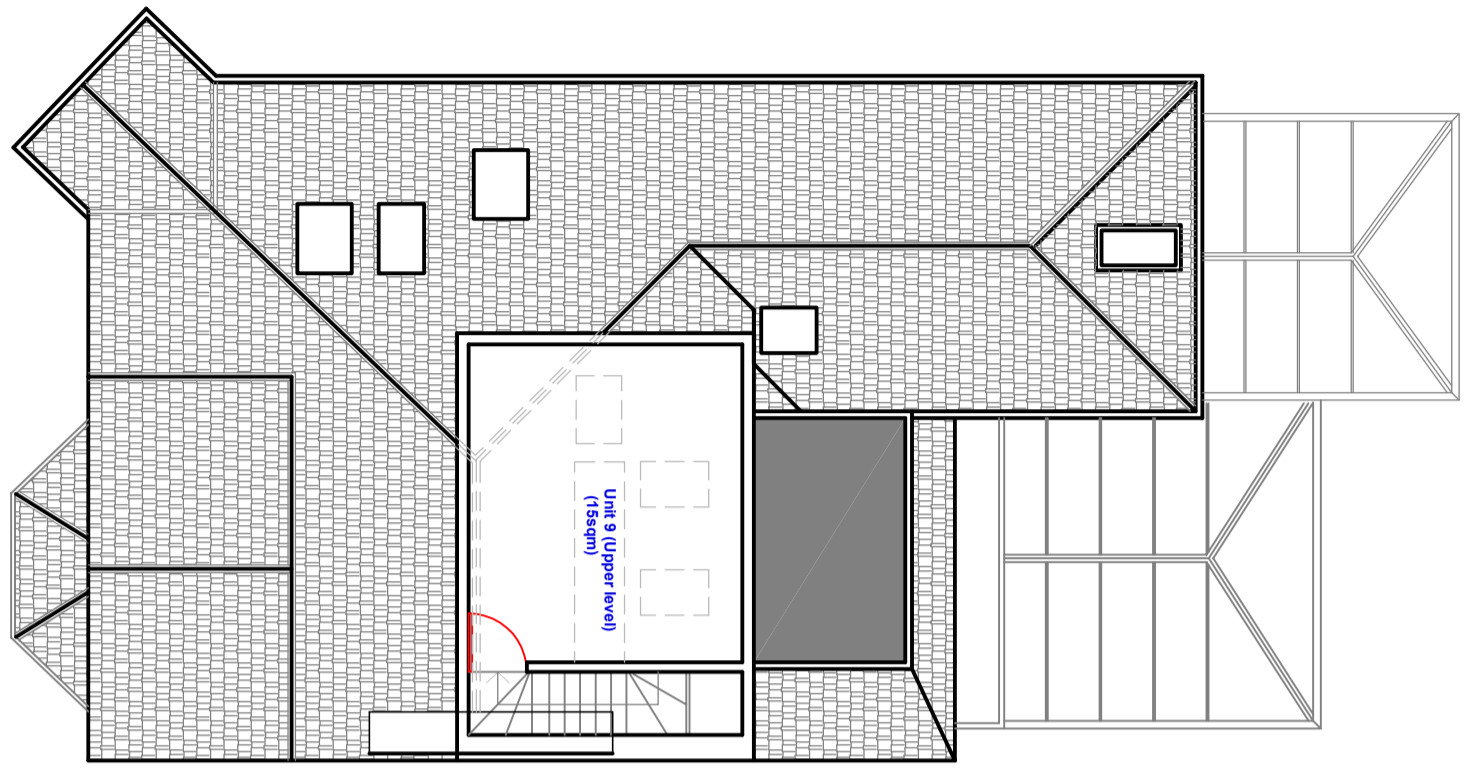

Loft Plan

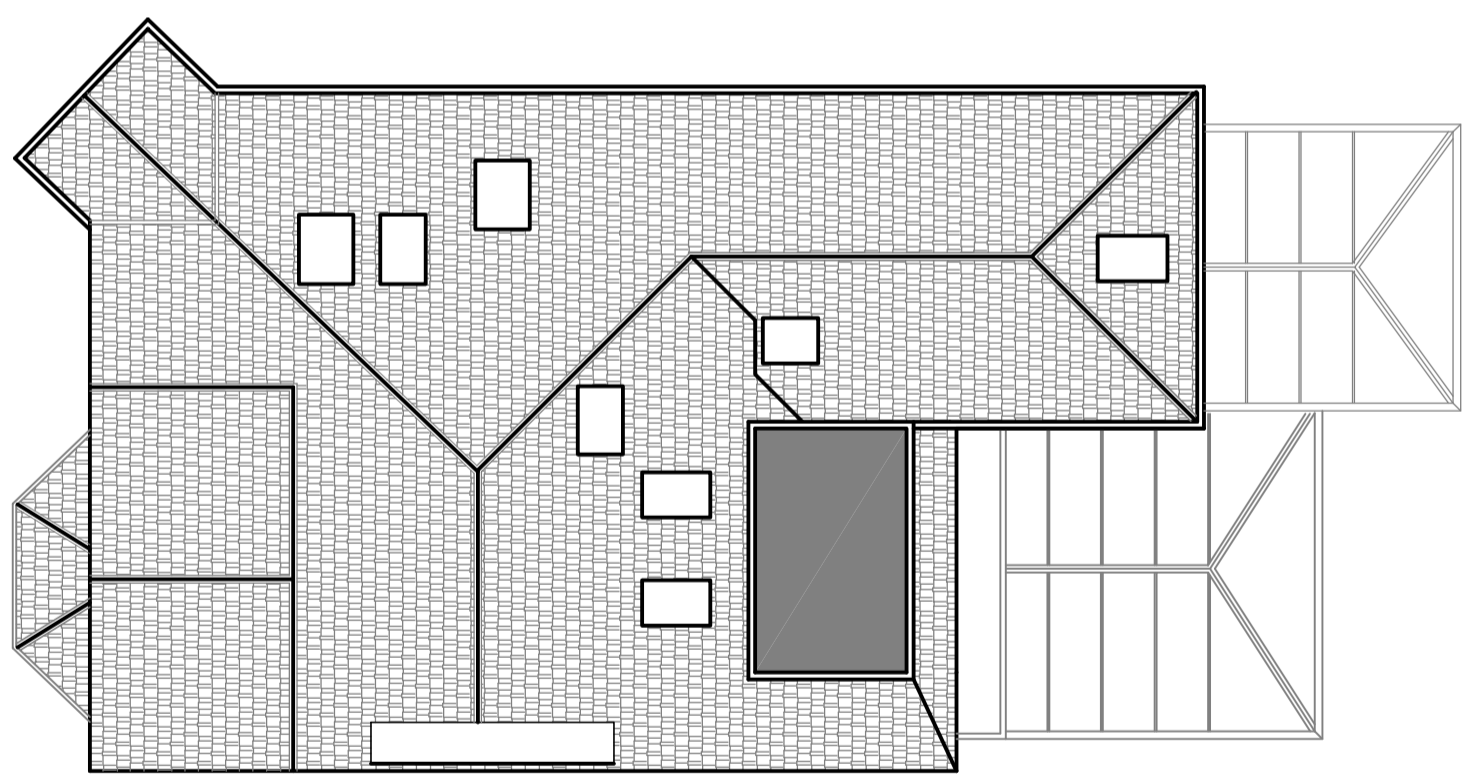

Roof Plan

As Built Loft & Roof Plans 1:100