

REVISIONS

Rev. Date By

----- = =

ALL BRICK WORKS TO MATCH EXISTING.
ALL METAL GATE & RAILINGS MADE OF
BLACK CAST IRON

77K Ltd
Design Development

Town Planners
and
Architects

77K Limited
151 Aislew Road
LONDON W12 9AU
Mobile: 07977 152 888

Client

77K Limited
Property Development
151 Aislew Road
LONDON W12 9AU

Project Title

366 Finchy Road
London NW3 7AU

Drawing Title


As built Elevations
Front, Side & Rear elevations

Scale 1:100 Date 05/04/2016

Drawn ZN Checked DL Rev. --


Drawing No. T212/EX-021

CAD plot date: --

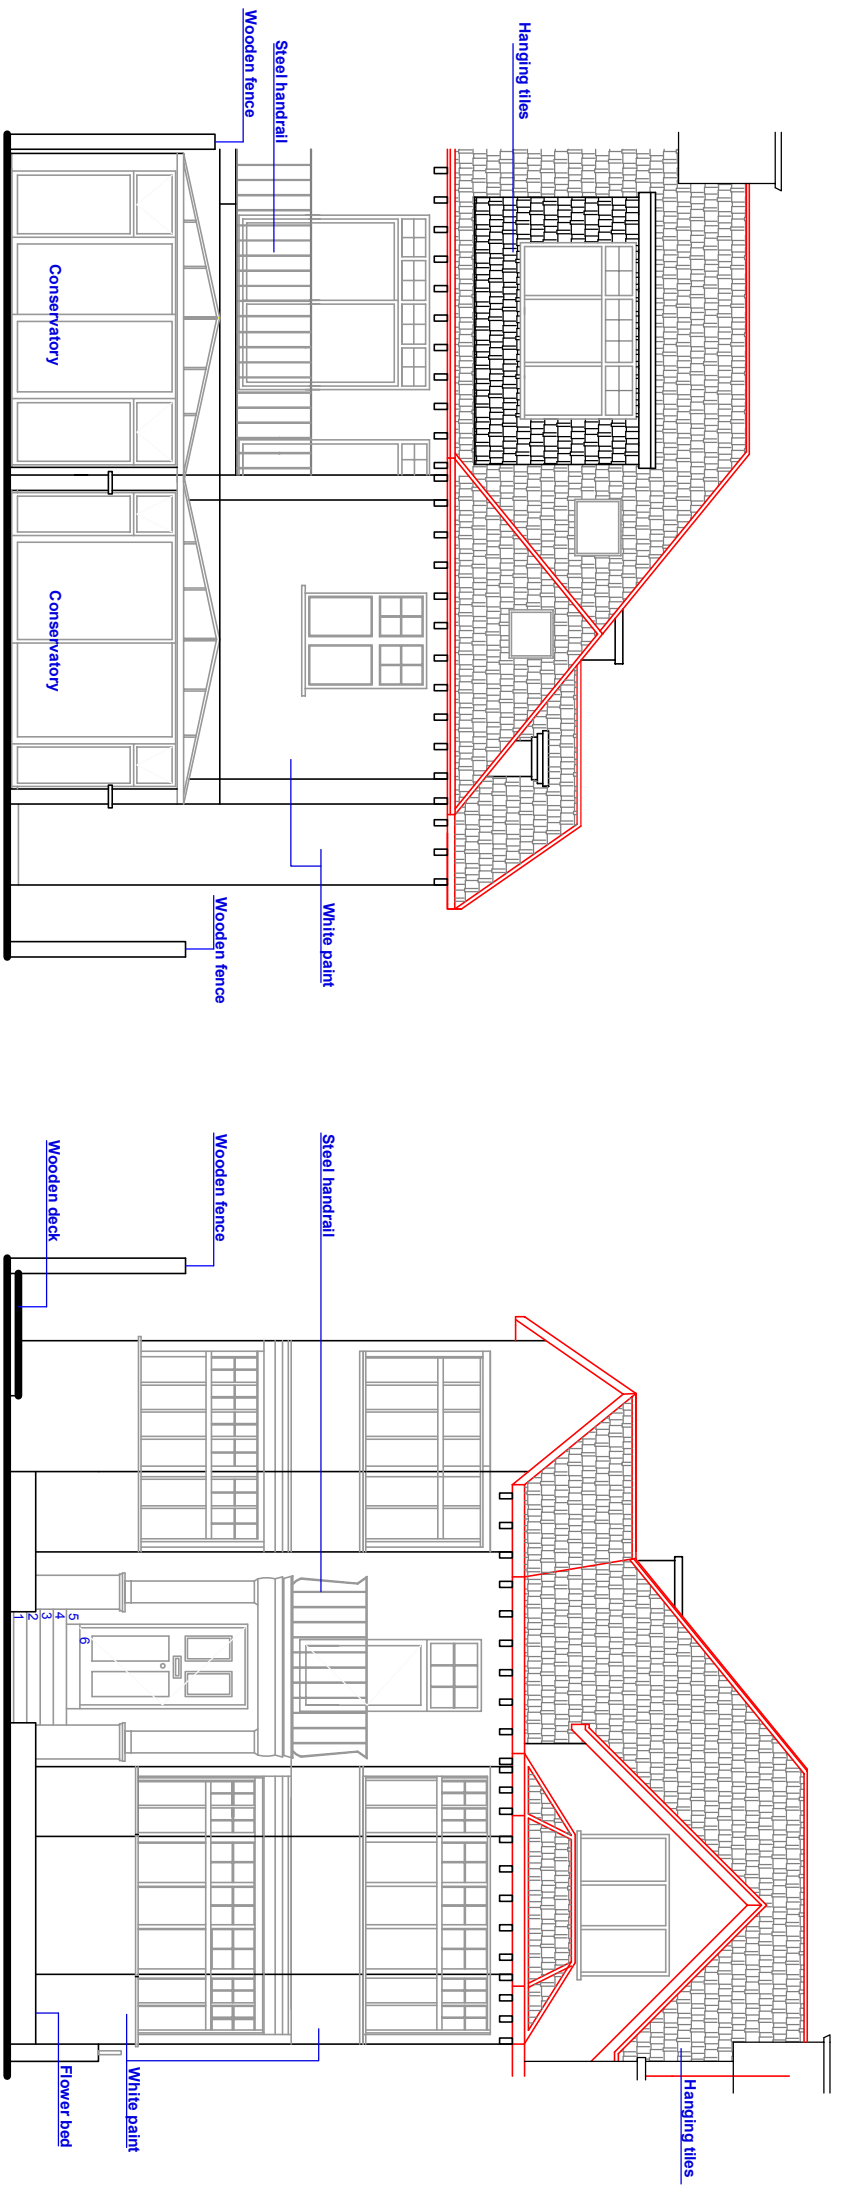

Rear Elevation-As Built

Front Elevation-As Built

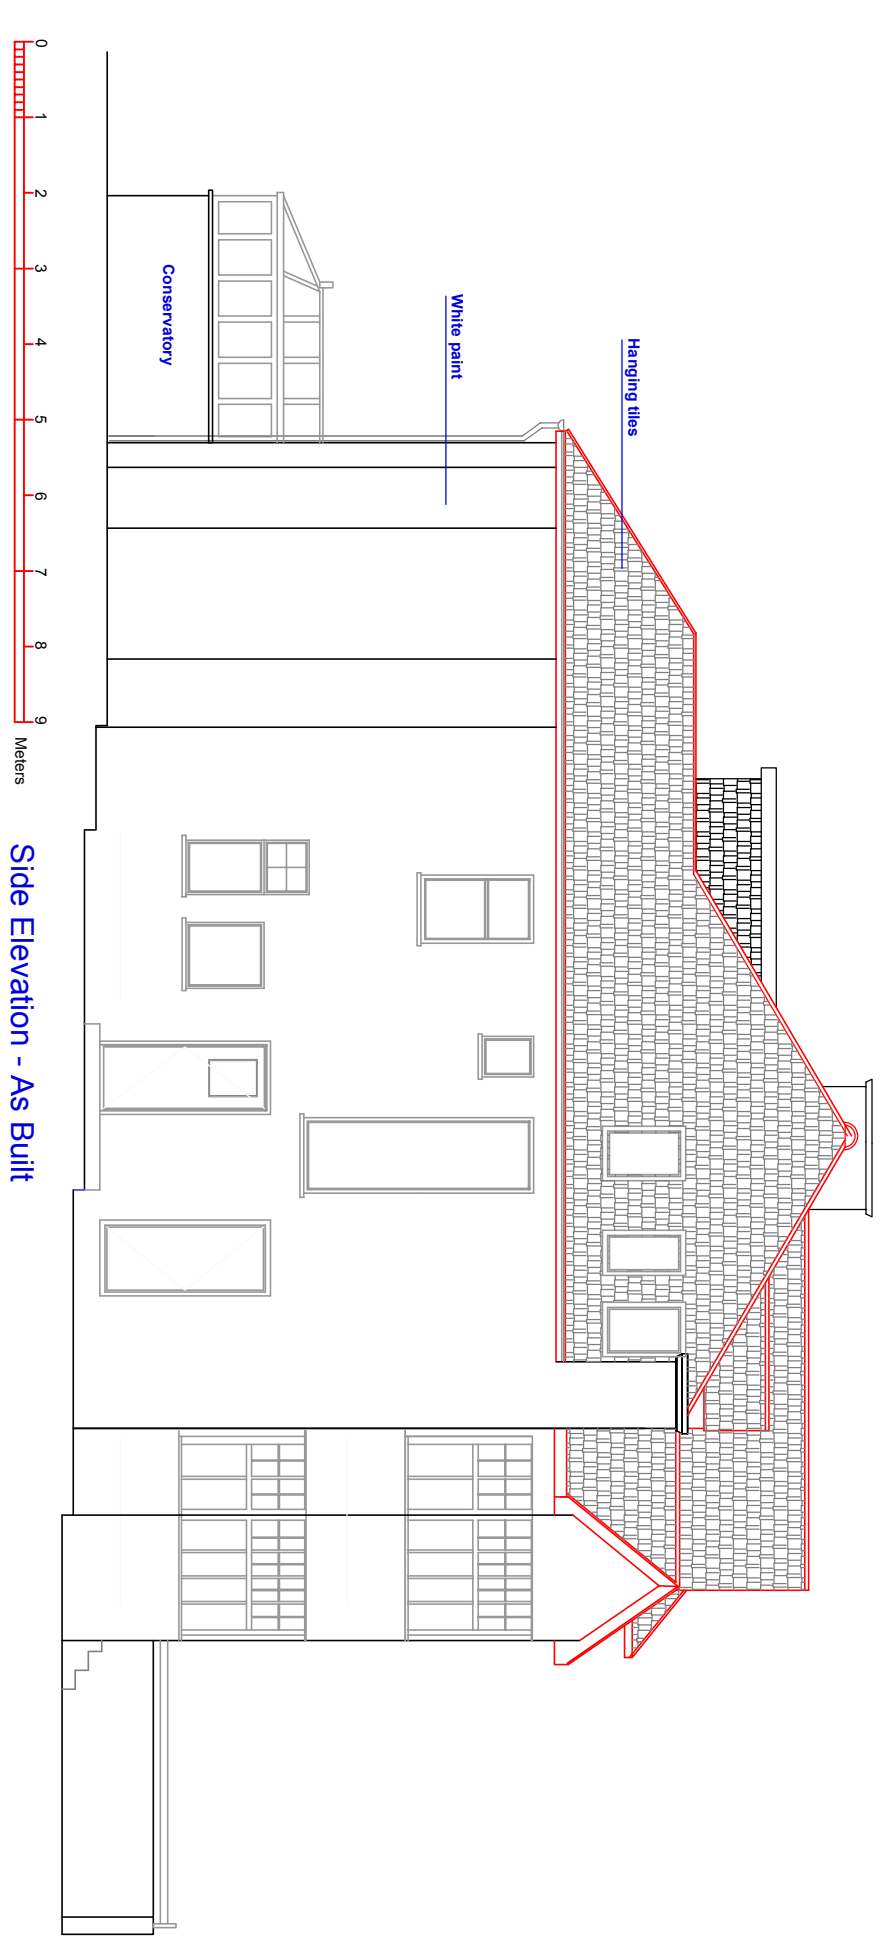

Side Elevation - As Built

As Built Front, Side and Rear Elevations SCALE 1:100