



AS APPROVED FIRST FLOOR PLAN 1:50

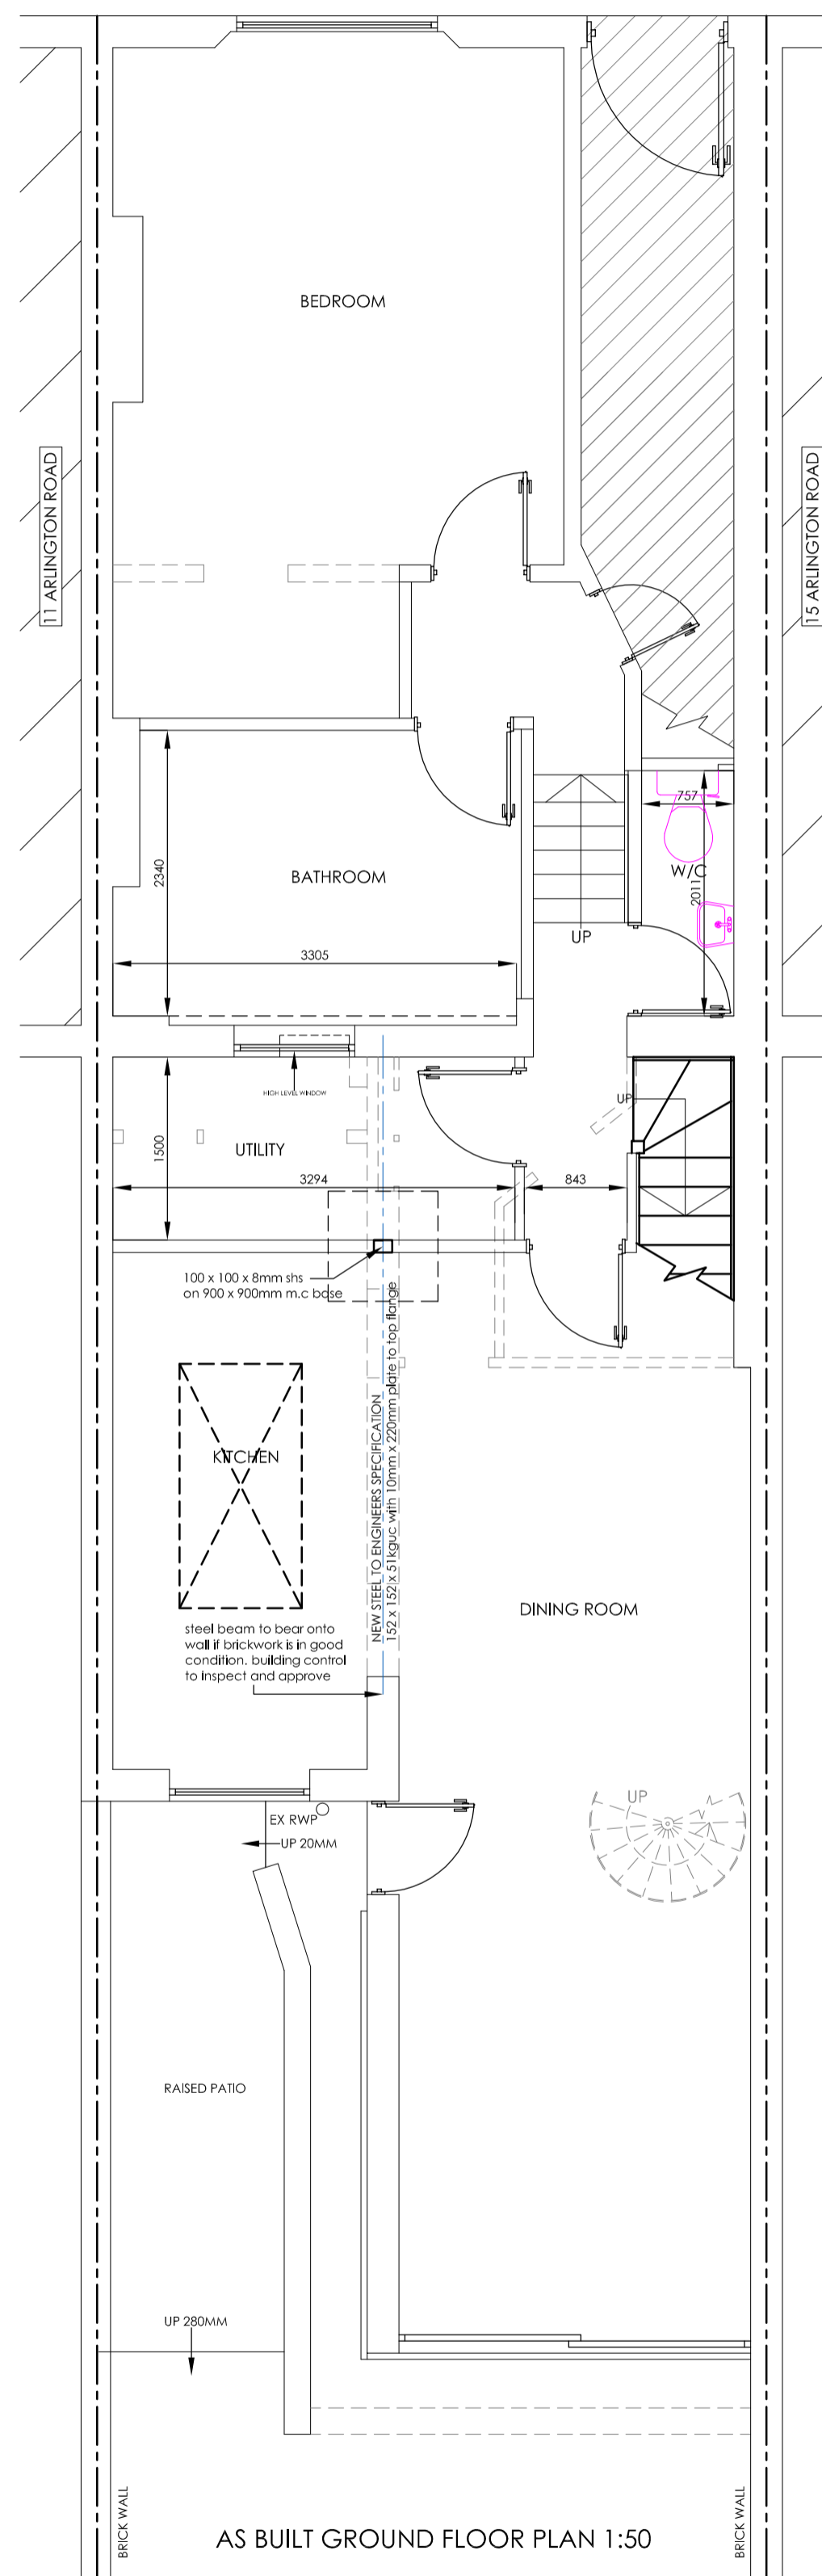

AS BUILT GROUND FLOOR PLAN 1:50

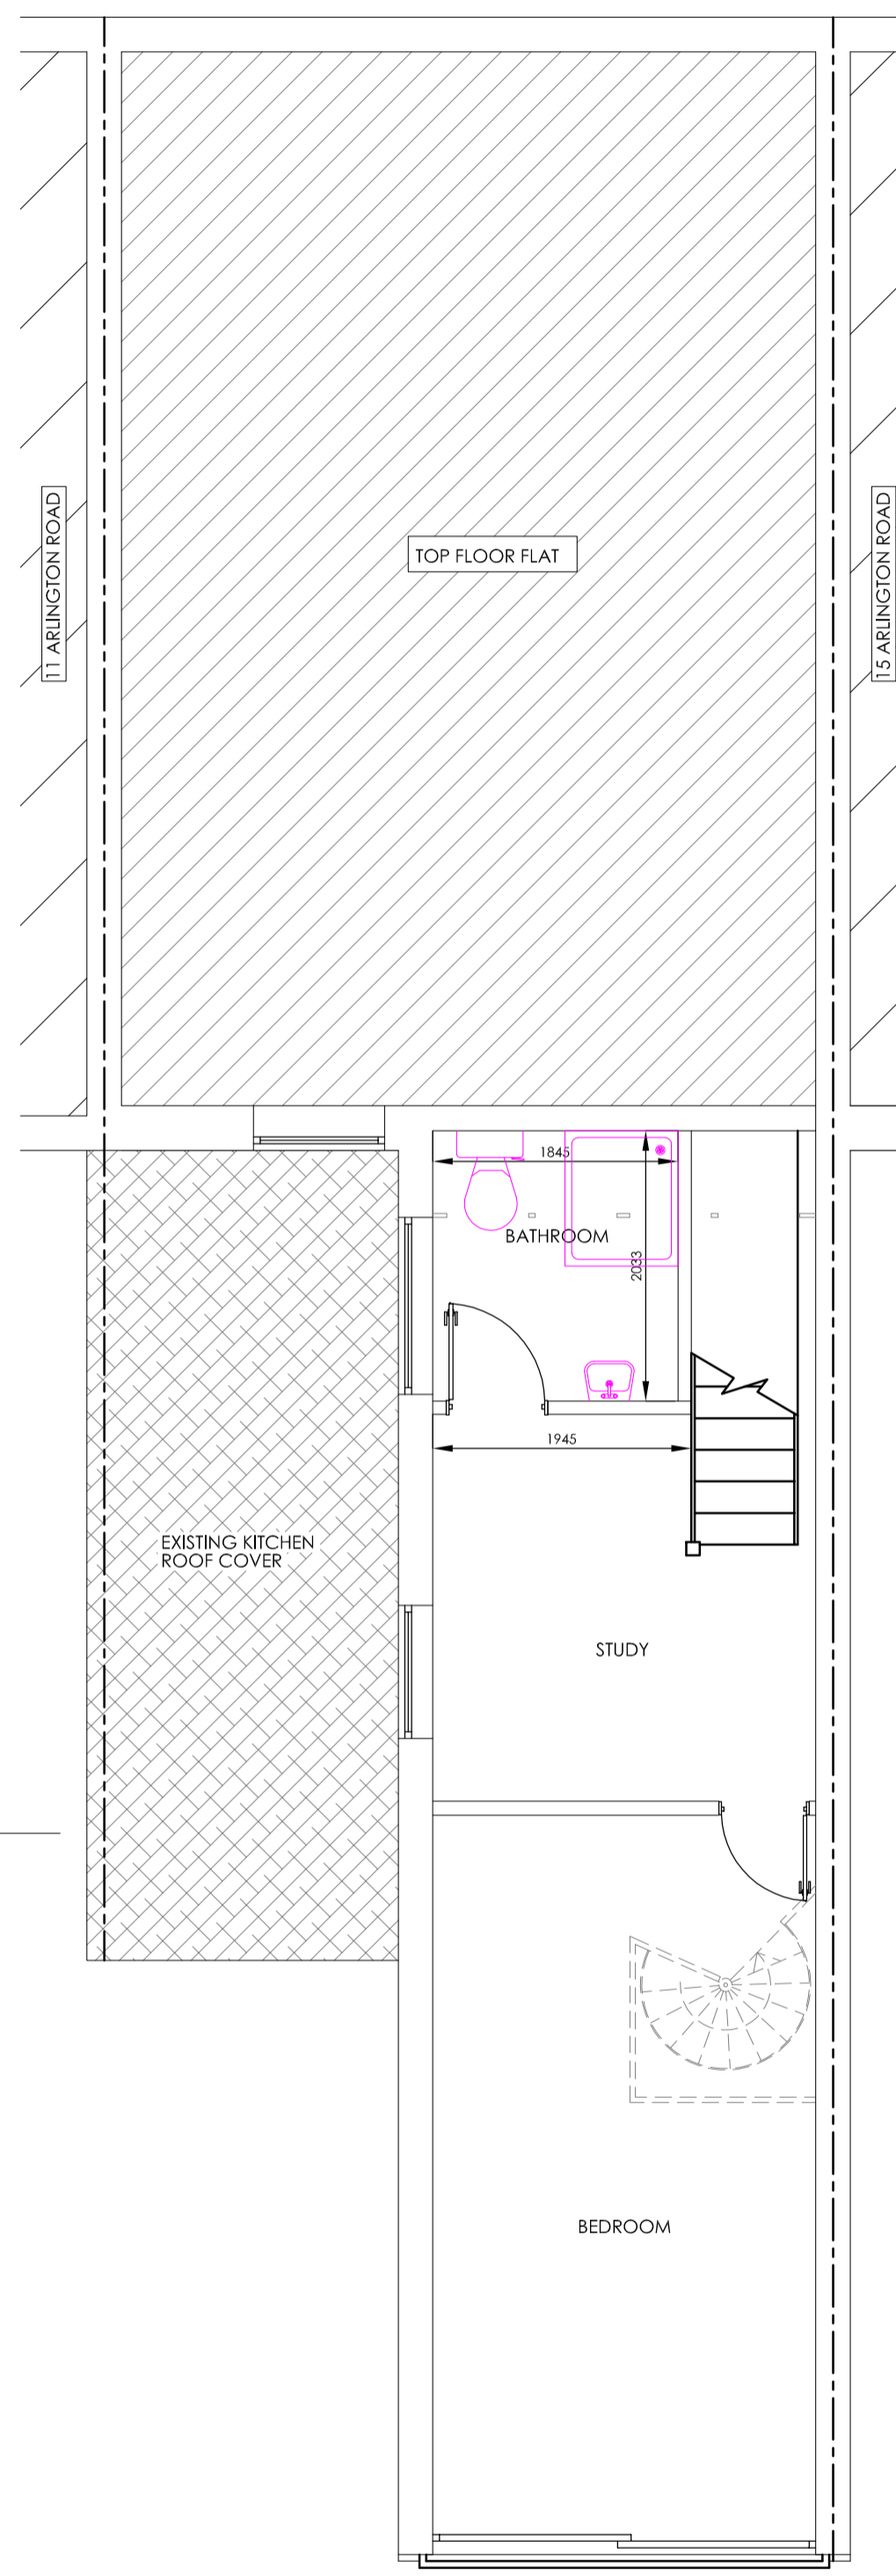

AS BUILT FIRST FLOOR PLAN 1:50

- KITCHEN EXTENSIONS
- LOFT CONVERSIONS
- REFURBISHMENTS

REVISION:  
 REV. A - 12/10/14 - CLIENT AMENDMENTS  
 REV. B - 20/11/14 - ADDITIONAL PLANNING DETAILS  
 REV. C - 04/03/15 - CLIENT ALTERATIONS  
 REV. D - 14/04/14 - STRUCTURAL DETAILS ADDED

DRAWING: EXISTING/PROPOSED FLOOR PLANS	
DATE: AUG 14	PROJECT: PROPOSED SINGLE STOREY REAR EXTENSION
SCALE @ A1: 1:50	CLIENT: MR J. BAKER
DRAWING No. P16-31.1	CLIENT ADDRESS: 13 ARLINGTON ROAD LONDON NW1 7ER

ALL DIMENSIONS TO BE CHECKED ON SITE PRIOR TO COMMENCEMENT AND SCALE FROM DRAWING.  
 AND TO BE CHECKED AGAINST THE PLANNING PERMISSIONS AND BUILDING CONTROL APPROVALS.  
 AND BUILDING CONTROL APPROVALS PRIOR TO ANY WORK BEING COMMENCED.  
 THE DRAWING IS TO BE USED AS A GUIDE ONLY AND IS NOT TO BE USED AS A BASIS FOR ANY OTHER WORK.  
 AND SHOULD BE USED IN CONJUNCTION WITH THE PLANNING PERMISSIONS AND BUILDING CONTROL APPROVALS.  
 AND SHOULD BE USED IN CONJUNCTION WITH THE PLANNING PERMISSIONS AND BUILDING CONTROL APPROVALS.  
 AND SHOULD BE USED IN CONJUNCTION WITH THE PLANNING PERMISSIONS AND BUILDING CONTROL APPROVALS.  
 AND SHOULD BE USED IN CONJUNCTION WITH THE PLANNING PERMISSIONS AND BUILDING CONTROL APPROVALS.

