

A

B


C

D

E

AS BUILT

DRAWINGS INDICATE DESIGN INTENT ONLY.
 ALL DIMENSIONS IN MILLIMETERS UNLESS NOTED OTHERWISE.
 THE CONTRACTOR IS RESPONSIBLE FOR TAKING AND CHECKING ALL DIMENSIONS.
 DO NOT SCALE FROM THE DRAWING.
 REPORT ALL CONFLICTS OF INFORMATION TO ORIGINATE AND SEEK ADVICE BEFORE PROCEEDING.
 THIS DRAWING IS THE COPYRIGHT OF ORIGINATE ARCHITECTS LTD.

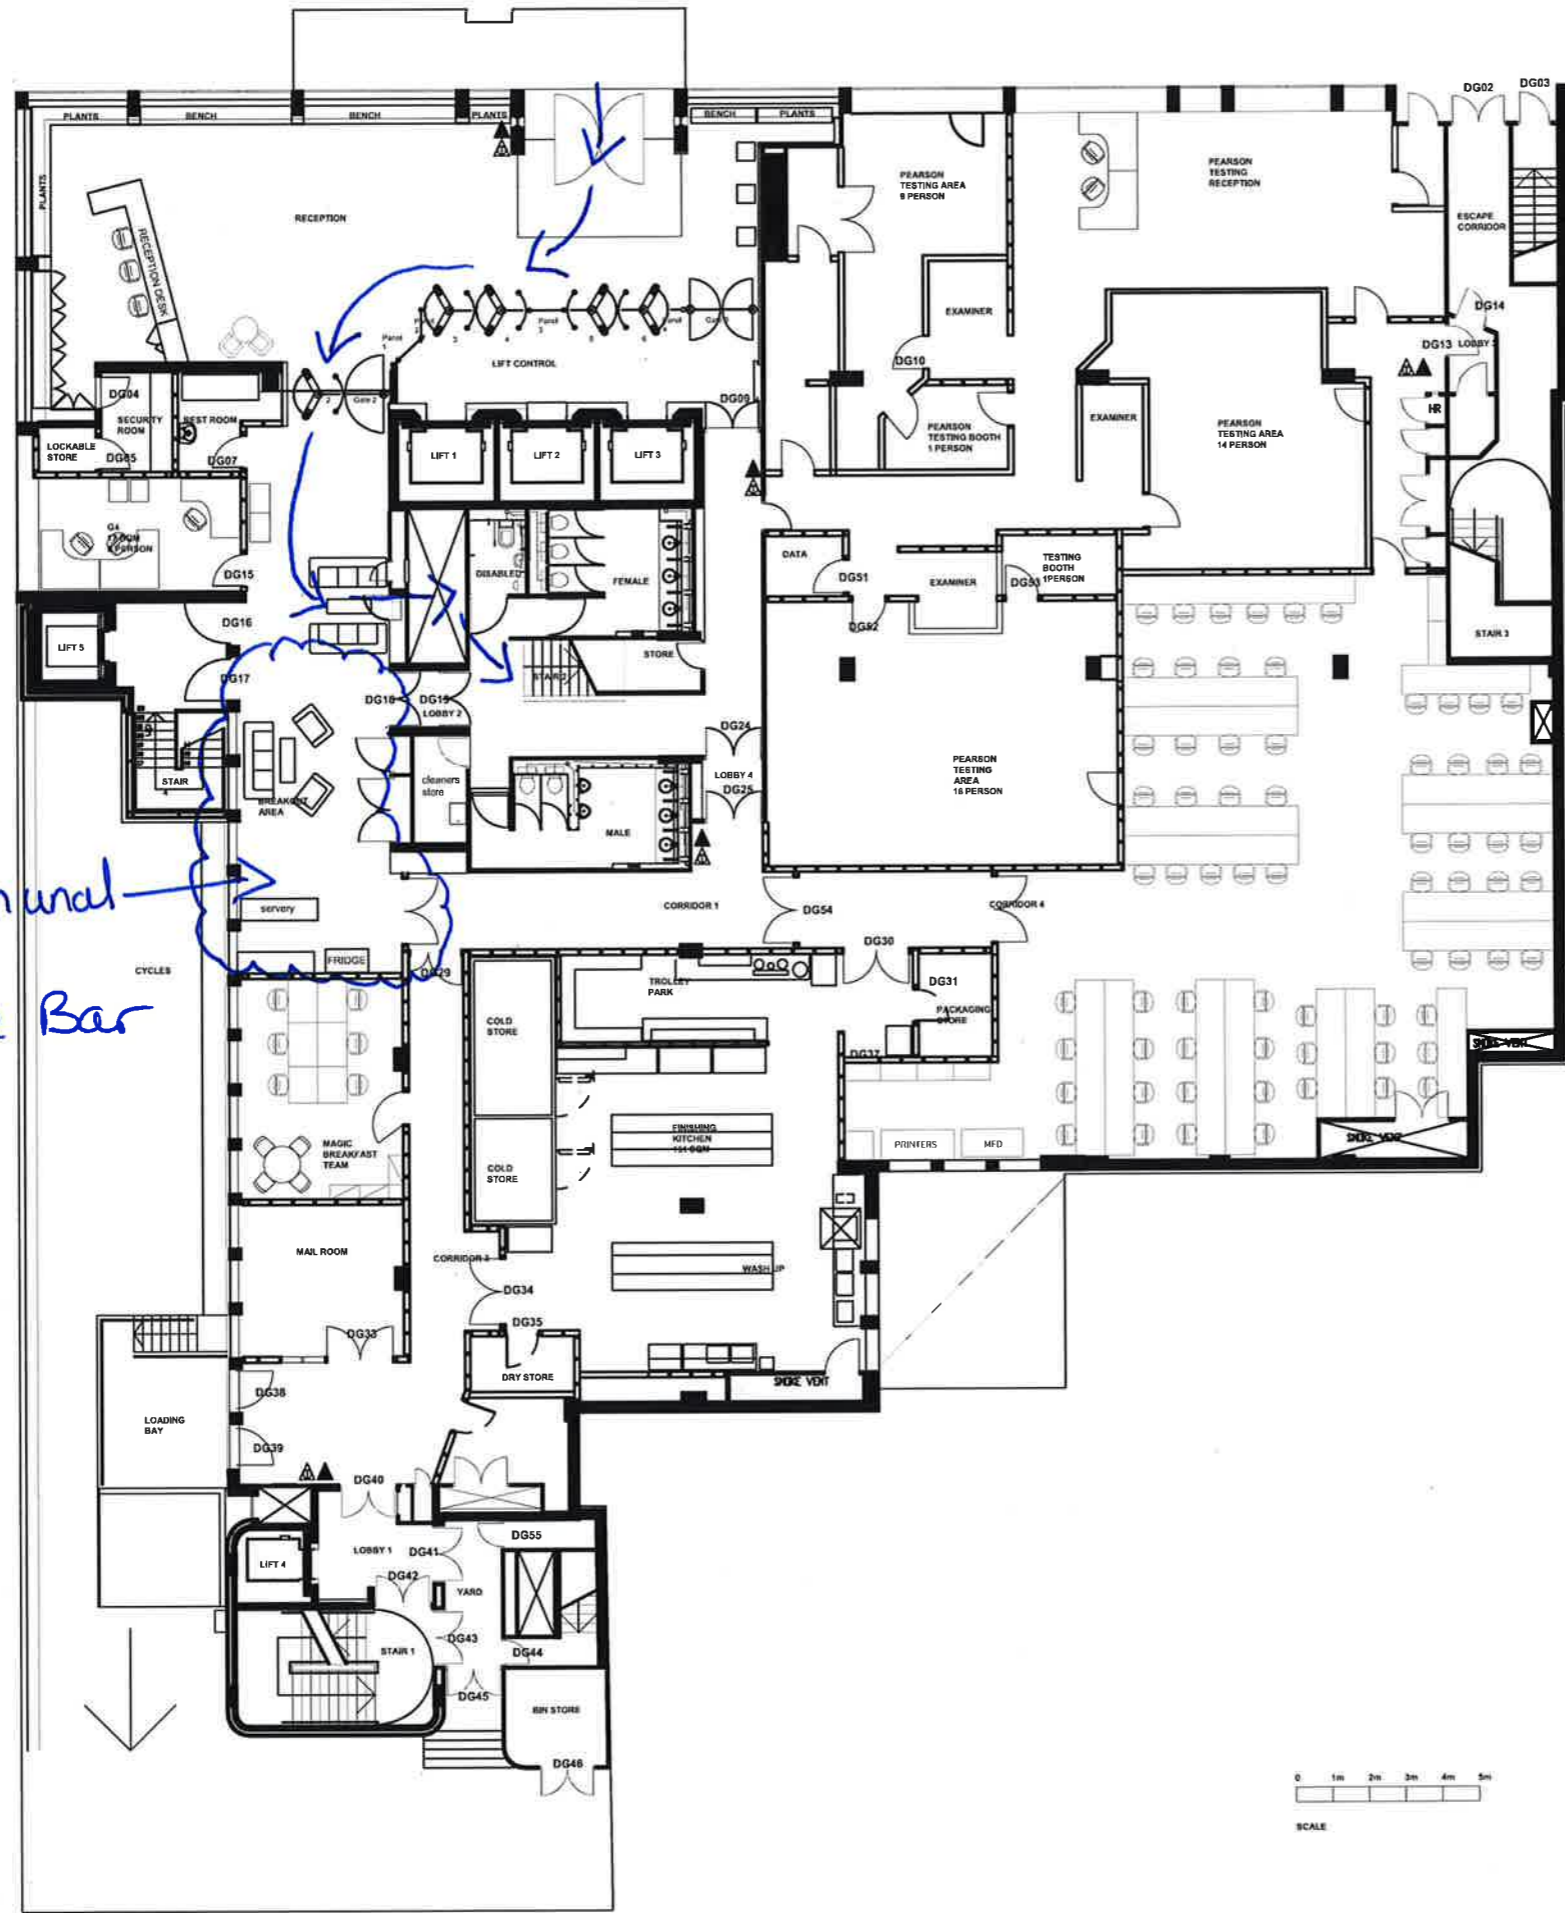

Communal
Area
Coffee Bar

▲ WATER FIRE EXTINGUISHER
 ▲ CARBON DIOXIDE FIRE EXTINGUISHER



A 01.03.12 Issued with Changes
 08.06.11 Issued As Built

EDEXCEL
 190 High Holborn
 LONDON WC2

ARCHITECTS
 80A Ashfield Street
 LONDON E1 2BJ
 020 7790 1178

GROUND FLOOR

SCALE 1:100
 NORTH

PROJECT NO. 1027 DRAWING NO. A100