


A | B | C | D | E

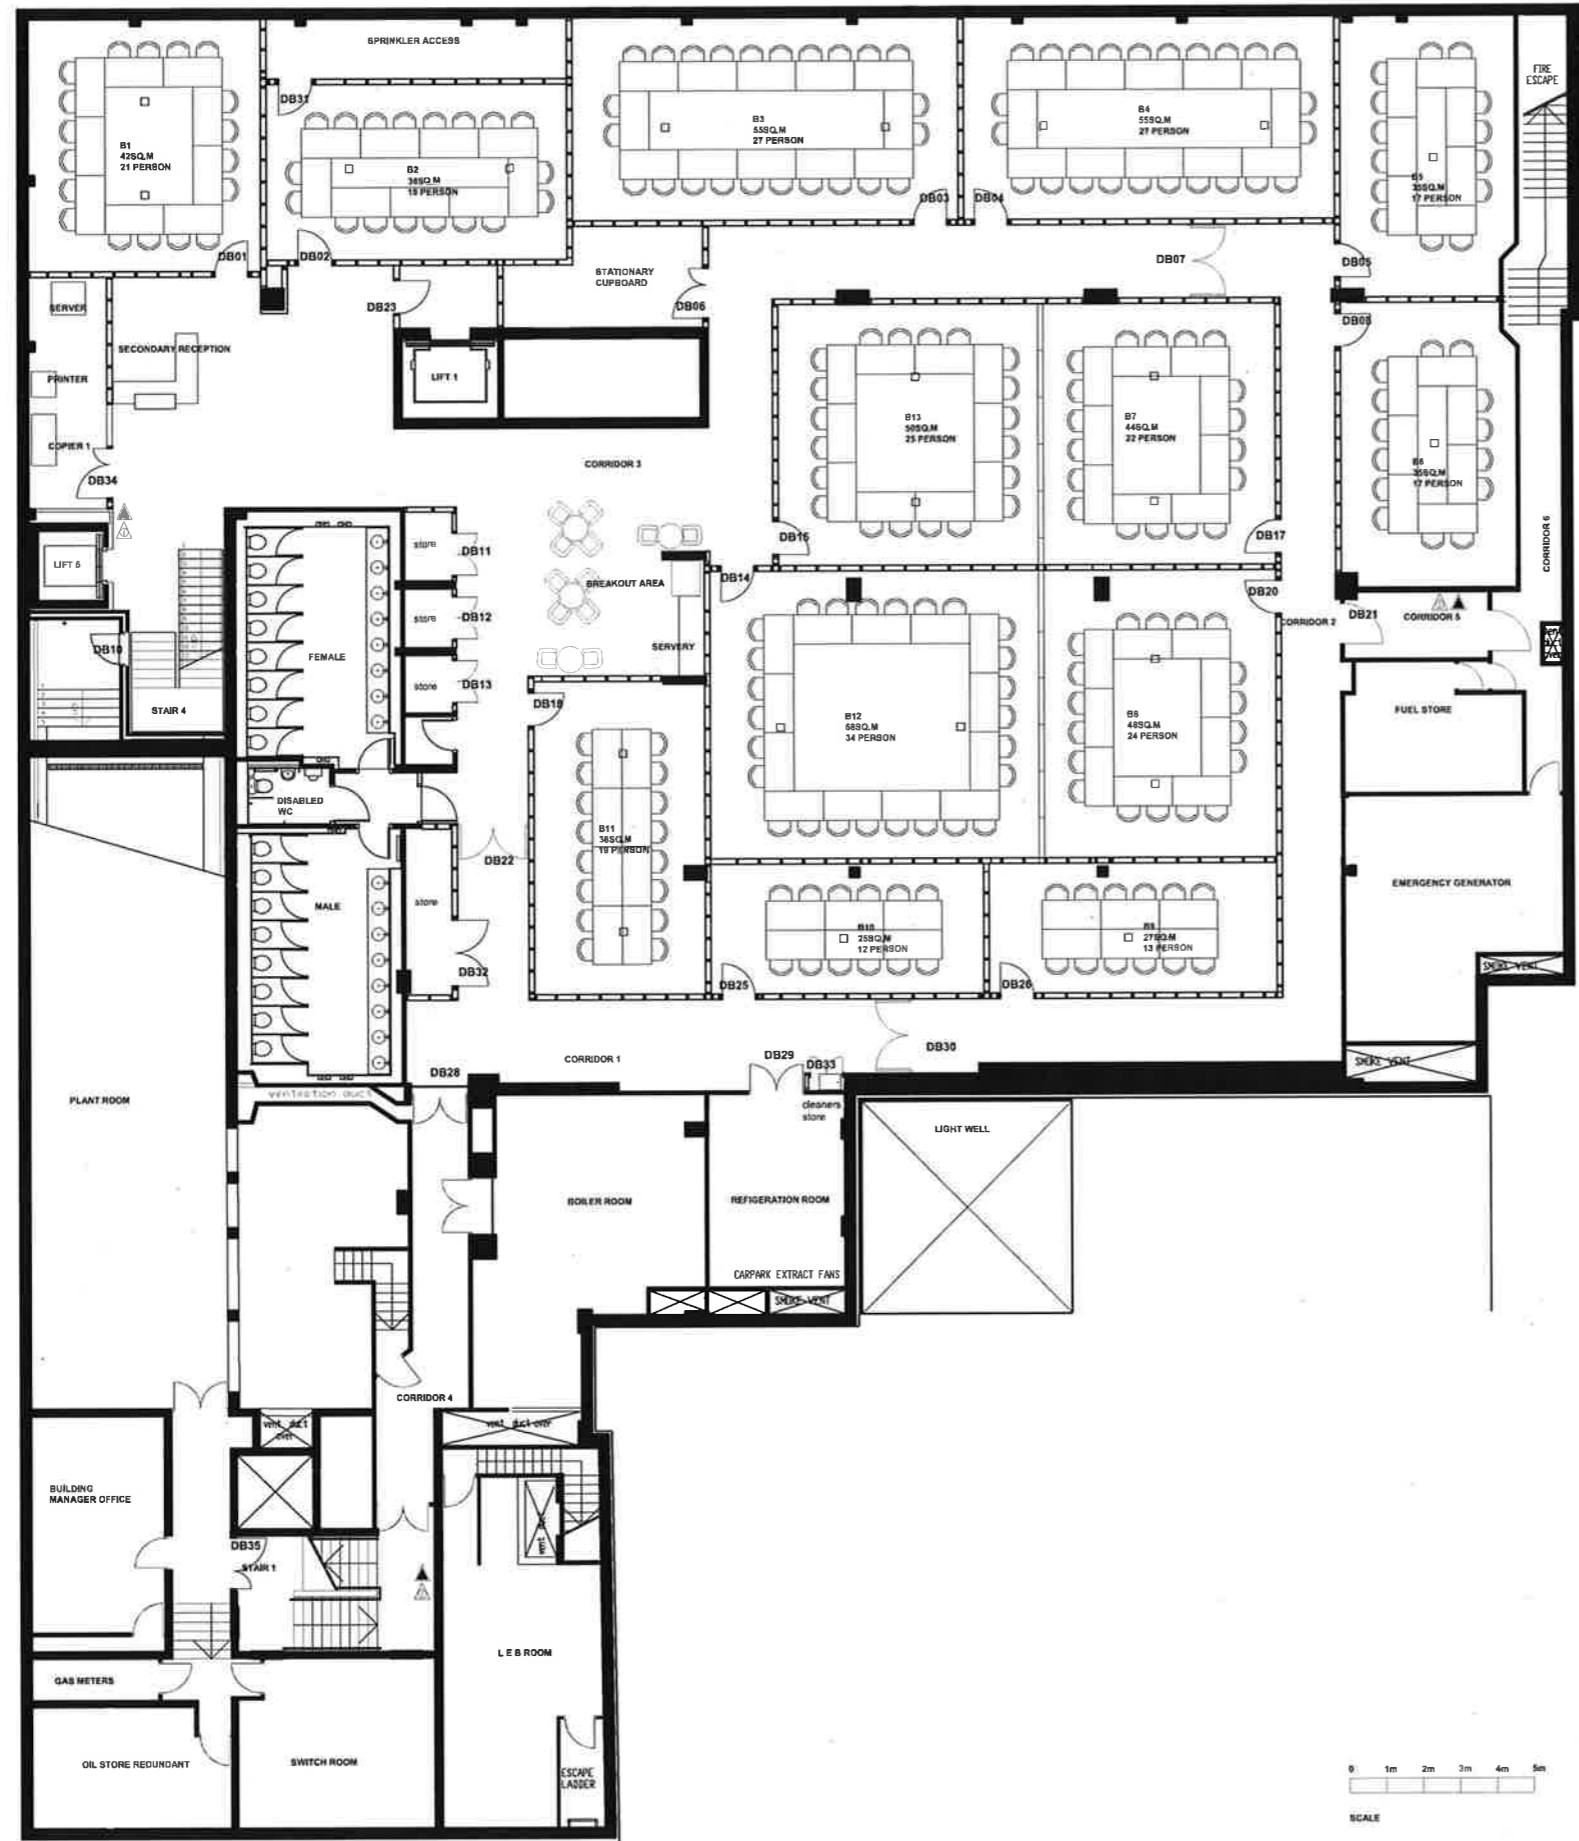

WATER FIRE EXTINGUISHER
CARBON DIOXIDE FIRE EXTINGUISHER

- B1 42 sqm. 21 person
- B2 38 sqm. 19 person
- B3 55 sqm. 27 person
- B4 55 sqm. 27 person
- B5 35 sqm. 17 person
- B6 35 sqm. 17 person
- B7 44 sqm. 22 person
- B8 48 sqm. 24 person
- B9 27 sqm. 13 person
- B10 27 sqm. 13 person
- B11 38 sqm. 19 person
- B12 68 sqm. 34 person
- B13 50 sqm. 25 person

AS BUILT

DRAWINGS INDICATE DESIGN INTENT ONLY
ALL DIMENSIONS IN MILLIMETERS UNLESS NOTED OTHERWISE.
THE CONTRACTOR IS RESPONSIBLE FOR MAKING AND CHECKING ALL DIMENSIONS.
DO NOT SCALE FROM THE DRAWING.
REFER TO ALL CONTRACTS OF INFORMATION TO ORIGINATE AND SEEK ADVICE BEFORE PROCEEDING.
THIS DRAWING IS THE COPYRIGHT OF ORIGINATE ARCHITECTS LTD.



11.05.11 Issued As Built

EDEXCEL
190 High Holborn
LONDON WC2

ORIGINATE
ARCHITECTS

80A Ashfield Street
LONDON E1 2BJ
020 7790 1178

LOWER GROUND FLOOR

DATE: DS SCALE: 1:100
CHECKED: DS DATE: 22.10.09

PROJECT NO: 1027 DRAWING NO: A1LG

A | B | C | D | E