




1 DETAIL PLAN- C2 EMPLOYMENT CW GROUND FLOOR JAMB

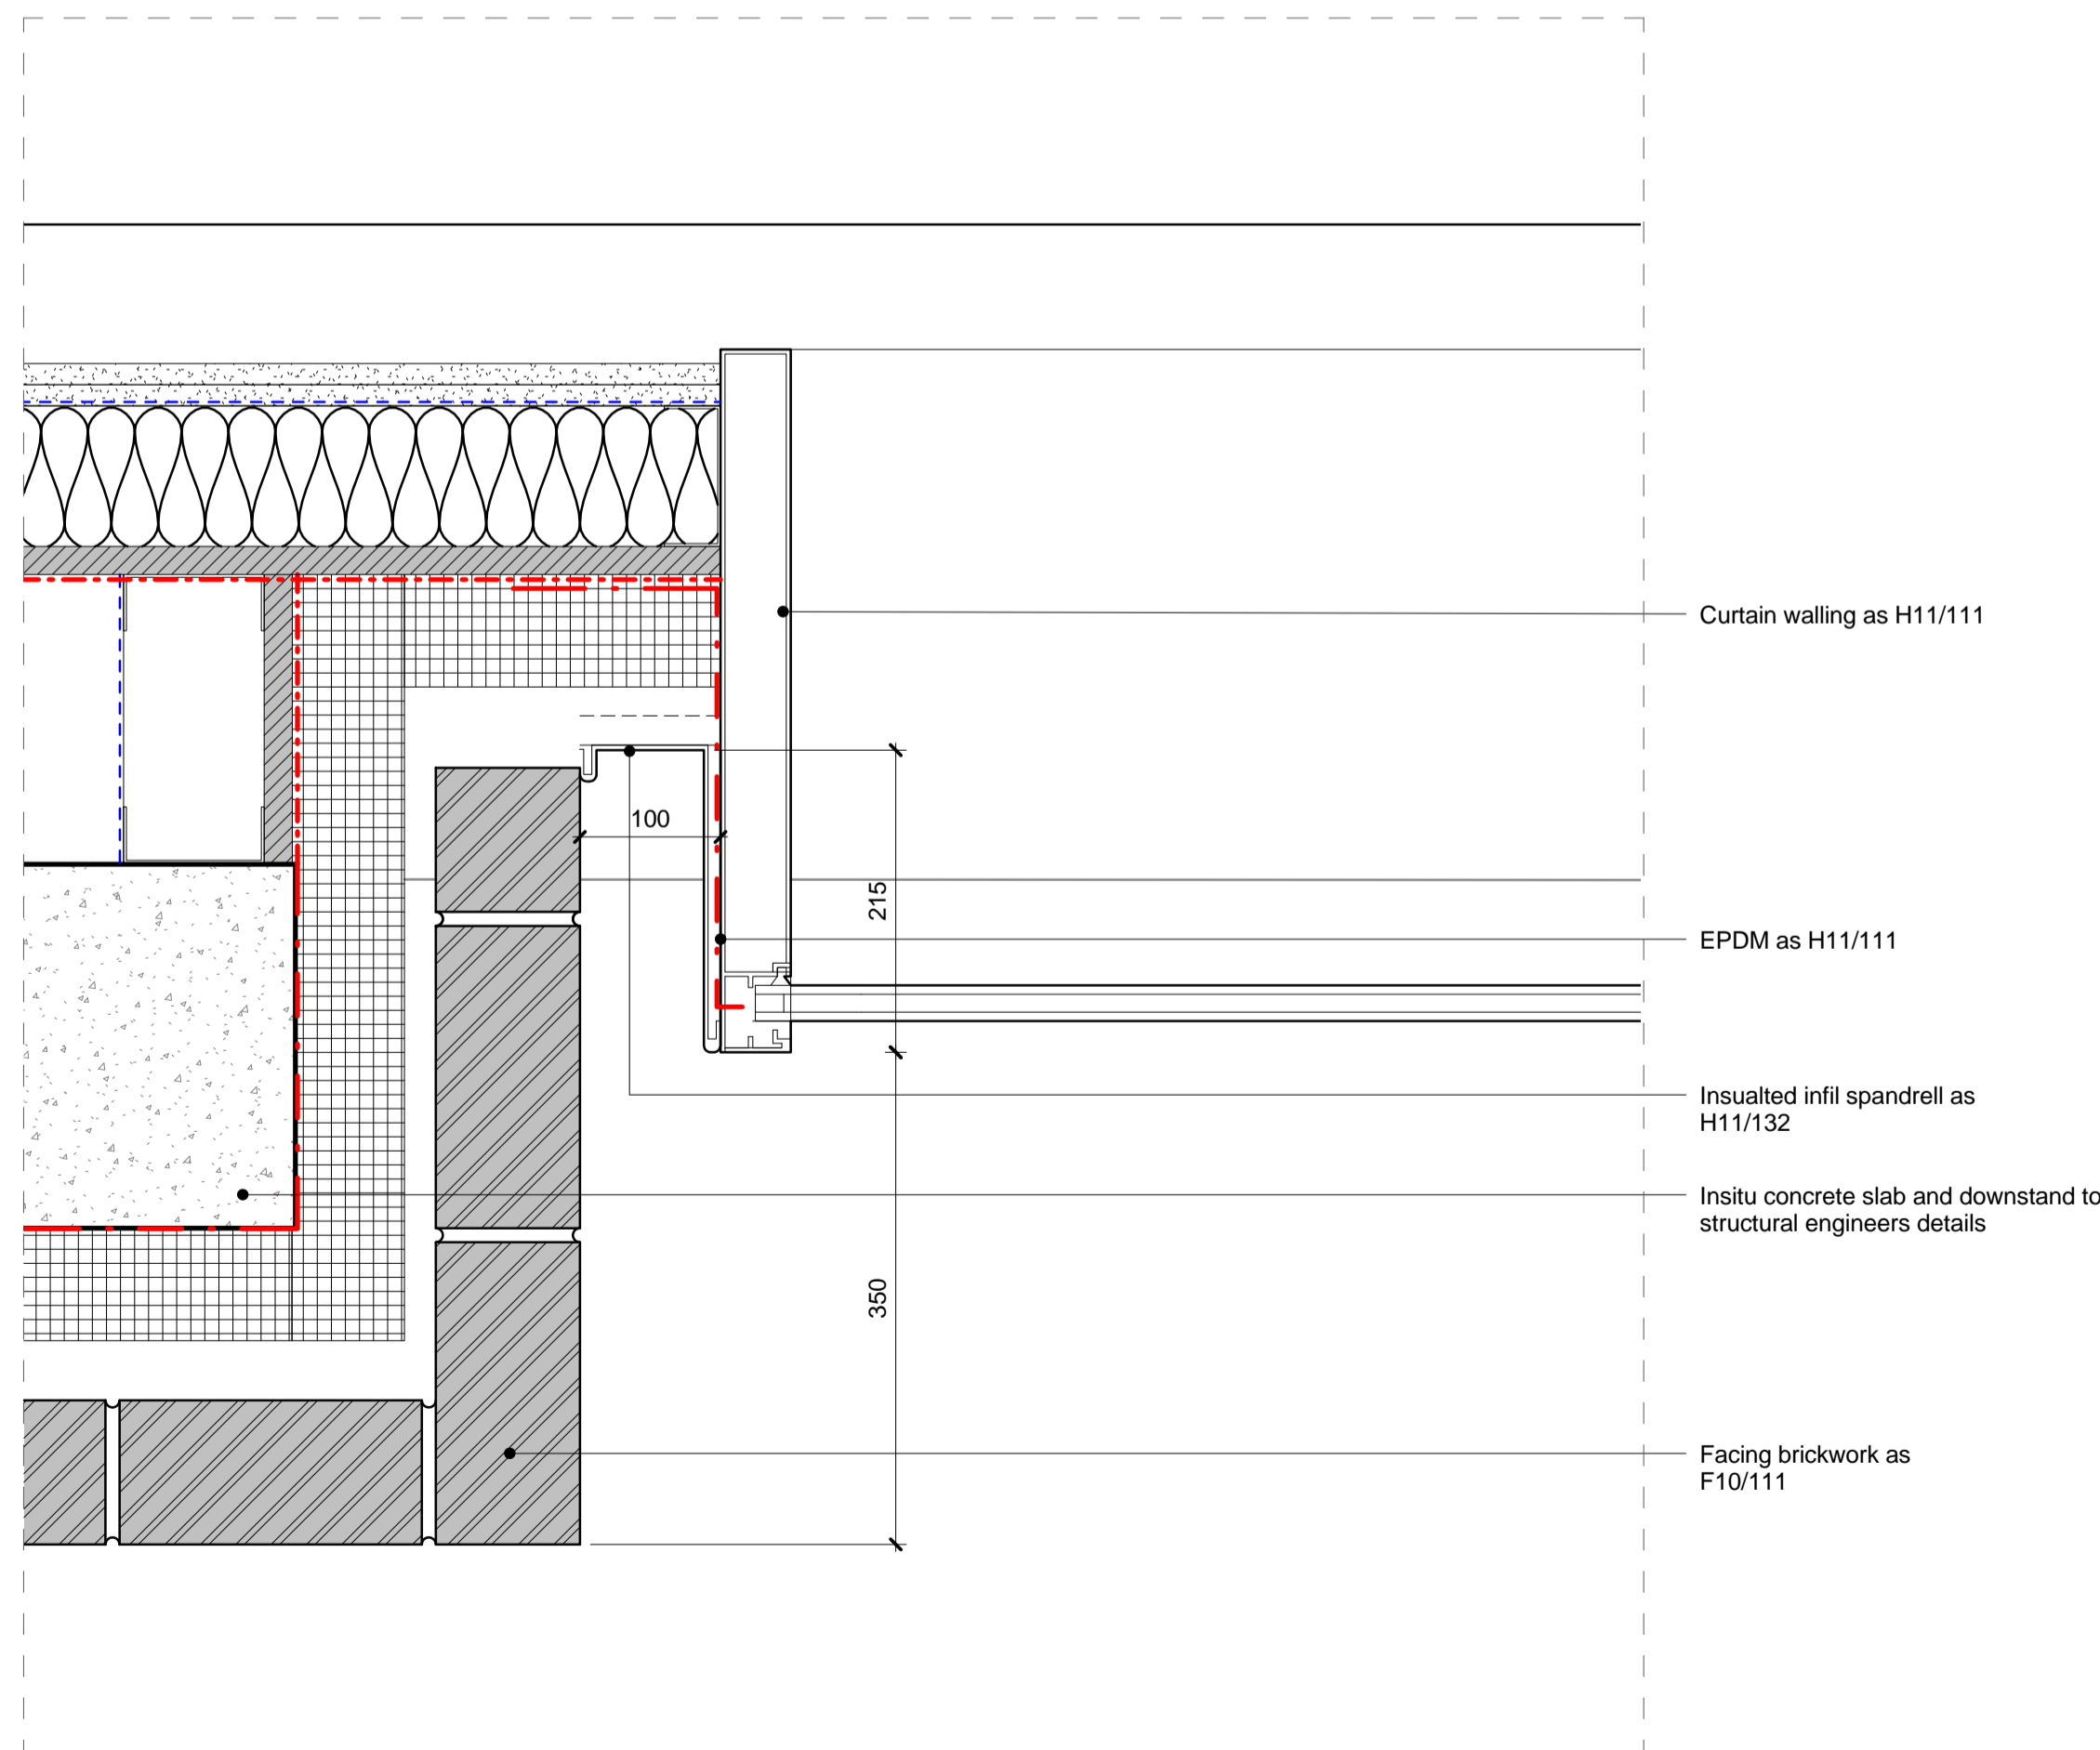


2 DETAILED PLAN - C2 EMPLOYMENT CW UPPER JAMB DETAIL

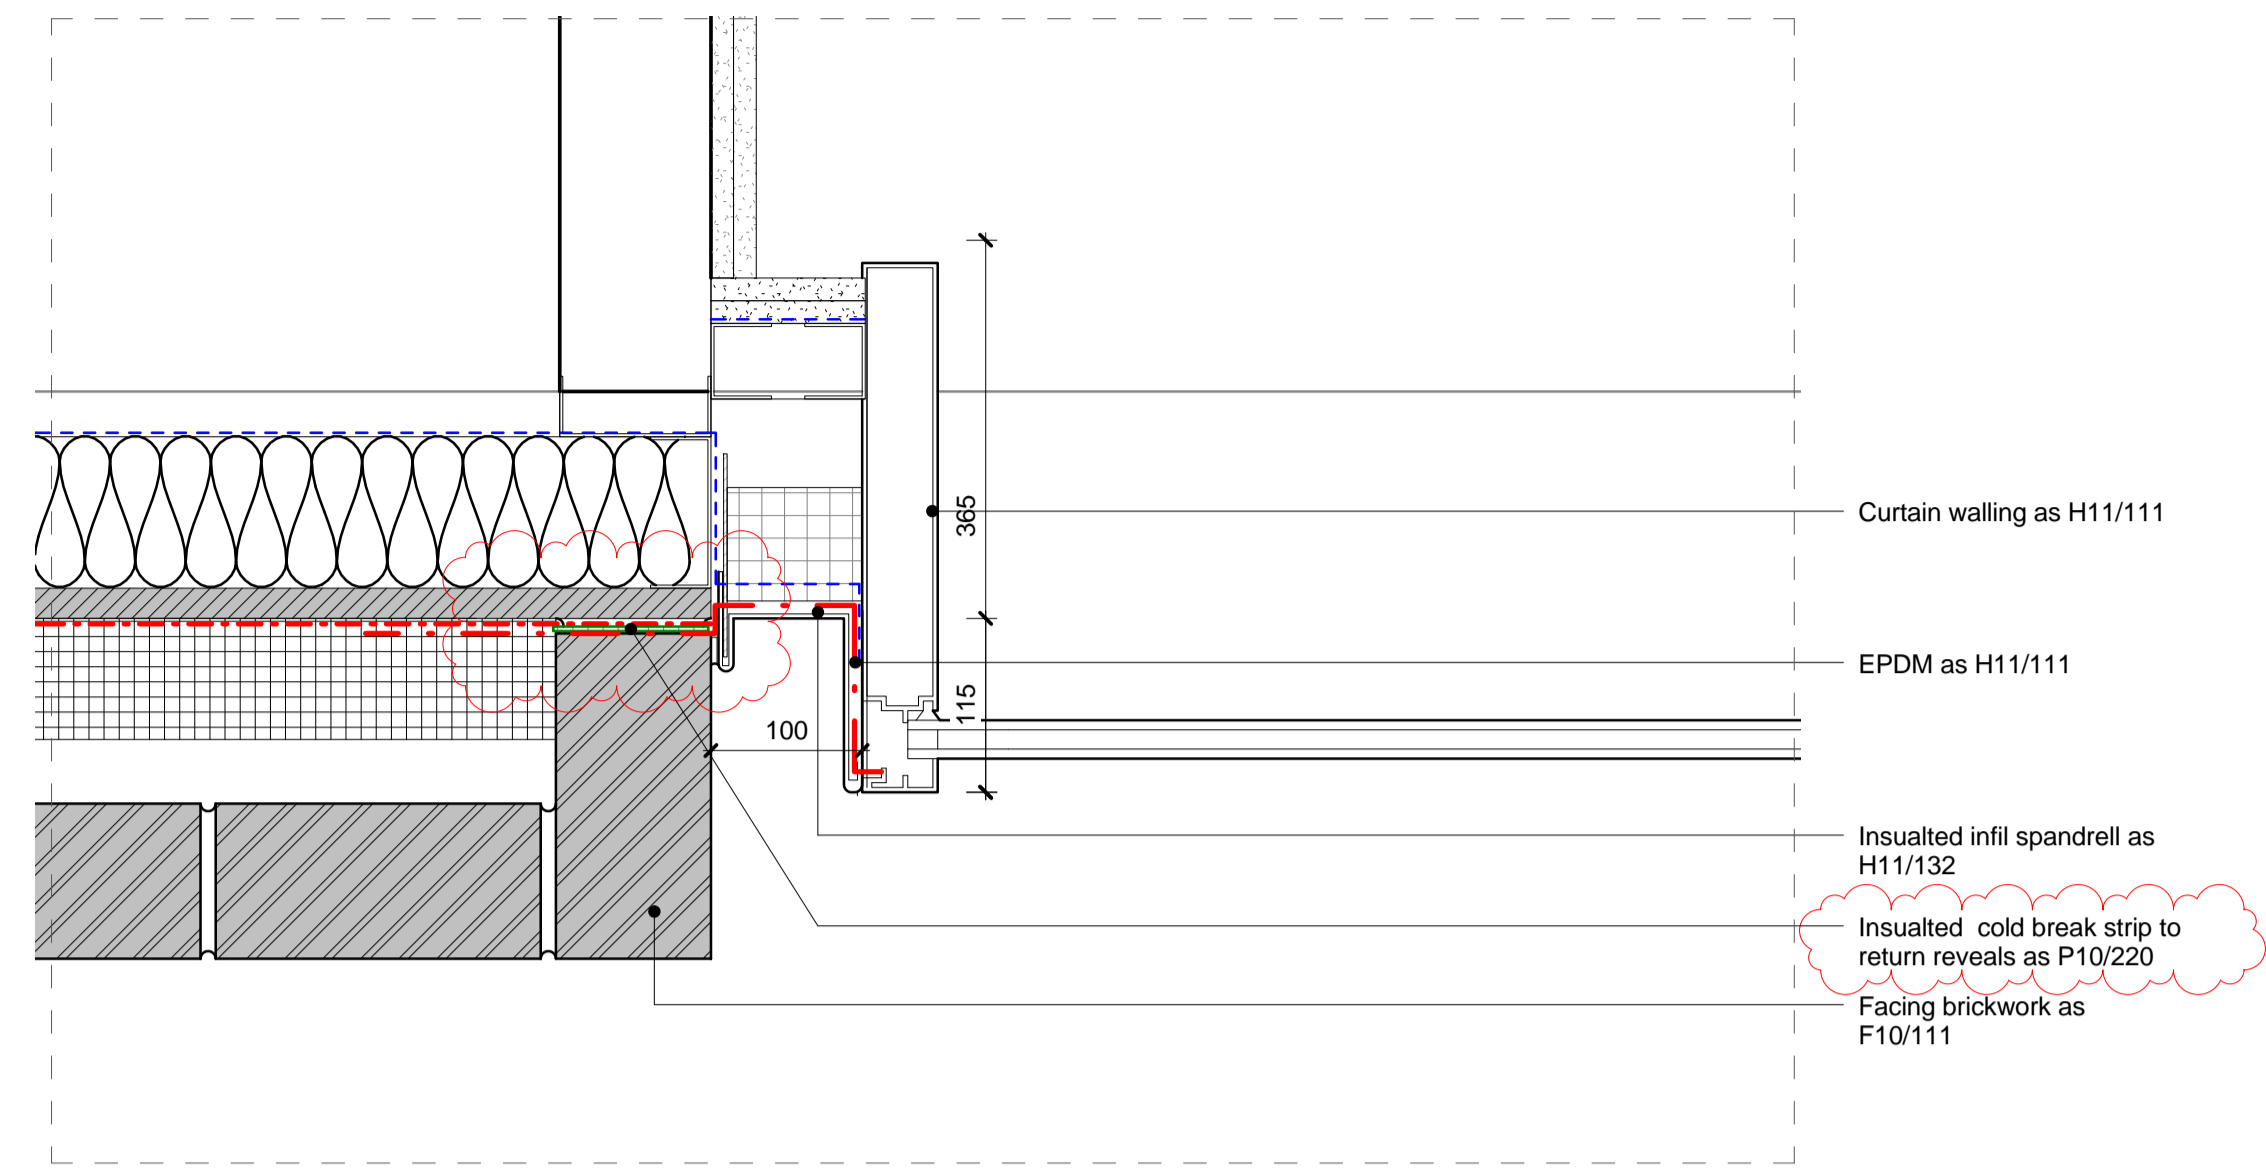

3 DETAILED PLAN- TYPICAL CURTAIN WALLING JAMB

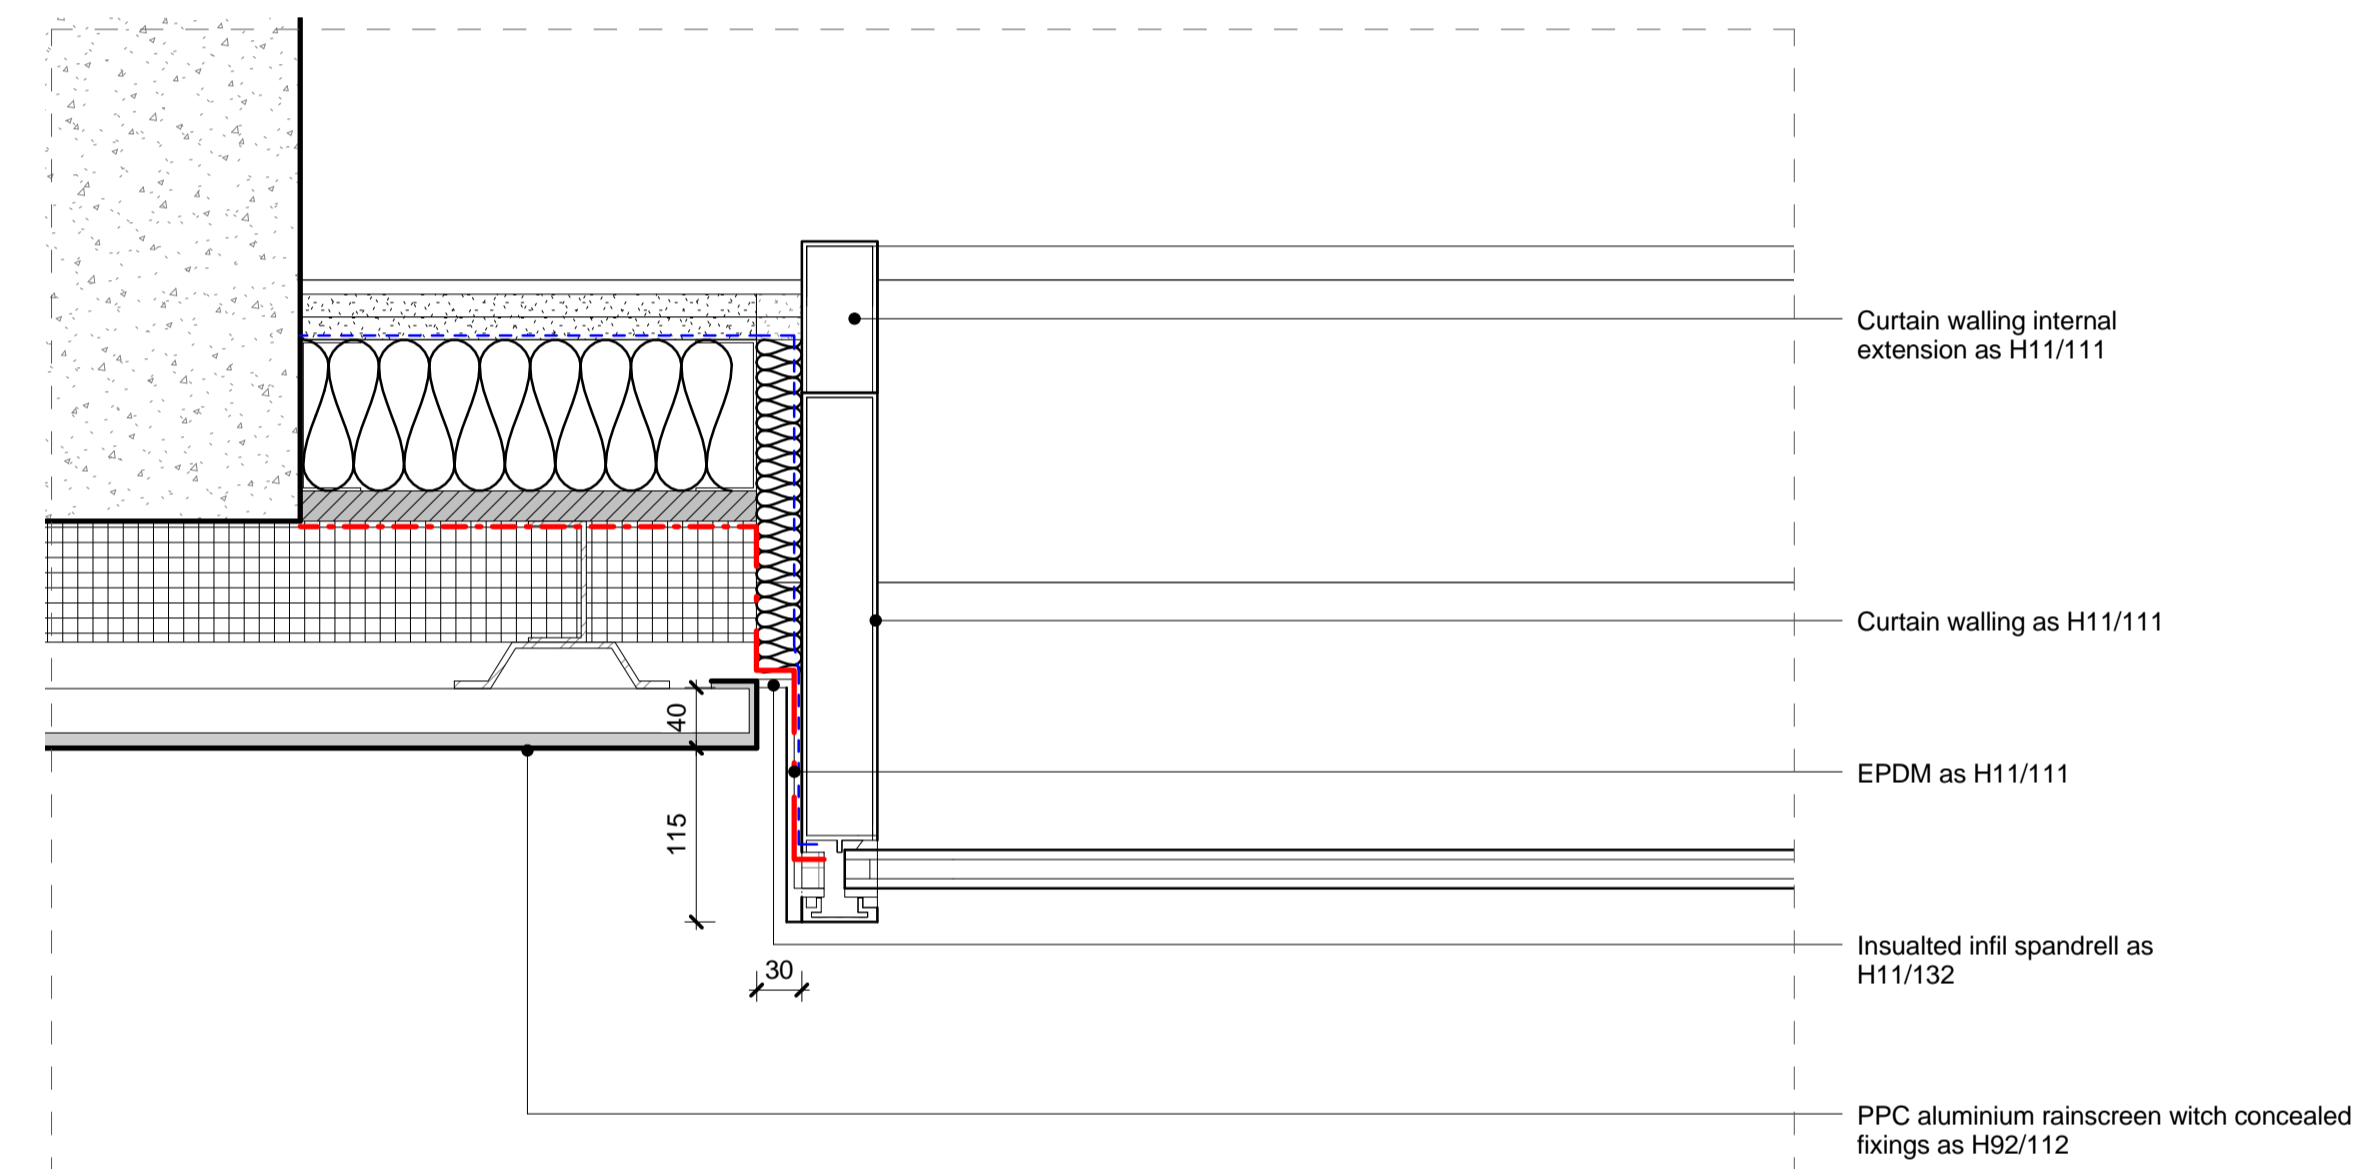

04 DETAILED PLAN- C1 LOCAL SPACE CW JAMB

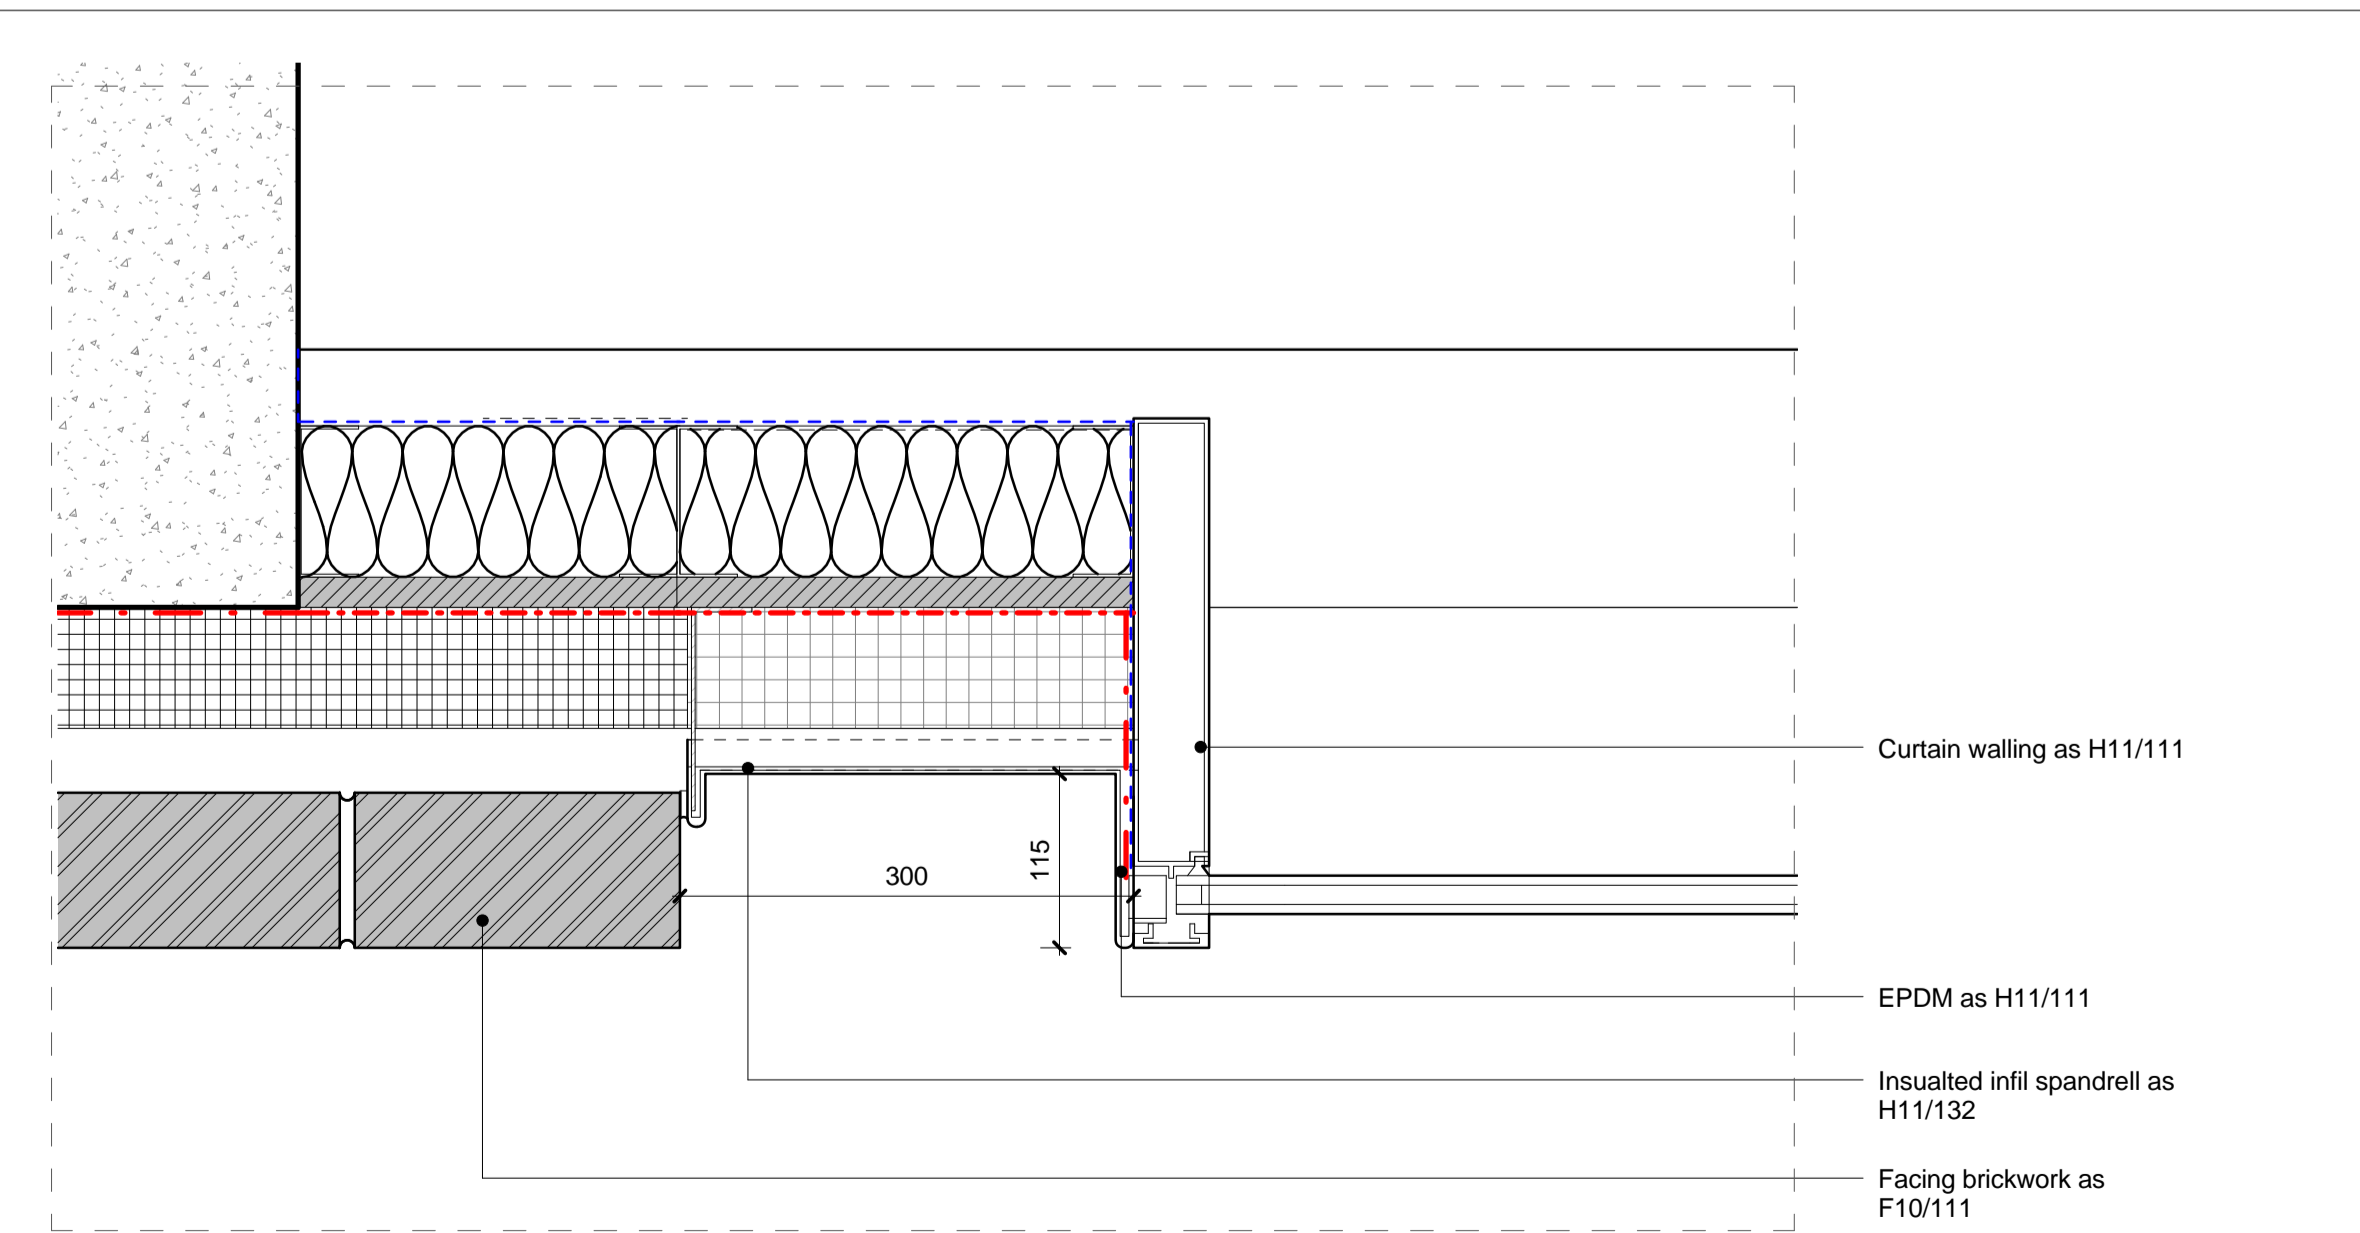

05 DETAILED PLAN - C1 CINEMA CW JAMB

KEY


**AHMM MARK UPS
FOR EMPLOYERS' REQUIREMENTS
18/12/15**

T 0 2 18/12/15 Issued for ER's
T 0 1 26/06/15 Stage E Tender Issue

REV DATE DESCRIPTION

CONSULTANTS	
CLIENT:	Stanley Sidings
CONTRACTOR:	-
STRUCTURAL ENGINEER:	Walsh Group
MECHANICAL ENGINEER:	Hoare Lea
COST CONSULTANT:	Gardiner & Theobald
PROJECT MANAGER:	Gardiner & Theobald
ACOUSTIC CONSULTANT:	Hoare Lea
TRANSPORT CONSULTANT:	Arup
PLANNING CONSULTANT:	Gerald Eve
LANDSCAPE ARCHITECT:	Fabrik
CDM CO-ORDINATOR:	MSA Safety

- NOTE
- Do not scale from this drawing.
 - All dimensions to be checked on site by the contractor and such dimensions to be his responsibility. Report all drawing errors, omissions and discrepancies to the architect.
 - This document may be issued in an uncontrolled CAD format to enable others to use it as background information to make alterations and/or additions. In that instance the file will be accompanied by a PDF version. It is for those making such alterations and additions to ensure that they make use of current background information.
 - AHMM Ltd accepts no liability for any such alterations or additions to the background information or arising out of changes to background information which occur prior to alterations or additions being made.

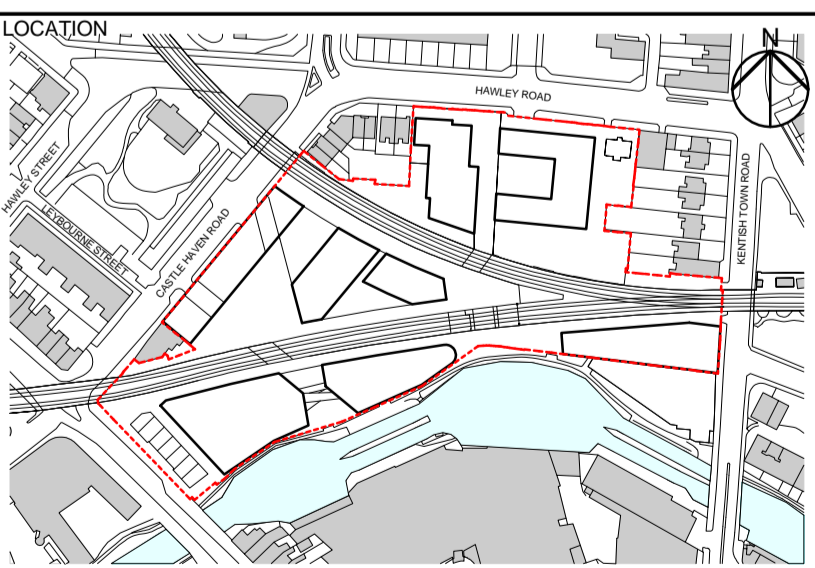

ALL FORD HALL MONAGHAN MORRIS
ARCHITECTS Ltd
5-23 OLD STREET, LONDON, EC1V 9HL
TEL 020 7251 5261 FAX 020 7251 5123 WEB WWW.AHMM.CO.UK

job title
CAMDEN LOCK VILLAGE

drawing title / location
CURTAIN WALLING JAMB DETAILS

drawn by	checked	scale	status
NL	KH	1 : 5 @ A1	ER issue

project	drawing no.	revision
14045	CX_(21)_ 6006	T02