


1:1000
NWS 255

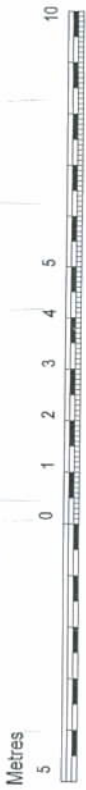


SCALE 1:50

AS BUILT


REV/NOTES:

Where building to the boundaries the adjacent owner is to be informed under the terms of the Party Wall Act 1996 and the provisions followed. Where building over boundaries the adjacent owner is to be served notice under section 85 of the Town & Country Planning Act 1990.
© This drawing and the works depicted are the copyright of GT Designz LTD and may not be reproduced or amended except by written permission of GT Designz LTD.
Rev 13.04.11 - Amend roof terracing showing railings within amended area of bedroom 2 to within requirements

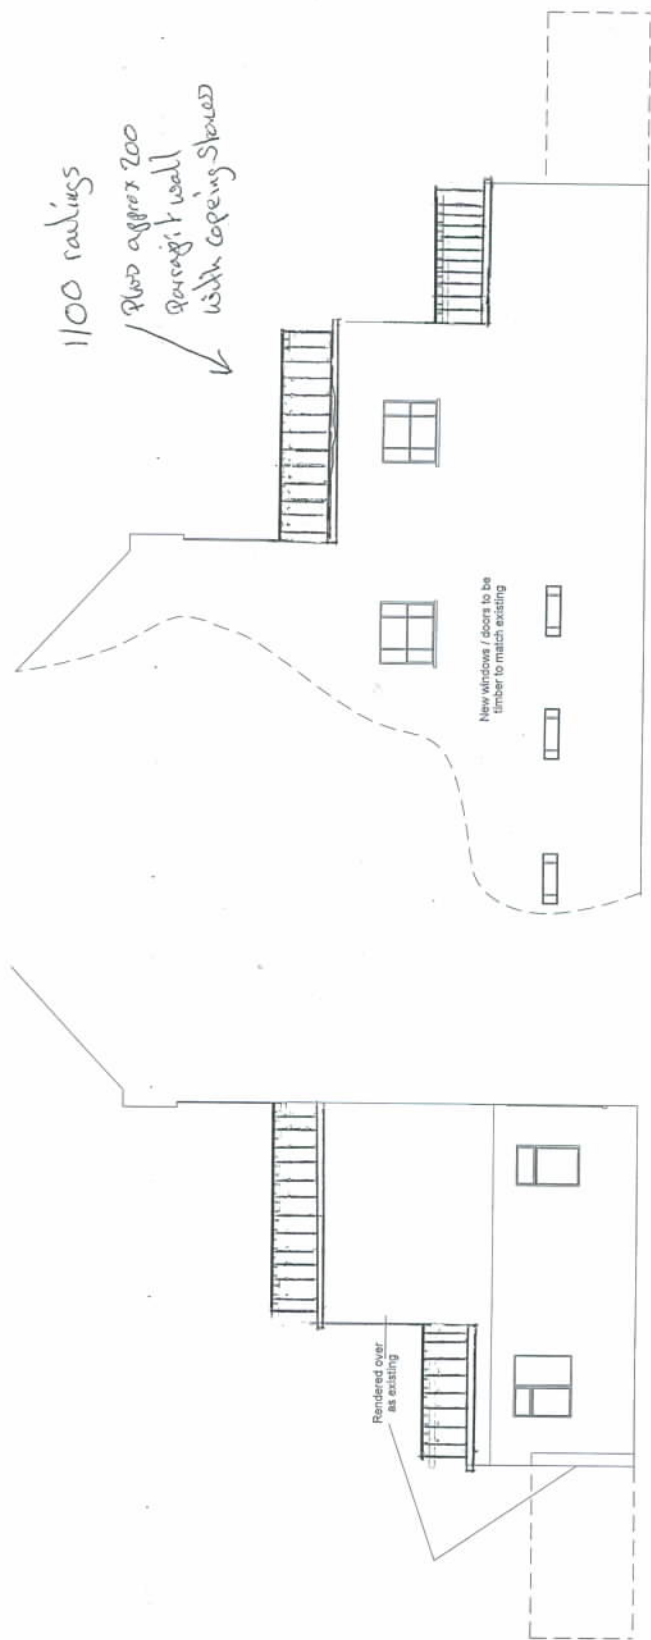

PROPOSED SIDE ELEVATION
SCALE 1:50 @ A1

PROPOSED SIDE 2 ELEVATION
SCALE 1:50 @ A1

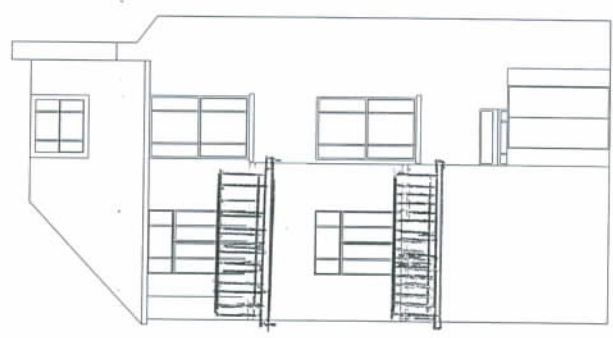

PROPOSED REAR ELEVATION
SCALE 1:50 @ A1

Application: FF Rear extension & terracing incl COU from three bed flat to 2 no bed flats			
Client:	Mr Coth	Date:	30 th Jan 2011
Site:	57a Terrance Avenue London, NW5 2SJ	Drawn By:	Clayton Bennett
Scale:	Refer to Drawing @ A1	Dwg No.:	GTD025.04

GT DESIGNZ LTD
Building Designs & Technical services

82a Holyhead Road
Wembley
West Midlands
WS10 7PA

Email: www.gtdesignz.com
Tel: 0121 502 3339 Mob: 07964 351 934
Email: enquiries@gtdesignz.com