



ALL DIMENSIONS TO BE CHECKED ON SITE




LINEAR SCALE 1:100

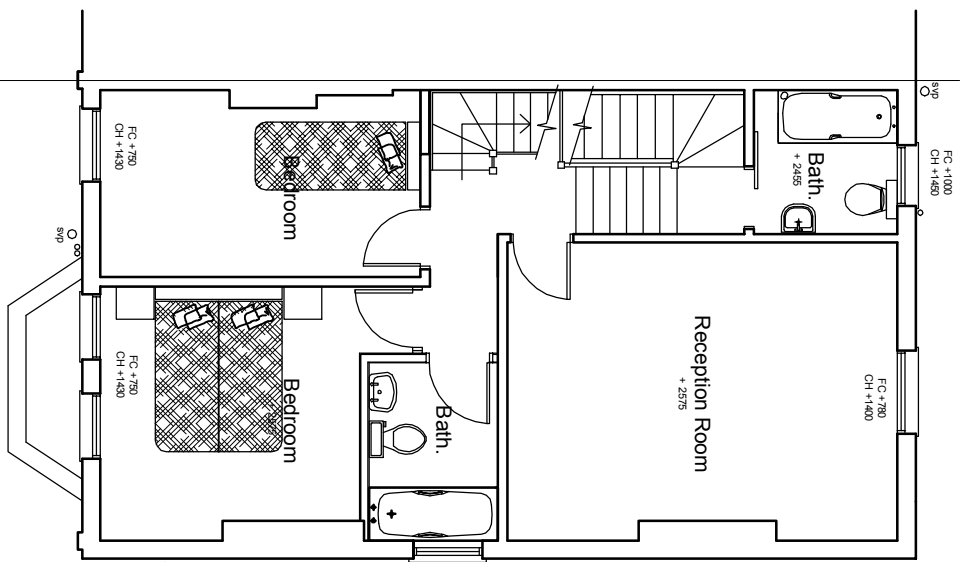

Proposed Second Floor Plan

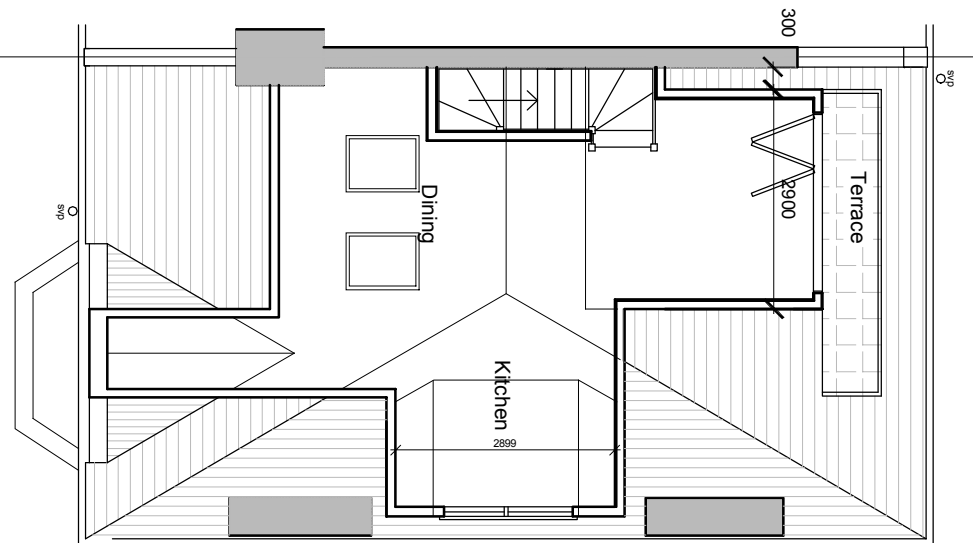

Proposed Roof Plan

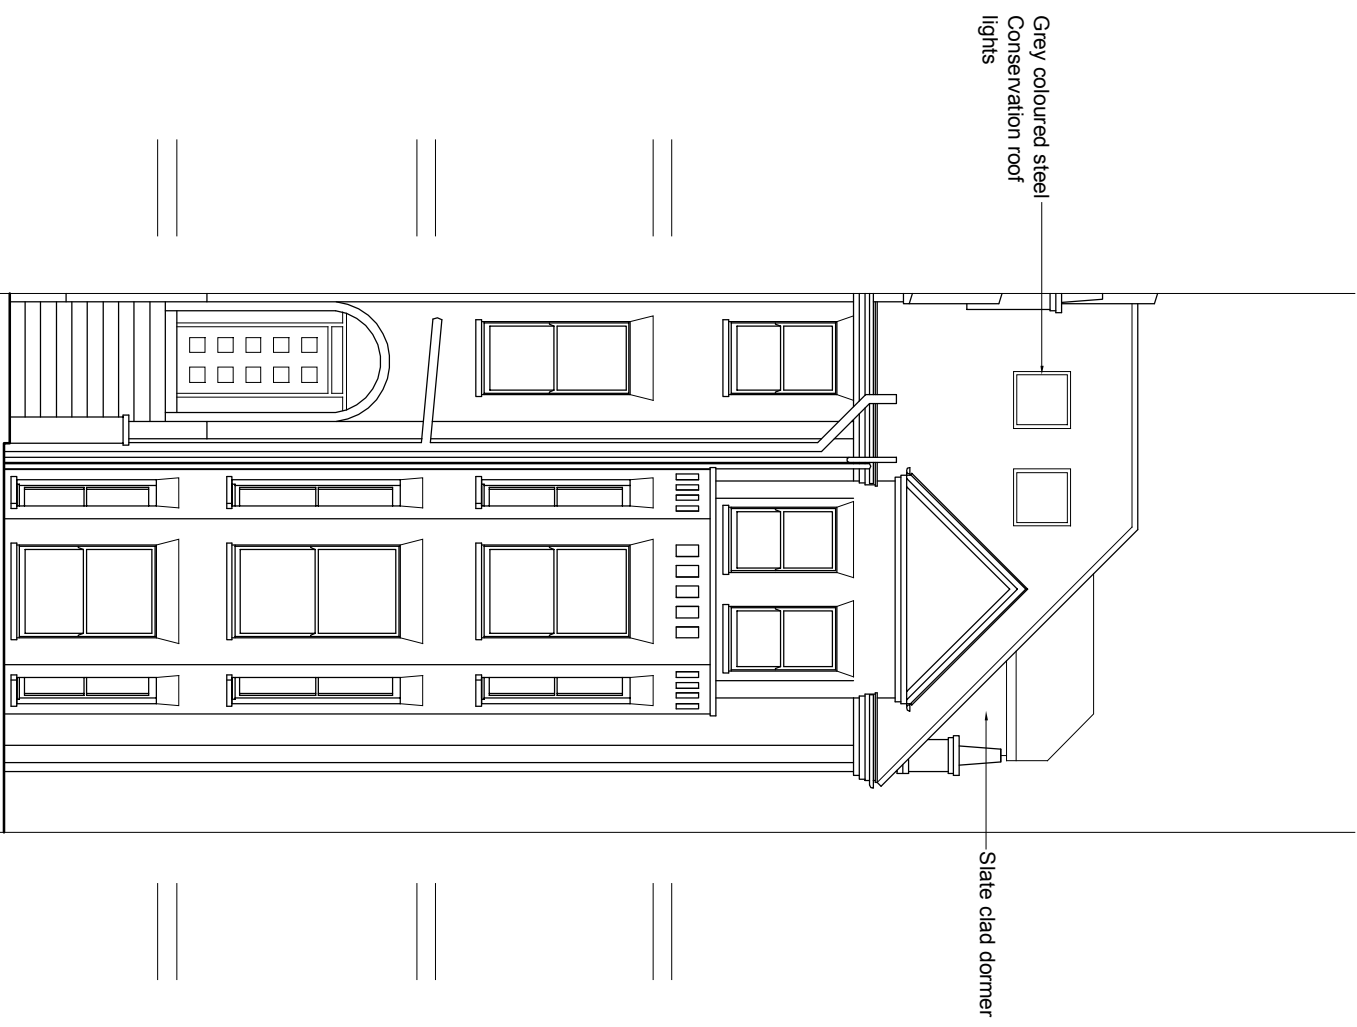

Proposed Front Elevation

revisions Revised to as built B

project
45 Goldhurst Terrace
London
NW6

client

Mr Ivan Forster

drawing title

Proposed Plans & Front Elevation

SEPIA DESIGN
Chartered Architectural Technologists

Chartered Architectural Technologists

20-22 St Dunstons Road

Feltham, Middlesex

Mob: 07595 032 939

E-mail: info@sepiadesign.co.uk

date Aug 15

number A9743PA/006

scale 1:100 @ A3 revision B

© copyright