



ALL DIMENSIONS TO BE CHECKED ON SITE

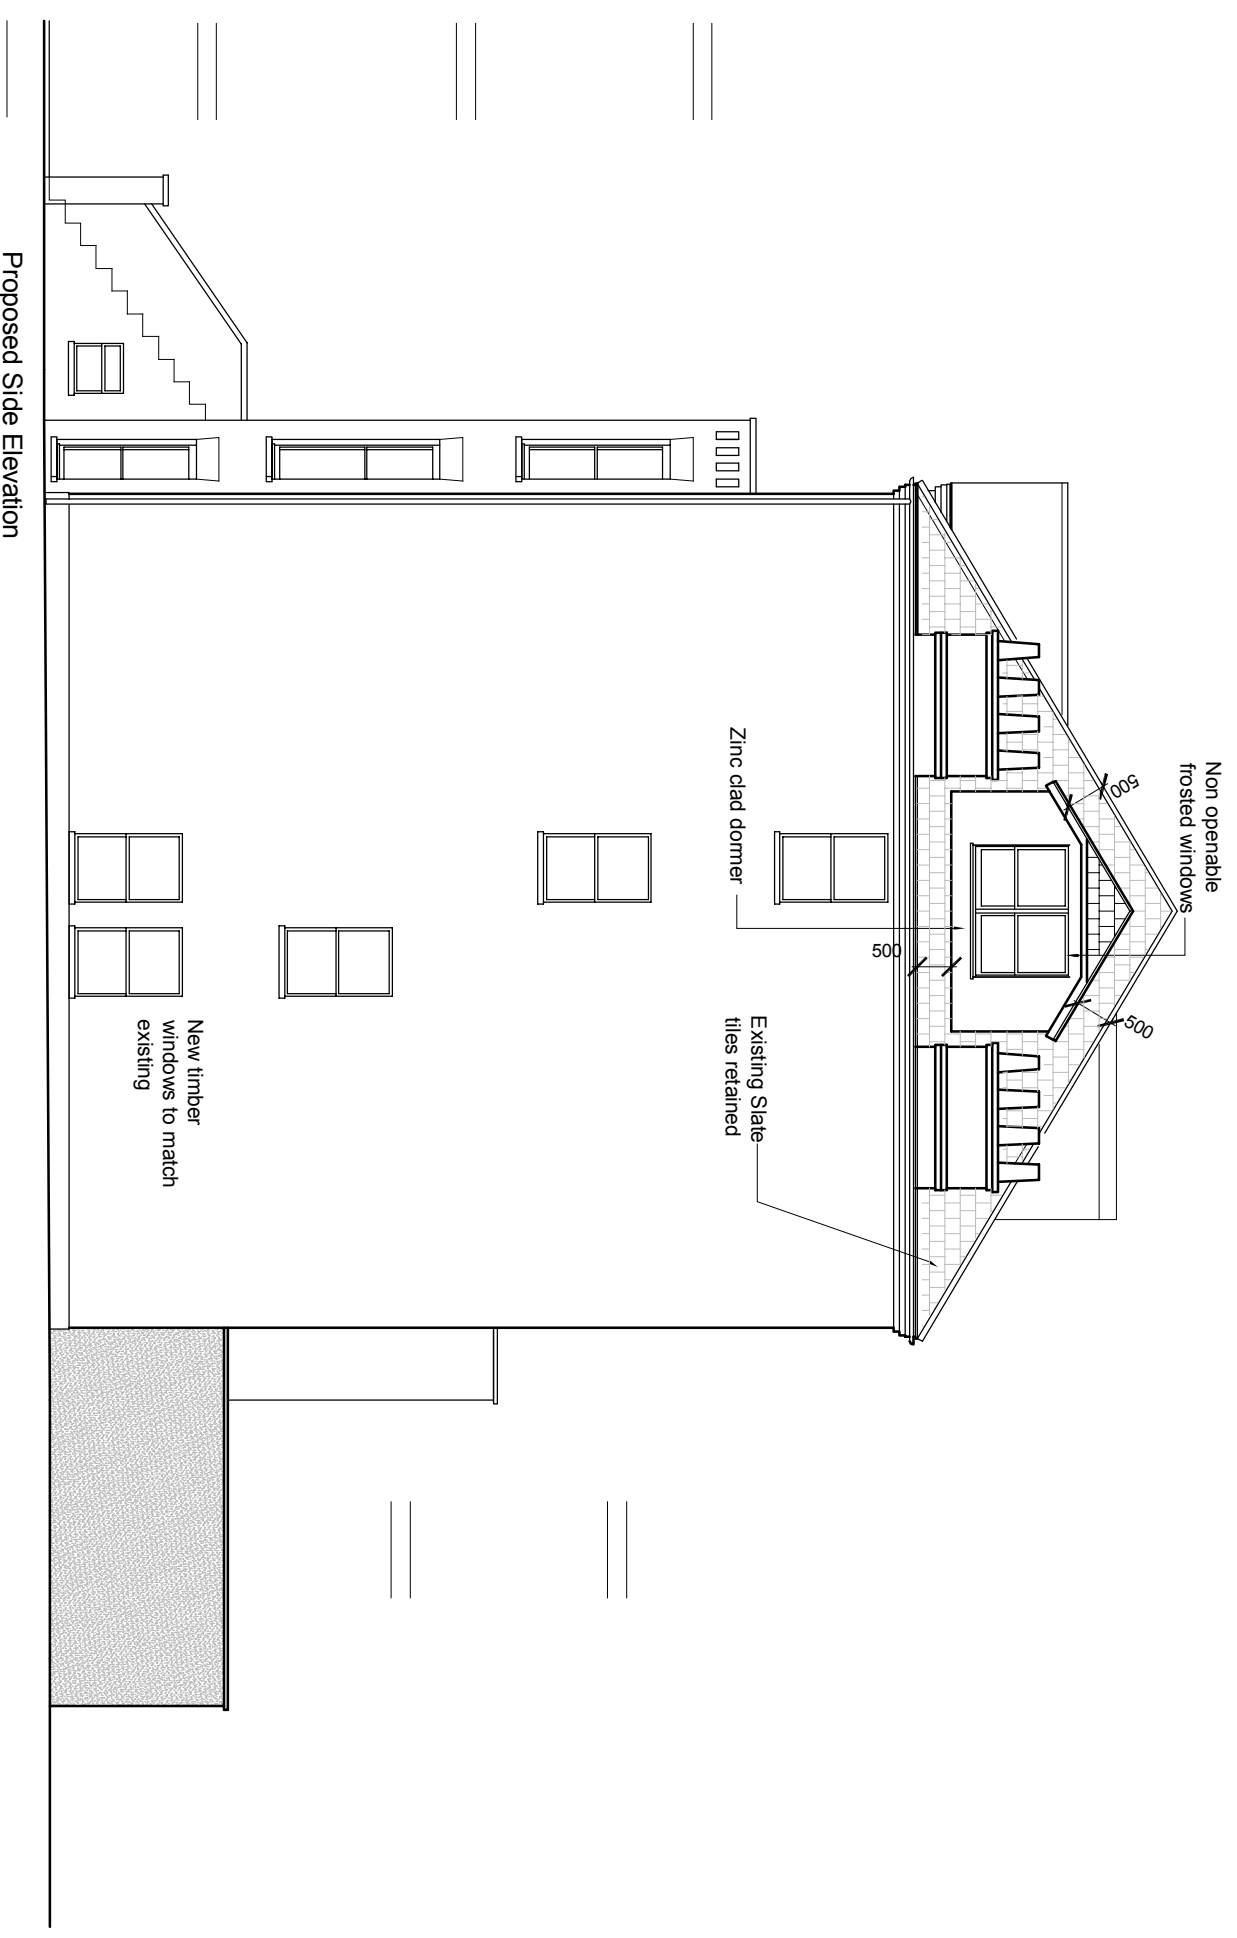

LINEAR SCALE 1:100

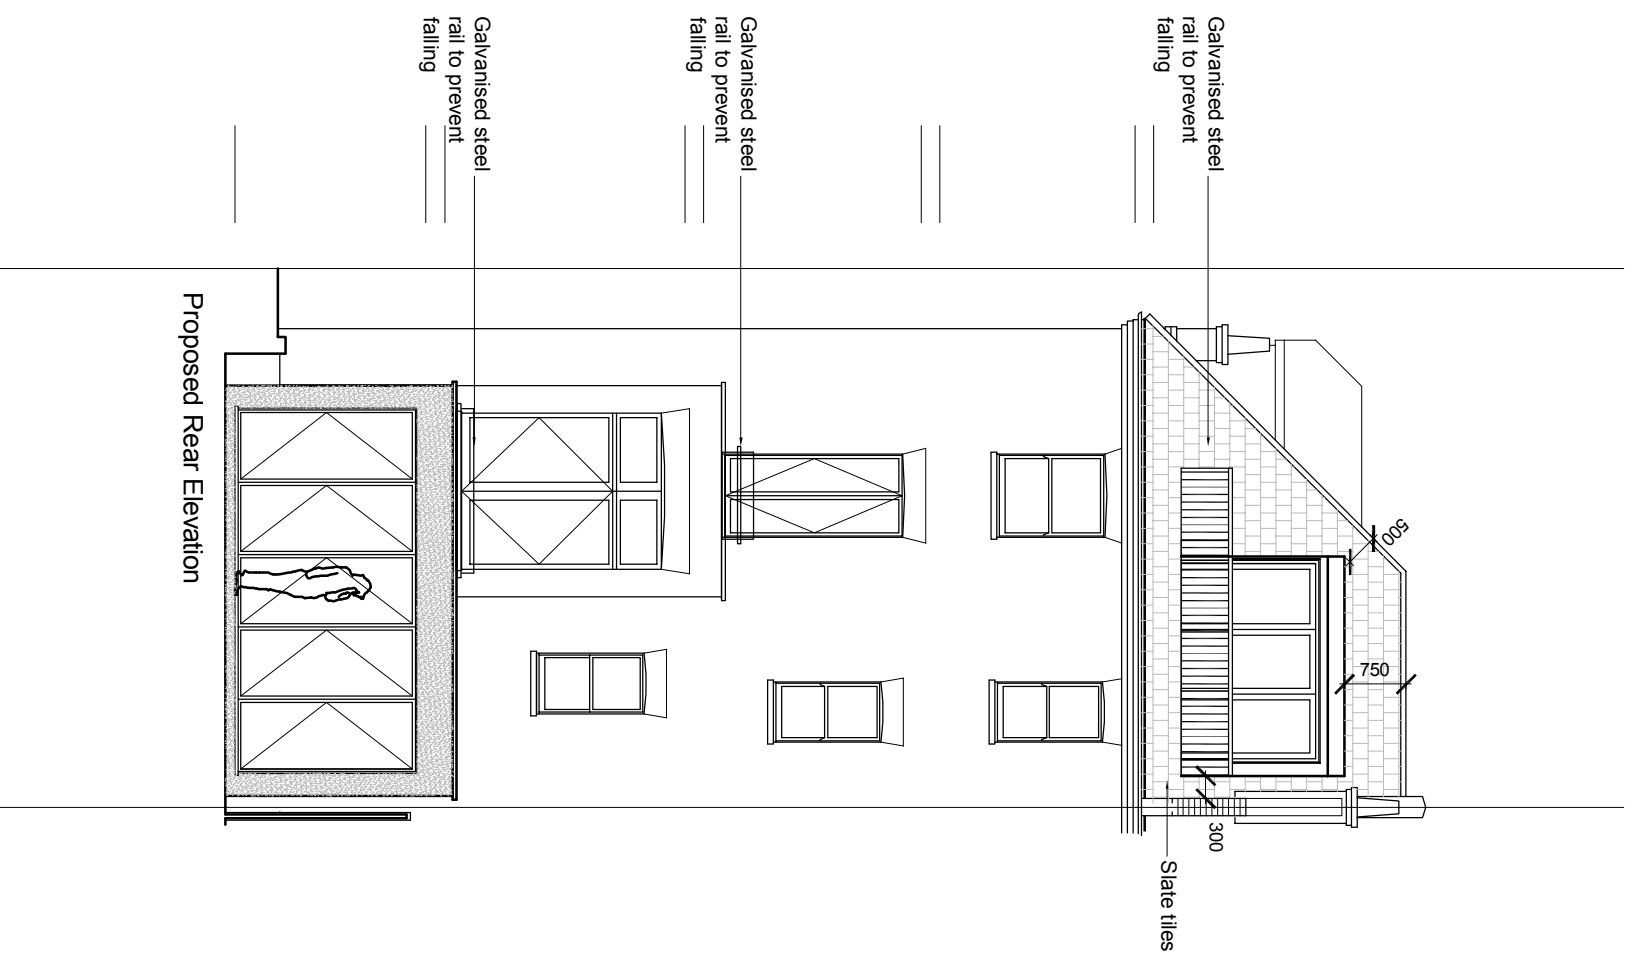

revisions Revised to as built C

project
45 Goldhurst Terrace
London
NW6

client
Mr Ivan Forster

drawing title
Existing Rear & Side Elevation

SEPIA DESIGN
Chartered Architectural Technologists

20-22 St Dunstons Road
Feltham, Middlesex
Tel: 0208 831 9629
Mob: 07595 032 939
E-mail: info@sepiaesign.co.uk



date Aug 15 number A9743PA007

scale 1:100 @ A3 revision C

© copyright