



ALL DIMENSIONS TO BE CHECKED ON SITE

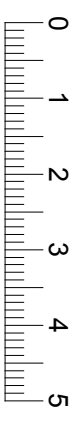

LINEAR SCALE 1:100

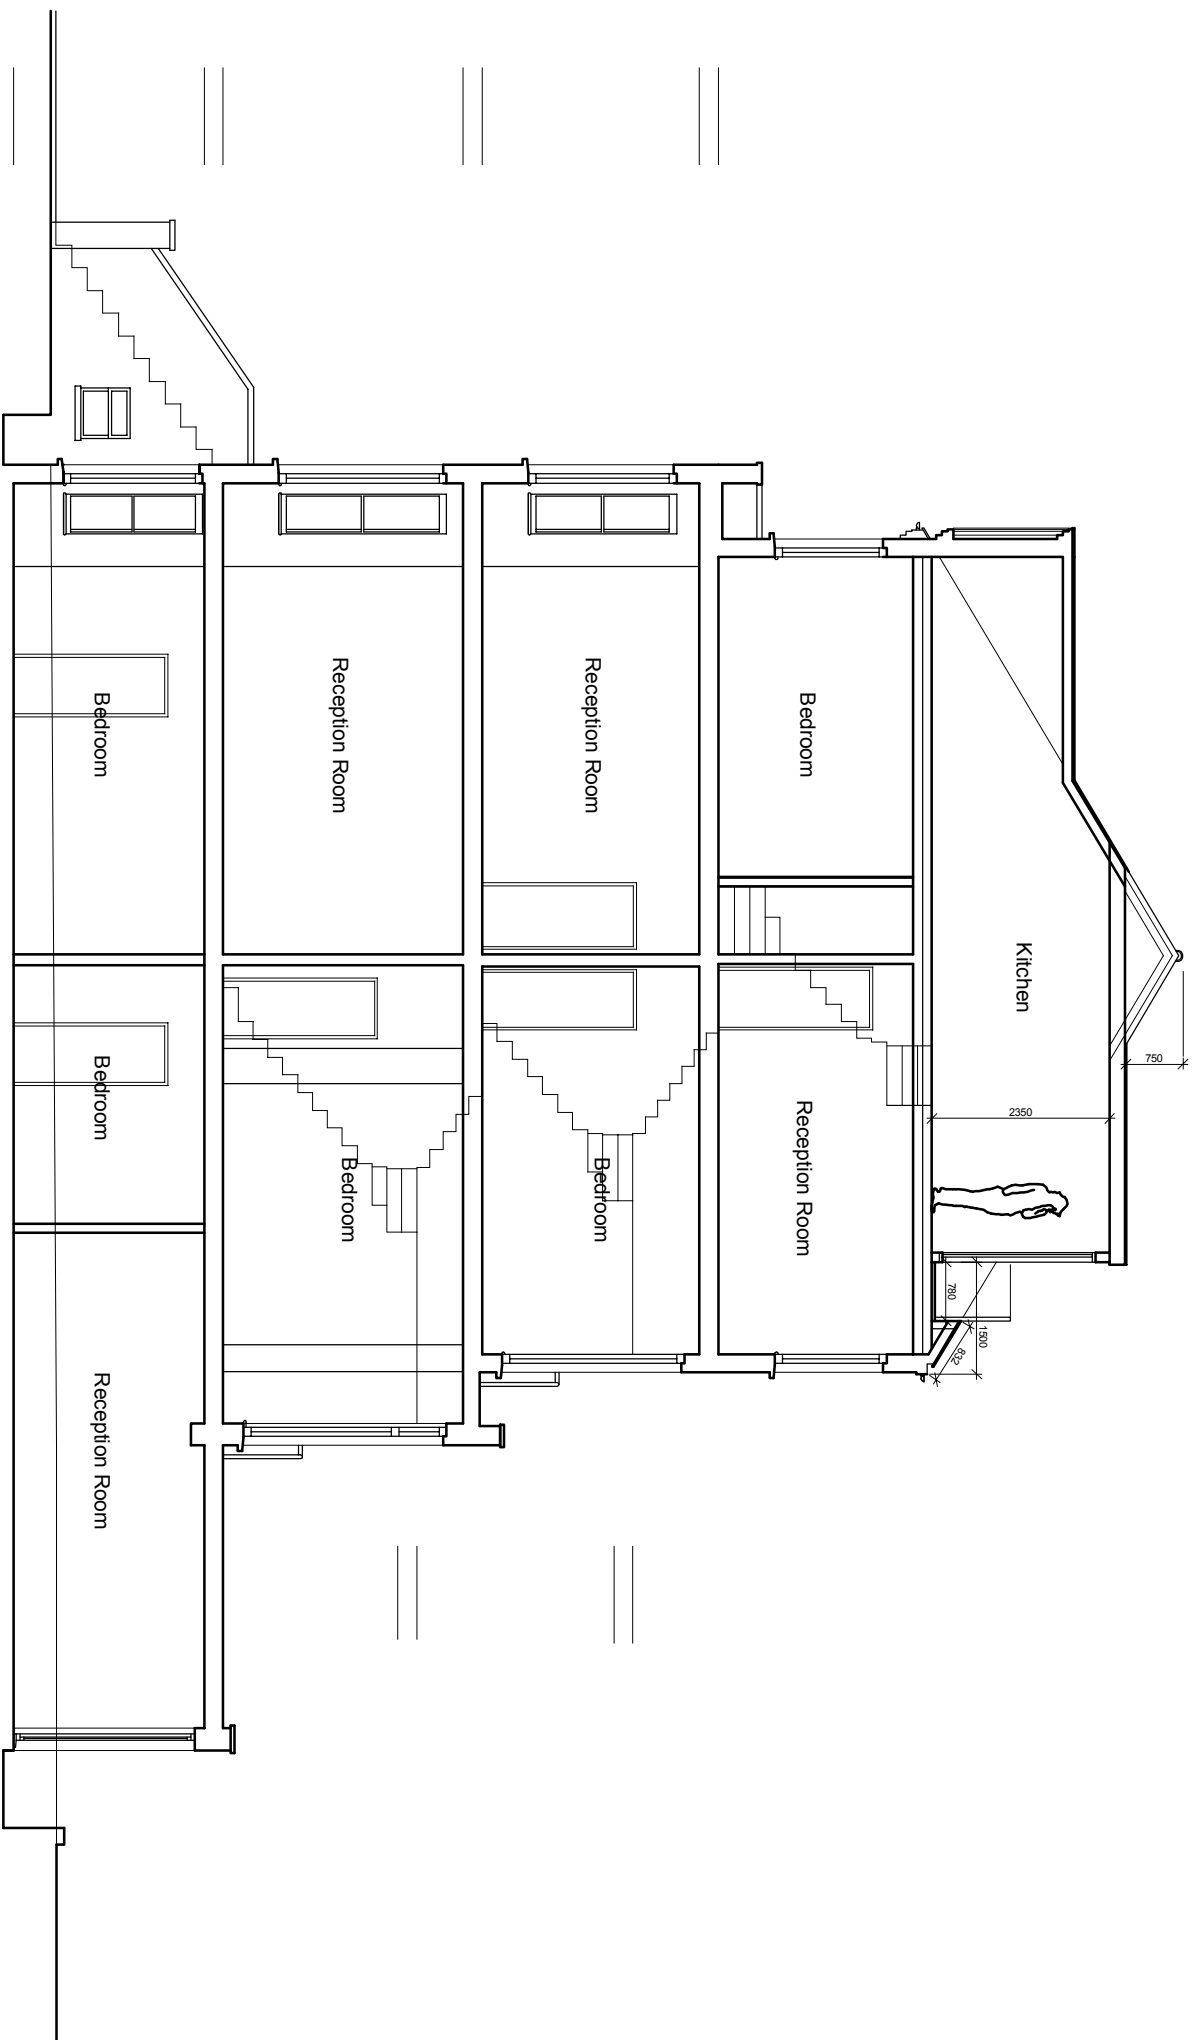

Proposed Section A-A

revisions Revised to as built B

project
45 Goldhurst Terrace
London
NW6

client
Mr Ivan Forster

drawing title
Proposed Section A-A

SEPIA DESIGN
Chartered Architectural Technologists

20-22 St Dunstons Road
Feltham, Middlesex
Tel: 0208 831 9629
Mob: 07595 032 939
E-mail: info@sepiaesign.co.uk



date Aug 15 number A9743PA008

scale 1:100 @ A3 revision B

© copyright