



FOR NOTES ON BALCONY AND SOFFIT  
CONSTRUCTION REFER TO DETAIL D-J-RC601

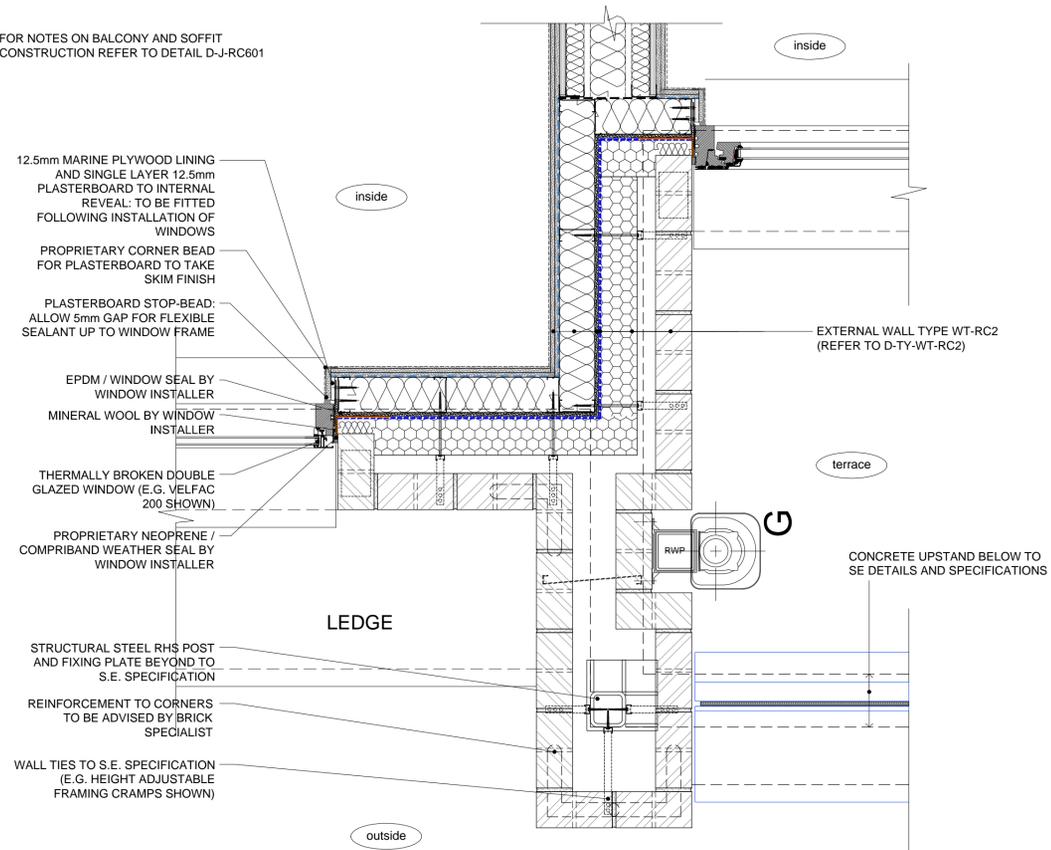

DETAIL - Block C - D-J-RC129 - Terrace over Communal Entrance Foyer (L02 GL J-06)

FOR NOTES ON BALCONY AND SOFFIT  
CONSTRUCTION REFER TO DETAIL D-J-RC601

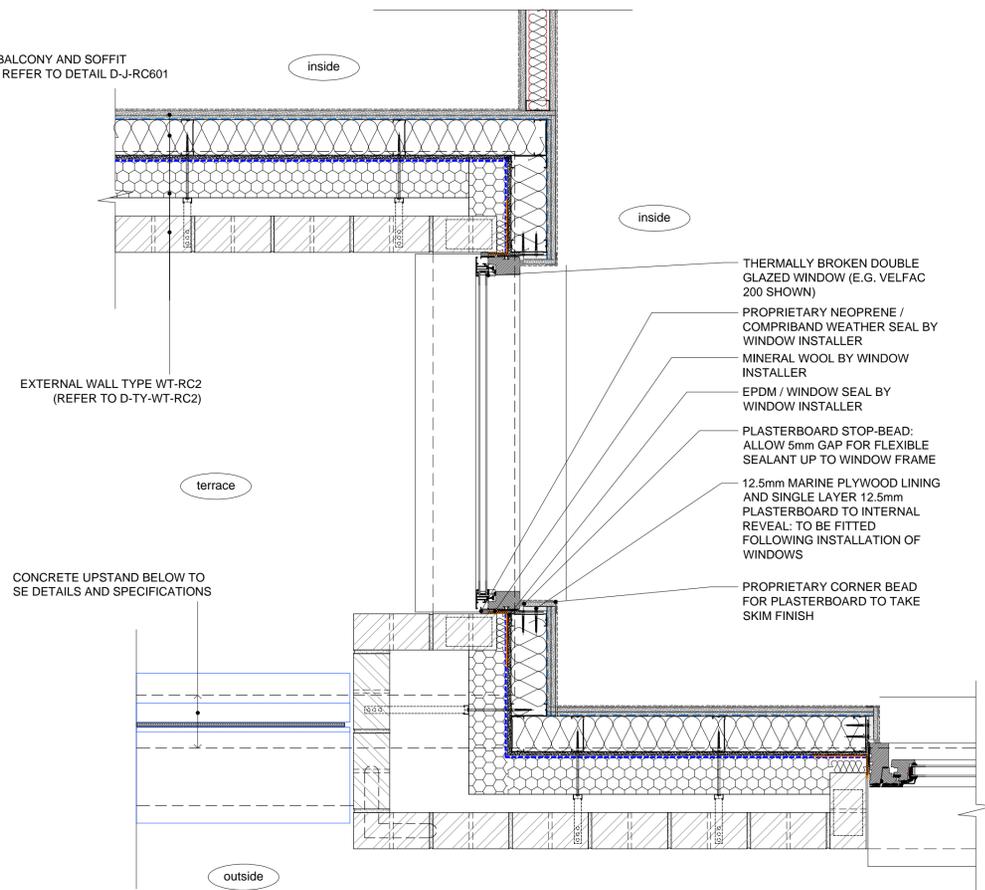


DETAIL - Block C - D-J-RC130 - Terrace over Communal Entrance Foyer (L02 GL J-07)

job	BACTON LOW RISE LONDON NWS	drawn:	date:
drawing	TYPICAL BLOCK C DETAILS External wall junctions - RC129 to RC130	scale:	job no:
		1:10 @ A1 1:20 @ A3	1952
note:	all dimensions to be checked on site at commencement of the work. If this drawing exceeds the quantities in any order, the client are to be informed before the work is commenced. For all applications for planning application purposes do not scale, use dimensions, this drawing is for information only.		
drawing no.	D-J-RC129 to D-J-RC132	rev.	as below

revisions	rev.	date	description	issued by	checked by
	C1	20.01.16	First Construction issue	RR	DWW

<i>Rydon</i>		
Received	Initial	Date
RYDON	RA	25 Jan 16
Client		
Status A - No Comments		<input type="checkbox"/>
Status B - Comments, Revise & Resubmit		<input checked="" type="checkbox"/>
Status C - Rejected		<input type="checkbox"/>
For Information Only		

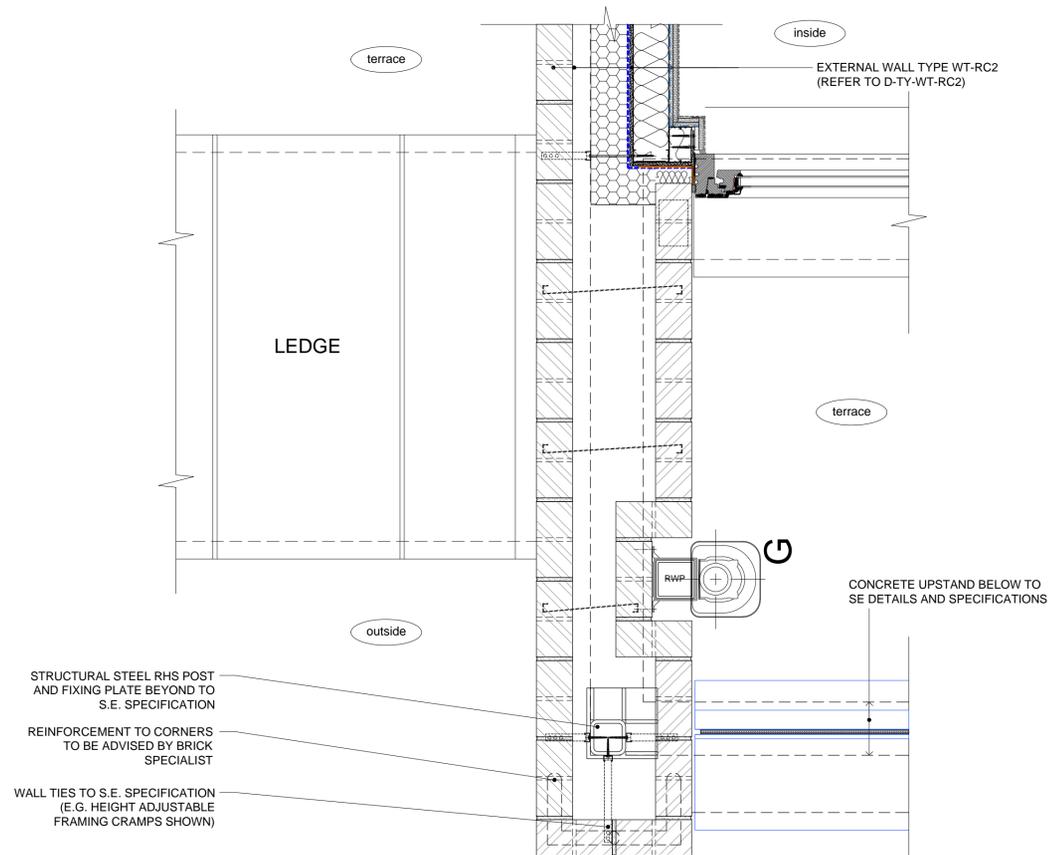

DETAIL - Block C - D-J-RC129 - Balcony over Communal Entrance Foyer (L05 GL J-06)

NOT  
USED

DETAIL - Block C - D-J-RC132