


FOR NOTES ON TERRACE AND SOFFIT
CONSTRUCTION REFER TO DETAIL D-J-RC604

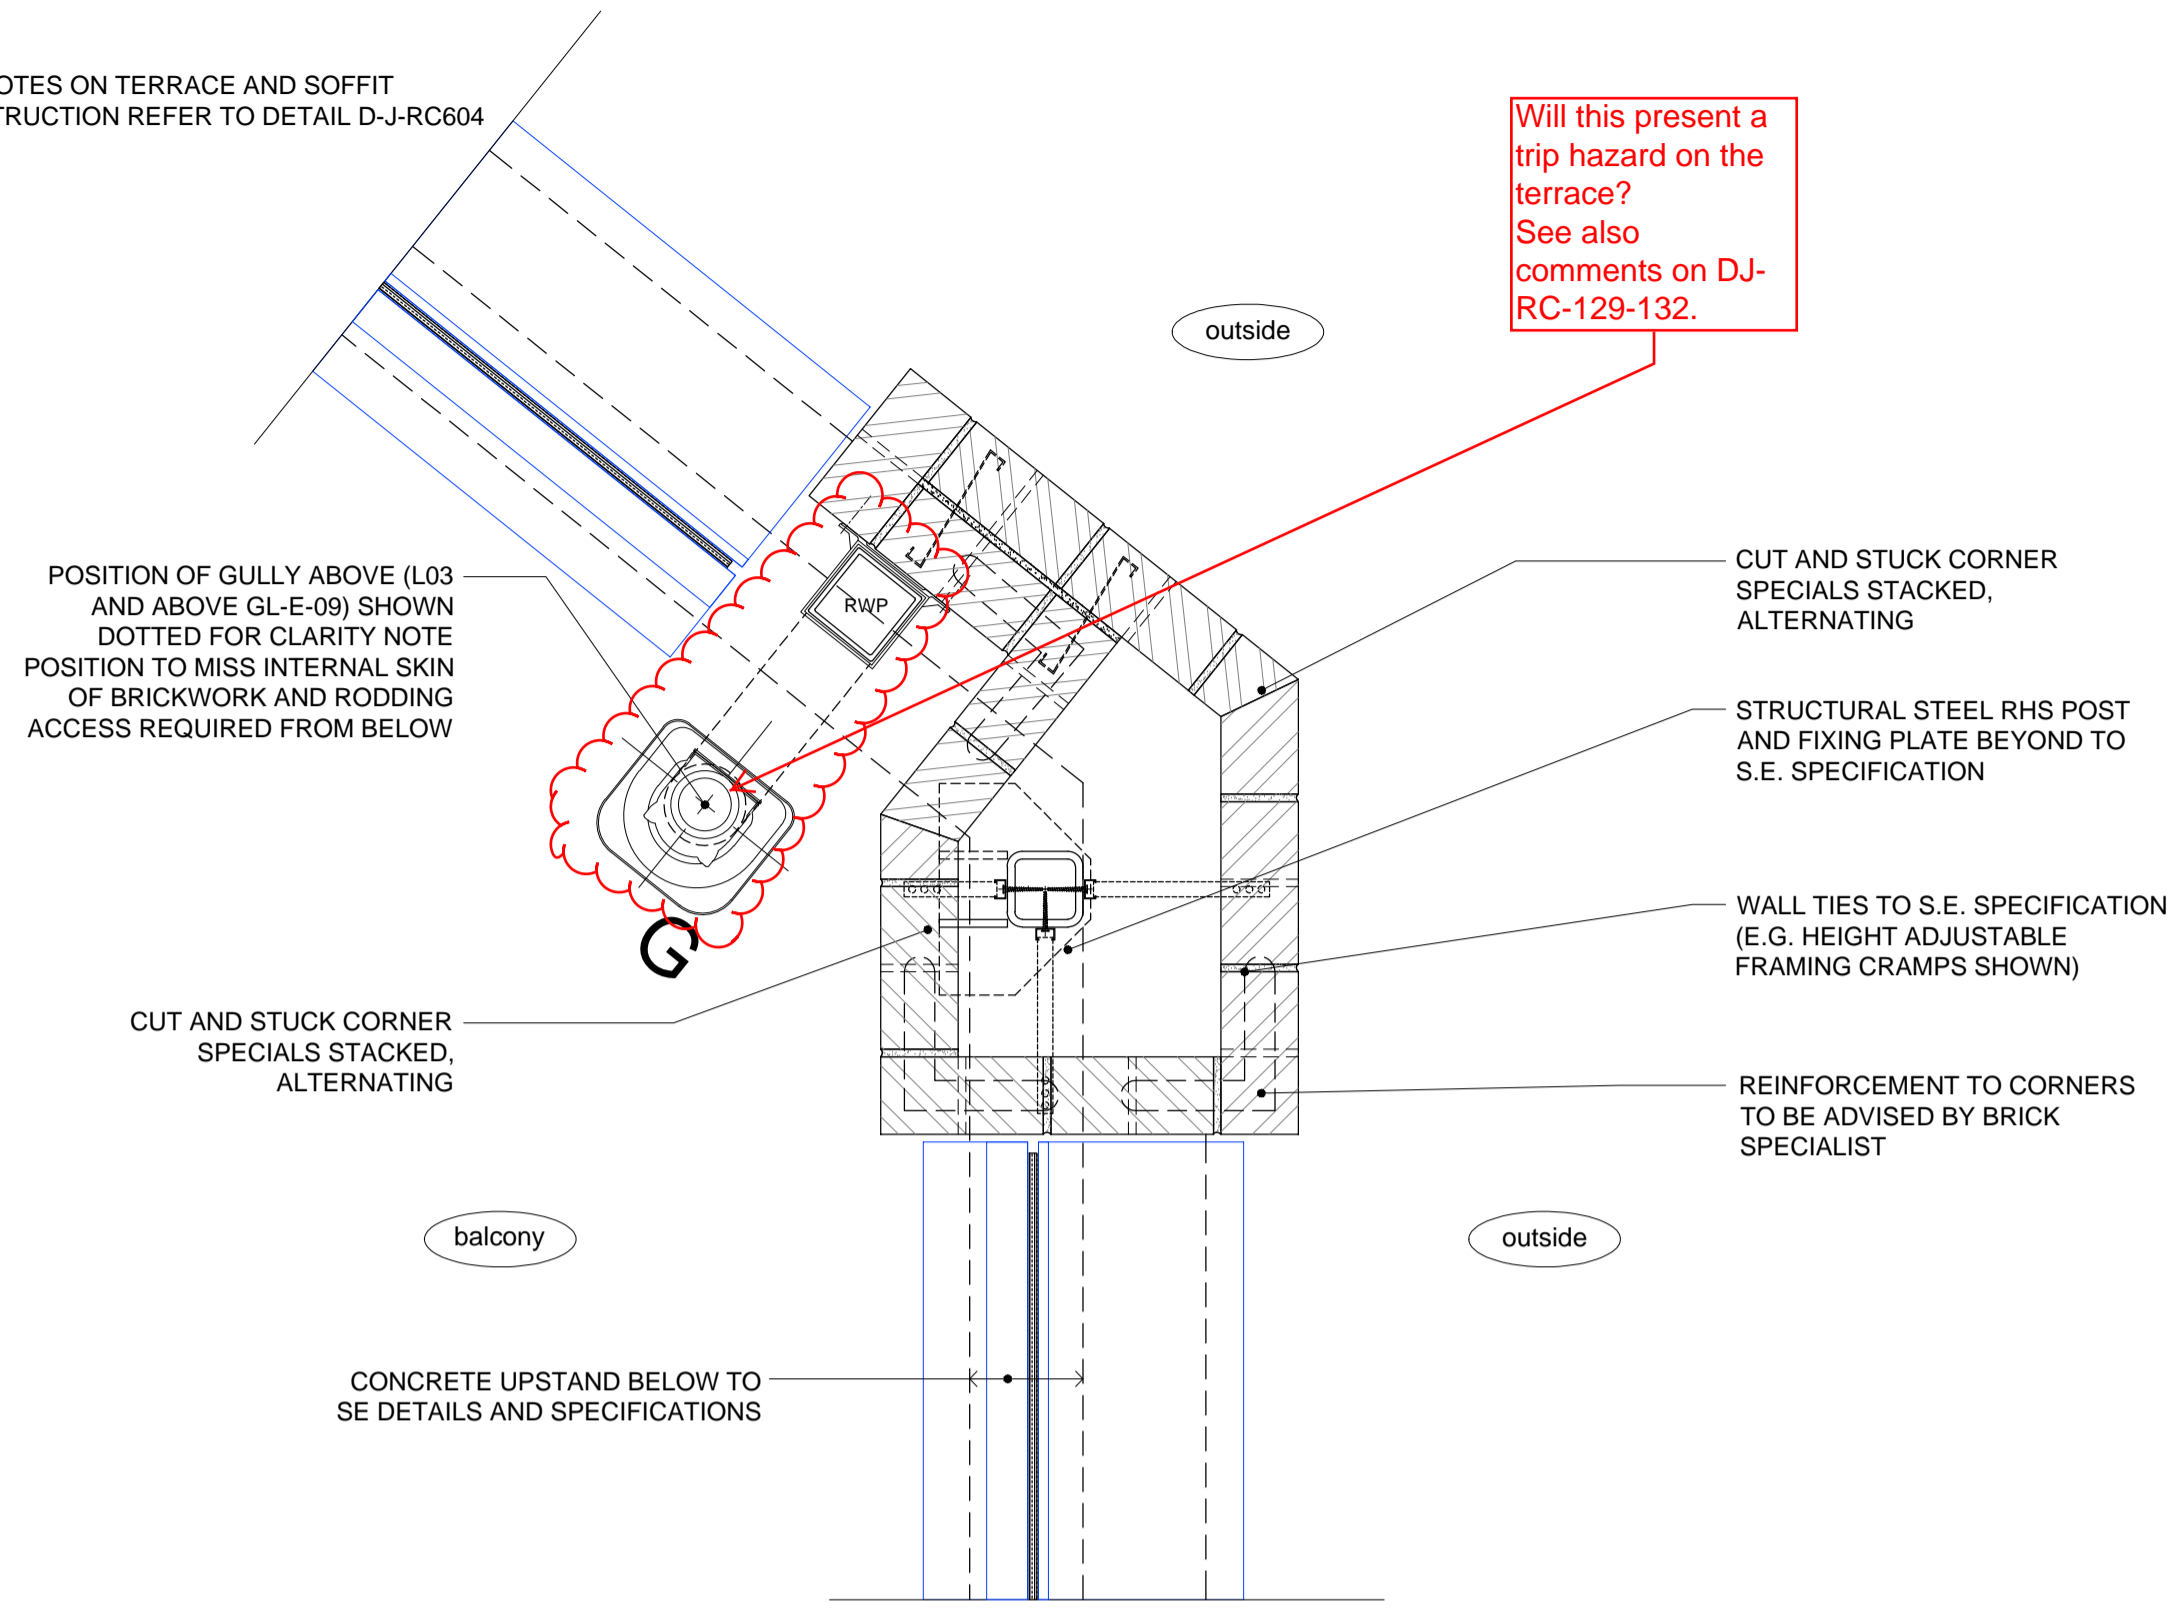


Will this present a trip hazard on the terrace?
See also comments on D-J-RC-129-132.

DETAIL - Block C - D-J-RC133 - Structural Post Encapsulation WT-RC1 (L03 to 07 GL E-09)

NOT
USED

FOR NOTES ON TERRACE AND SOFFIT
CONSTRUCTION REFER TO DETAIL D-J-RC604

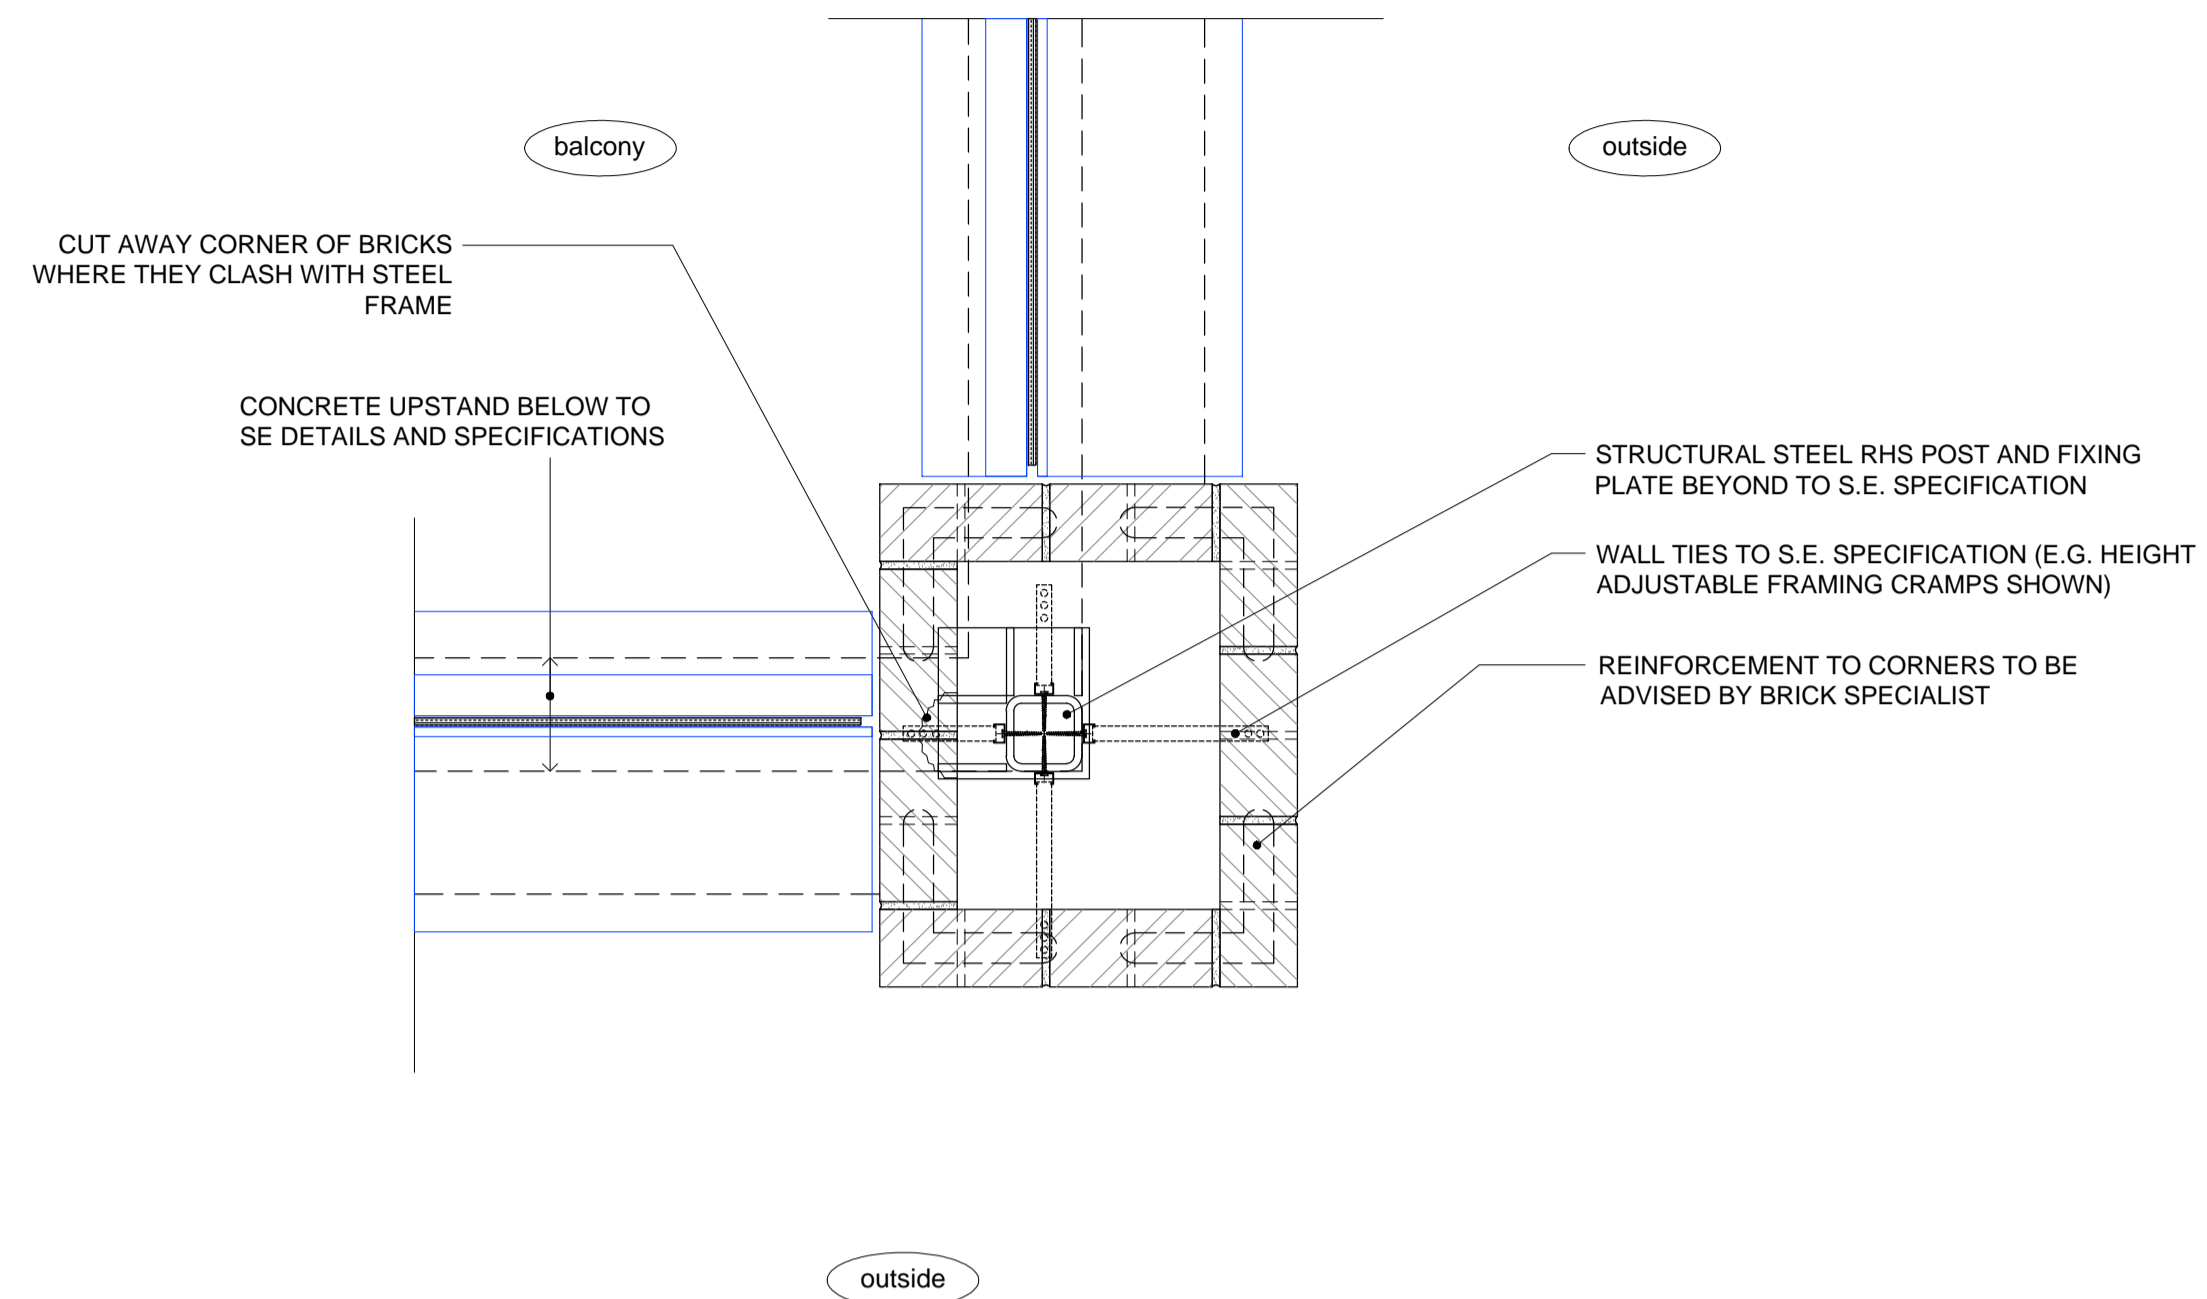

DETAIL - Block C - D-J-RC134 - Structural Post Encapsulation WT-RC1 (L03 to 07 GL J-09)

NOT
USED

job BACTON LOW RISE LONDON NWS	drawn: RR	date: 01.16
drawing TYPICAL BLOCK C DETAILS External wall junctions - RC133 to RC136	scale: 1:10 @ A1 1:20 @ A3	job no: 1952
note: all dimensions to be checked on site at commencement of the work. If this drawing exceeds the quantities in any bill of materials, the contractor is to be informed before the work is commenced. For all other applications from planning application purposes do not scale, use dimensions, this drawing is for information only.	drawing no. D-J-RC133 to D-J-RC136	rev. as below

rev.	date	description	issued by	checked by
C1	20.01.16	First Construction issue	RR	DWW

<i>Rydon</i>		
Received	Initial	Date
RYDON	RA	25 Jan 16
Client		
Status A - No Comments		<input type="checkbox"/>
Status B - Comments, Revise & Resubmit		<input checked="" type="checkbox"/>
Status C - Rejected		<input type="checkbox"/>
For Information Only		<input type="checkbox"/>