



RE: ACCREDITED DETAIL: MCI-RF-02

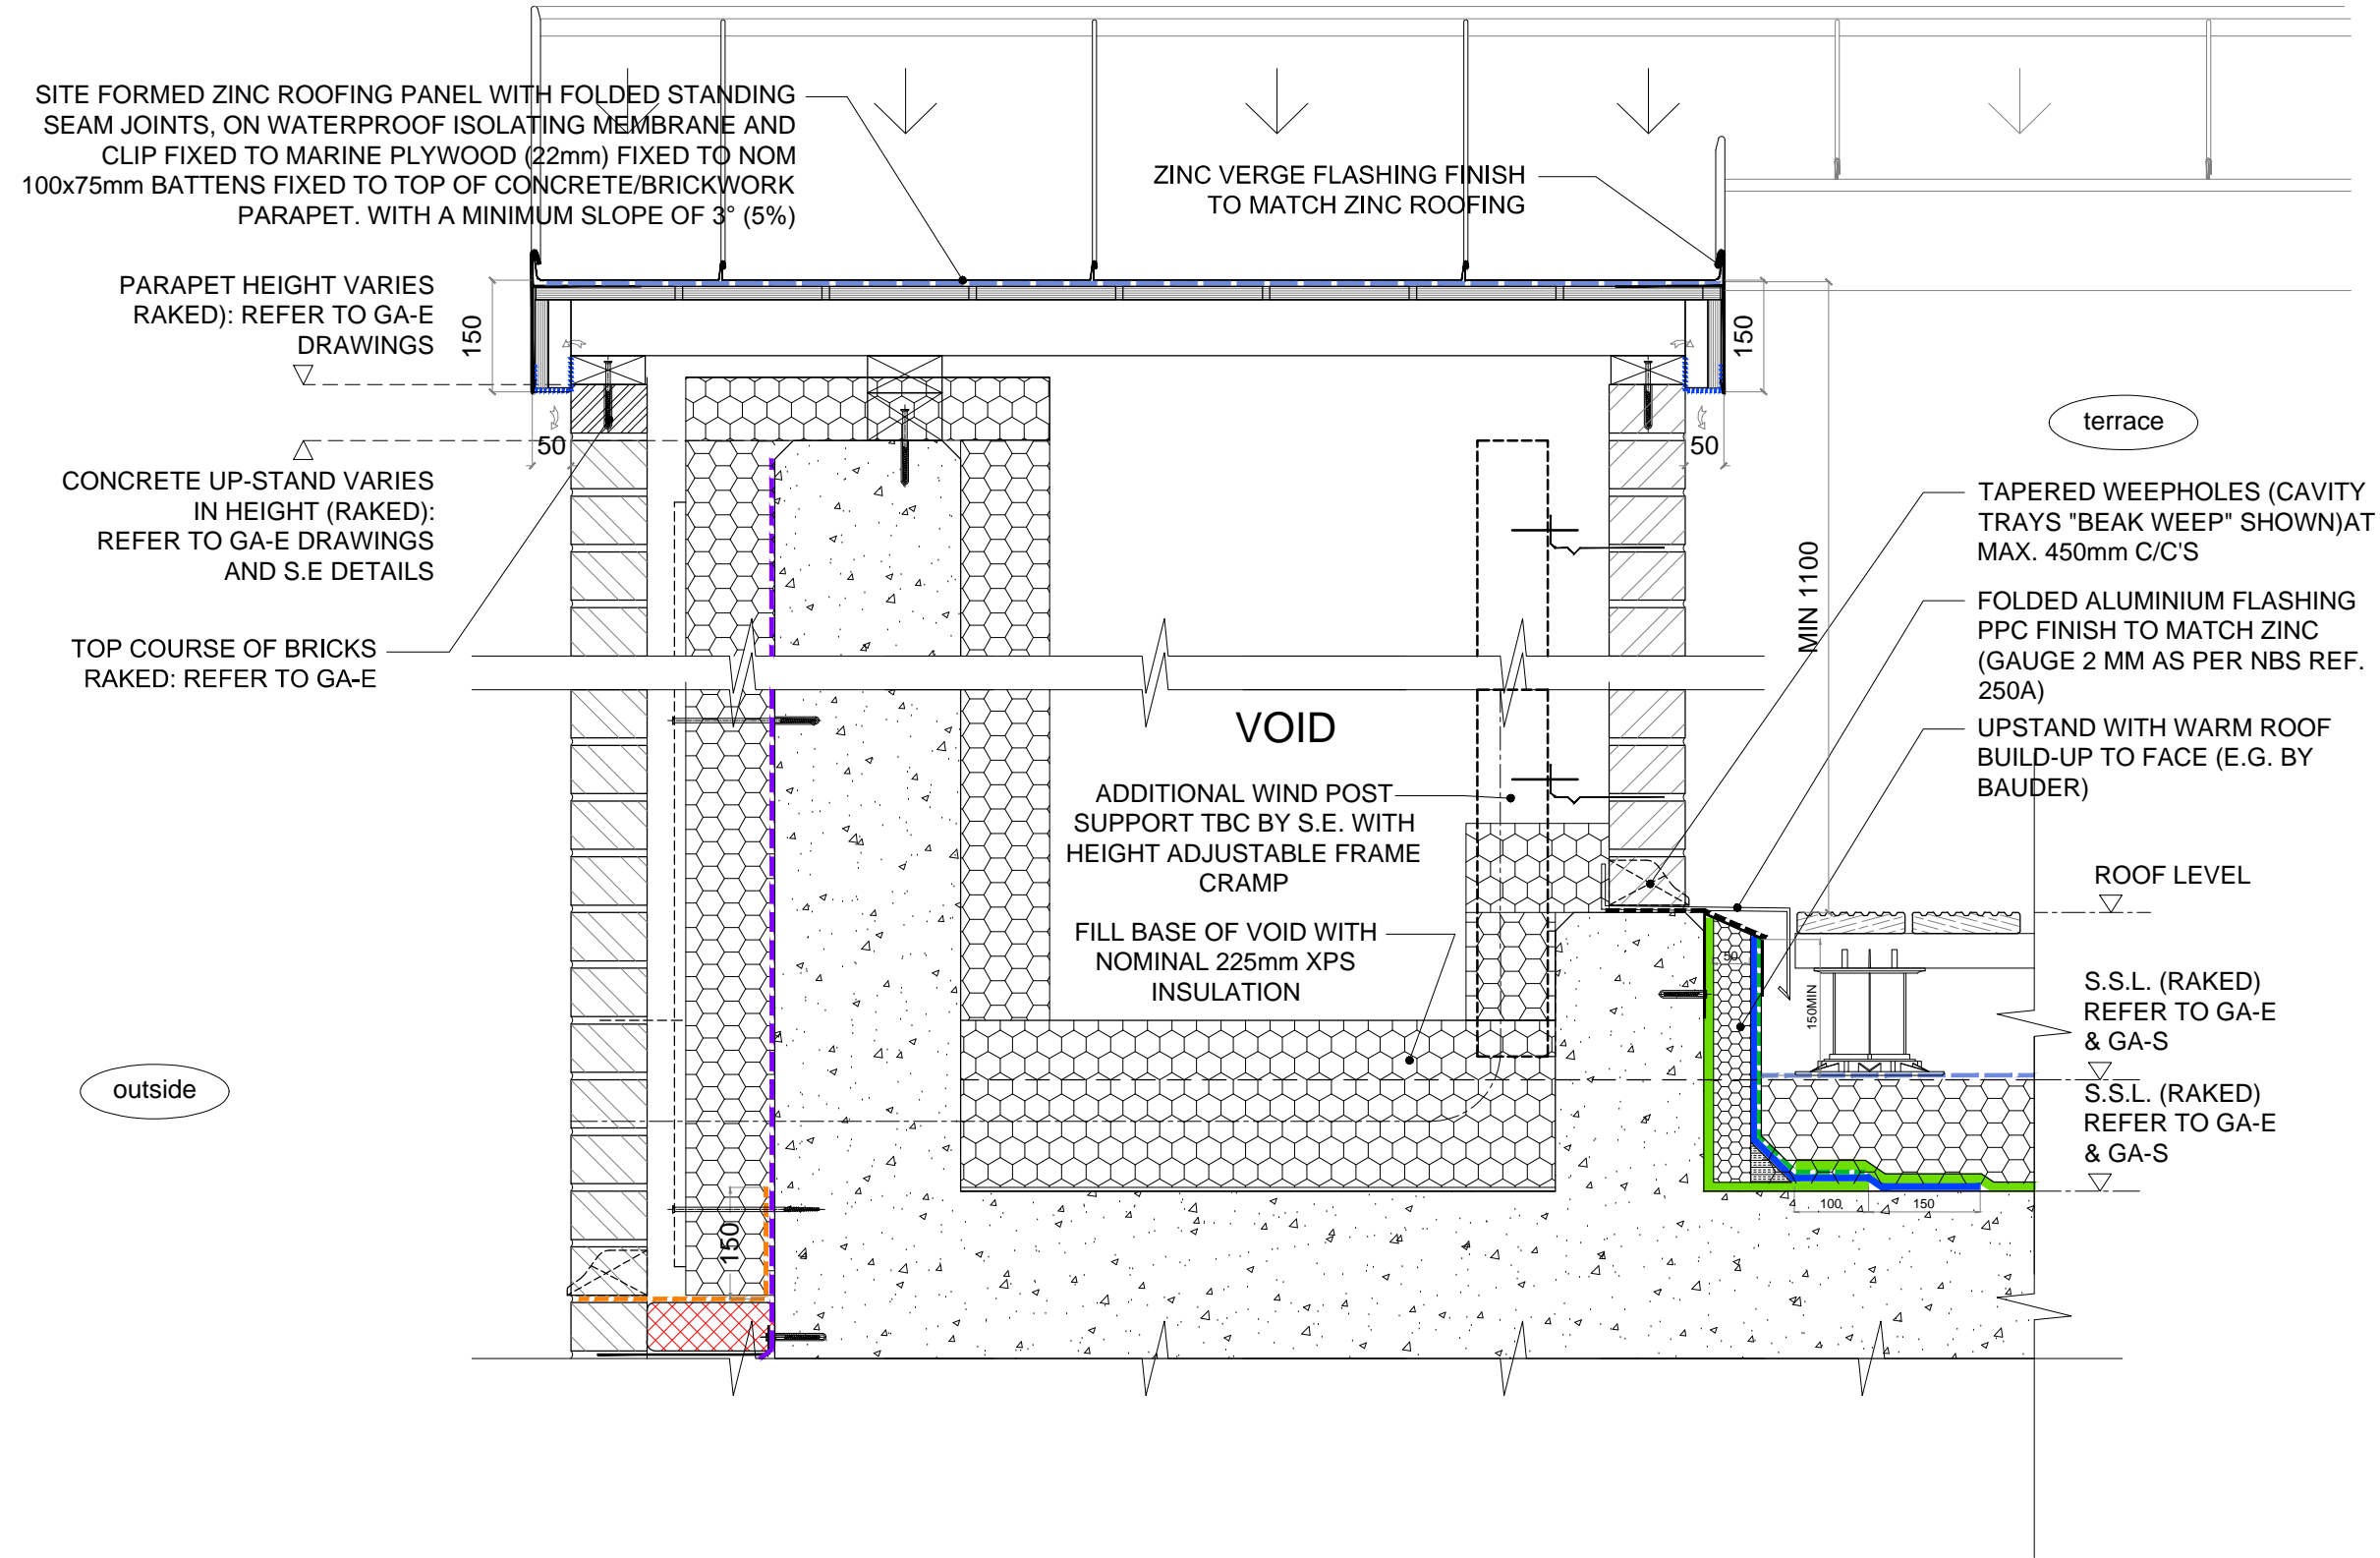


DETAIL - Block C - D-J-RC225 - Through fall in roof/parapet (L05 GL D-05/06)

RE: ACCREDITED DETAIL: MCI-RF-02

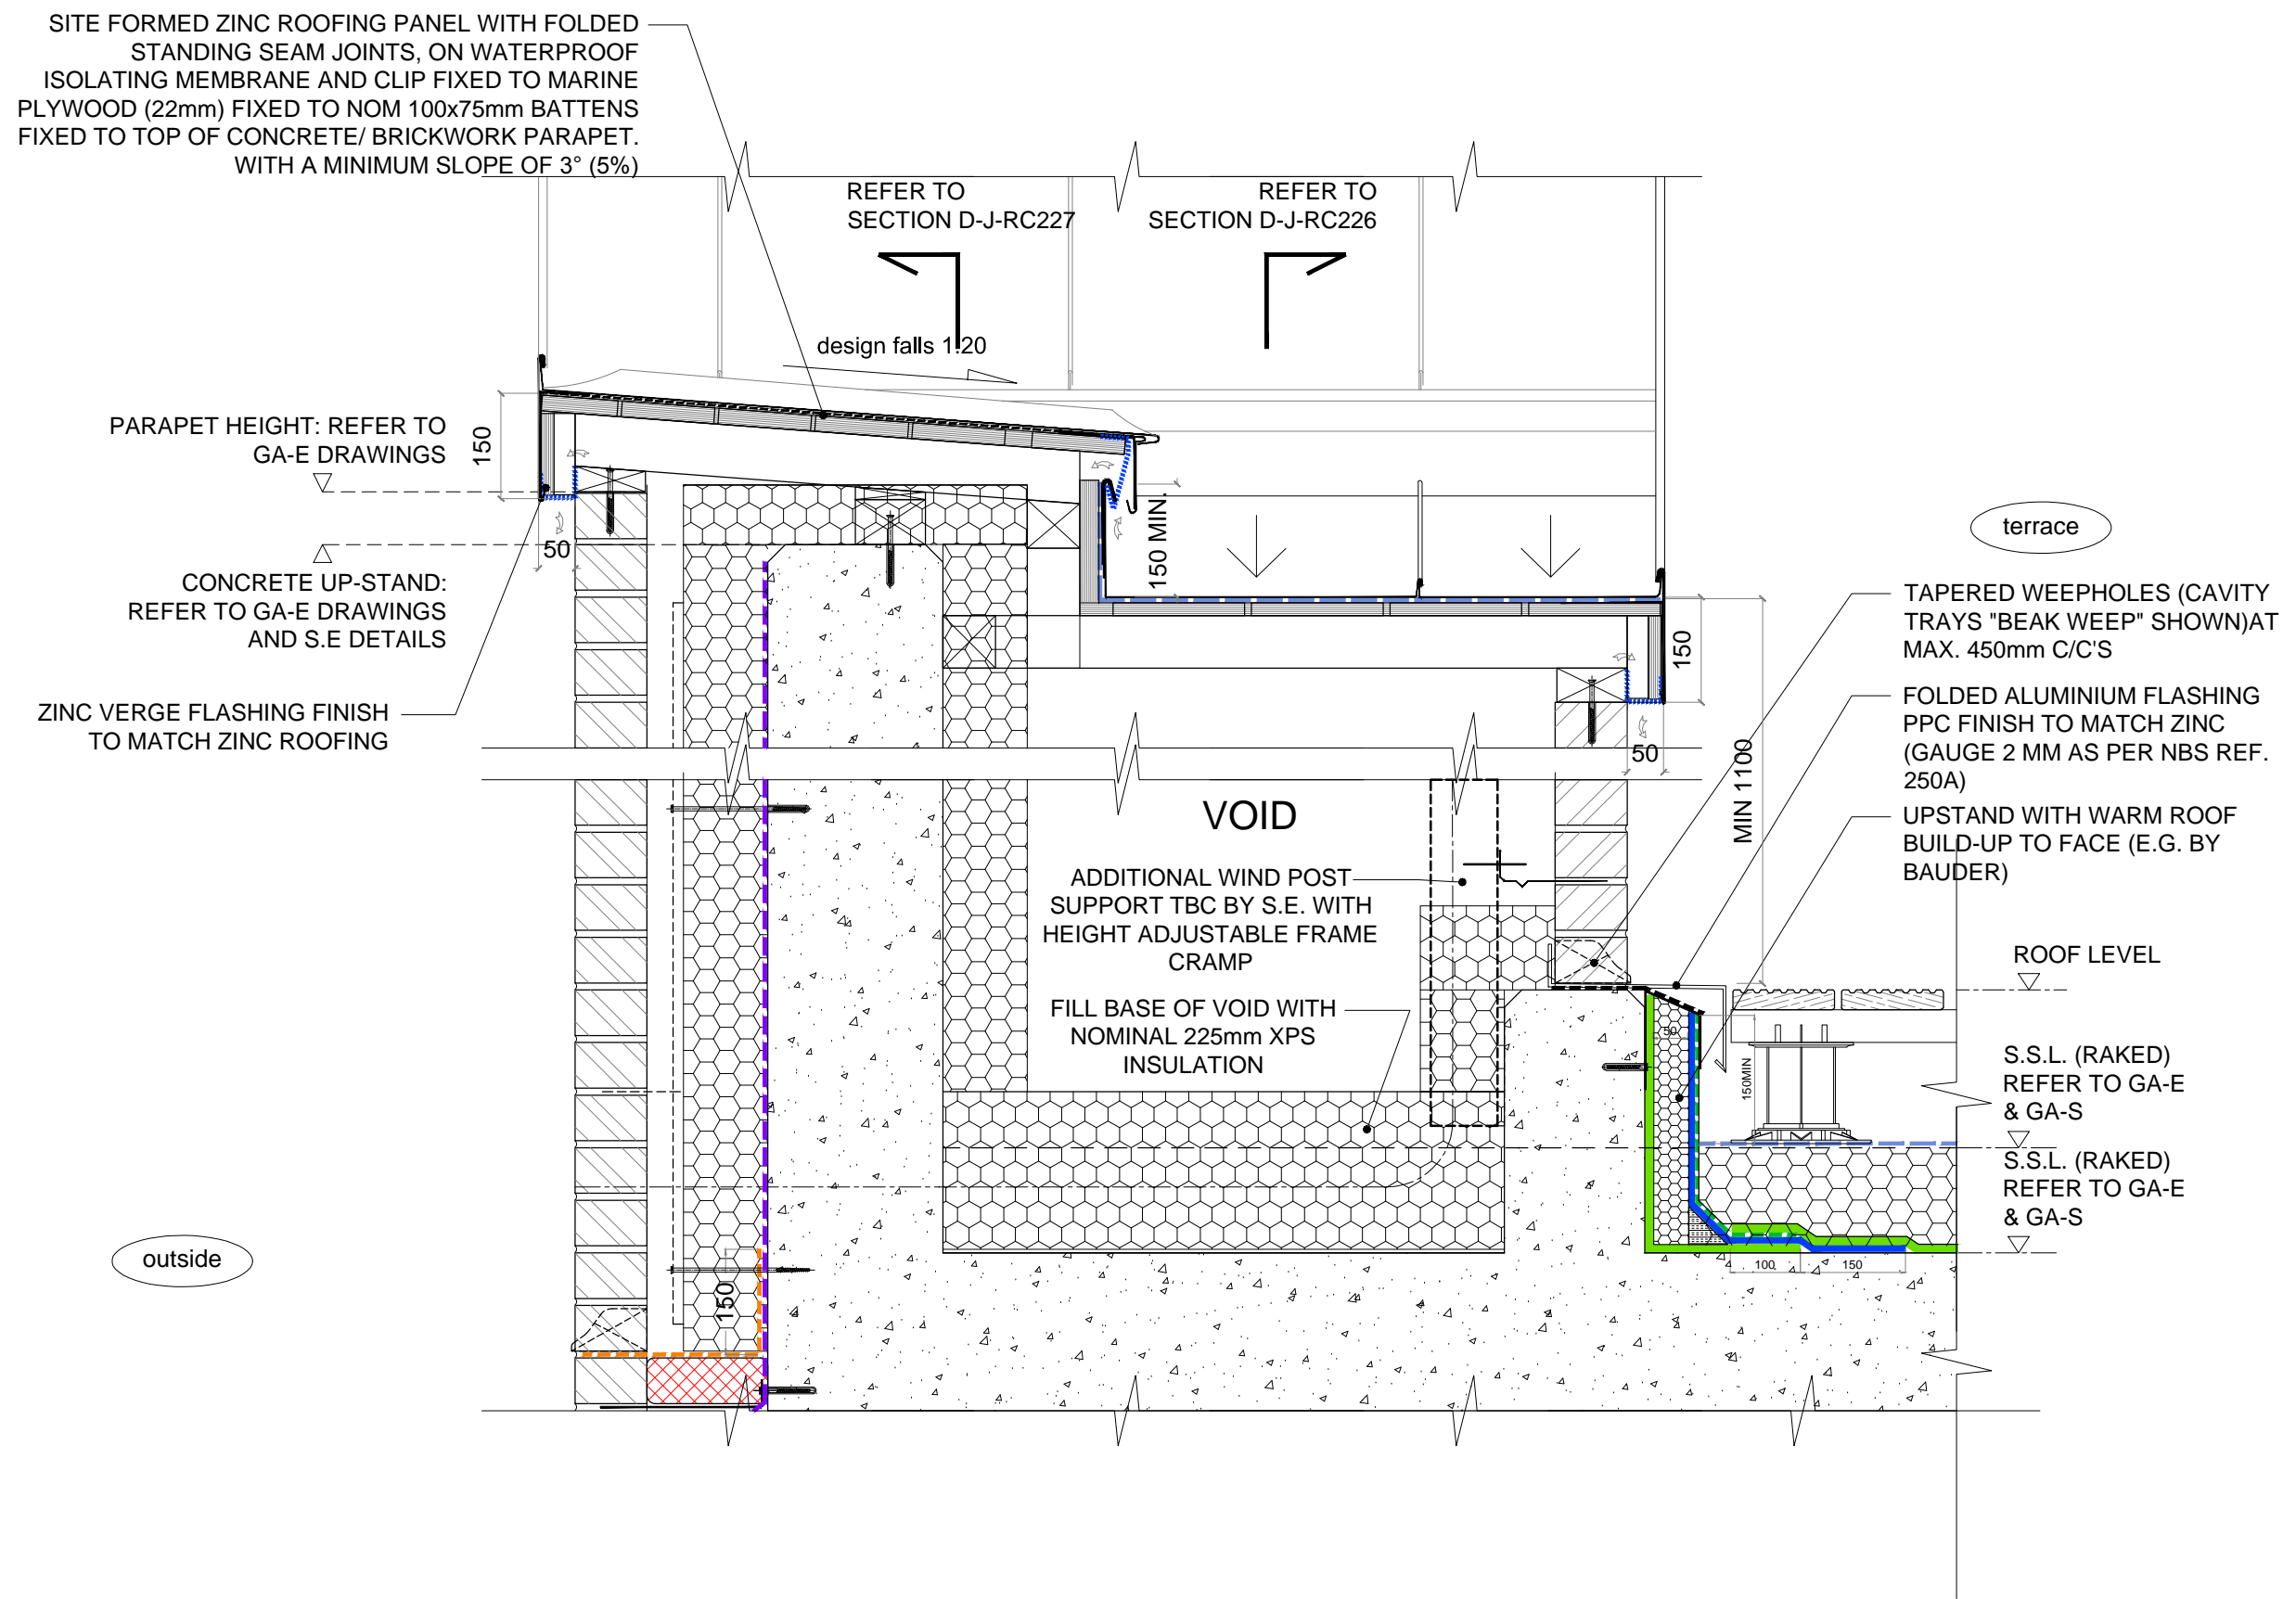


DETAIL - Block C - D-J-RC226 - Parapet/Transition of fall (L05 GL G1/H-05)

RE: ACCREDITED DETAIL: N/A

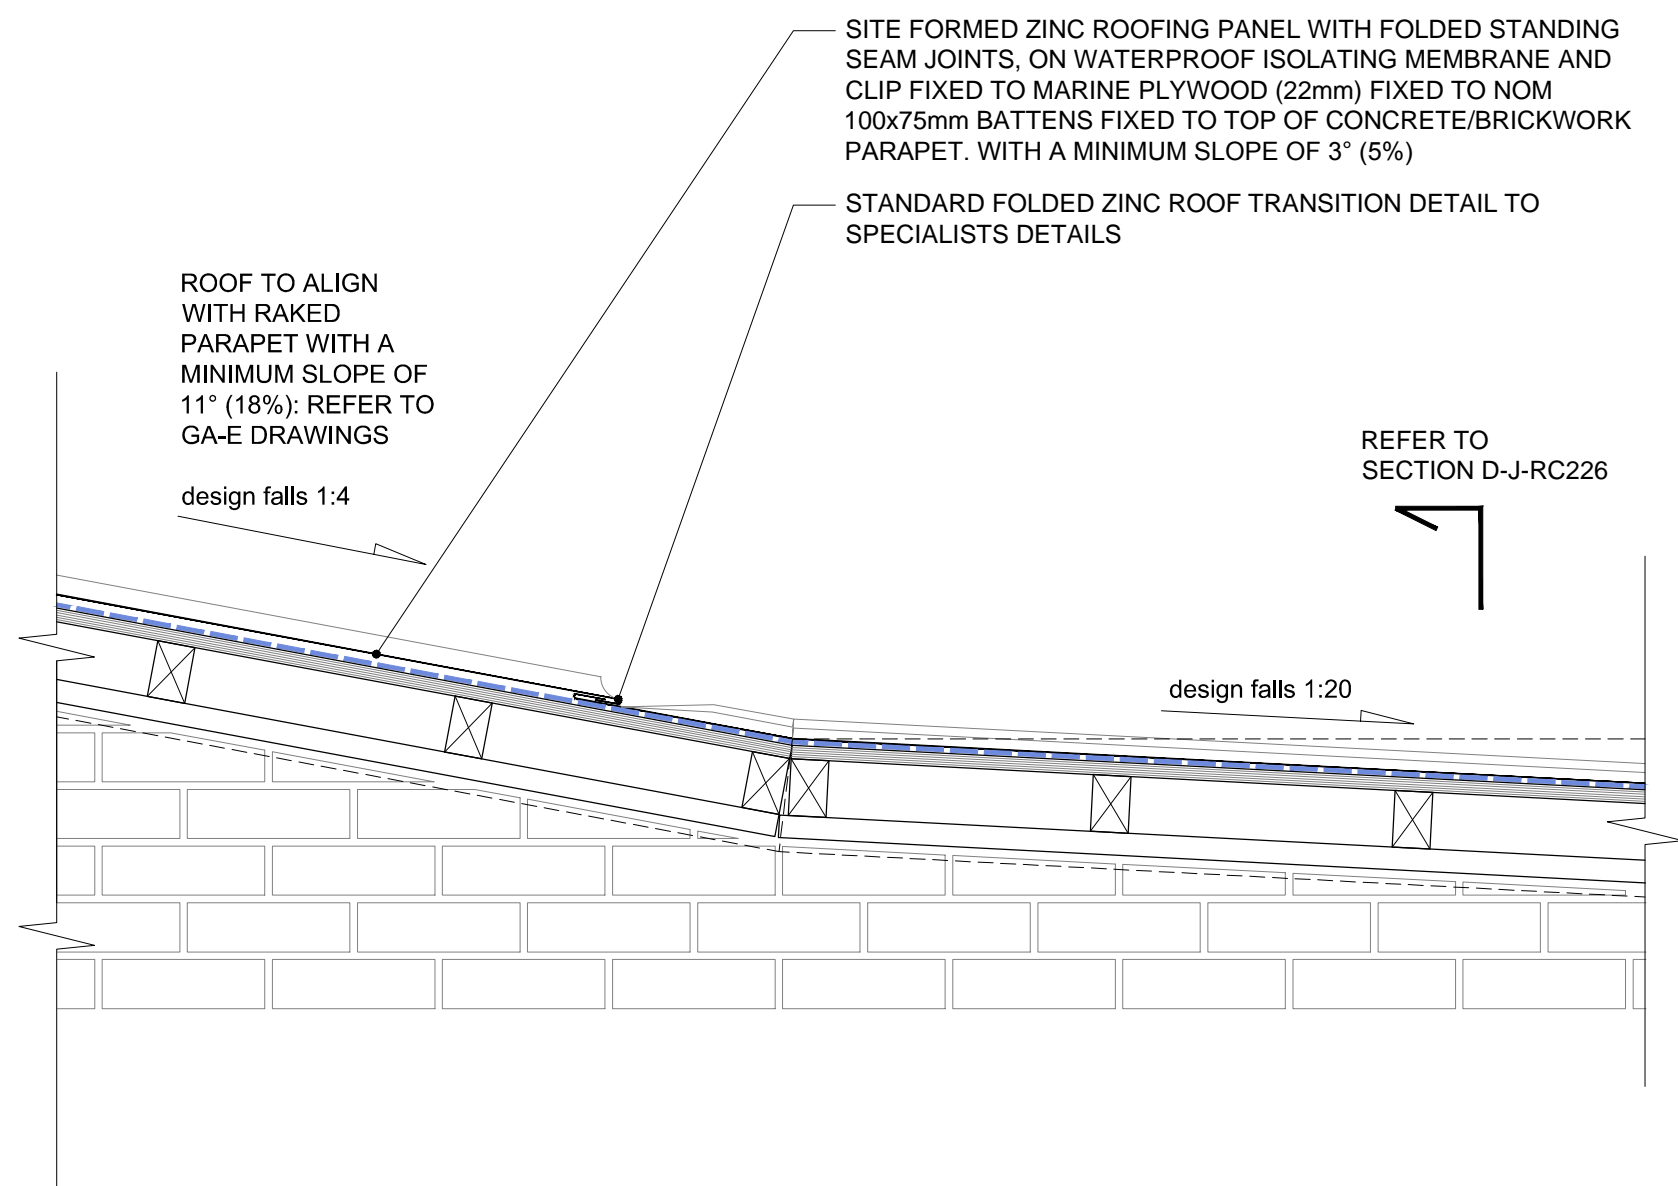

DETAIL - Block C - D-J-RC227 - Transition of fall (L05 GL G1/H-05)

RE: ACCREDITED DETAIL: MCI-RF-02

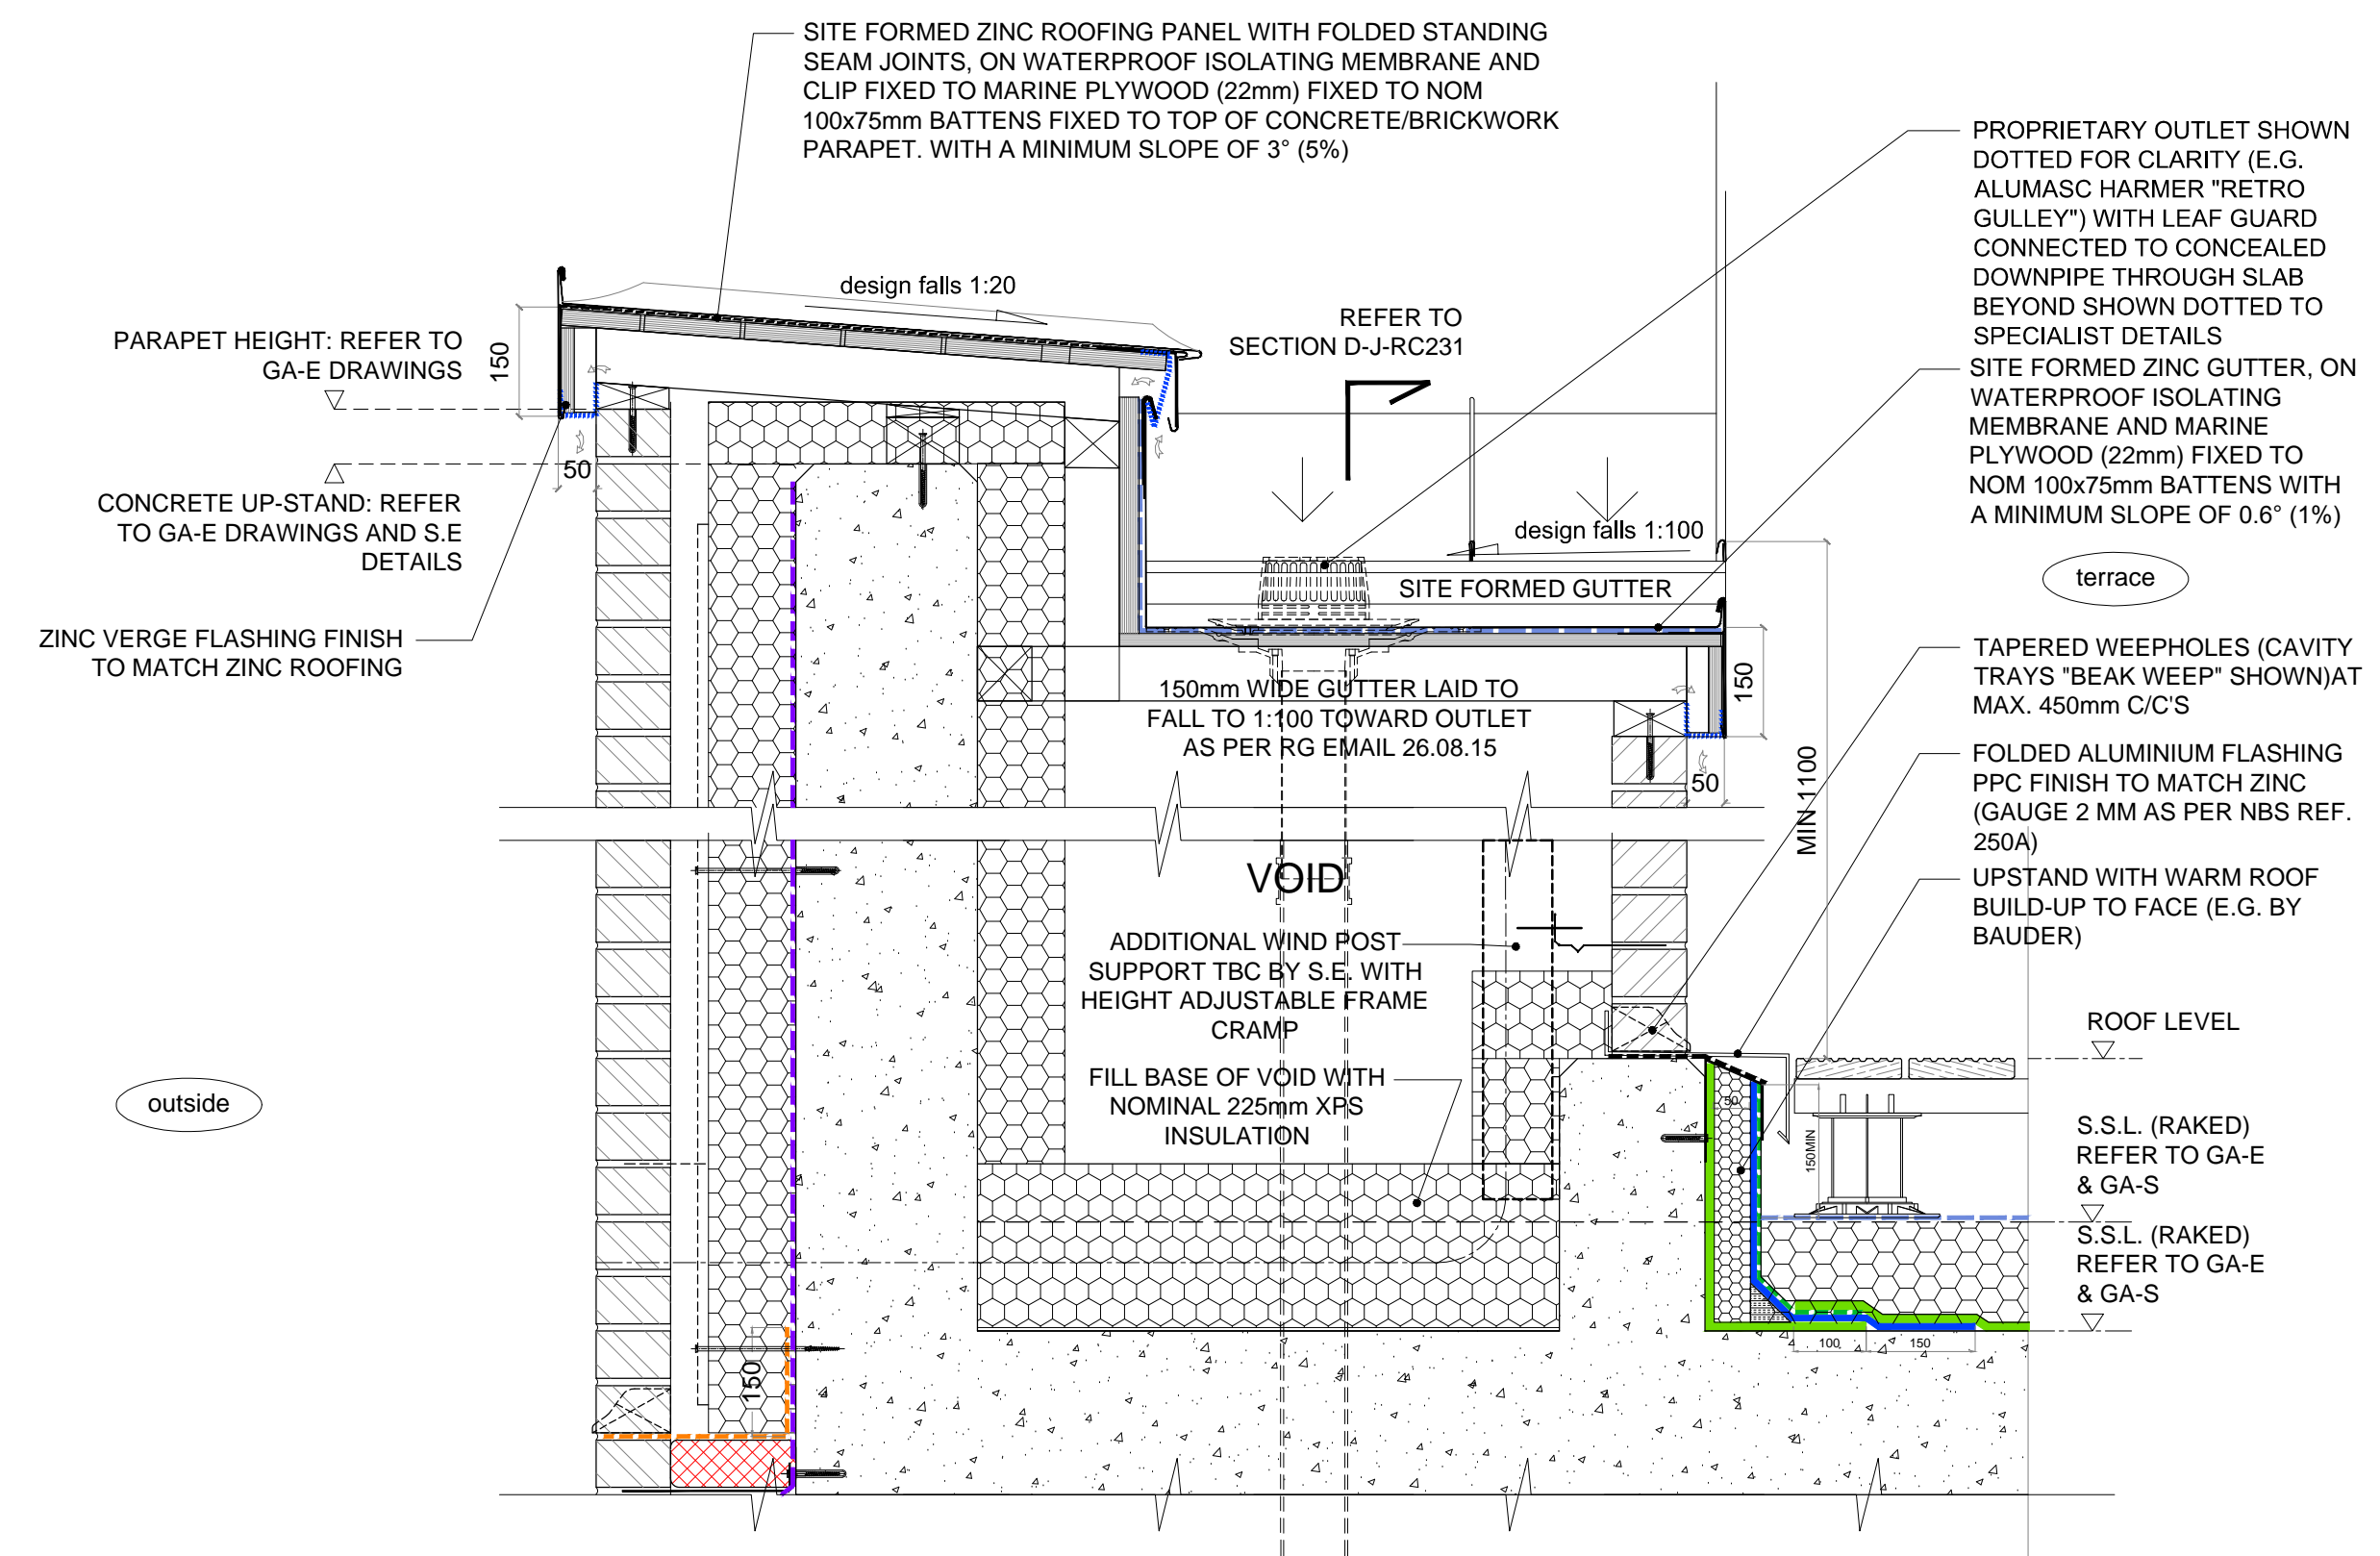

DETAIL - Block C - D-J-RC228 - Gutter (L05 GL H/J-05)

job	BACTON LOW RISE LONDON NWS	drawn:	DWW	date:	02.16
drawing	TYPICAL BLOCK C DETAILS Roof junctions - RC225 to 228	scale:	1:10 @ A1 1:20 @ A3	job no:	1952
note:	all dimensions to be checked on site at commencement of the work. If this drawing exceeds the quantities in any bill of materials to be informed before the work is commenced. For all other purposes from planning application purposes do not scale, use dimensions, this drawing is for reference only.				
revisions		drawing no.	D-J-RC225	rev.	as below

rev.	date	description	issued by	checked by
C1	05.02.16	First issue for Construction	DWW	RR

Rydon		
Received	Initial	Date
RYDON	RA	1 Apr 16
Client		
Status A - No Comments		<input type="checkbox"/>
Status B - Comments, Revise & Resubmit		<input type="checkbox"/>
Status C - Rejected		<input checked="" type="checkbox"/>
For Information Only		<input type="checkbox"/>

TO BE AMMENDED AS DISCUSSED IN MEETING WITH SPECIALIST 10 MARCH 16