

job no.	client	date:
BACTION LOW RISE	RYDON	01.16
drawing no.	scale:	job no.:
D-J-RC301	1:10 @ A1	1962
D-J-RC304	1:20 @ A3	

NOTE: ALL DIMENSIONS TO BE CONFIRMED BY THE CONTRACTOR. THE CONTRACTOR SHALL BE RESPONSIBLE FOR VERIFYING THE EXISTING CONDITIONS AND FOR OBTAINING ALL NECESSARY APPROVALS PRIOR TO COMMENCING WORK. THE CONTRACTOR SHALL BE RESPONSIBLE FOR OBTAINING ALL NECESSARY APPROVALS PRIOR TO COMMENCING WORK. THE CONTRACTOR SHALL BE RESPONSIBLE FOR OBTAINING ALL NECESSARY APPROVALS PRIOR TO COMMENCING WORK.

rev.	date	description	issued by	checked by
C1	20.01.16	First Construction Issue	RR	DWW
C2	04.05.16	Imperious splash zone indicated and depth of channel highlighted as per email comments dated 03.05.16	DWW	JD

Received	Initial	Date
	RA	17 May 16

Client

Status A - No Comments


Status B - Comments, Revise & Resubmit

Status C - Rejected

For Information Only

NOT USED

DETAIL - Block C - D-J-RC301

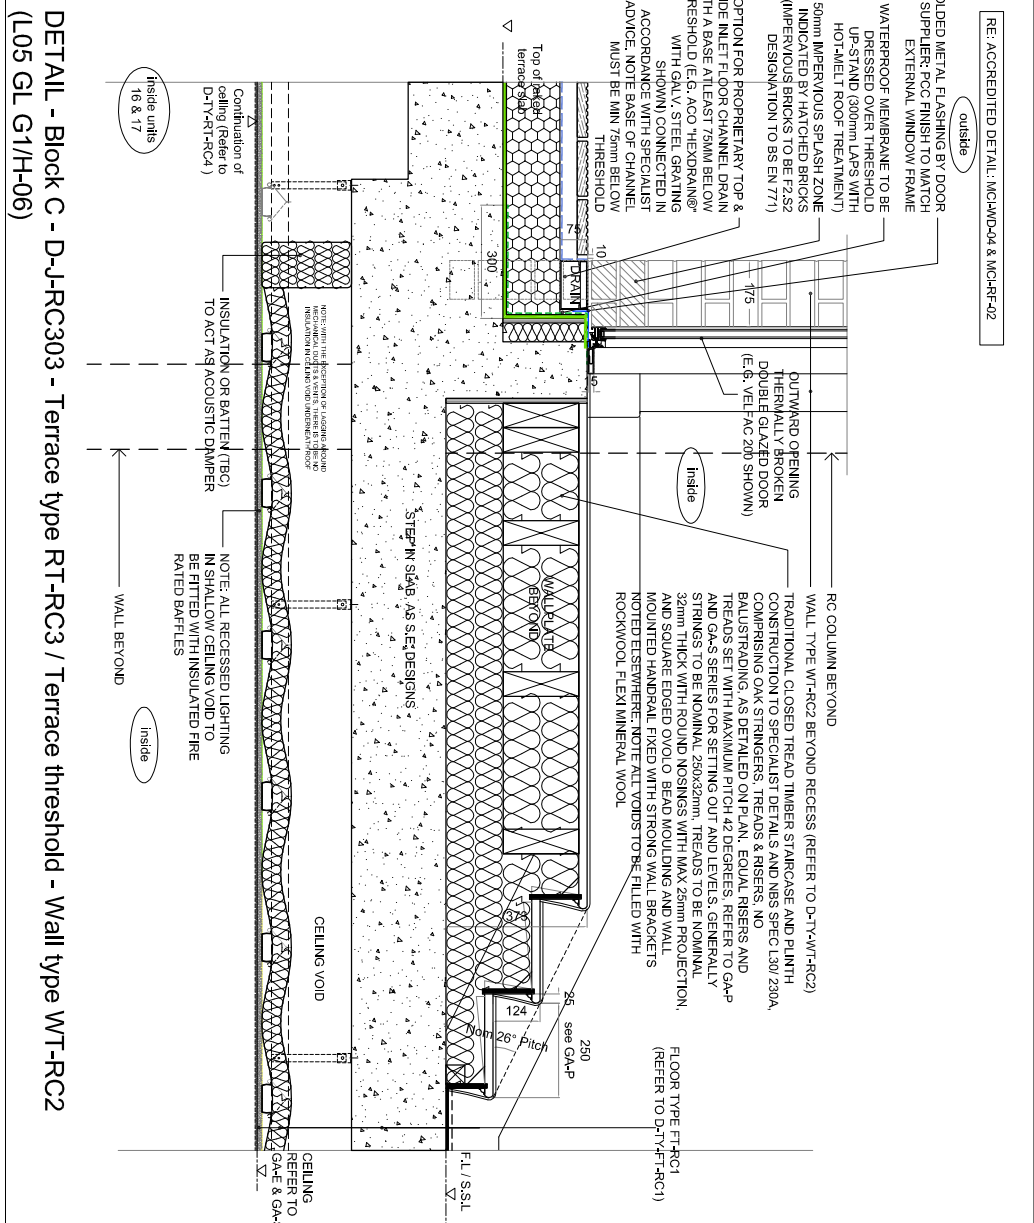

DETAIL - Block C - D-J-RC302 - Upper floor windows / Juliet balcony - Wall type WT-RC2

