




1. ALL MEASUREMENTS/DIMENSIONS TO BE CHECKED ON SITE PRIOR TO UNDERTAKING ANY WORKS.

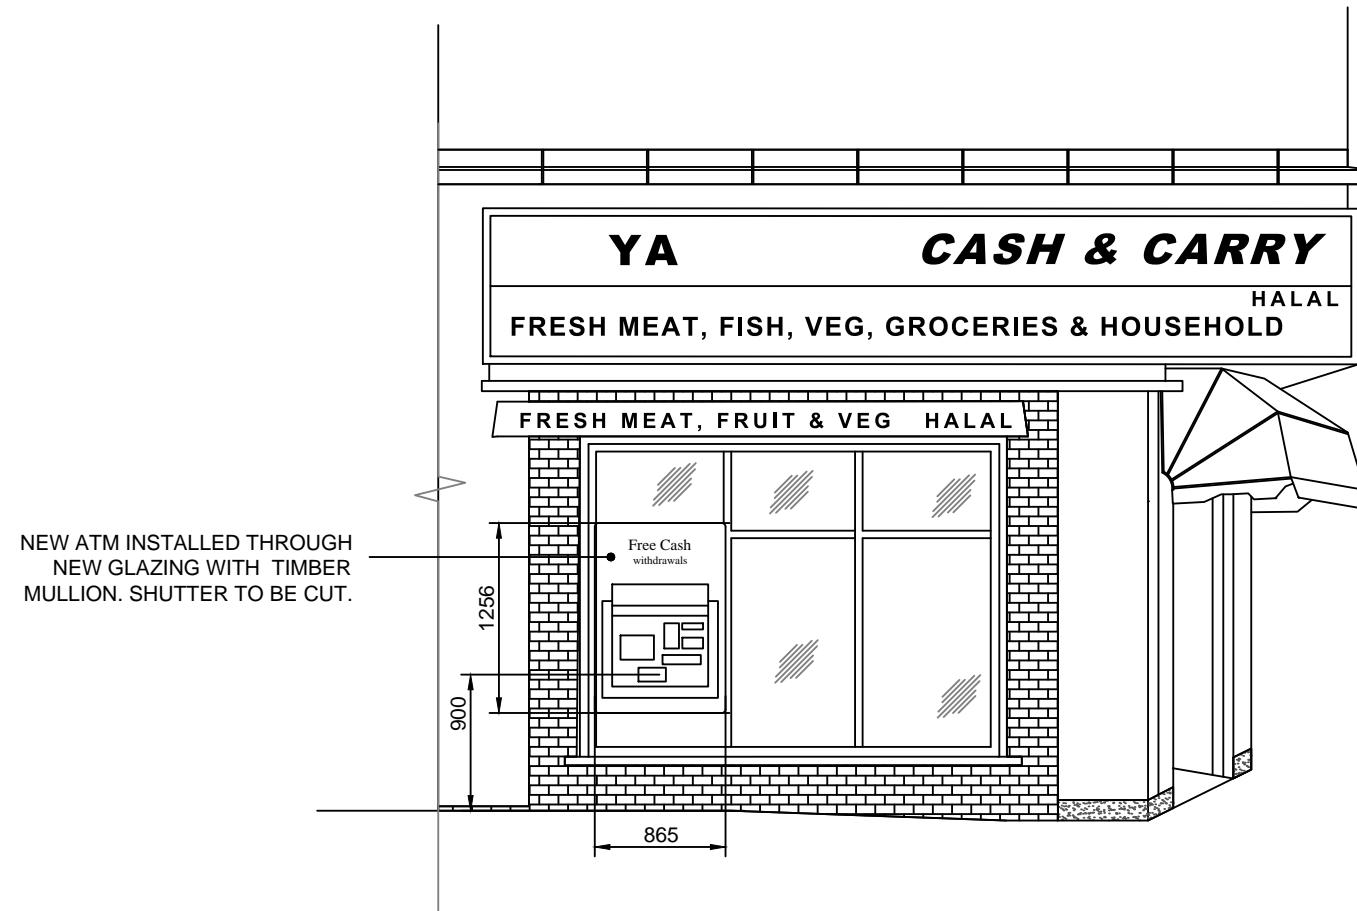

AS INSTALLED FRONT ELEVATION
SCALE 1:50

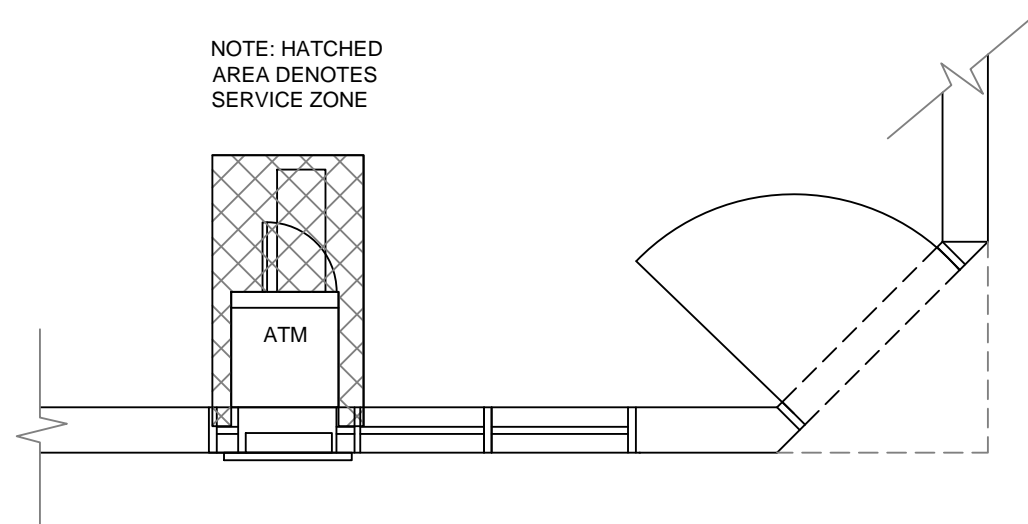

AS INSTALLED PART PLAN
SCALE 1:50

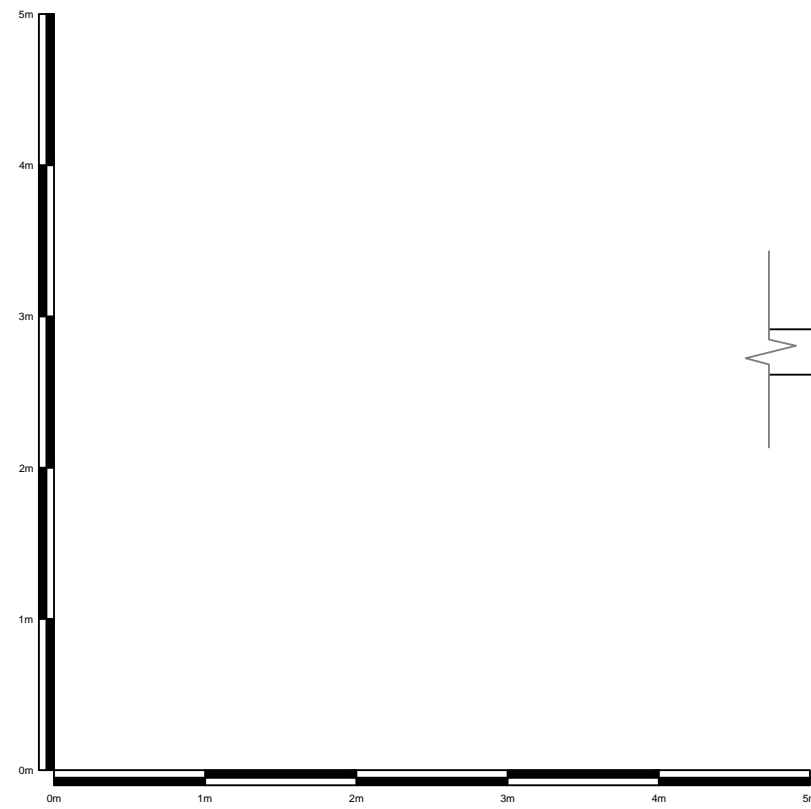

REV.	DATE	BY	DESCRIPTION
1	27/06/16	JML	Amended Following Comments

NOTE MACHINE

NoteMachine UK Ltd

Elvicta Business Park, Crickhowell, Powys, NP8 1DF
Tel: 01873 811 634 Fax: 01873 811 552

CLIENT
STEVEN LEE SUPERMARKET

TITLE
**AS INSTALLED ELEVATION AND PLAN
CONVENIENCE STORE
98 CROMER STREET
LONDON WC1H 8BZ**

DRAWN BY JML/CAD	DATE 14/05/16	SCALE 1:50	SHEET SIZE A3
CHECKED BY	DATE	APPROVED BY	DATE

DRAWING No. 30754-36-002	REVISION 1
------------------------------------	----------------------