









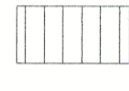


8 Render system : 'StoTherm' or similar approved. Mechanically fixed insulation, T-rails, reinforcing coat with reinforcing mesh and top coat. Facade to be divided into strips as per the individual bays with a movement joint / shadow gap in between.

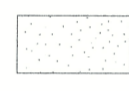
Render system : 'StoTherm' or similar approved. Mechanically fixed insulation, T-rails, reinforcing coat with reinforcing mesh and top coat.

Legend :

-  1. powder coated curtain walling with metal infill
 -  2. Treated Larch timber cladding with 12mm joints horizontally laid over minimum 40mm cavity.
 -  7. Curtain walling system, powder coated
 -  5. Tenant fit out area
- SOUTH ELEVATION
-  Aluminium powder coated window. Inward opening
 -  6. Aluminium powder coated louvre opening
 -  8. Render system : 'StoTherm' or similar approved. Mechanically fixed insulation, T-rails, reinforcing coat with reinforcing mesh and top coat.
- Colours
-  33340
 -  31137
 -  31134
 -  31131

7 EAST ELEVATION AT GL 6 3rd FLOOR
300_00 1:100

Render system : 'StoTherm' or similar approved. Mechanically fixed insulation, T-rails, reinforcing coat with reinforcing mesh and top coat.

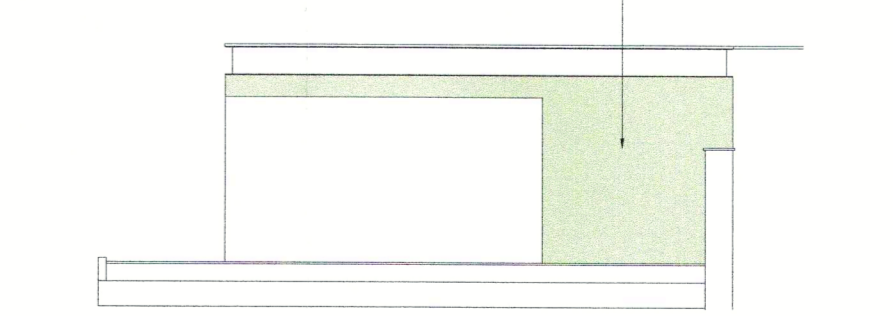

8 WEST ELEVATION AT GL 4 3rd FLOOR
300_00 1:100

Client			
Stanley Sidings Ltd			
Project			
Camden Stables A&B site			
Title			
East & West Elevation			
Lawful development application			
Reflecting the as-built condition in 2010			
project	drg no.	Rev	
05005	300_00	PL1	
date	scale		
25.05.2016	1:200 @ A1		