
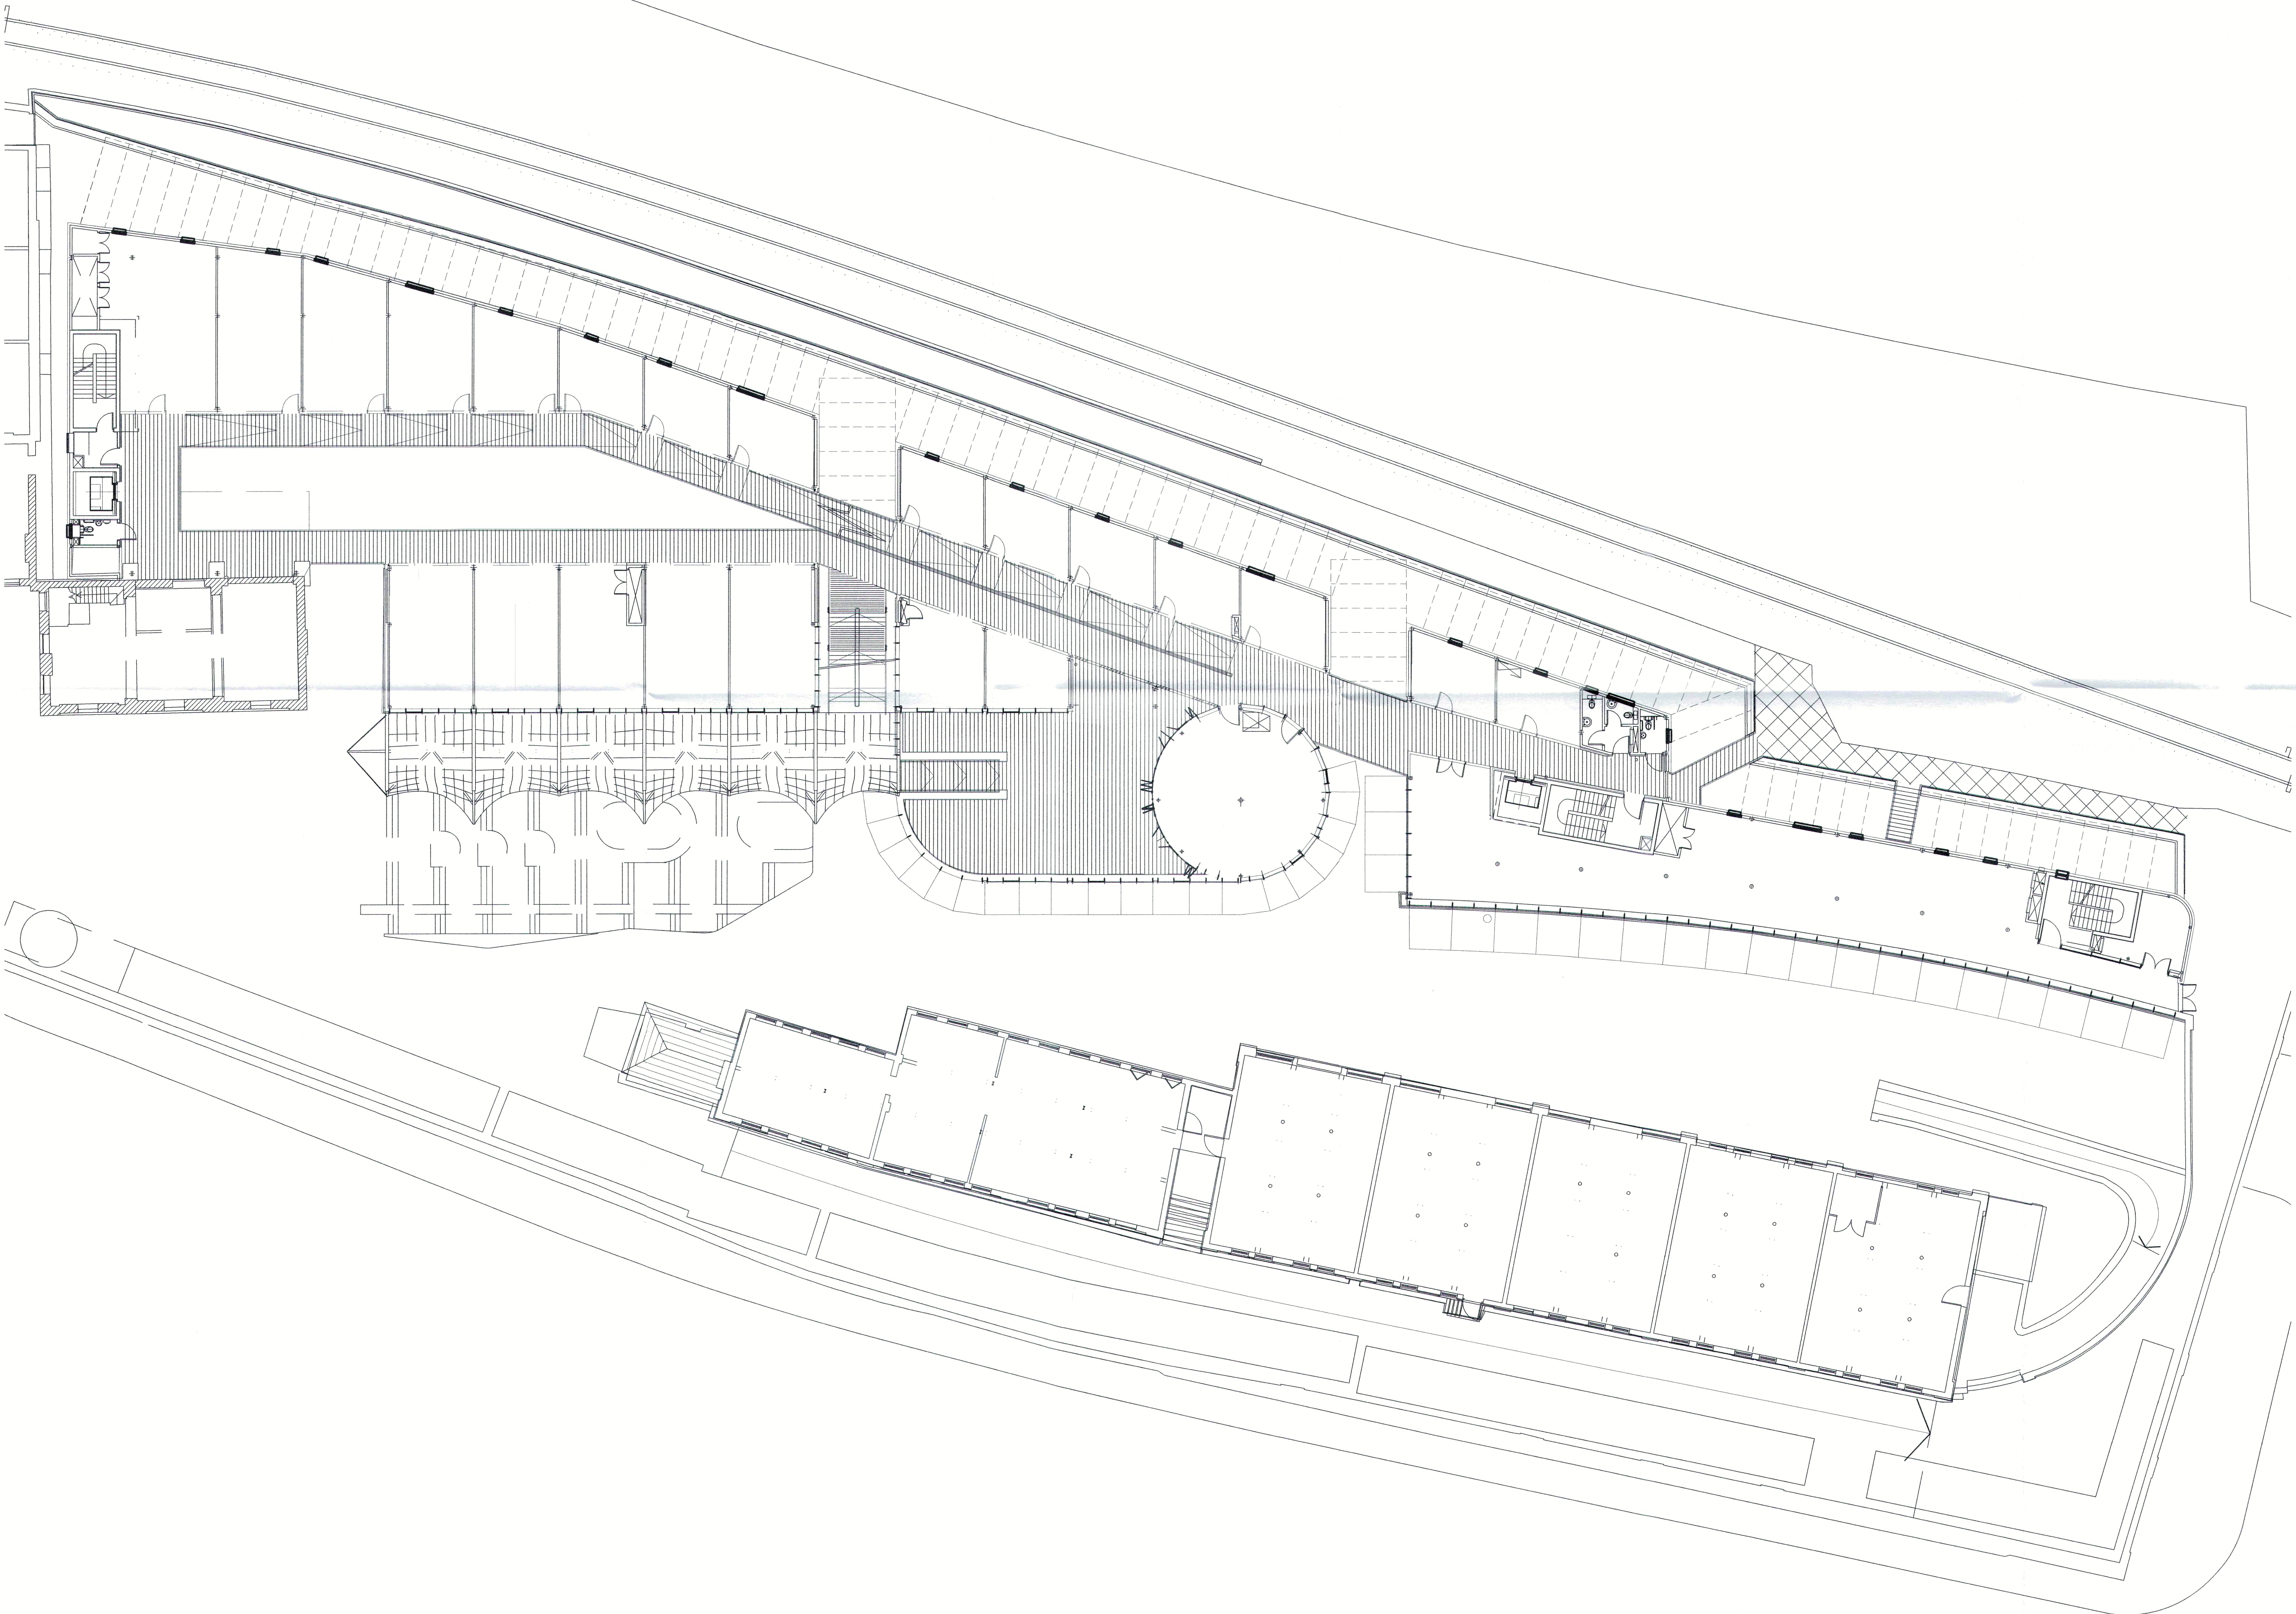


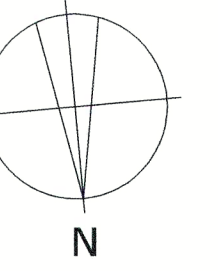

Client			
Stanley Sidings Ltd			
Project			
Camden Stables A&B site			
Title			
Level 01 Plan			
Lawful development application			
Reflecting the as-built condition in 2010			
project	05005	drwg no.	200_04
Rev			PL1
scale			
date	25.05.2016	1:200 @ A1	