



chartered
surveyors
and project
managers

APPENDIX C


DRAWINGS P-01, P-02, P-03, P-04

NOTES


All dimensions and levels to be checked by Contractor and verified before work commences; dimensions must be not be scaled from this drawing.
Copyright reserved.

EC REGULATIONS - GENERAL NOTE

Where reference is made on this drawing to British Standards or to specific manufacturer's products or trade names, this is intended to indicate a minimum acceptable standard of performance etc. Materials and components conforming to an equivalent European Standard may be used and supporting evidence shall be produced at tender stage to confirm fitness for purpose.

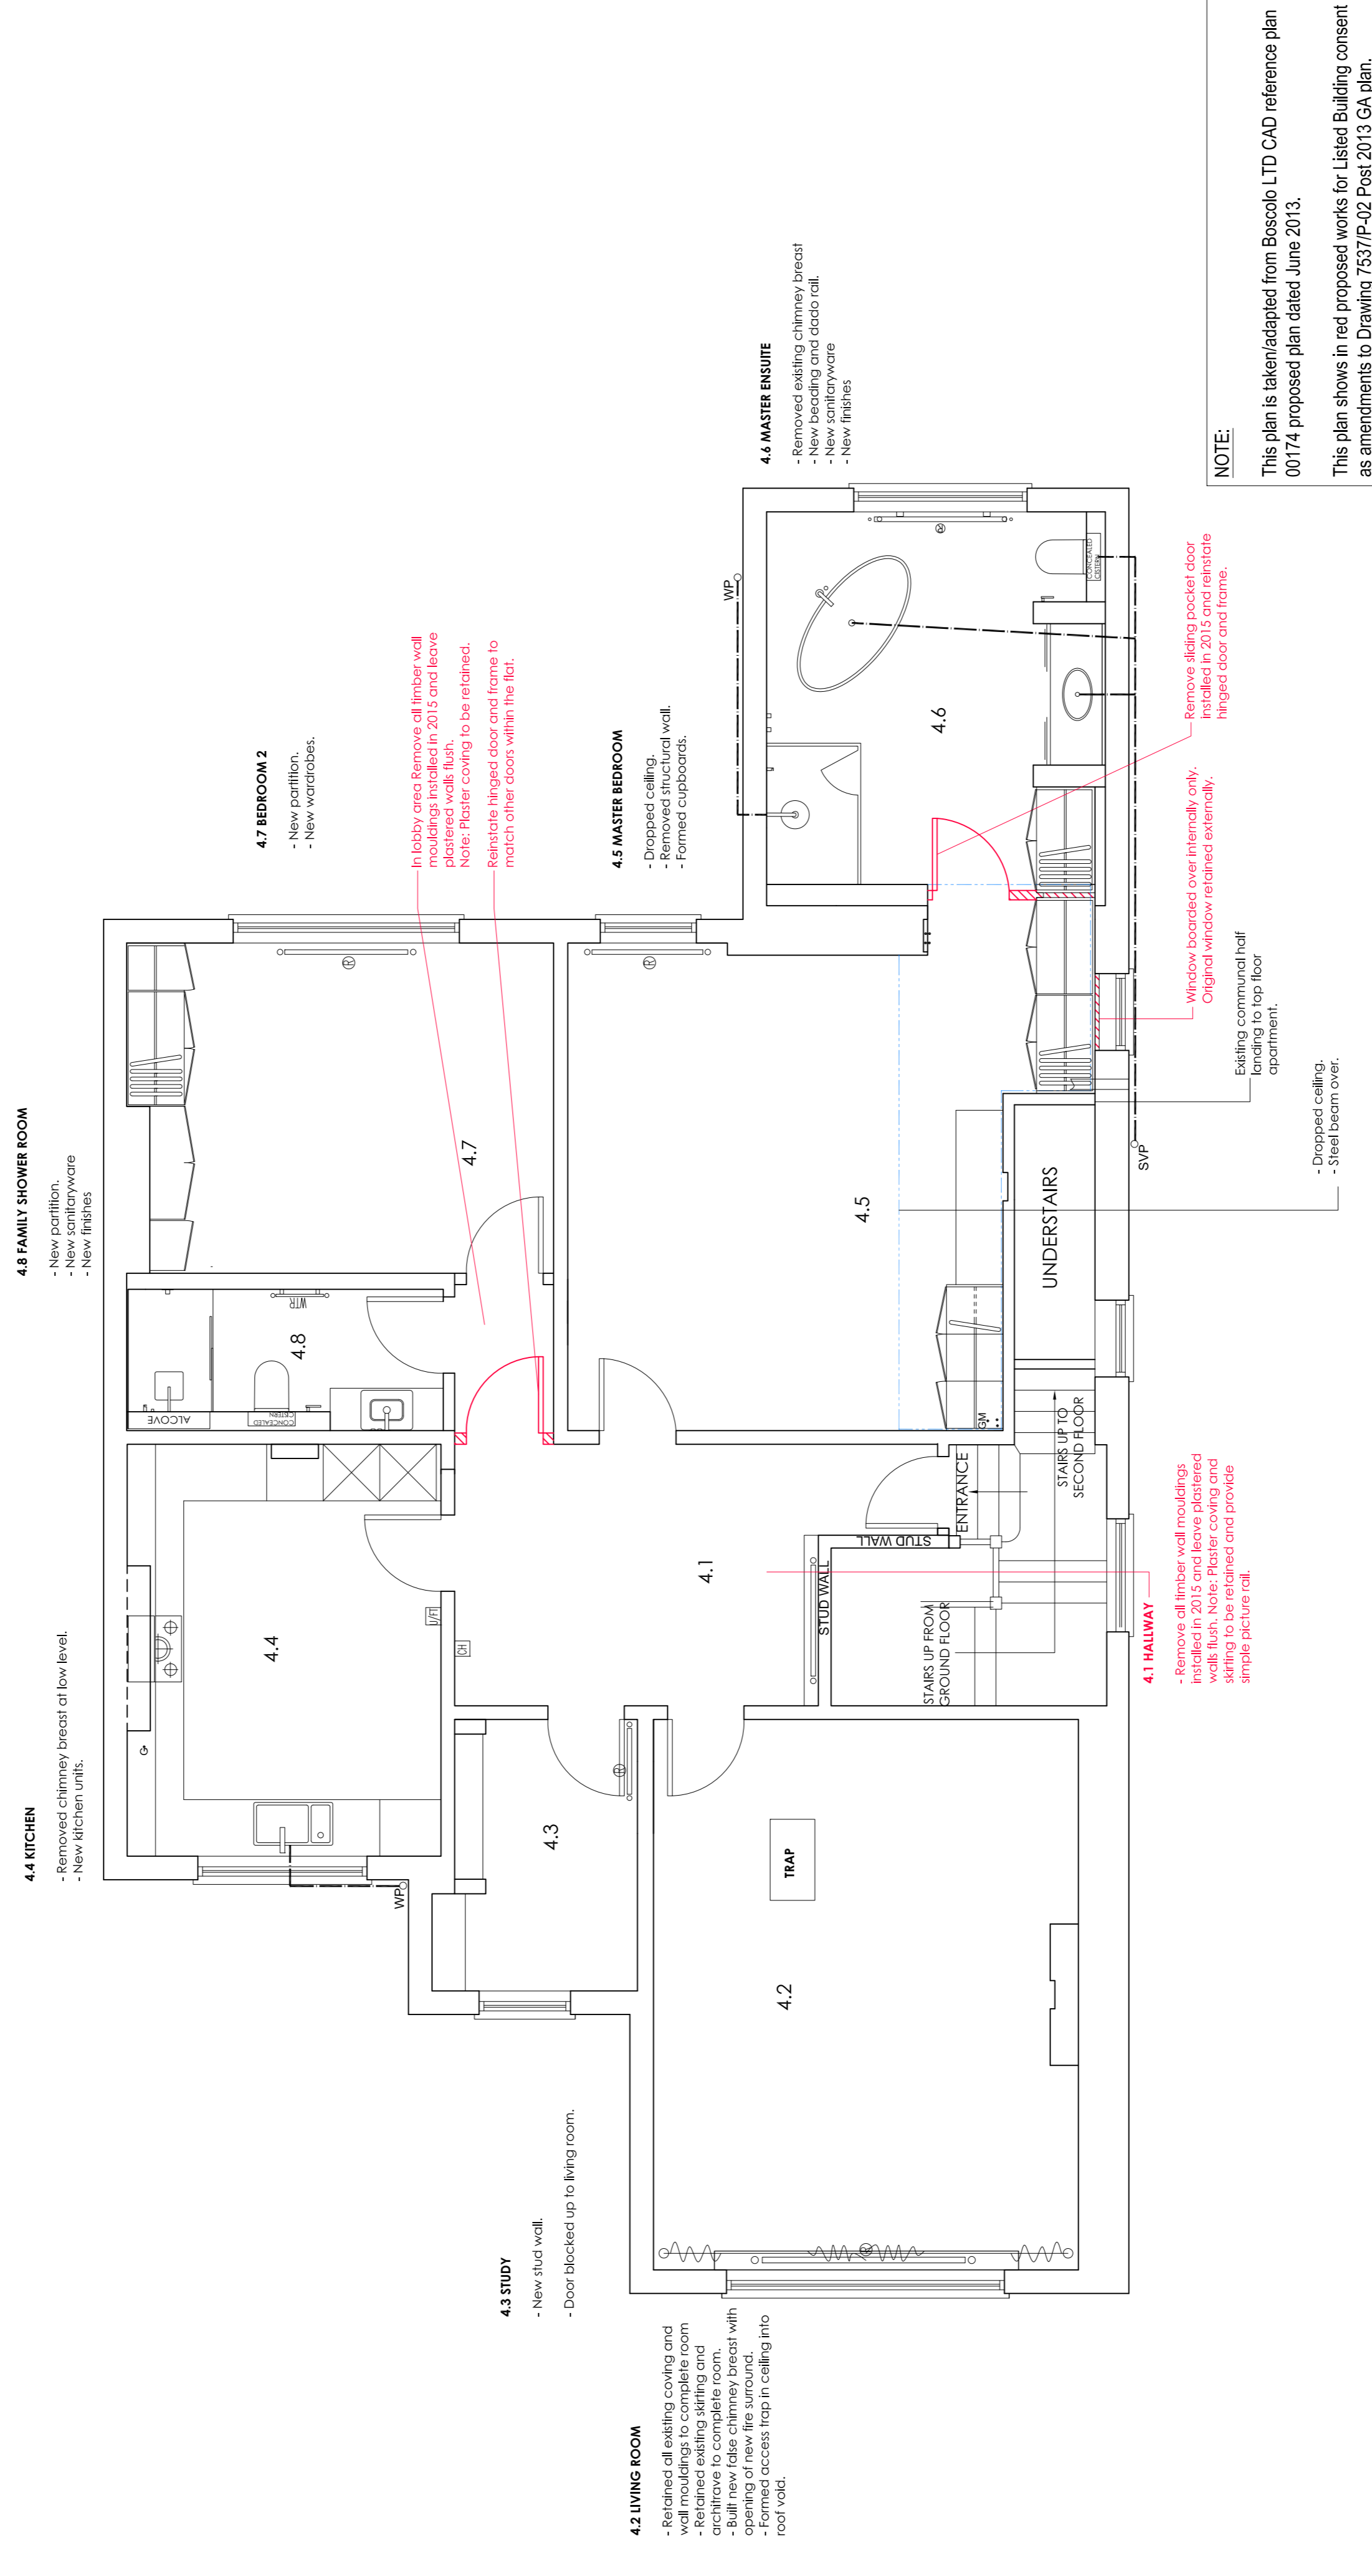

NOTE:
This plan is taken/adapted from Boscolo LTD CAD reference plan 00174 proposed plan dated June 2013.
This plan shows in red proposed works for Listed Building consent as amendments to Drawing 7537/P-02 Post 2013 GA plan.

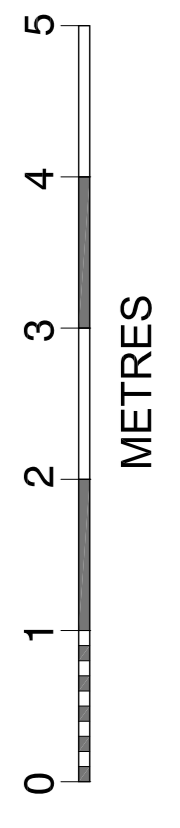

revisions			
AS BUILT			
PROPOSED FOR LISTED BUILDING			
PLANNING APPROVAL 2016			
D.DESAI & P. SHAH			
Chartered Surveyors 138 Chichester Road, London N1 9JU Tel: 020 7636 8833			
Threeways House 38 George Street, Oxford OX1 2EJ Tel: 01865 260 600			
e-mail: info@tmd-surveys.co.uk www.tmd-surveys.co.uk			
Project			
FLAT 2		14 FERNGROFT AVENUE LONDON NW3 7PH	
Drawing			
PROPOSED (AS BUILT) & FUTURE WORKS (2016)			
GENERAL ARRANGEMENT			
Scale:	Date:	Drawn By:	Checked By:
1/50 @ A1	OCTOBER 2015	PA	NS
Job No:	7537	Rev'n	
	P-04		
			A1