

NEW EXTENSION  
TO MATCH  
EXISTING LONDON  
STOCK  
BRICKWORK

LINE OF NEW  
BRICK WALL TO  
MATCH LINE OF  
EXISTING TIMBER  
FENCE

DASHED RED LINE INDICATES  
BUILDING OUTLINE OF THE  
PREVIOUSLY PERMITTED  
SCHEME (REF:2008/1402/P-  
2010/6738/P)

STUDY

UTILITY

ROOFLIGHT ABOVE

COURTYARD

ROOFLIGHT ABOVE

EXISTING  
FIRE PLACE

LIVING AREA

WC

KITCHEN

WEATHERALL  
LODGE

CHRISTCHURCH HILL


DINING AREA

ENTRANCE

LANDSCAPED AREA

General notes:  
This drawing is copyright of KSR architects. This drawing must be read in conjunction with the Designer's Risk Assessment, specification and all other relevant documentation and drawings. KSR architects accept no liability for any expense, loss or damage of whatsoever nature and however arising from any variation made to this drawing or in the execution of the work to which it relates which has not been referred to them and their approval obtained.  
Do not scale from this drawing or the digital data, only figured dimensions are to be used. For Planning refer to linear scale.  
Check all dimensions on site prior to carrying out any works - advice any discrepancy

| LEGEND        |  |
|---------------|--|
| NEW EXTENSION |  |
| EXISTING      |  |

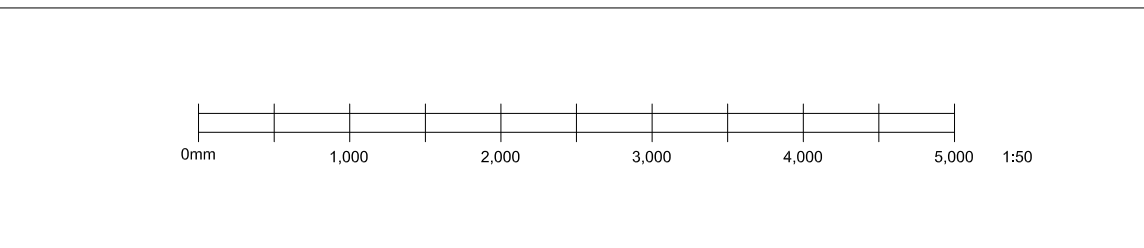

| PLANNING         |                      |                |              |
|------------------|----------------------|----------------|--------------|
| Rev              | Notes                | dd.mm.yy       | By           |
| A                | Planning Application | 12.07.16       | GJ           |
| © KSR architects |                      | Date: 12.07.16 | Drawn By: GS |
|                  |                      | Checked: GJ    |              |

**KSRARCHITECTS**  
KSR Architects LLP  
14 Greatland Street  
London NW1 0ND  
t: +44 (0)20 7892 5000  
e: mail@ksrarchitects.com  
www.ksrarchitects.com

Title:  
**PROPOSED  
GROUND FLOOR PLAN**

Project Ref: 16010  
Drawing No: 16010-P-100  
Revision: A

DASHED RED LINE INDICATES BUILDING OUTLINE OF THE PREVIOUSLY PERMITTED SCHEME (REF:2008/1402/P- 2010/6738/P)

NEW WINDOW TO MATCH EXISTING PAINTED TIMBER WINDOW FRAMES

ROOFLIGHT

ROOFLIGHT

WC

EN SUITE

WEATHERALL LODGE

BEDROOM 1

BEDROOM 2


MASTER BEDROOM

LEGEND

NEW EXTENSION



EXISTING

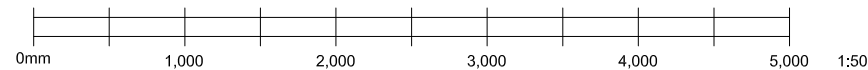

General notes:

This drawing is copyright of KSR architects. This drawing must be read in conjunction with the Designer's Risk Assessment, specification and all other relevant documentation and drawings. KSR architects accept no liability for any expense, loss or damage of whatsoever nature and however arising from any variation made to this drawing or in the execution of the work to which it relates which has not been referred to them and their approval obtained. Do not scale from this drawing or the digital data, only figured dimensions are to be used. For Planning refer to linear scale. Check all dimensions on site prior to carrying out any works - advice any discrepancy

PLANNING

Project: 53 CHRIST CHURCH HILL, LONDON, NW3 1LG

KSRARCHITECTS


KSR Architects LLP  
14 Greenland Street  
London NW1 0ND  
t: +44 (0)20 7892 5000  
www.ksrarchitects.com

Title: PROPOSED FIRST FLOOR PLAN

|                        |       |          |    |                  |  |              |             |                    |                         |             |
|------------------------|-------|----------|----|------------------|--|--------------|-------------|--------------------|-------------------------|-------------|
| A Planning Application |       | 12.07.16 | GJ | Date: 12.07.16   |  | Drawn By: GS | Checked: GJ | Project Ref: 16010 | Drawing No: 16010-P-110 | Revision: A |
| Rev                    | Notes | dd.mm.yy | By | Chkd             |  |              |             |                    |                         |             |
| © KSR architects       |       |          |    | Scale: 1:50 @ A3 |  |              |             |                    |                         |             |



DASHED RED LINE INDICATES BUILDING OUTLINE OF THE PREVIOUSLY PERMITTED SCHEME (REF:2008/1402/P- 2010/6738/P)

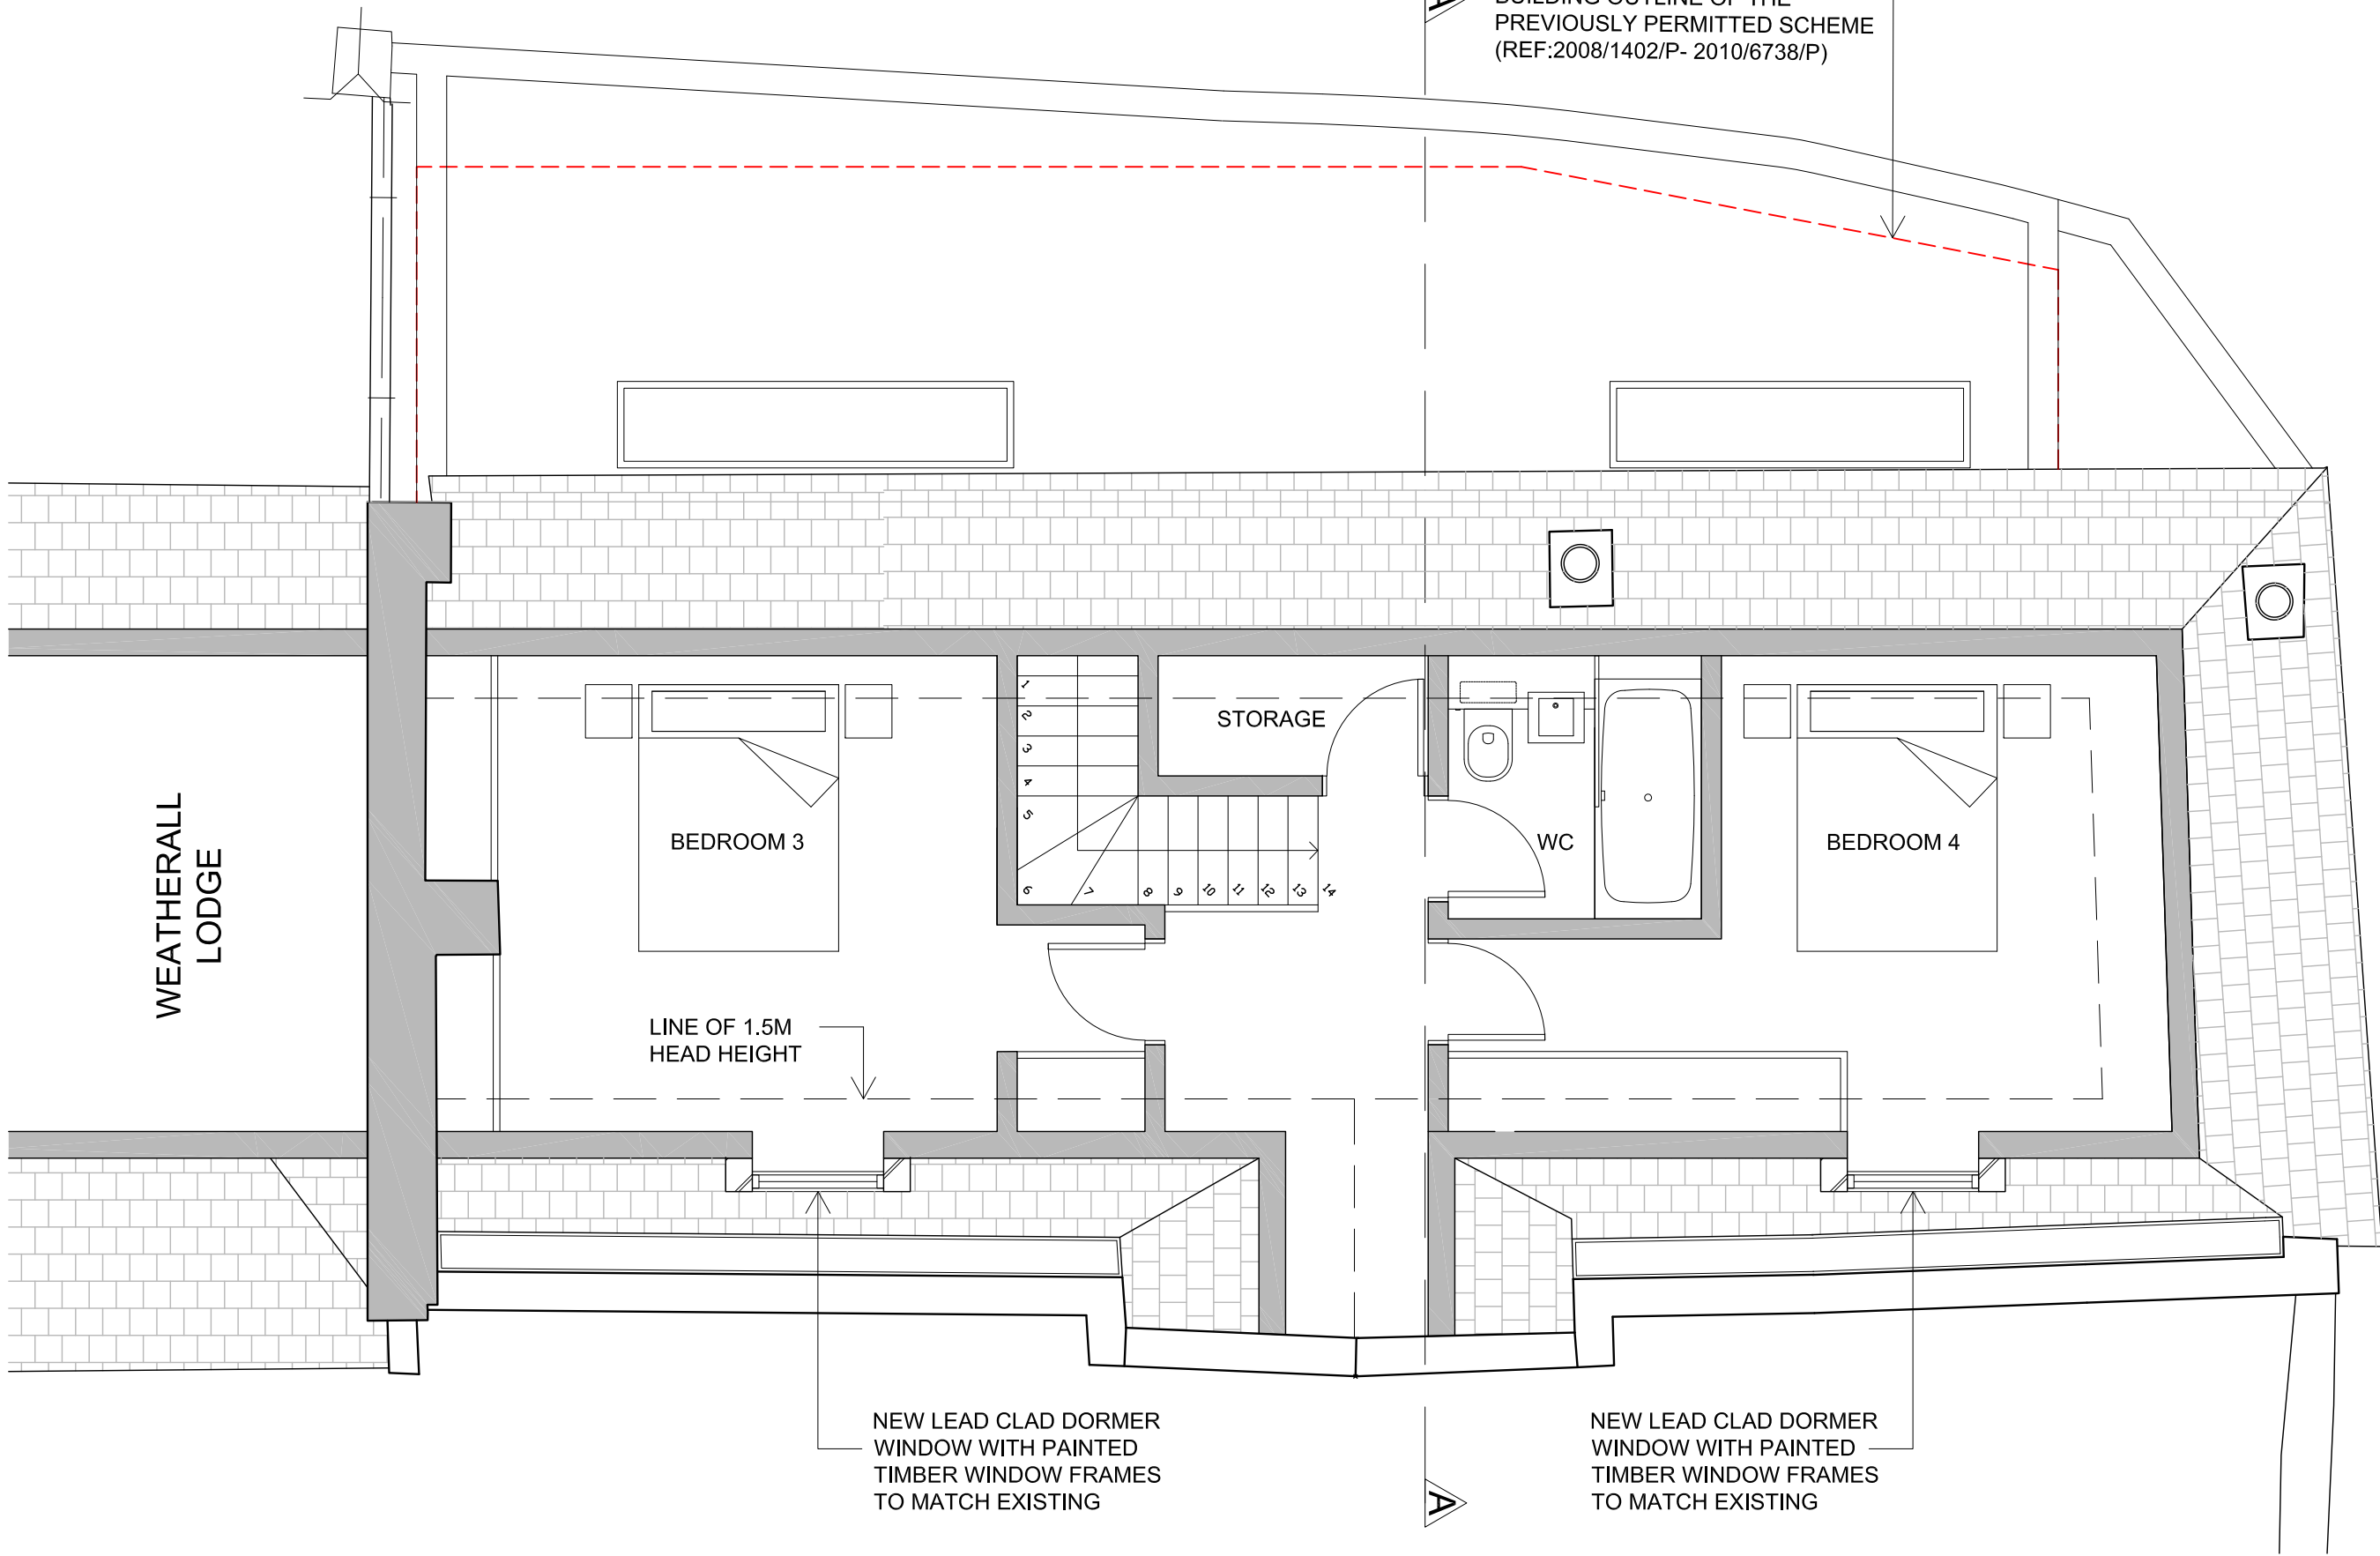

WEATHERALL LODGE

BEDROOM 3

STORAGE

WC

BEDROOM 4

LINE OF 1.5M HEAD HEIGHT


NEW LEAD CLAD DORMER WINDOW WITH PAINTED TIMBER WINDOW FRAMES TO MATCH EXISTING

NEW LEAD CLAD DORMER WINDOW WITH PAINTED TIMBER WINDOW FRAMES TO MATCH EXISTING



General notes:  
 This drawing is copyright of KSR architects. This drawing must be read in conjunction with the Designer's Risk Assessment, specification and all other relevant documentation and drawings. KSR architects accept no liability for any expense, loss or damage of whatsoever nature and however arising from any variation made to this drawing or in the execution of the work to which it relates which has not been referred to them and their approval obtained.  
 Do not scale from this drawing or the digital data, only figured dimensions are to be used. For Planning refer to linear scale. Check all dimensions on site prior to carrying out any works - advise any discrepancy

| LEGEND        |  |
|---------------|--|
| NEW EXTENSION |  |
| EXISTING      |  |

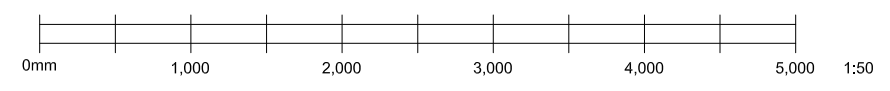

| Rev | Notes                | dd.mm.yy | By | Chkd | Date     | Drawn By    | Checked     |
|-----|----------------------|----------|----|------|----------|-------------|-------------|
| A   | Planning Application | 12.07.16 | GJ |      | 12.07.16 | Drawn By:GS | Checked: GJ |


PLANNING  
 Project:  
 53 CHRIST CHURCH HILL,  
 LONDON, NW3 1LG.  
 Scale: 1:50 @ A3

**KSRARCHITECTS**  
 KSR Architects LLP  
 14 Greenland Street  
 London NW1 0ND  
 Tel: +44 (0)20 7892 5000  
 Email: mail@ksrarchitects.com  
 Website: www.ksrarchitects.com

Title:  
 PROPOSED  
 SECOND FLOOR PLAN

|              |             |           |
|--------------|-------------|-----------|
| Project Ref: | Drawing No: | Revision: |
| 16010        | 16010-P-120 | A         |

DASHED RED LINE INDICATES BUILDING OUTLINE OF THE PREVIOUSLY PERMITTED SCHEME (REF:2008/1402/P- 2010/6738/P)

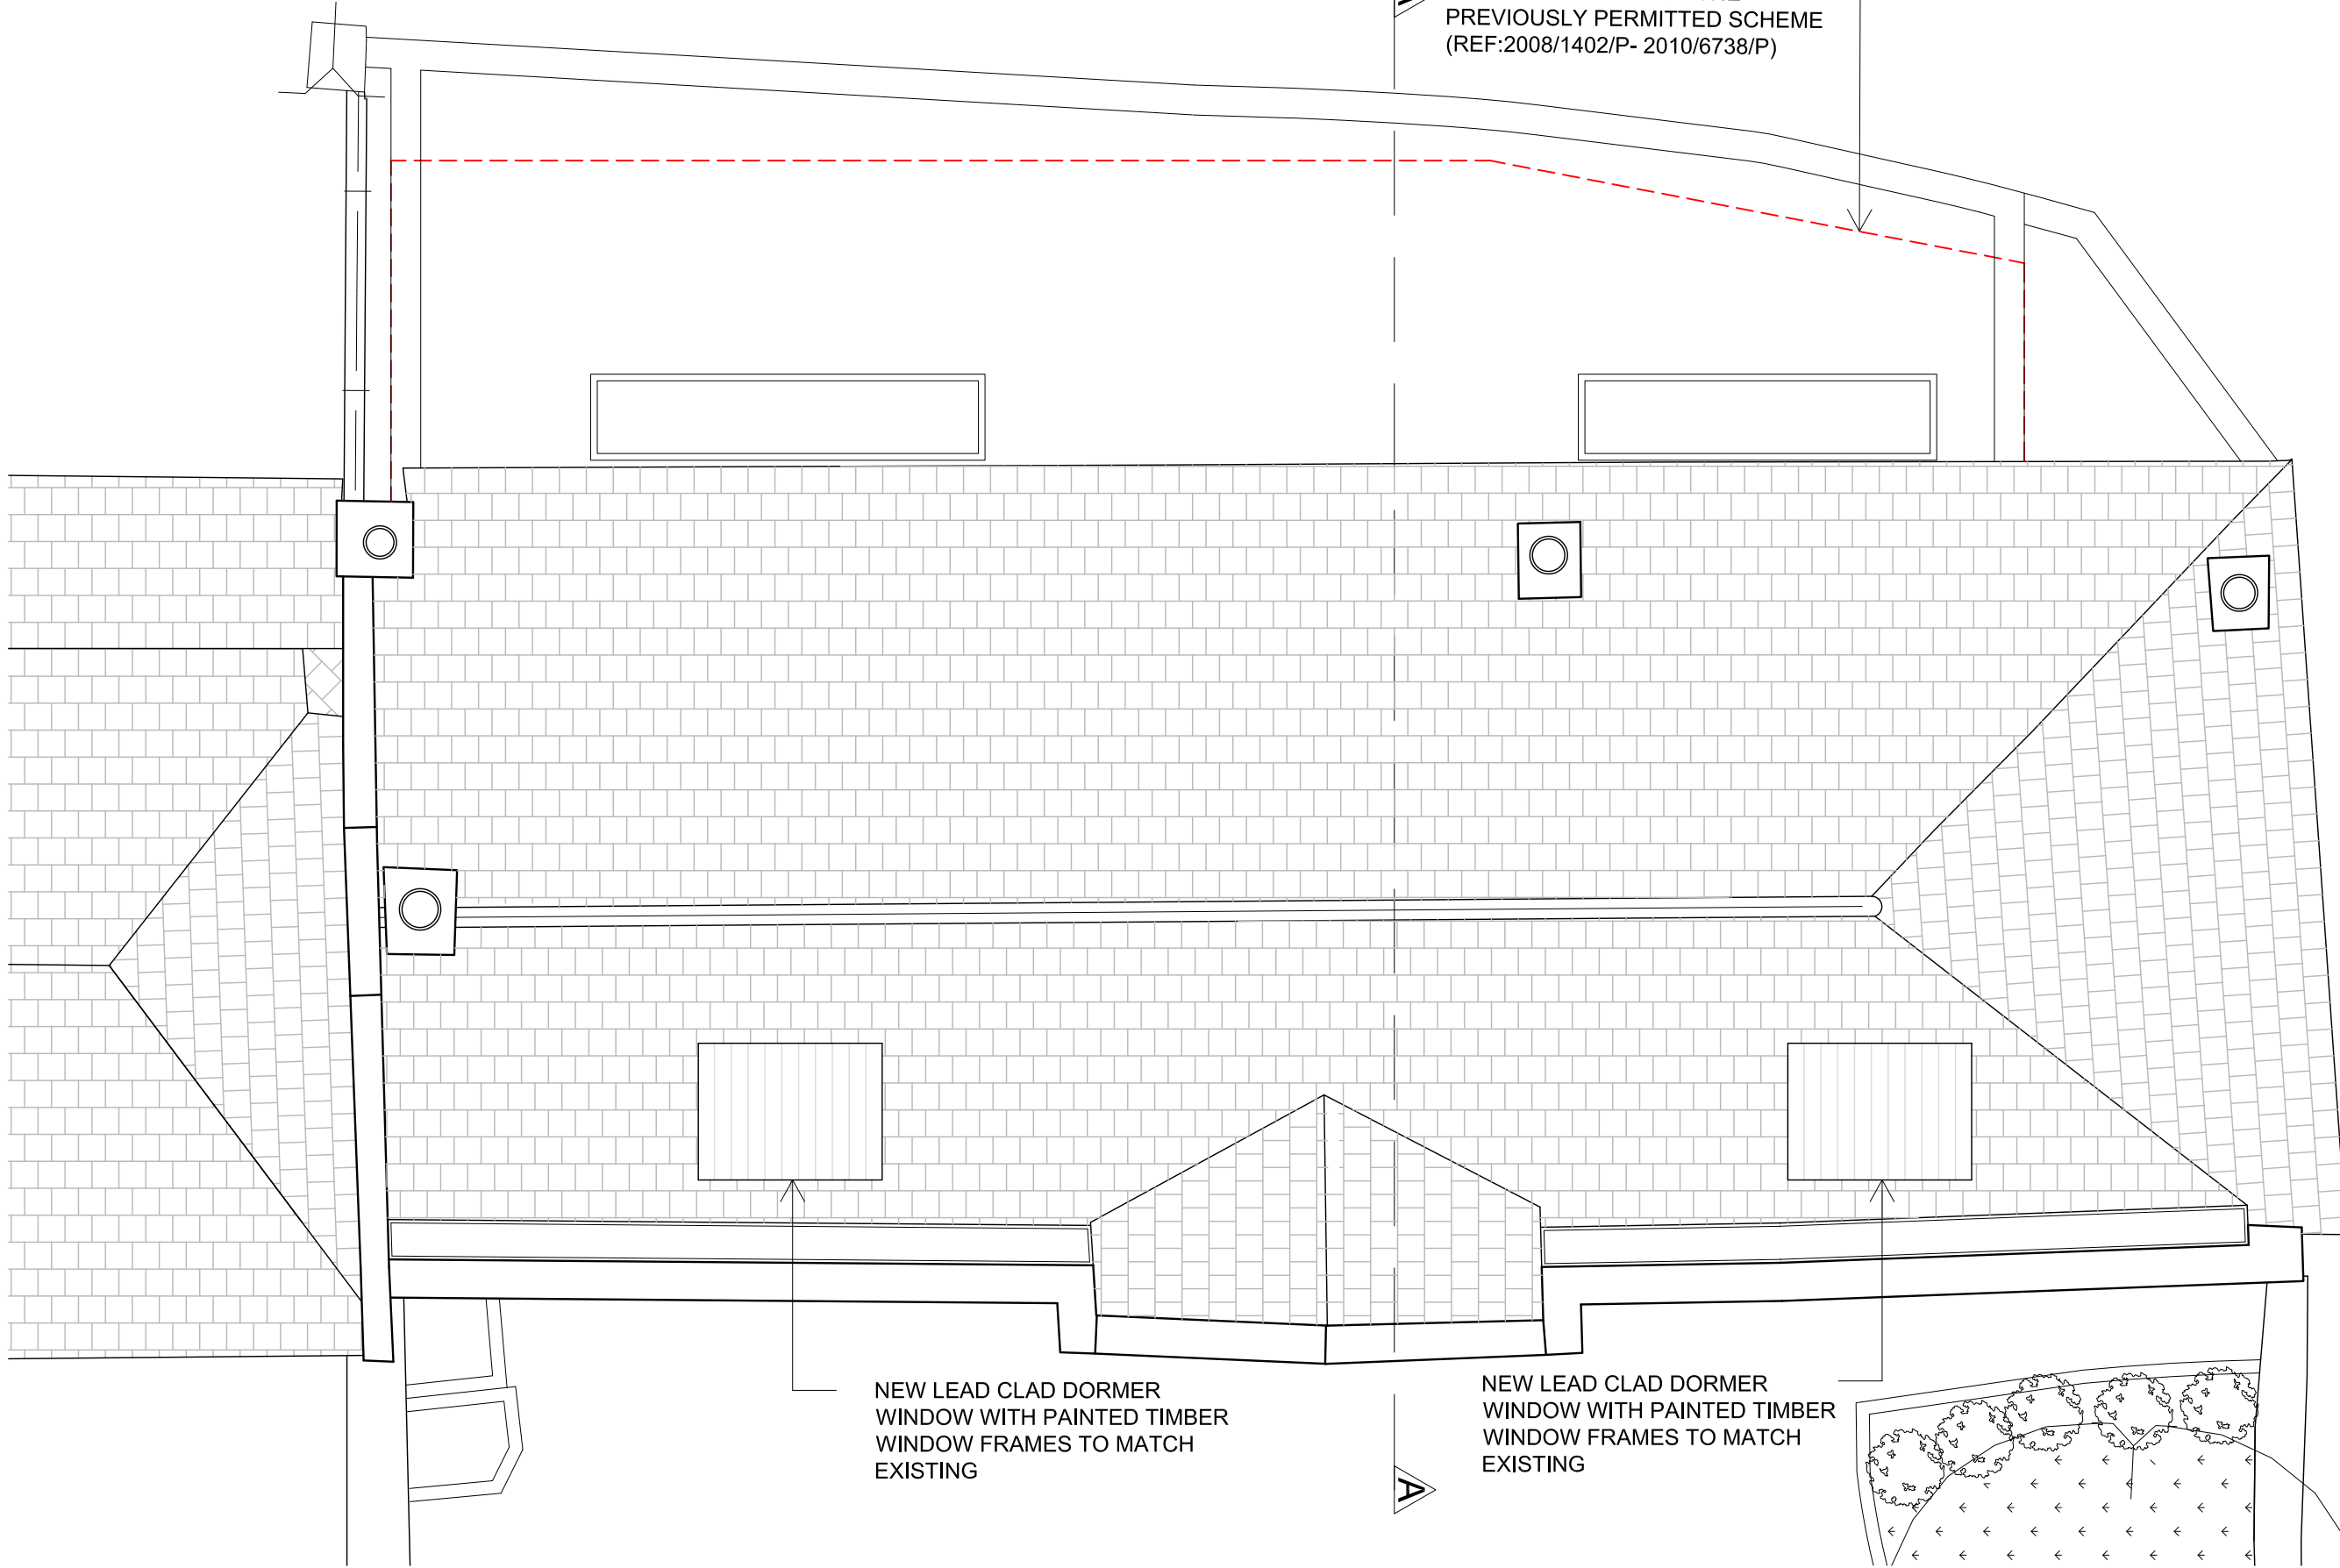


NEW LEAD CLAD DORMER WINDOW WITH PAINTED TIMBER WINDOW FRAMES TO MATCH EXISTING

NEW LEAD CLAD DORMER WINDOW WITH PAINTED TIMBER WINDOW FRAMES TO MATCH EXISTING

**General notes:**  
 This drawing is copyright of KSR architects. This drawing must be read in conjunction with the Designer's Risk Assessment, specification and all other relevant documentation and drawings. KSR architects accept no liability for any expense, loss or damage of whatsoever nature and however arising from any variation made to this drawing or in the execution of the work to which it relates which has not been referred to them and their approval obtained.  
 Do not scale from this drawing or the digital data, only figured dimensions are to be used. For Planning refer to linear scale. Check all dimensions on site prior to carrying out any works – advice any discrepancy

**LEGEND**

|               |  |
|---------------|--|
| NEW EXTENSION |  |
| EXISTING      |  |

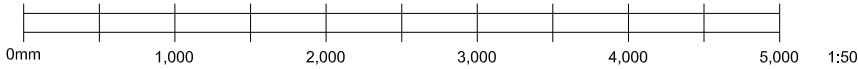

|                        |       |               |                         |
|------------------------|-------|---------------|-------------------------|
| A Planning Application |       | 12.07.16      | GJ                      |
| Rev                    | Notes | dd.mm.yy      | By Chkd                 |
| © KSR architects       |       | Date:12.07.16 | Drawn By:GS Checked: GJ |

**PLANNING**


Project:  
 53 CHRIST CHURCH HILL,  
 LONDON, NW3 1LG.

Scale: 1:100 @ A3

**KSRARCHITECTS**  
 KSR Architects LLP  
 14 Greenland Street  
 London NW1 0ND  
 t: +44 (0)20 7892 5000  
 e: mail@ksrarchitects.com  
 www.ksrarchitects.com

Title:  
 PROPOSED  
 ROOF PLAN


|              |       |             |             |           |   |
|--------------|-------|-------------|-------------|-----------|---|
| Project Ref: | 16010 | Drawing No: | 16010-P-130 | Revision: | A |
|--------------|-------|-------------|-------------|-----------|---|

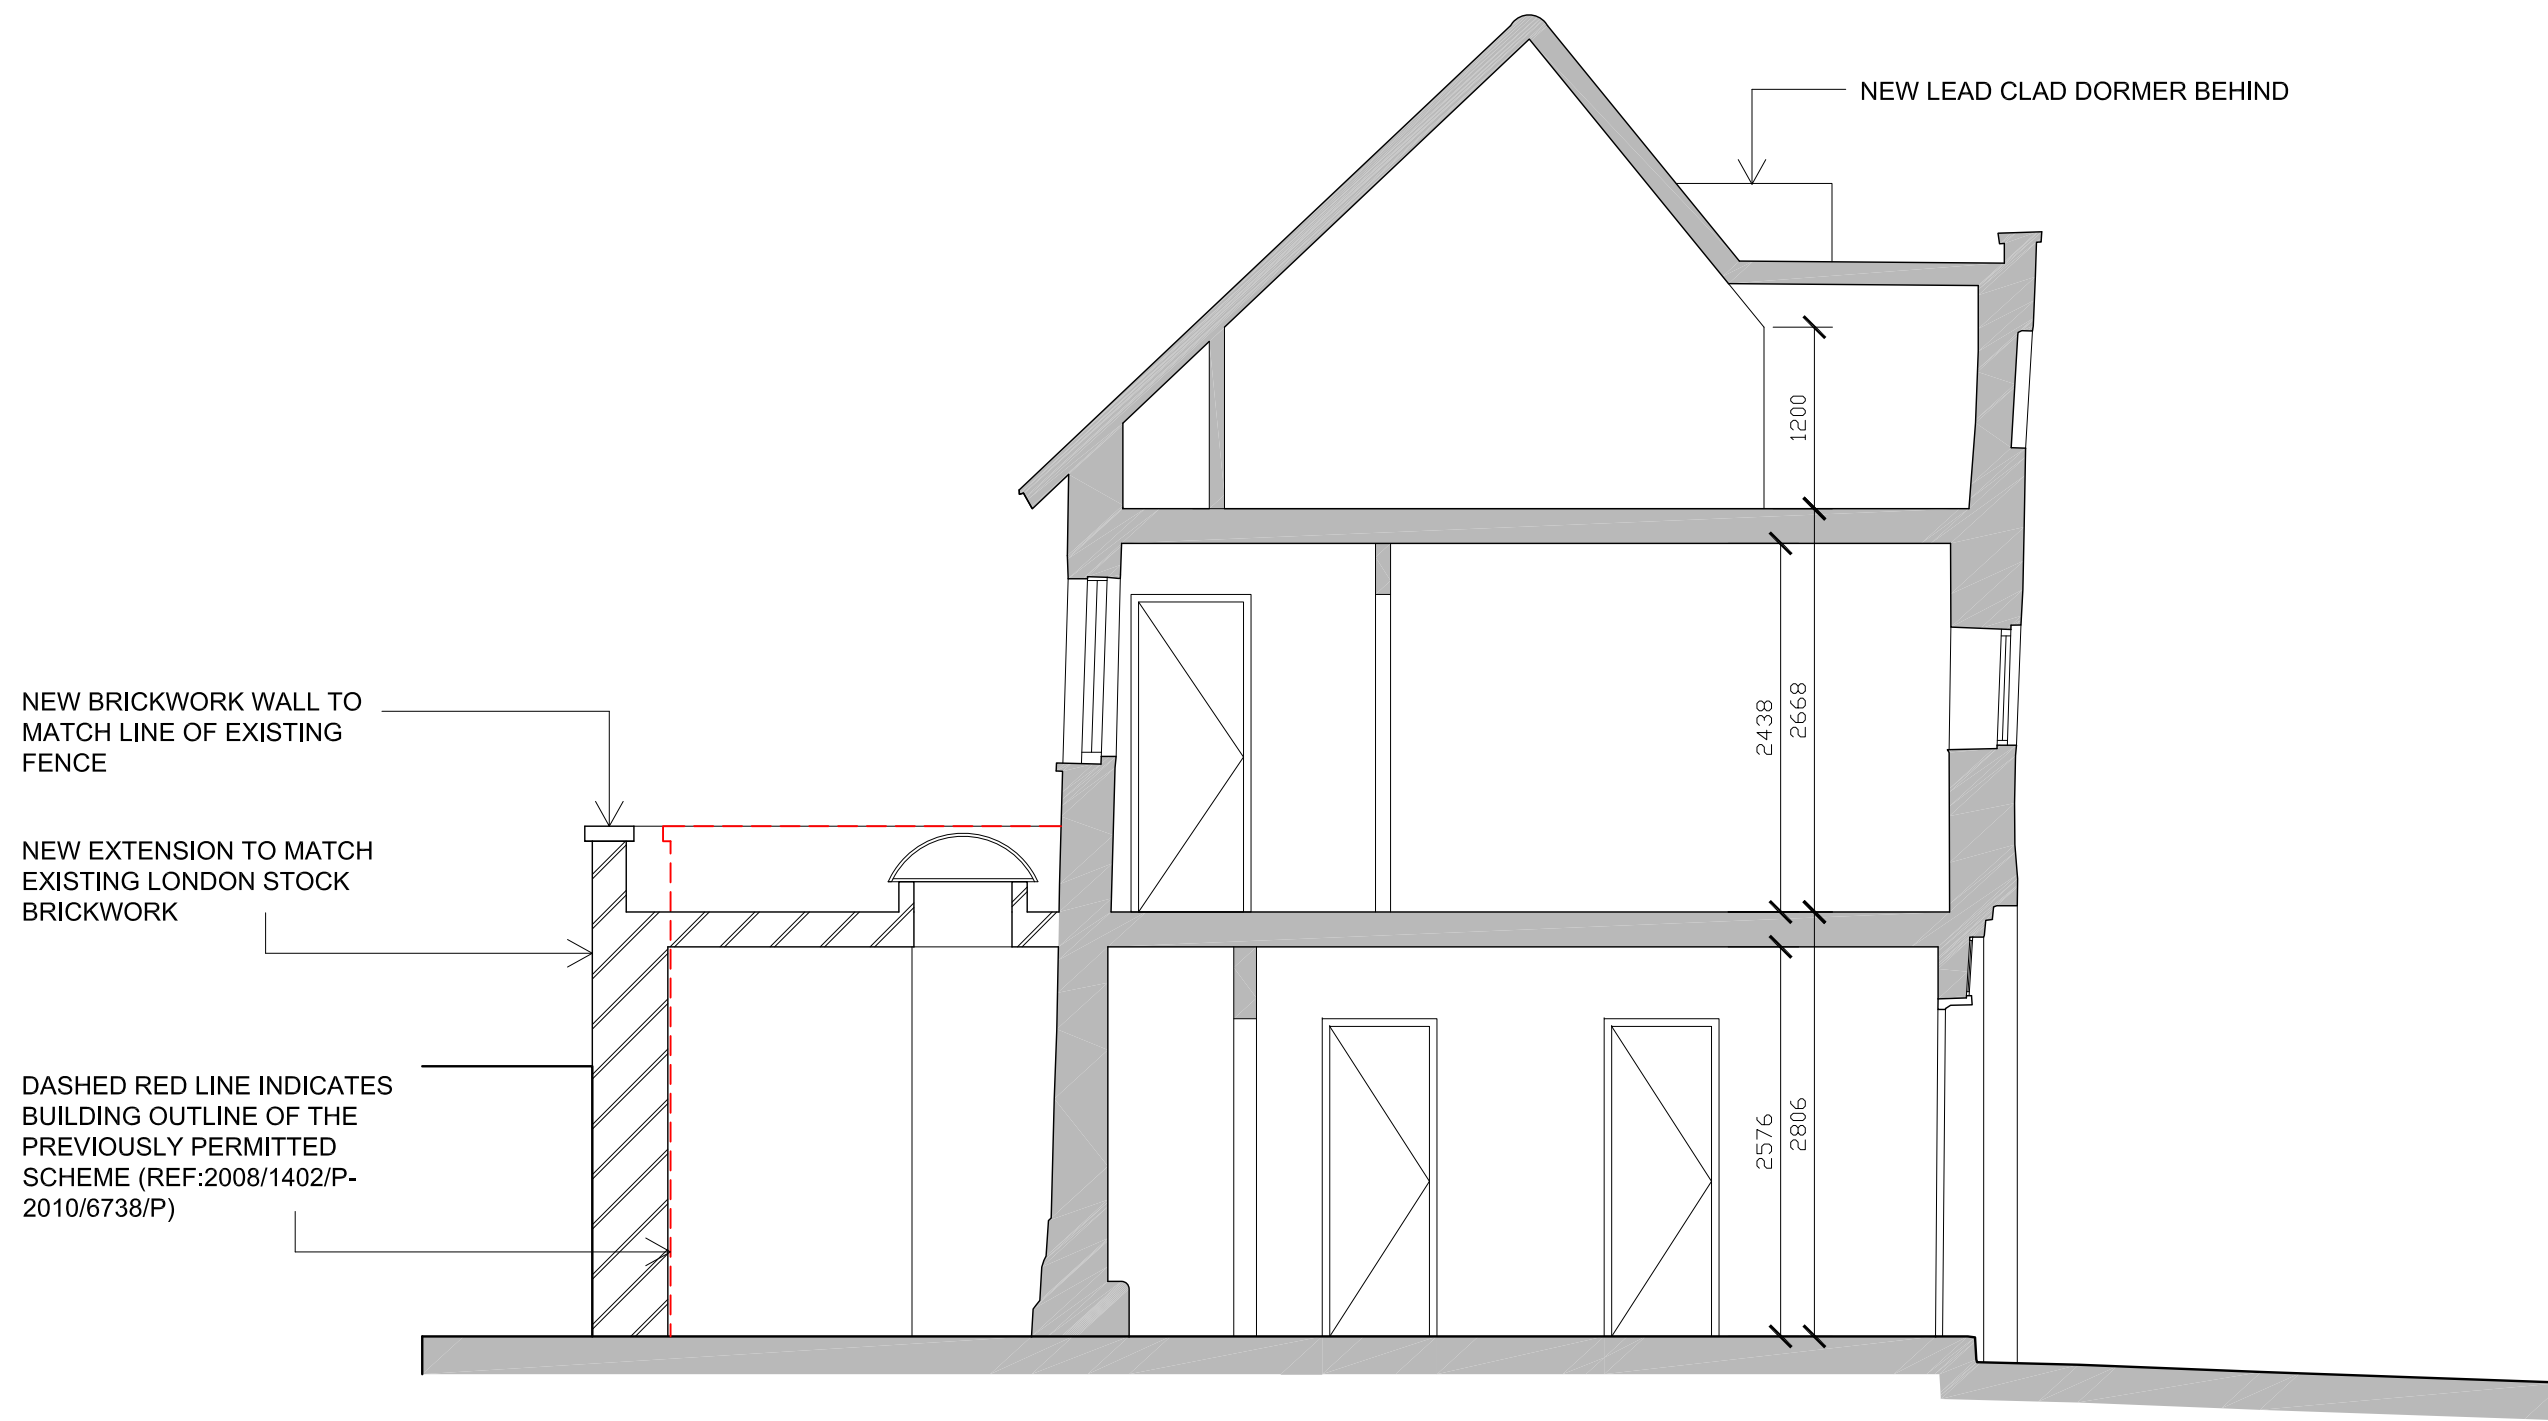

# SECTION A-A

General notes:  
 This drawing is copyright of KSR architects. This drawing must be read in conjunction with the Designer's Risk Assessment, specification and all other relevant documentation and drawings. KSR architects accept no liability for any expense, loss or damage of whatsoever nature and however arising from any variation made to this drawing or in the execution of the work to which it relates which has not been referred to them and their approval obtained.  
 Do not scale from this drawing or the digital data, only figured dimensions are to be used. For Planning refer to linear scale.  
 Check all dimensions on site prior to carrying out any works – advice any discrepancy

| LEGEND        |  |
|---------------|--|
| NEW EXTENSION |  |
| EXISTING      |  |

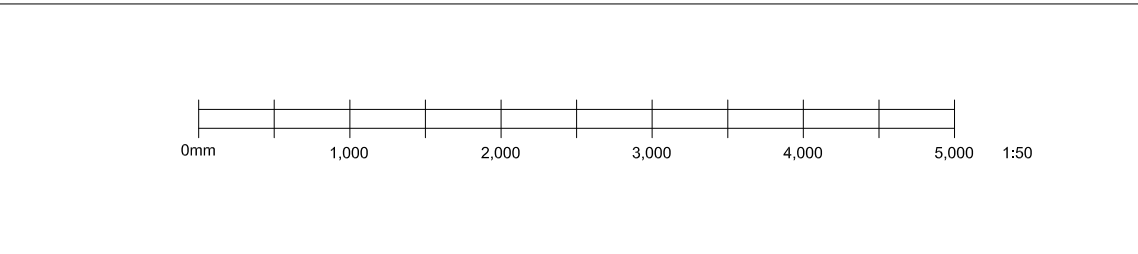

|                        |       |                |              |
|------------------------|-------|----------------|--------------|
| A Planning Application |       | 12.07.16       | GJ           |
| Rev                    | Notes | dd.mm.yy       | By Chkd      |
| © KSR architects       |       | Date: 12.07.16 | Drawn By: GS |

|  |                         |
|--|-------------------------|
| PLANNING   |                         |
| Project: 53 CHRIST CHURCH HILL, LONDON, NW3 1LG. |                         |
| Project Ref: 16010                               | Drawing No: 16010-P-200 |

**KSRARCHITECTS**  
 KSR Architects LLP  
 14 Greenland Street  
 London NW1 0ND  
 Email: info@ksrarchitects.com  
 Tel: +44 (0)20 7892 5000  
 www.ksrarchitects.com

Title: PROPOSED SECTION A-A

Revision: A




WEATHERALL LODGE

AGRIST COTTAGE

DATUM 102.00m

SOUTH EAST (GARDEN) ELEVATION

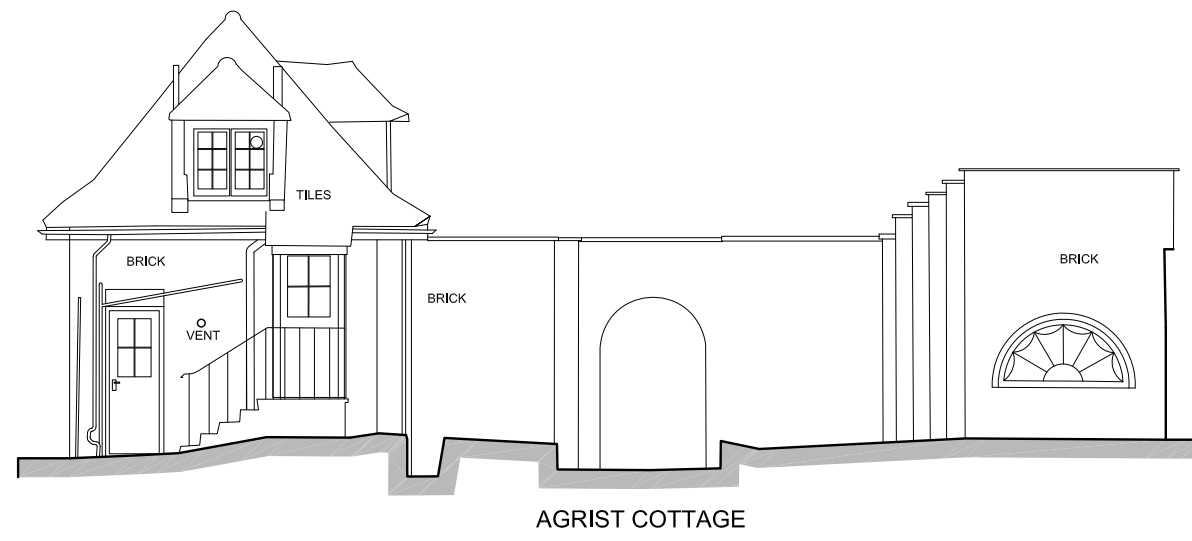


AGRIST COTTAGE

DATUM 102.00m

NORTH WEST (GARDEN) ELEVATION OF GARAGE

General notes:

This drawing is copyright of KSR architects. This drawing must be read in conjunction with the Designer's Risk Assessment, specification and all other relevant documentation and drawings. KSR architects accept no liability for any expense, loss or damage of whatsoever nature and however arising from any variation made to this drawing or in the execution of the work to which it relates which has not been referred to them and their approval obtained.  
Do not scale from this drawing or the digital data, only figured dimensions are to be used. For Planning refer to linear scale.  
Check all dimensions on site prior to carrying out any works – advice any discrepancy

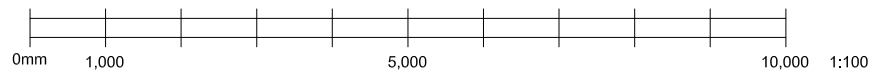

PLANNING

**KSRARCHITECTS**


KSR Architects LLP  
14 Greenland Street  
London NW1 0ND  
t: +44 (0)20 7892 5000  
m: +44 (0)20 7892 5000  
www.ksrarchitects.com

Project:  
53 CHRIST CHURCH HILL,  
LONDON, NW3 1LG.

Title:  
PROPOSED ELEVATIONS  
SOUTH EAST AND NORTH WEST

|                        |       |          |    |                |                   |              |             |                    |                         |             |
|------------------------|-------|----------|----|----------------|-------------------|--------------|-------------|--------------------|-------------------------|-------------|
| A Planning Application |       | 12.07.16 | GJ | Date: 12.07.16 |                   | Drawn By: GS | Checked: GJ | Project Ref: 16010 | Drawing No: 16010-P-300 | Revision: A |
| Rev                    | Notes | dd.mm.yy | By | Chkd           |                   |              |             |                    |                         |             |
| © KSR architects       |       |          |    |                | Scale: 1:100 @ A3 |              |             |                    |                         |             |


CHRISTCHURCH HILL

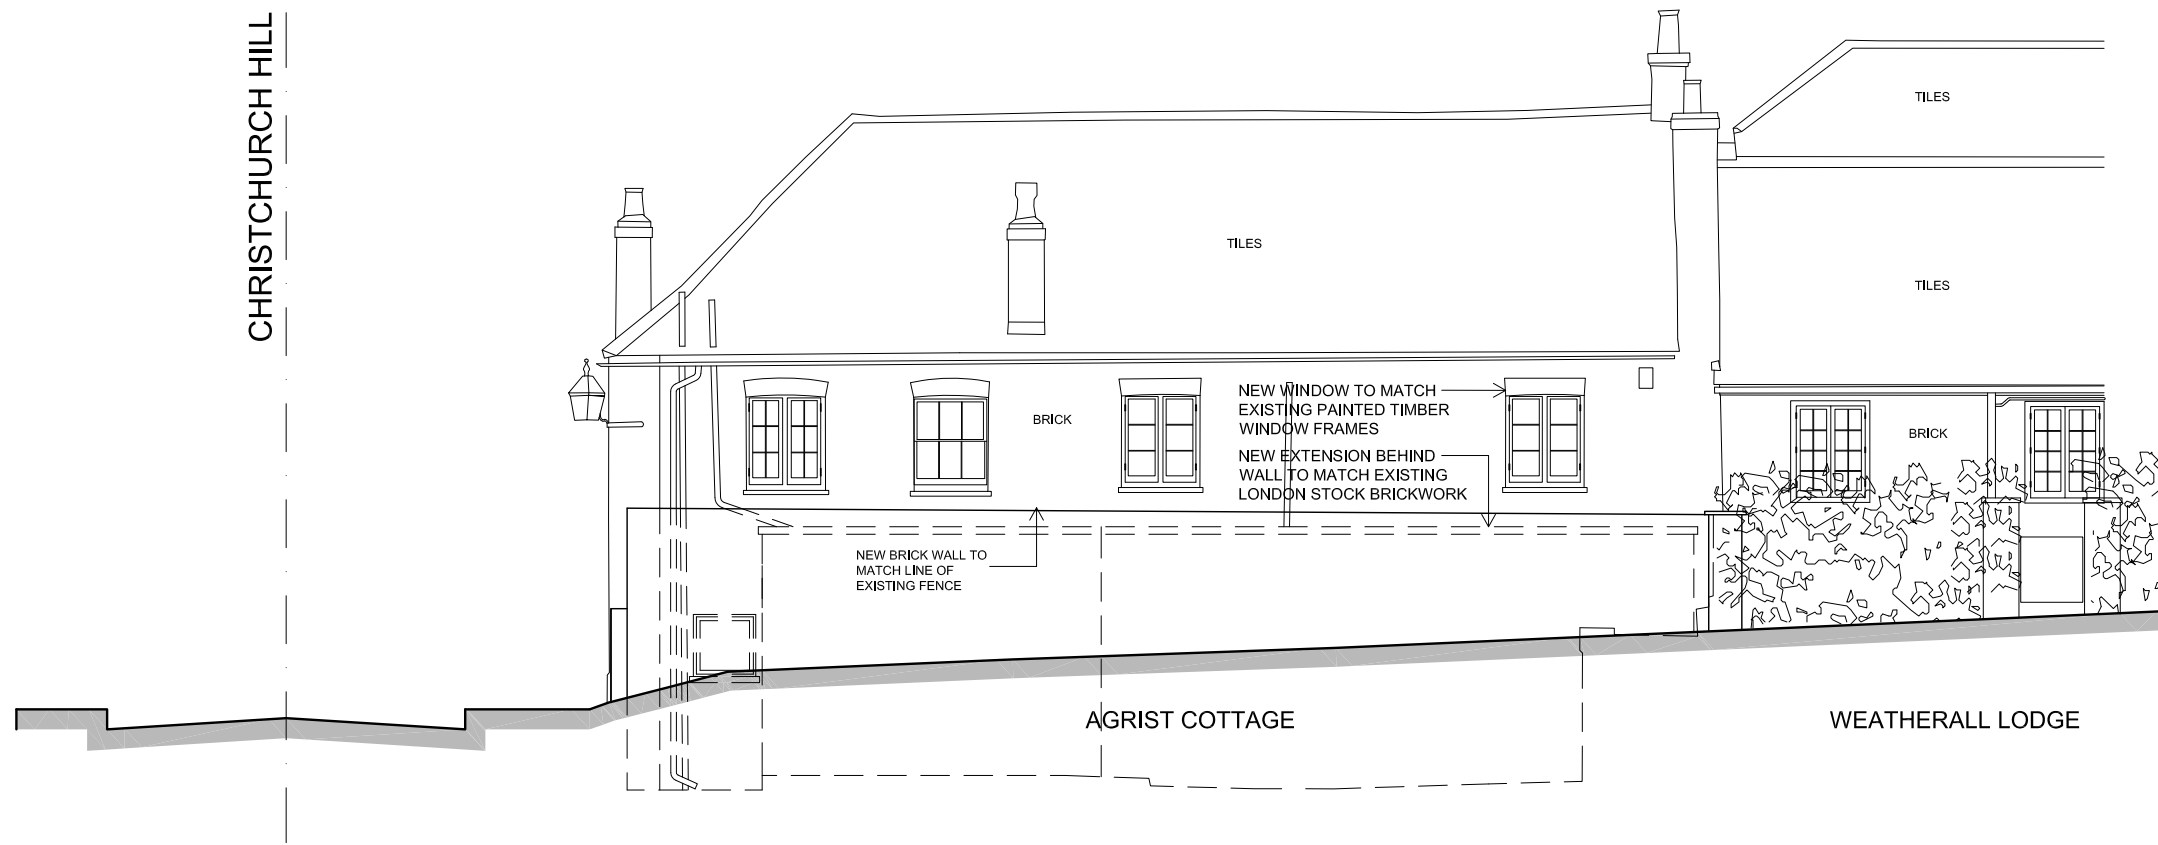

NORTH WEST (WELL ROAD) ELEVATION

DATUM 102.00m

WELL ROAD

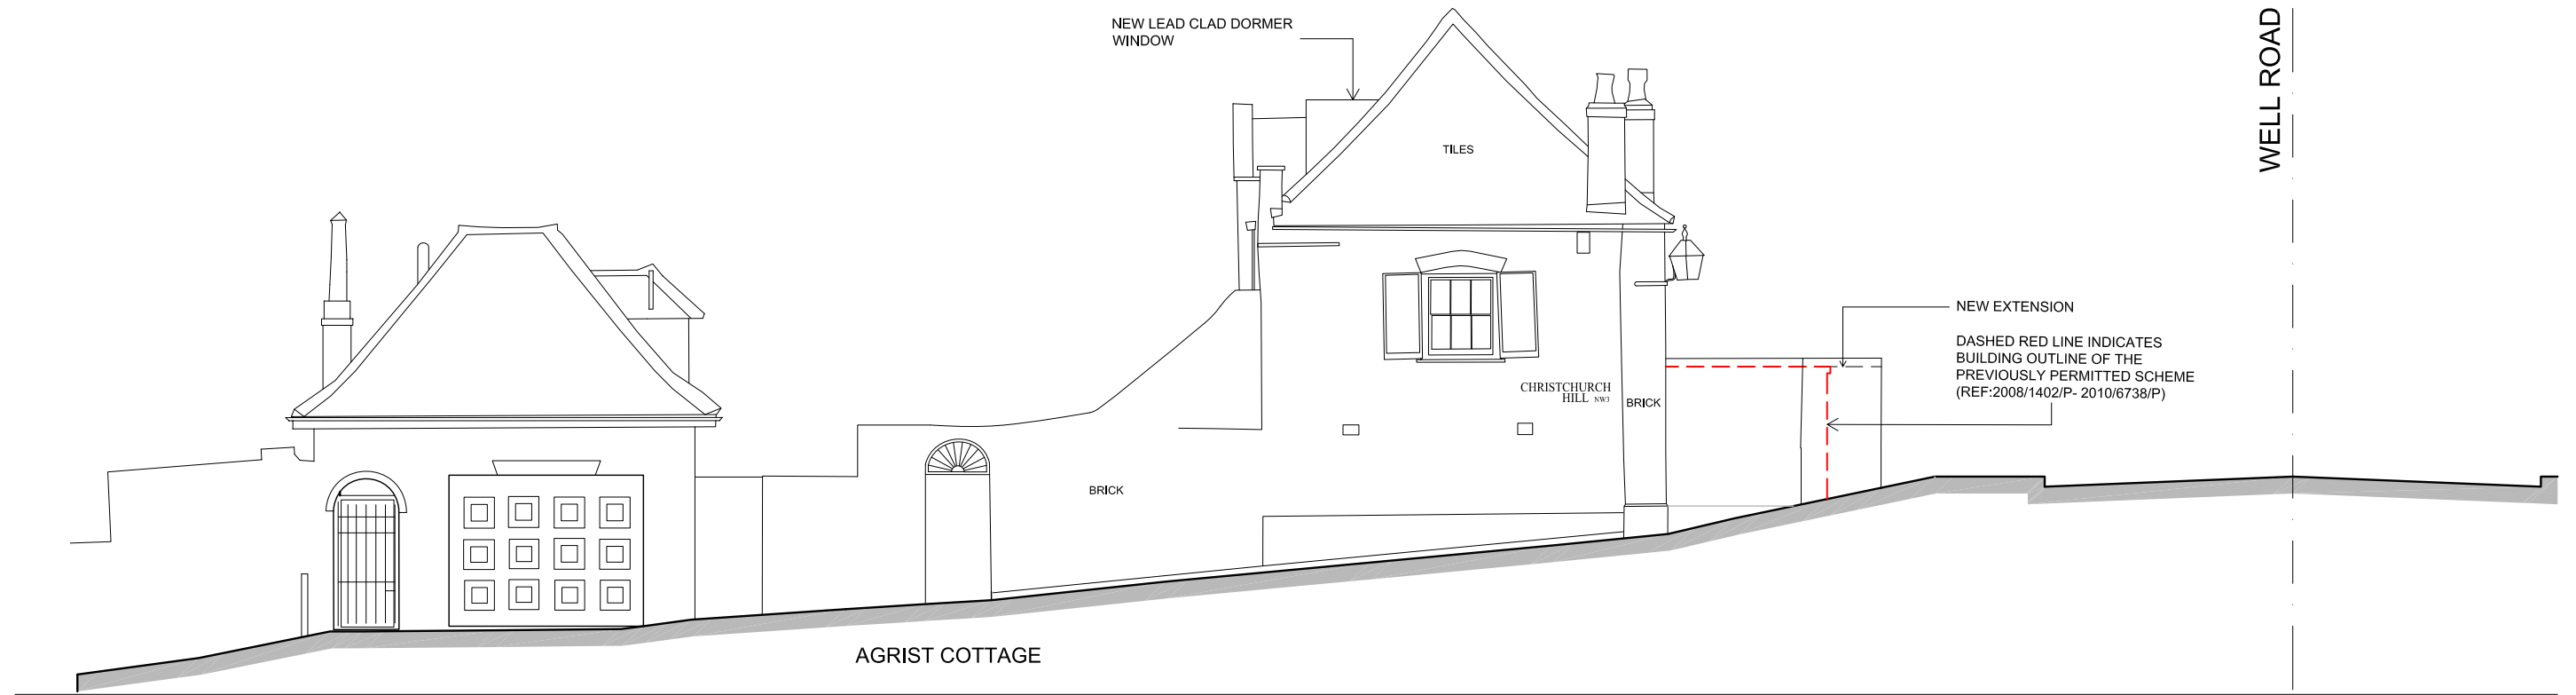


NORTH EAST (CHRISTCHURCH HILL) ELEVATION

DATUM 102.00m

General notes:

This drawing is copyright of KSR architects. This drawing must be read in conjunction with the Designer's Risk Assessment, specification and all other relevant documentation and drawings. KSR architects accept no liability for any expense, loss or damage of whatsoever nature and however arising from any variation made to this drawing or in the execution of the work to which it relates which has not been referred to them and their approval obtained.  
Do not scale from this drawing or the digital data, only figured dimensions are to be used. For Planning refer to linear scale.  
Check all dimensions on site prior to carrying out any works - advice any discrepancy

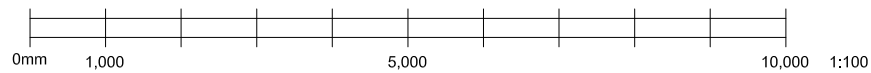

PLANNING

**KSRARCHITECTS**

KSR Architects LLP  
14 Greenland Street  
London NW1 0ND  
t: +44 (0)20 7892 5000  
e: info@ksrarchitects.com  
www.ksrarchitects.com

Project:  
53 CHRIST CHURCH HILL,  
LONDON, NW3 1LG.

Title:  
PROPOSED ELEVATIONS  
NORTH WEST & NORTH EAST

|                        |       |                   |    |                |  |              |             |                    |                         |             |
|------------------------|-------|-------------------|----|----------------|--|--------------|-------------|--------------------|-------------------------|-------------|
| A Planning Application |       | 12.07.16          | GJ | Date: 12.07.16 |  | Drawn By: GS | Checked: GJ | Project Ref: 16010 | Drawing No: 16010-P-301 | Revision: A |
| Rev                    | Notes | dd.mm.yy          | By | Chkd           |  |              |             |                    |                         |             |
| © KSR architects       |       | Scale: 1:100 @ A3 |    |                |  |              |             |                    |                         |             |