



~ NOTES ~


ALL WORK TO BE TO CLIENT & LOCAL AUTHORITY APPROVAL.
 ALL RELEVANT BS'S & CP'S TO BE COMPLIED WITH.
 ANY DISTURBANCE TO BE MADE GOOD TO MATCH EXISTING.
 ARCHITRAVES, CORNICES, DOORS & SKIRTINGS TO MATCH.
 SERVICES TO BE ALTERED & EXTENDED AS NECESSARY.

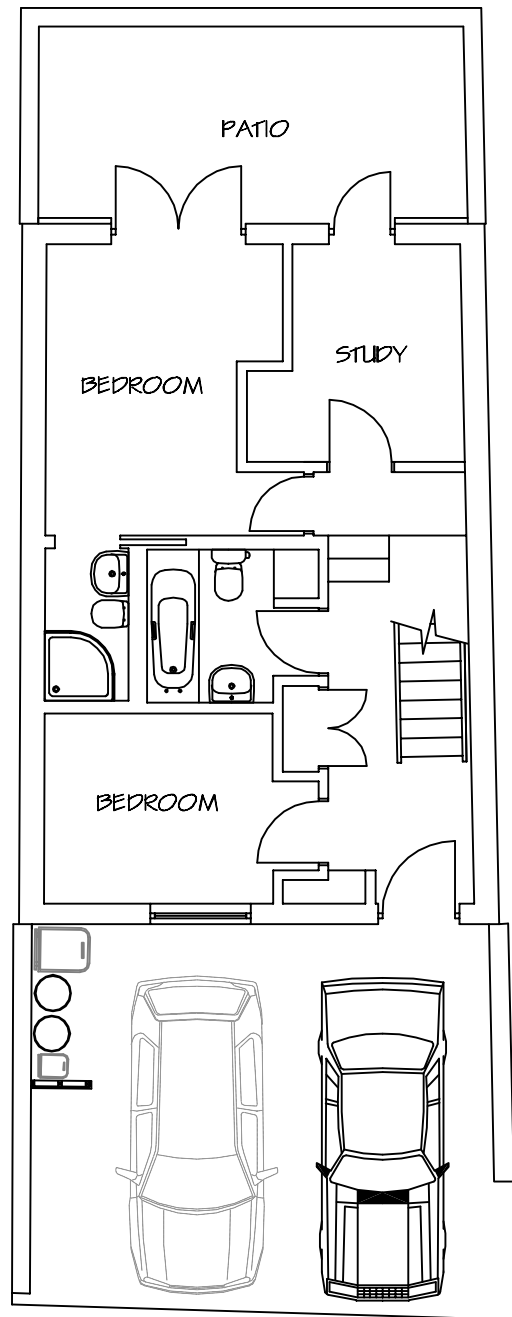

GROUND FLOOR PLAN

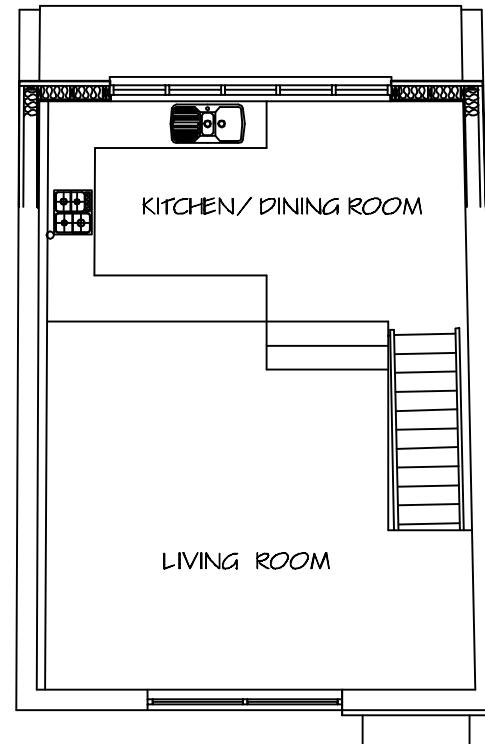

FIRST FLOOR PLAN

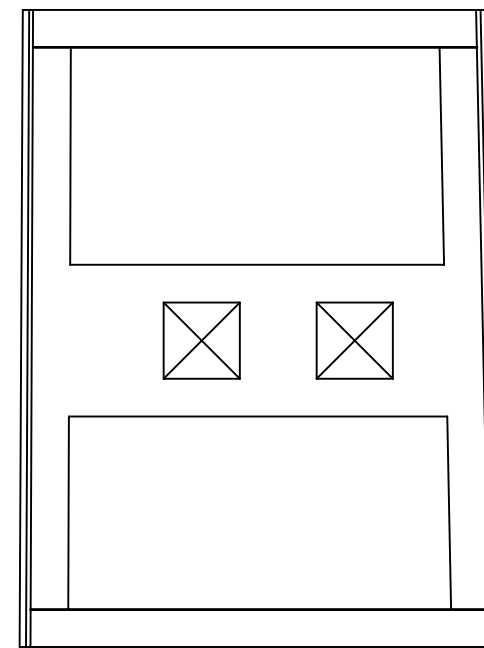

ROOF PLAN

REV L - Updated to as built Issued to new owner	19/07/2016
REV K - Refuse & Recycling Waste Provision	30/11/2015
REV J - Changes bubbled as requested by LPA Layout revised to move kitchen to rear	28/05/2015
REV I - Green roof layout shown on roof plan	16/02/2015
REV H - First floor layout reversed	15/01/2015
REV G - Roof lowered by 330mm. Front Elevation finishes and style redesigned	05/12/2014
REV F - Rear parapet removed to lower height	08/05/2014
REV E - Replacements for leaking rooflights added	14/02/2014
REV D - Planting added to front forecourt	11/11/2013
REV C - First floor layout reversed and external window/door openings rev'd, planting added	18/07/2013
REV B - Replacement window specified	06/03/2013
REV A - Window recessed to allow 16.5m separation	30/01/2013
REVISIONS	DATE

Architectural Design & Planning
 32 Grange Road
 Plymouth PL7 2HY
 t: 01752 341696
 f: 01752 342503



TITLE
 PROPOSED FLOOR PLANS

ADDRESS
 33c MILL LANE
 LONDON NW6 1NZ

CLIENT
 COBSTAR Ltd

SCALE
 A1 1:50 & 1:100 DATE DEC 2012

DRAWING No. 121214/P/01 REV. L