


PLANNING

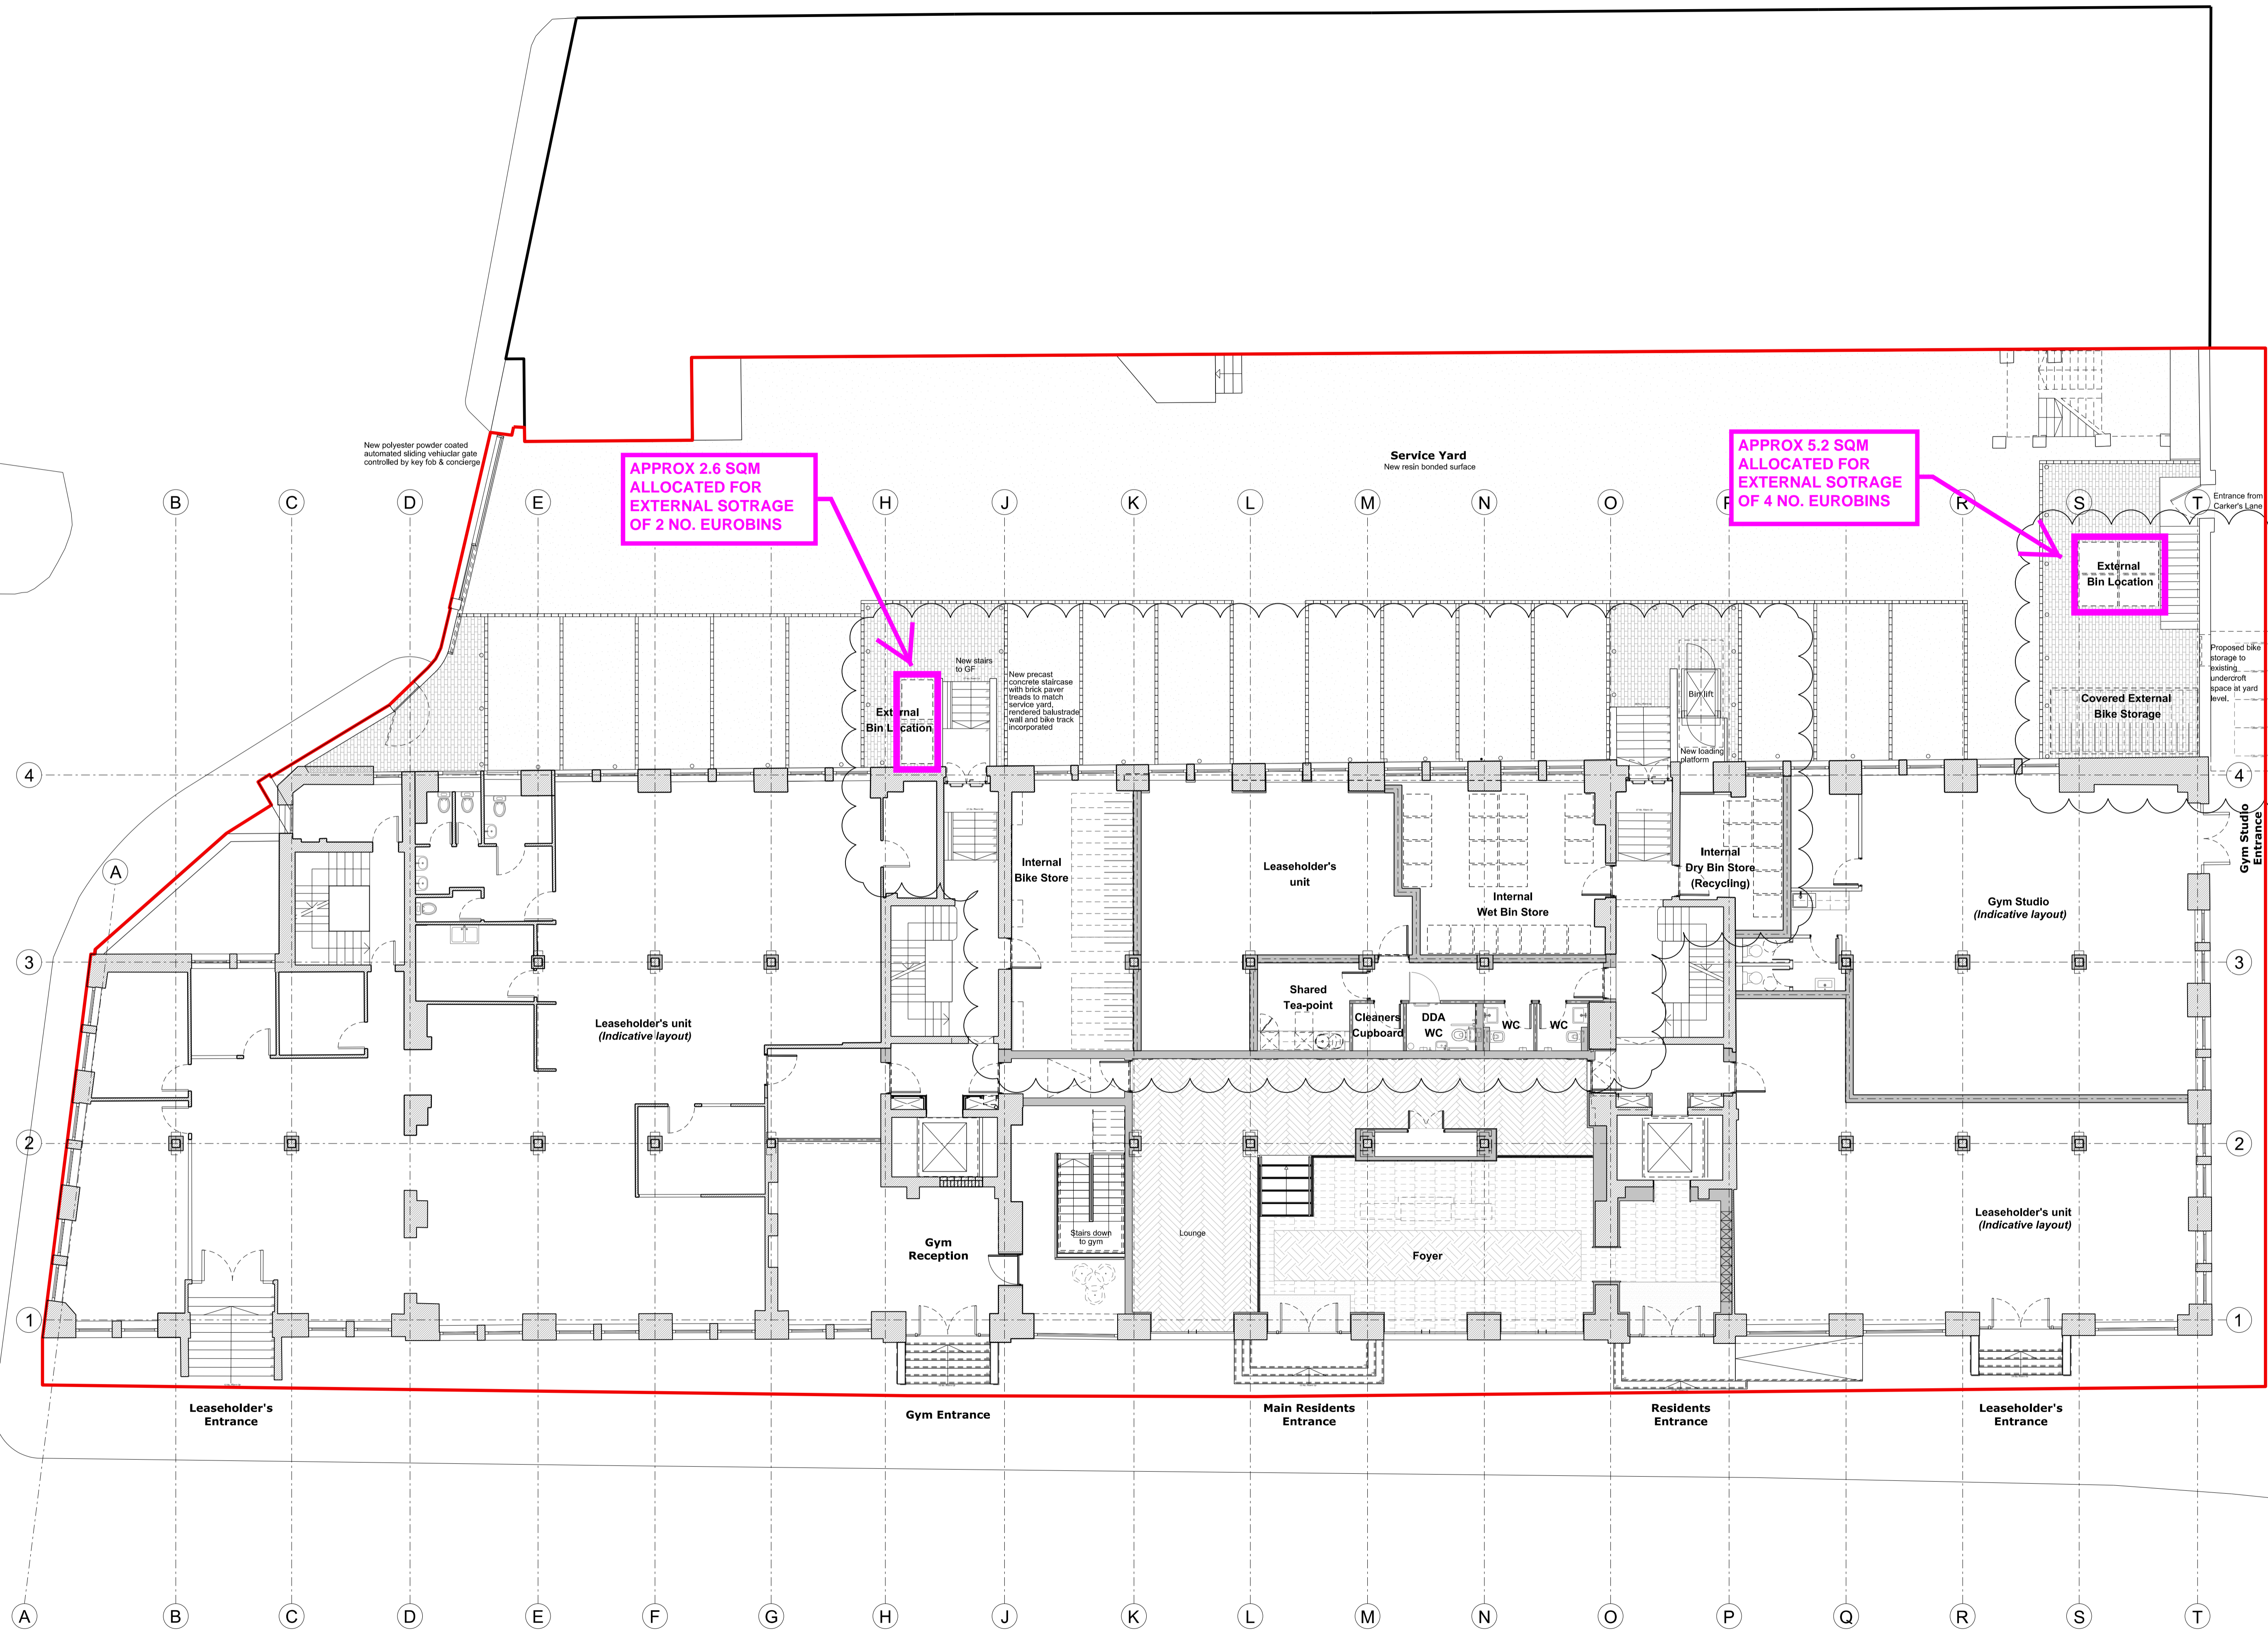

CSA MARK-UPS IN PURPLE FOR CLARIFICATION OF EXTERNAL BIN STORAGE AREAS IN RESPONSE TO QUERY OF PLANNING OFFICER DATED 12TH AUGUST 2016

P5	04.07.16	Internal + rear yard layout alterations
P4	21.12.15	Light layout + CCTV
P3	01.06.15	Internal layout alterations
P2	16.02.15	Revision of cycle shed
P1	15.08.14	Planning Issue
Rev	Date	Note

Acoustic Engineer
Gillieron Scott Acoustic Design

Interior Design
Gordon-Duff + Linton

Project Management / Quantity Surveyor
Stace LLP

Services
Synergy Consulting

Structures
Fluid Structures

Client
Linton Property Developments Ltd
The Linton Group,
14 Basil Street, Knightsbridge, London, SW3 1AJ

Project title
LINTON HOUSE

Drawing Title
GROUND FLOOR PLAN AS PROPOSED


Scale @ A1 **1:100** Scale @ A3 **1:200**

Project No.	Drawing no.	Revision
152	120	P5

Status	Date of Issue
PLANNING	JUL 2016

Clive Sall Architecture Ltd.
2 Providence Yard
Ezra Street
London E2 7RJ
Copyright CLIVE SALL ARCHITECTURE LTD

1 Ground Floor as proposed
152_120
Scale 1:100 @ A1

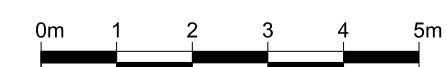

HIGHGATE ROAD