


CAMDEM ELEVATION  
CAMDEN HIGH STREET

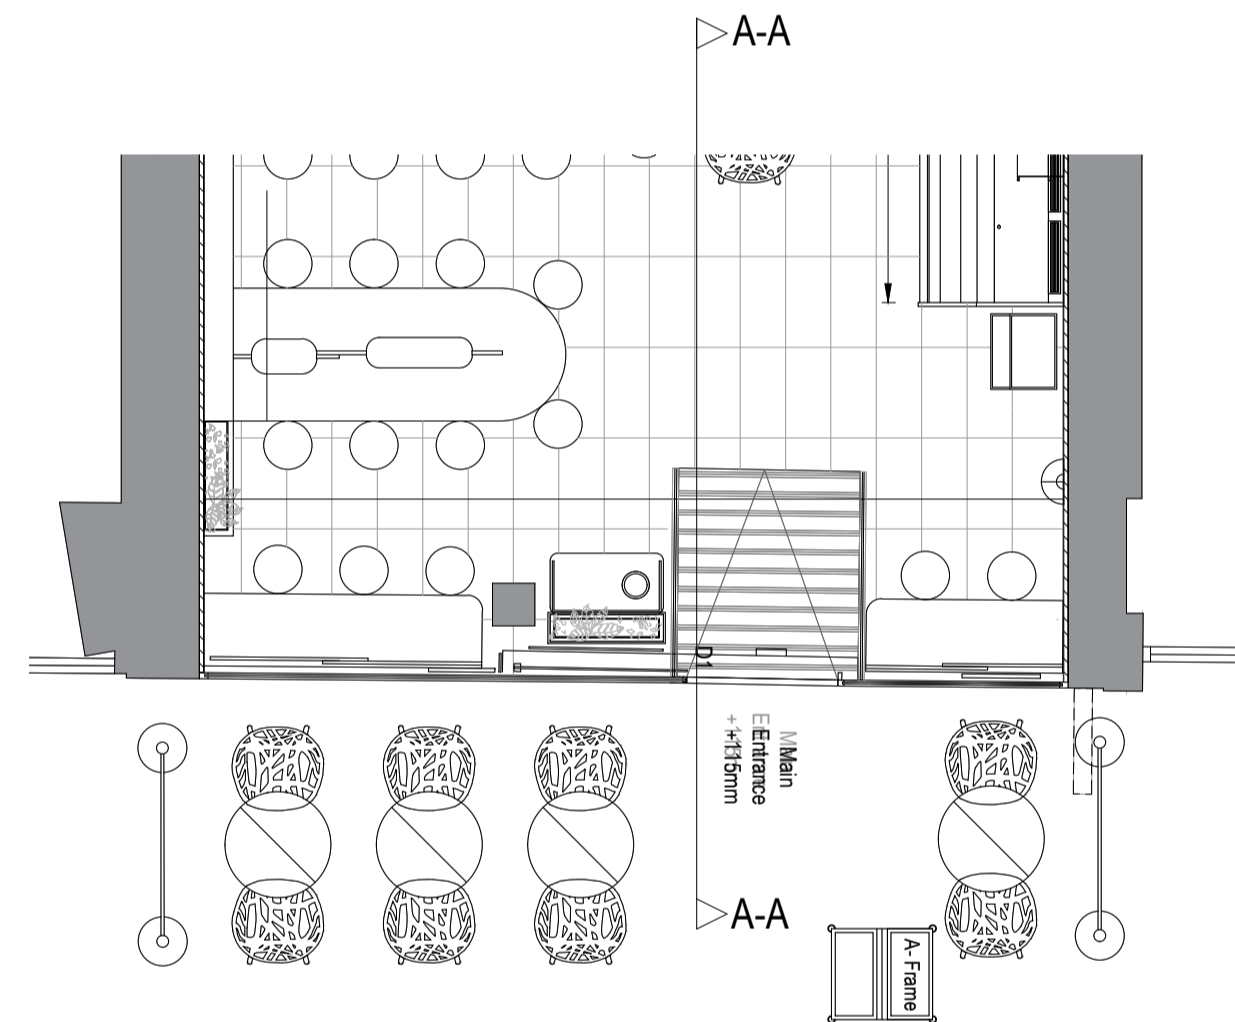

CAMDEM SHOP FRONT PLAN  
CAMDEN HIGH STREET

## External Shop Front Elevations

**PROJECT**  
ITSU CAMDEN  
191-192 CAMDEN HIGH STREET  
LONDON  
NW1 7BT

**DRAWING TITLE**  
EXTERNAL SHOP FRONT ELEVATION

**PROJECT No.**  
1541

**SCALE**  
1:50@A1

**DRAWING No.**  
1541-P-04

**DRAWN BY**  
GT

**DATE**  
14/06/2016

**REV**  
A

REV	DESCRIPTION	DATE	BY
-	Proposed External Shop Front Elevation Produced	20/05/2016	ITSU
A	Shop front amended following site visit and totem positions amended	14/06/2016	ITSU

**DRAWING STATUS**  
**AS BUILT**

DO NOT SCALE FROM THIS DRAWING. THE AUTHOR OF THIS DRAWING TAKES NO RESPONSIBILITY FOR ANY DIMENSIONS OBTAINED BY MEASURING OR SCALING FROM THIS DRAWING AND NO RELIANCE MAY BE PLACED ON SUCH DIMENSIONS. ALL DIMENSIONS MUST BE CHECKED AND VERIFIED ON SITE BY THE CONTRACTOR BEFORE COMMENCING ANY WORK OR PRODUCING DRAWINGS. ITSU MUST BE NOTIFIED IMMEDIATELY OF ANY ERRORS OR DISCREPANCIES PRIOR TO THE COMMENCEMENT OF WORK.

THIS DRAWING AND ALL INFORMATION CONTAINED WITHIN IS THE SOLE PROPERTY OF ITSU LTD AND MAY NOT BE REPRODUCED IN WHOLE OR PART WITHOUT WRITTEN PERMISSION FROM ITSU LTD.

