

This drawing is partly based on information supplied by third parties and as such no guarantee can be made as to its accuracy. The features illustrated are therefore approximate and must be subject to a detailed topographical and/or measured building survey, statutory services enquiries and confirmation of legal boundaries.

Do not scale from this drawing: use figured dimensions only taken from elements as prescribed on the drawing. (Figured dimensions when taken from existing elements are from the finished surface.) Discrepancies must be reported prior to commencement of any work or fabrication of elements. If in doubt, refer to the contract administrator.

License is hereby granted for the intended user to employ the information contained within this drawing for purposes connected with the related project only. Copyright of this drawing remains solely the property of CeeToo Architecture Limited unless otherwise assigned in writing. Breach of the terms of this license results in the immediate termination of the license; the medium and any resulting copies must be returned to CeeToo immediately.

EXISTING CHIMNEY'S AND PARTY WALL TO BE EXTENDED

8.995 TOP OF EXISTING PARAPET (APPROX)

8.657 U/S OF NEW PARAPET COPING

7.580 FFL FOURTH FLOOR (APPROX)

7.090 WINDOW HEAD (APPROX)

5.525 WINDOW CILL LEVEL (APPROX)

4.849 FFL THIRD FLOOR (APPROX)

4.481 WINDOW HEAD (APPROX)

2.914 WINDOW CILL LEVEL (APPROX)

2.227 FFL SECOND FLOOR (APPROX)

1.870 WINDOW HEAD (APPROX)

0.050 WINDOW CILL LEVEL (APPROX)


0.000 DATUM (TOP OF CORNICE)

-0.643 FFL FIRST FLOOR (APPROX)

-4.814 FFL GROUND FLOOR (APPROX)



ELEVATION TO PATSHULL ROAD: AS PROPOSED

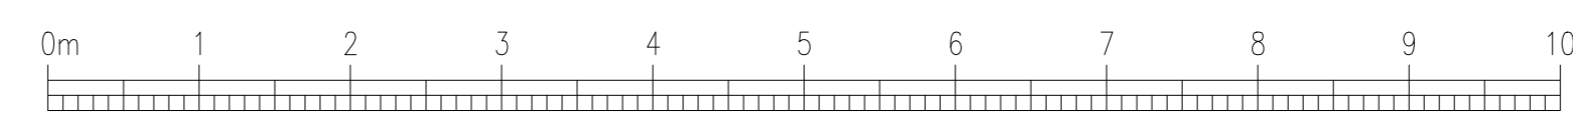

A REDRAWN: WINDOWS AMENDED 03.08.16

Project: 1242
180 Kentish Town Road
 London NW5 2AE

Client: Quadrant Design & Construction Ltd

CONVERSION TO RESIDENTIAL
 Elevation to Patshull Road: As Proposed
 General Arrangement

Drawing Status	AS CONSTRUCTED AND TO BE CONSTRUCTED	Date	13.03.16
Drawing Scale	1:50 at A2 (1:100 at A4)	Revision	
Drawing Number	C2.1242.GAD.012	Revision	A

ceetoo
 Architects & Development Consultants www.ceetoo.com
 One 15a, St Dunmores Park, London E2 6DP, 020 7033 3800