


Existing walls to be retained or modified.

FIRST FLOOR: AS PROPOSED



North

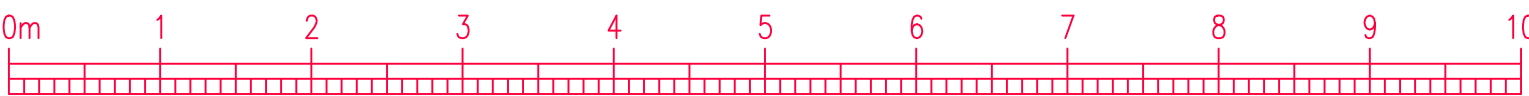

This drawing is partly based on information supplied by third parties and as such no guarantee can be made as to its accuracy. The features illustrated are therefore approximate and must be subject to a detailed topographical and/or measured building survey, statutory services enquiries and confirmation of legal boundaries.

Do not scale from this drawing: use figured dimensions only taken from elements as prescribed on the drawing. (Figured dimensions when taken from existing elements are from the finished surface.) Discrepancies must be reported prior to commencement of any work or fabrication of elements. If in doubt, refer to the contract administrator.

Licence is hereby granted for the intended user to employ the information contained within this drawing for purposes connected with the related project only. Copyright of this drawing remains solely the property of CeeToo Architecture Limited unless otherwise assigned in writing. Breach of the terms of this licence results in the immediate termination of the licence, the medium and any resulting copies must be returned to CeeToo immediately.

B Flue added, external walls to annex amended 03.08.16
A Section lines amended 13.01.16

Project: 1242
180 Kentish Town Road
London NW5 2AE

Client: Ouadrant Design & Construction Ltd

Drawing Title
CONVERSION TO RESIDENTIAL
First Floor Plan As Proposed
General Arrangement

Drawing Status AS CONSTRUCTED AND TO BE CONSTRUCTED	
Drawing Scale 1:50 at A2 (1:100 at A4)	Page 30.135
Drawing Number C2.1242.GAD.003	Revision B

ceetoo²
Architects & Development Consultants | www.ceetoo.com
Unit 10a, 5 Doughty Yard, London E2 6DP, 020 7533 3800