




EXISTING DETAIL PLAN

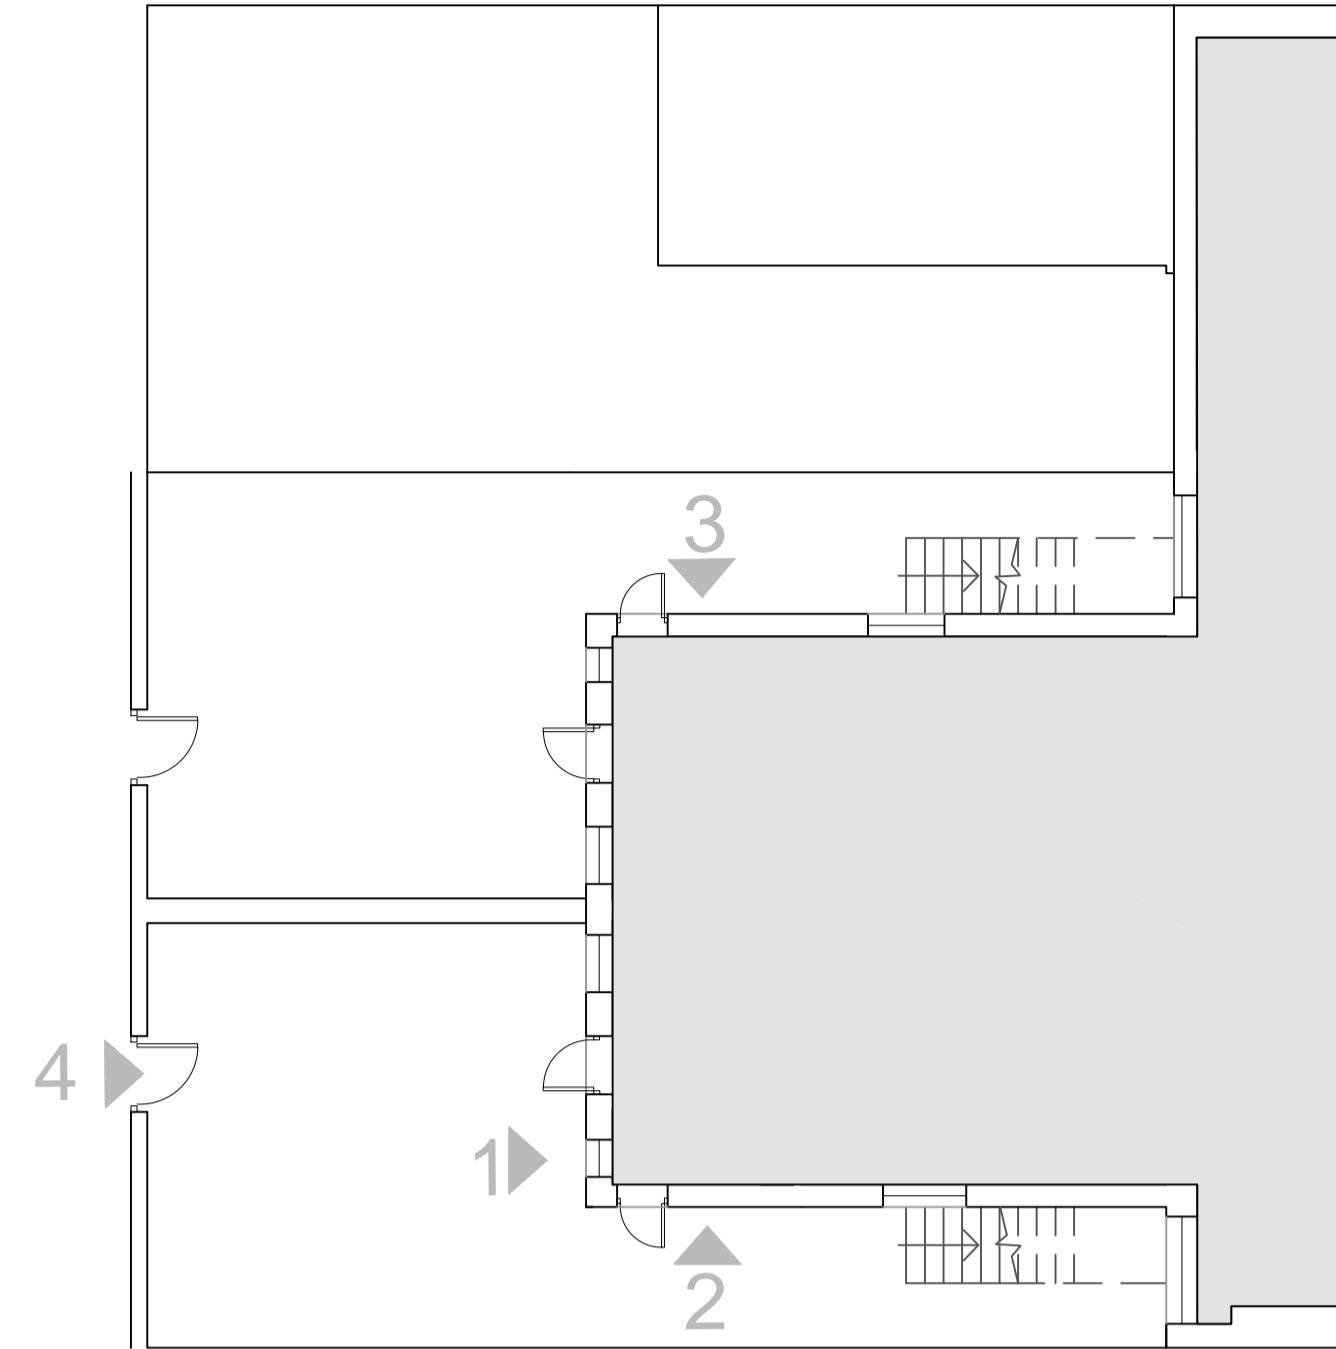

AS-BUILT DETAIL PLAN

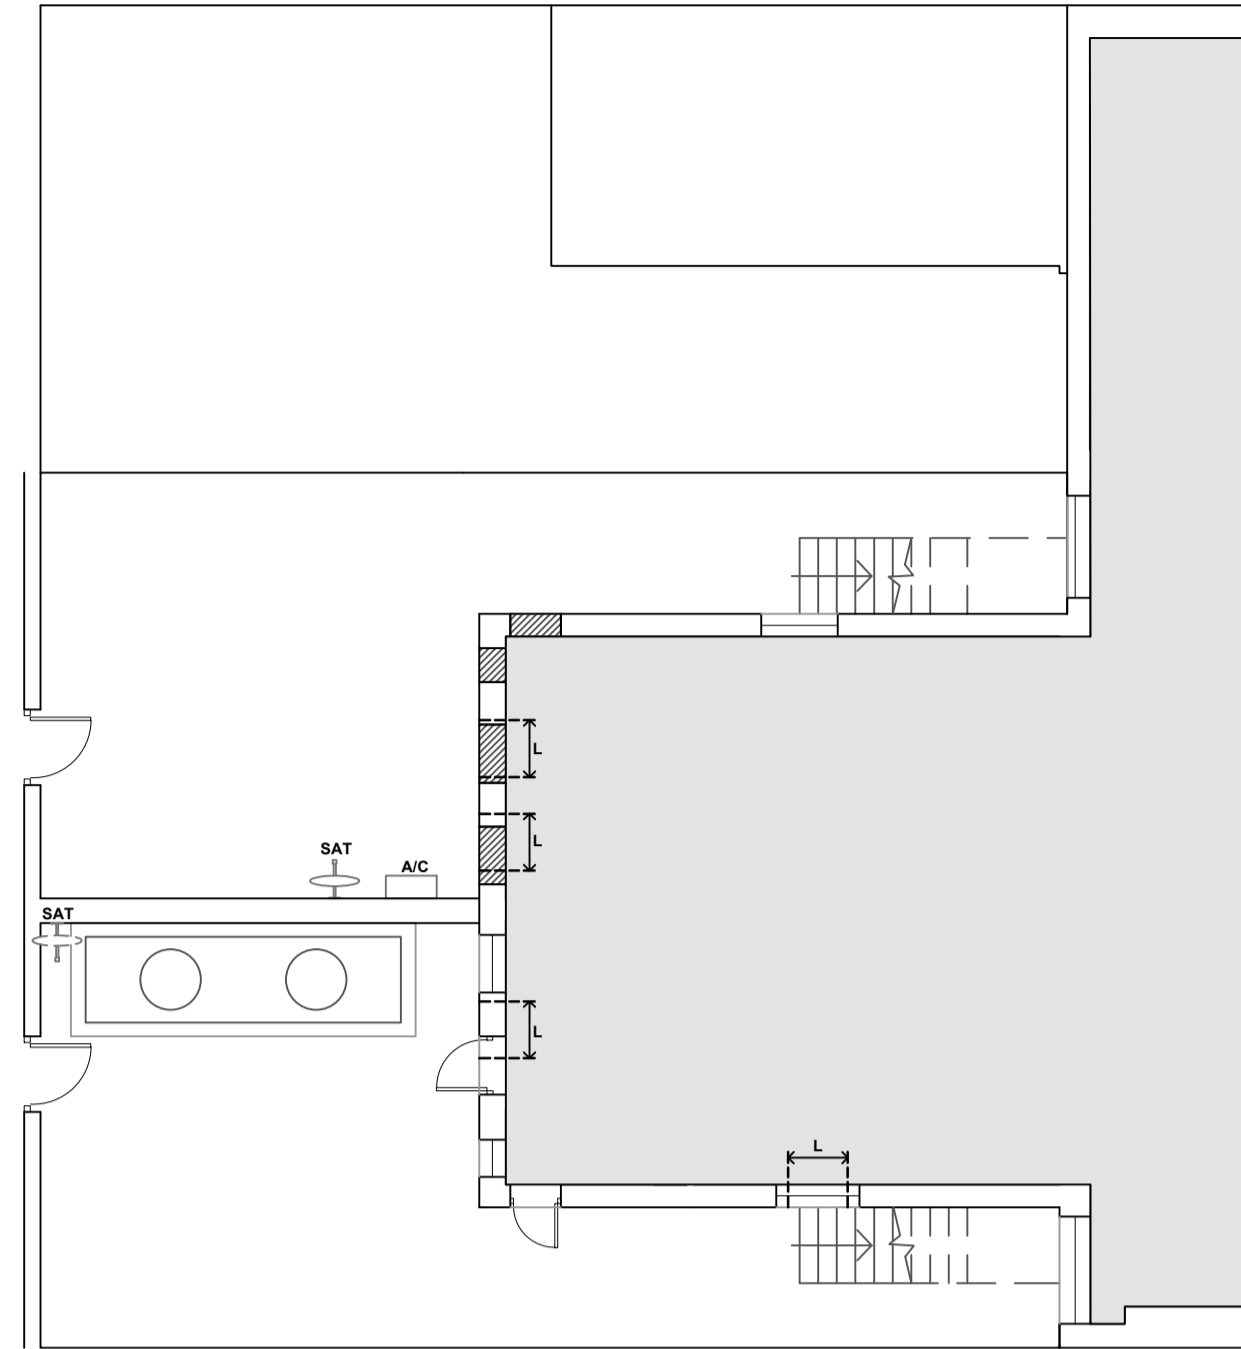


PROPOSED DETAIL PLAN

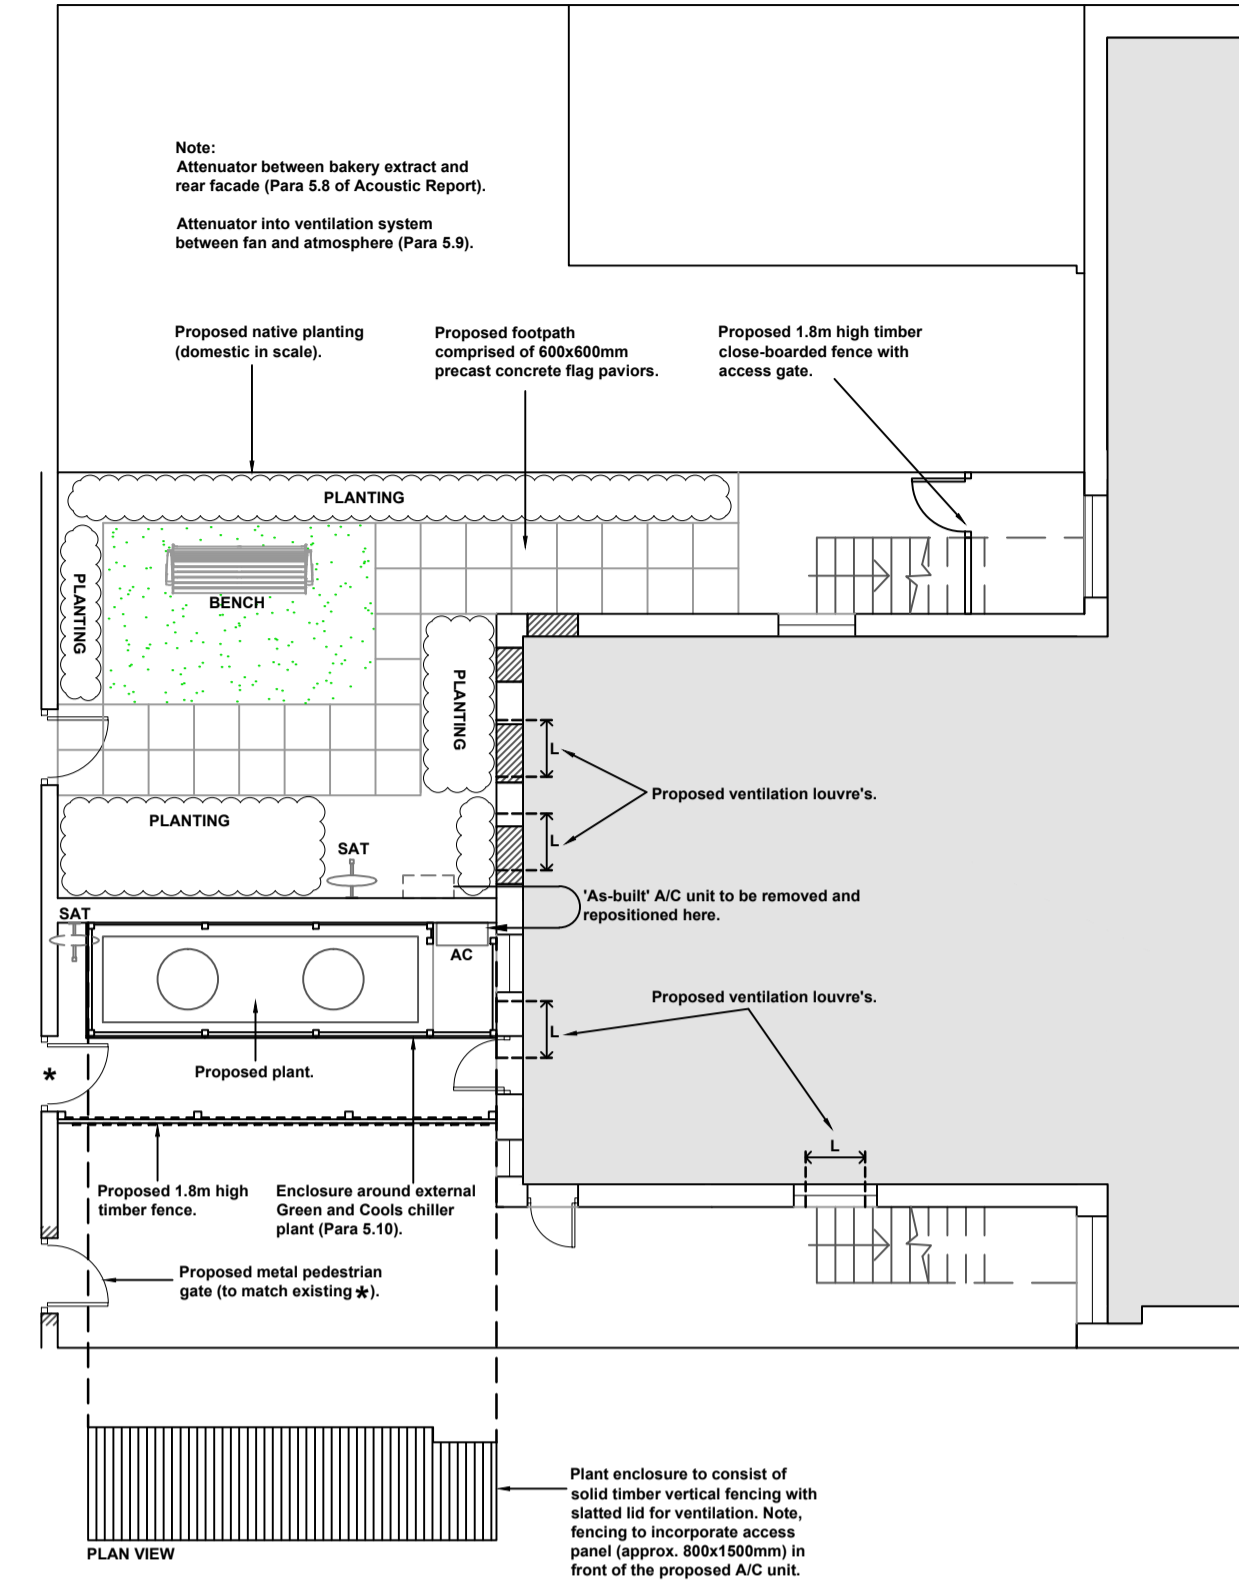

EXISTING REAR ELEVATION (VIEW '1')




EXISTING SIDE ELEVATION (VIEW '2')

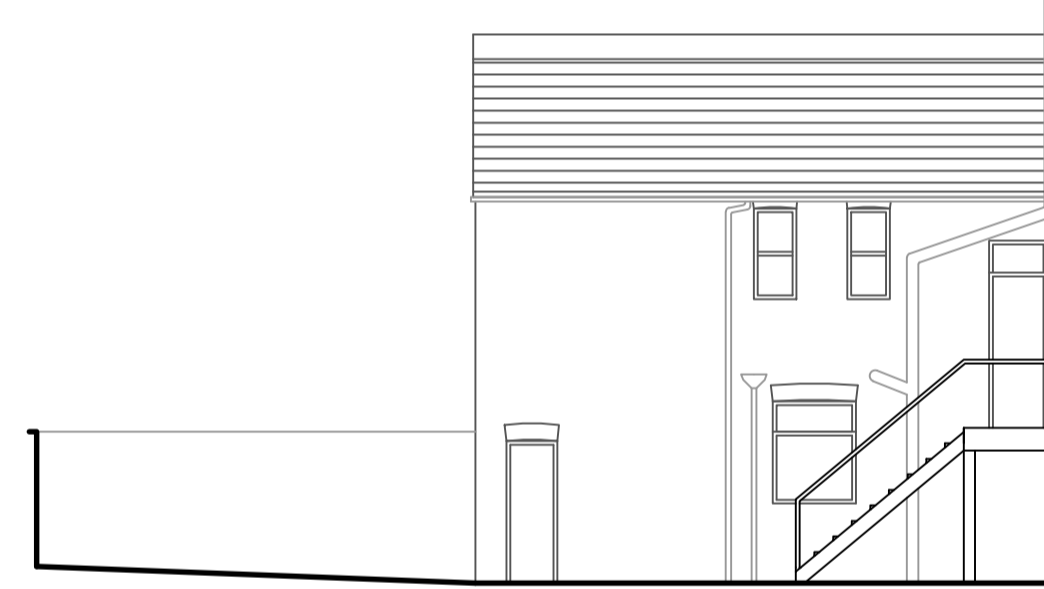

EXISTING SIDE ELEVATION (VIEW '3')



EXISTING REAR ELEVATION (VIEW '4')

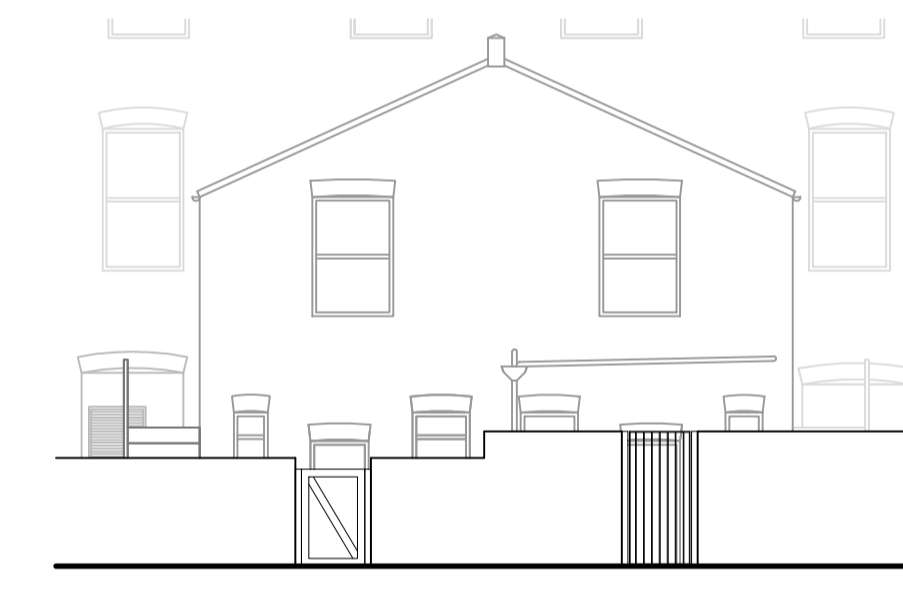


AS-BUILT REAR ELEVATION (VIEW '1')




AS-BUILT SIDE ELEVATION (VIEW '2')




AS-BUILT SIDE ELEVATION (VIEW '3')

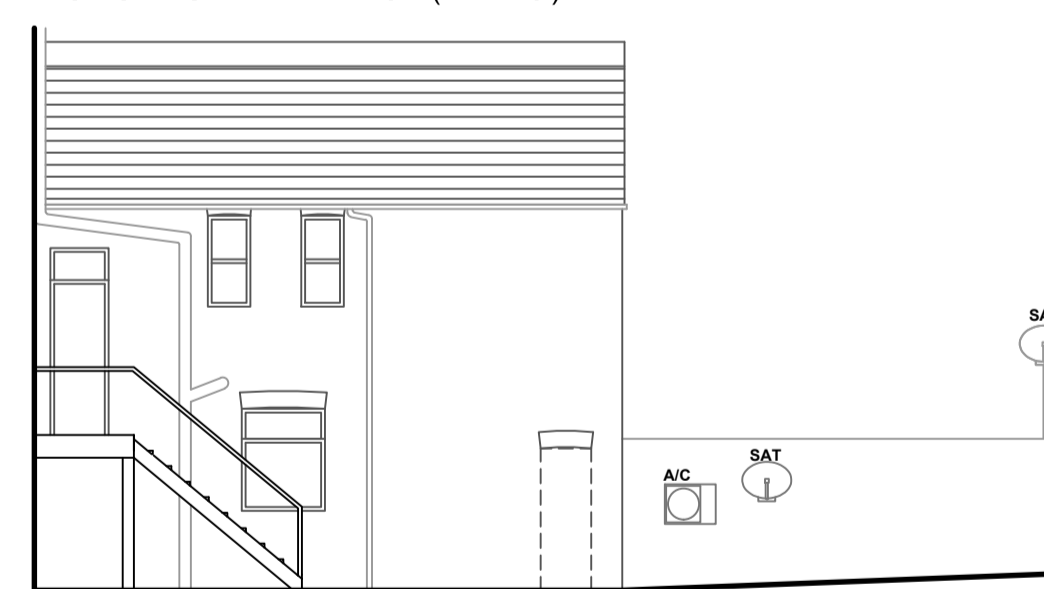


AS-BUILT REAR ELEVATION (VIEW '4')

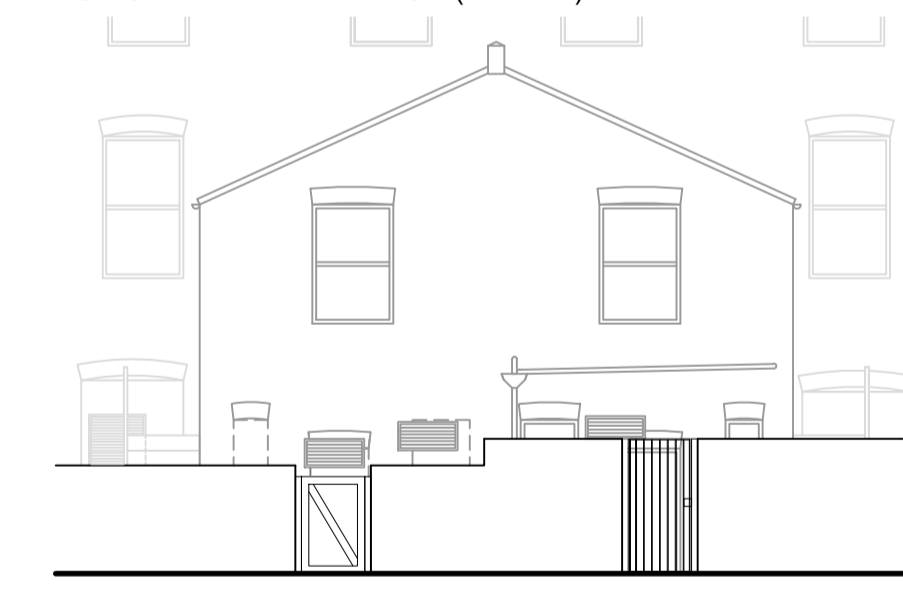


PROPOSED REAR ELEVATION (VIEW '1')

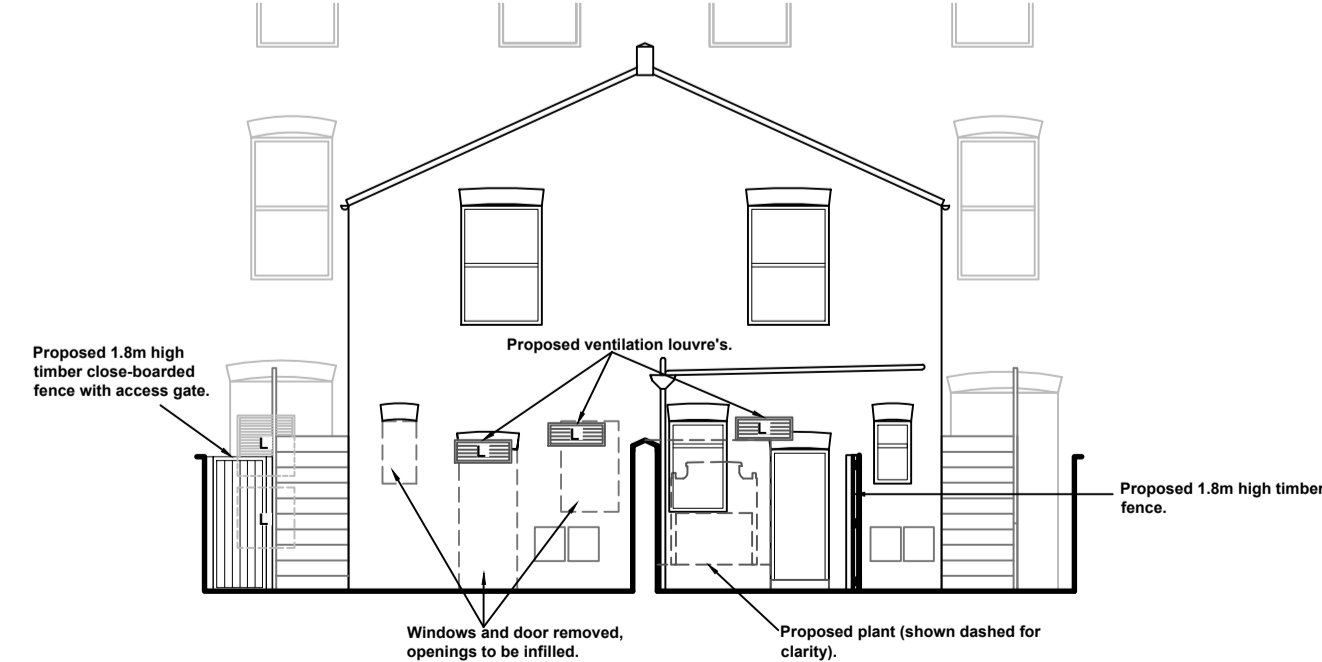


PROPOSED SIDE ELEVATION (VIEW '2')

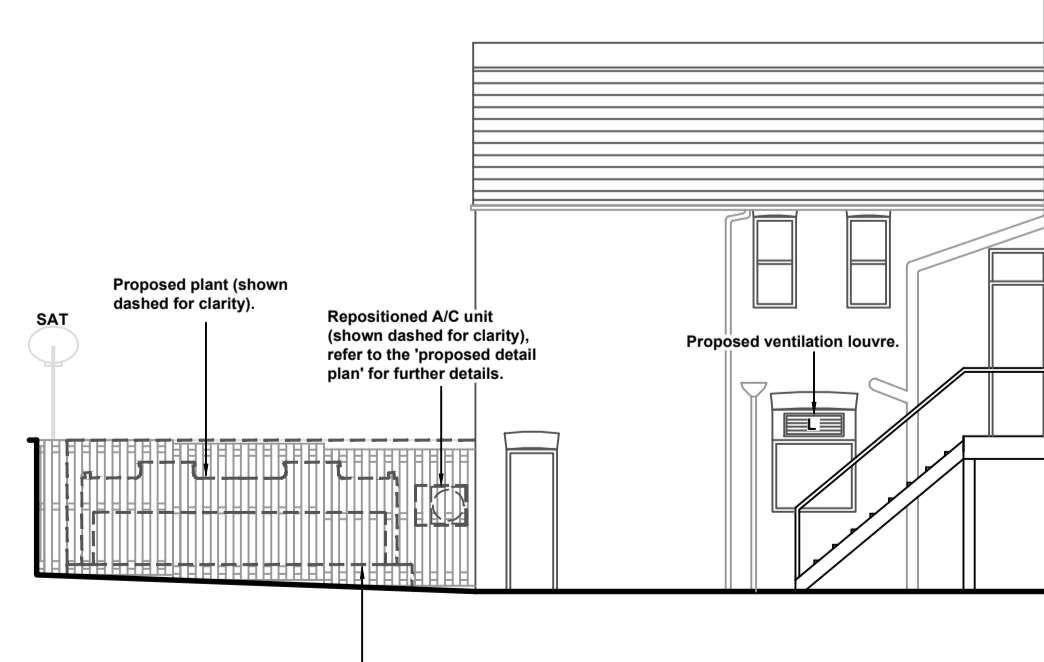

PROPOSED SIDE ELEVATION (VIEW '3')

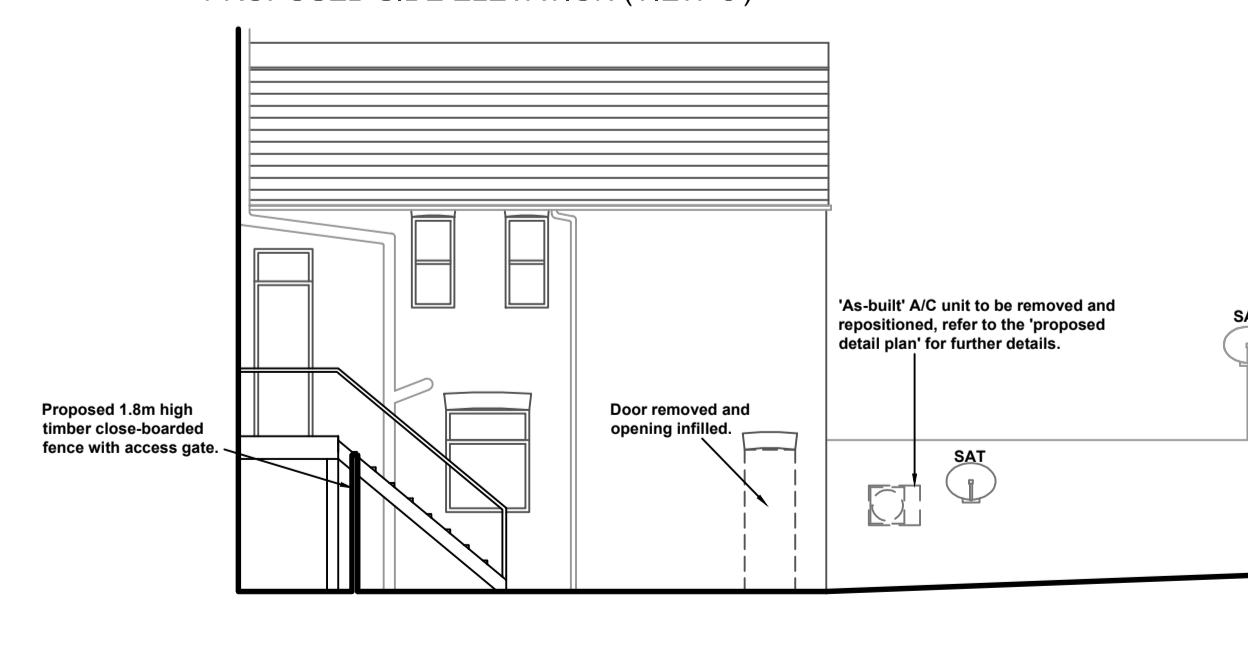

PROPOSED REAR ELEVATION (VIEW '4')

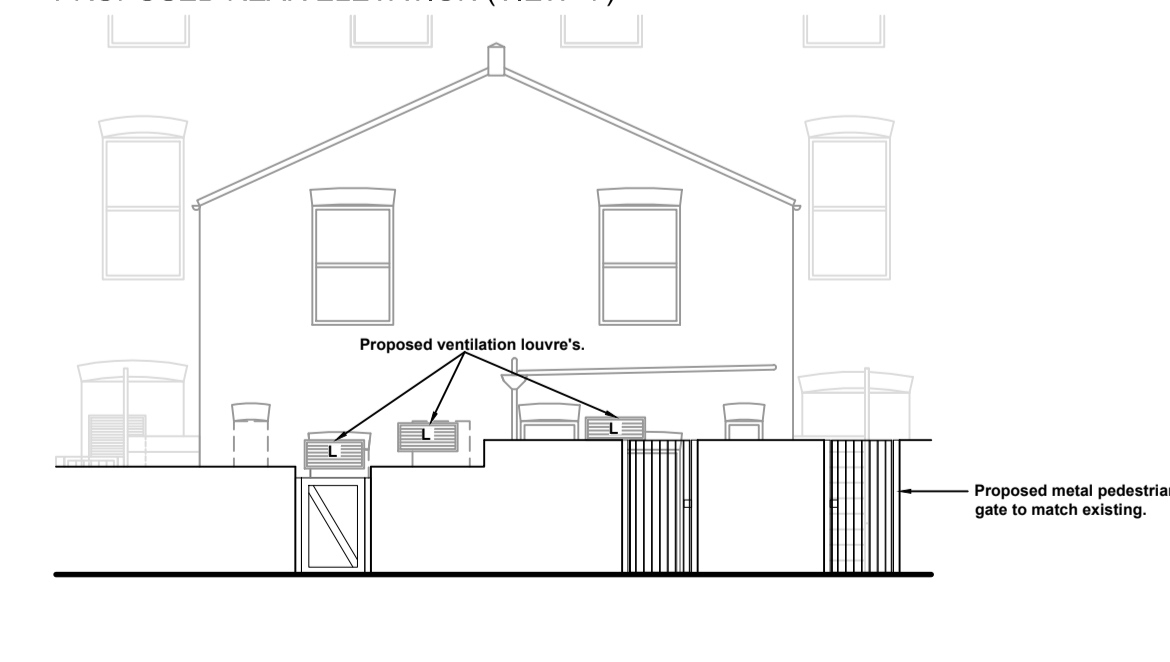

GENERAL NOTES

This scheme is subject to Town Planning and all other necessary consents. Dimensions, areas and levels where given are only approximate and subject to site survey. All dimensions are to be checked on site. Do not scale other than for Planning purposes. This drawing is to be read in conjunction with all relevant consultants' and/or specialists' drawings/documents and any discrepancies or variations are to be notified to the architects before the effected work commences. All queries relating to design of foundations, floor slabs and any structural elements are to be referred to the structural engineering consultant for resolution. All feasibility studies are subject to full site survey. The workmanship of all relevant trades and building operations shall comply with the recommendations of British Standard (BS) 8000:1989 parts 1-15 inclusive.

All design and construction is to be in accordance with the Construction, Design and Management Regulations 2015

NOTE:
DRAWING TO BE USED FOR PLANNING PURPOSES ONLY.

KEY:
A/C - Air conditioning unit.
SAT - Satellite dish.
L - Louvre.

Hatch denotes openings to be blocked up.

PLANNING

CLIENT



PROJECT
22-26 Cricklewood
Broadway,
Bronsbury,
NW2 3HD

DRAWING
Existing, As-Built
and Proposed Detail
Plans/Elevations



DATE 09.09.16 DRAWN L.O'R
SCALE 1:100@A1 CHECKED M.L

CHQ.16.11872 - 12

