



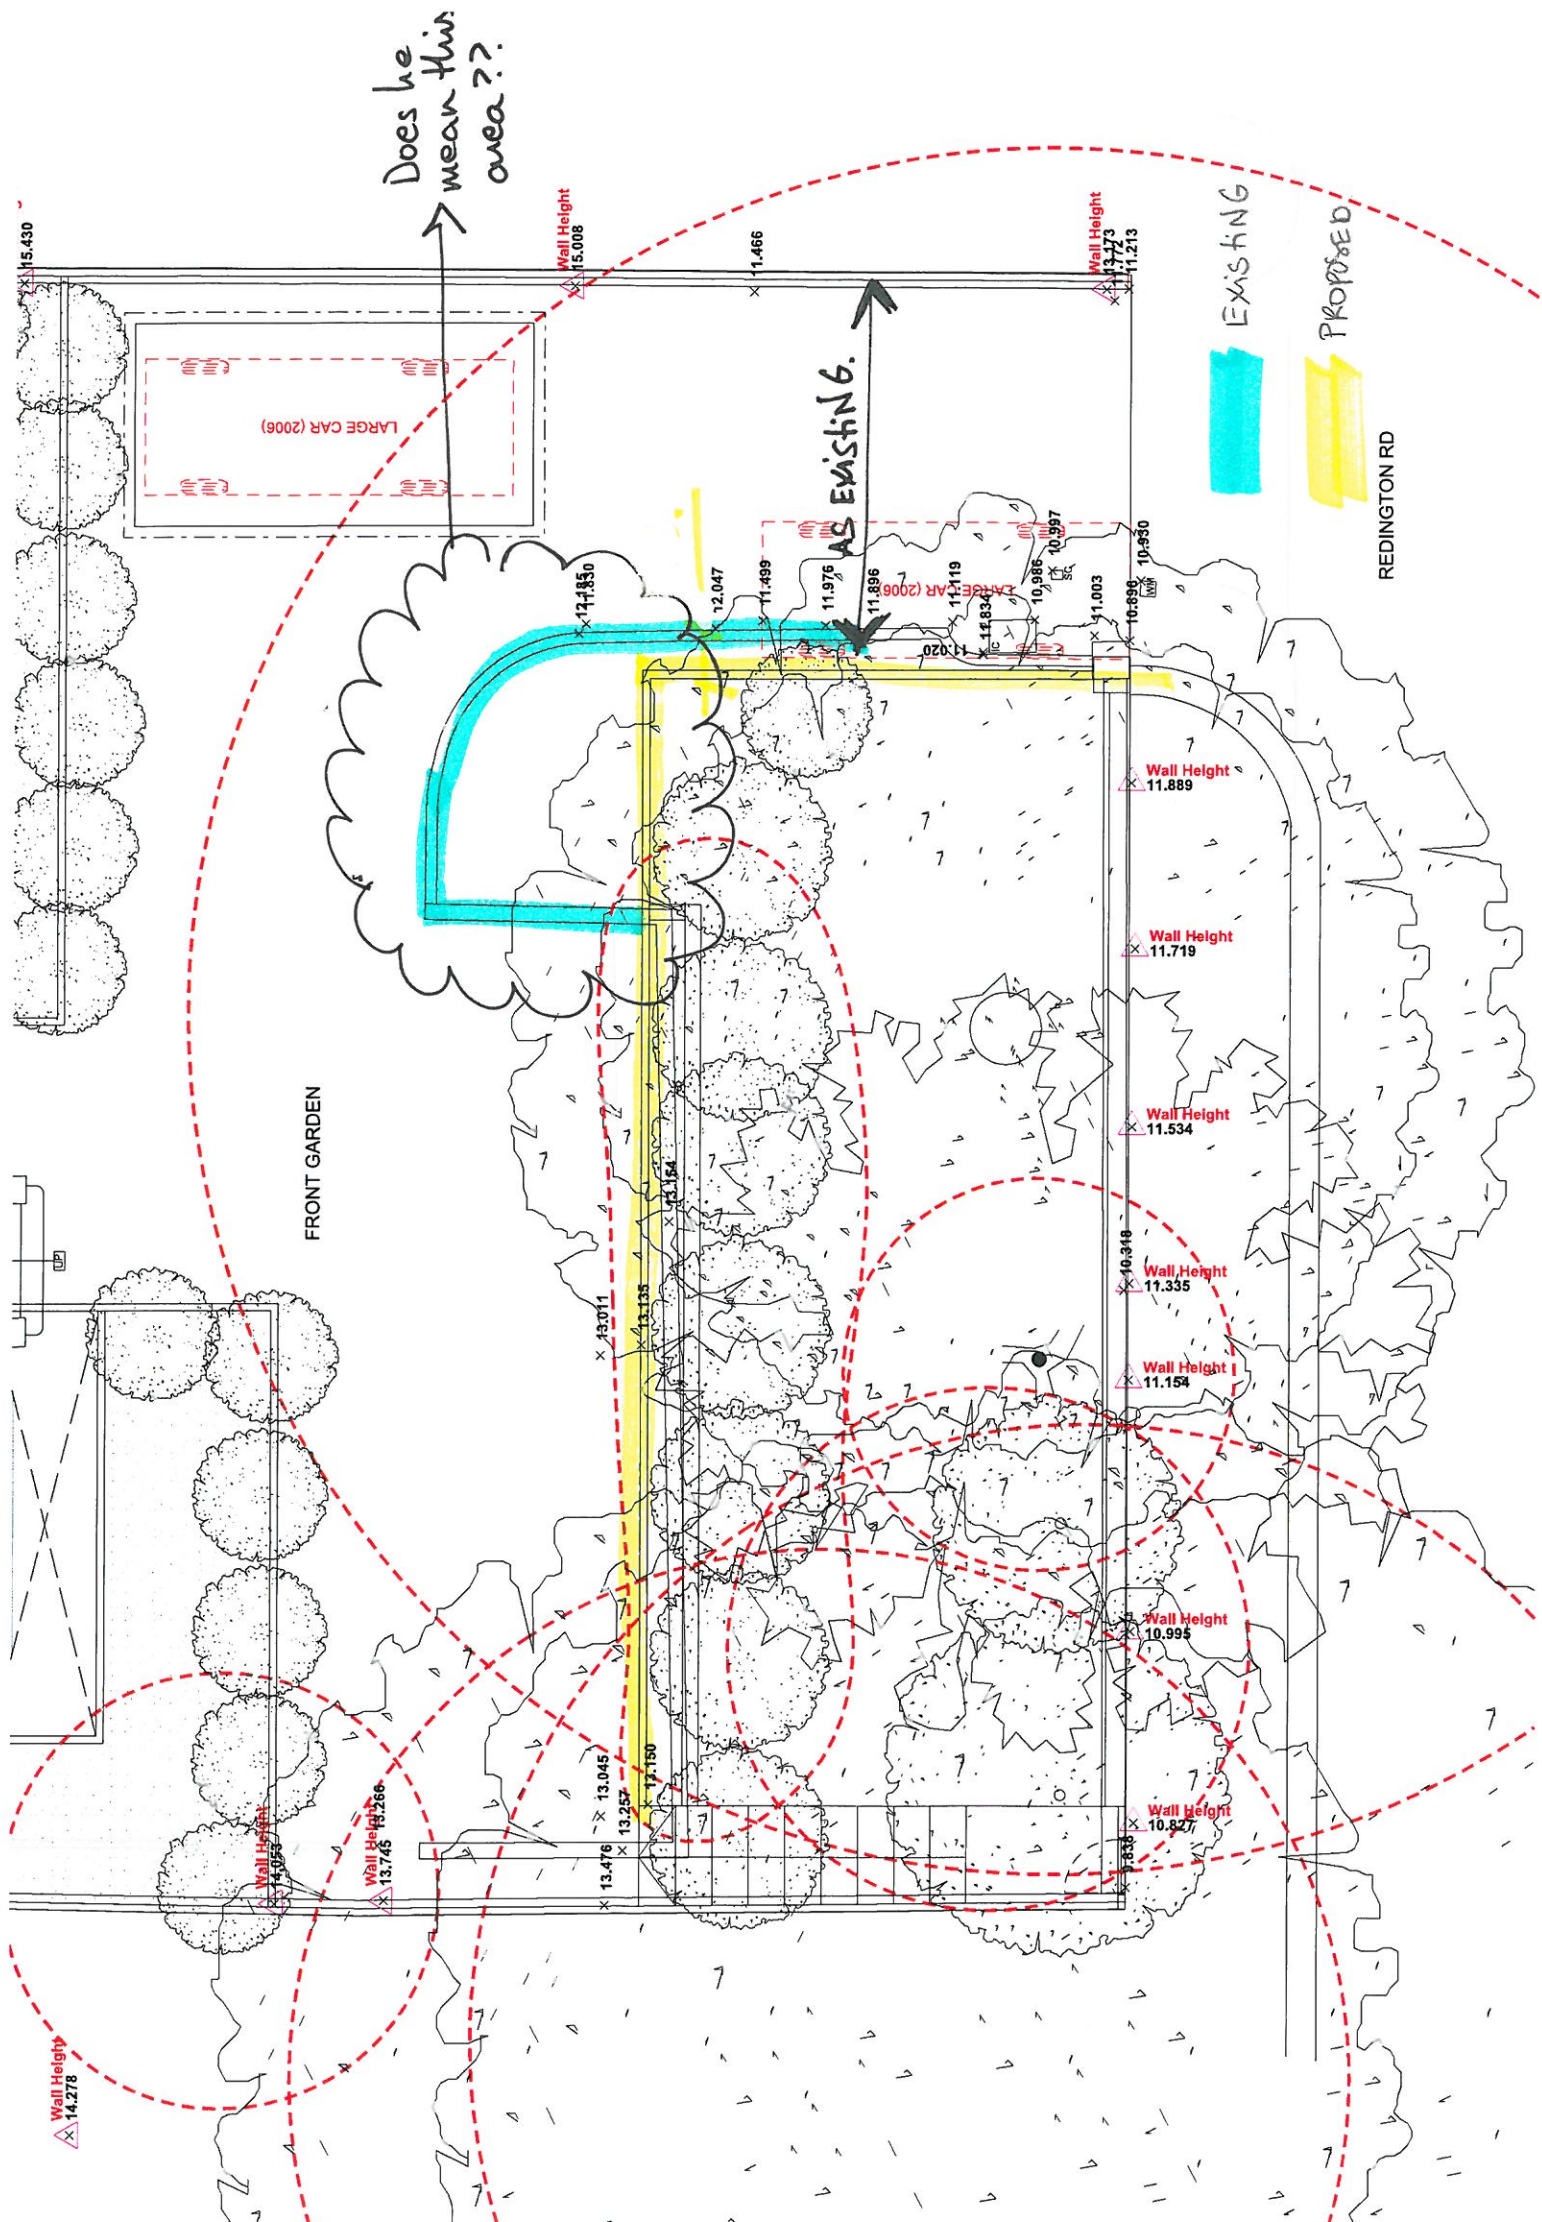

Rev	Details	Drawn	Checked	Date
A	Architect base & heading updated	AS	DF	20.03.16
B	Architect base & heading updated	AS	DF	15.04.16
C	Architect base & heading updated	AS	DF	17.05.16

VEHICLE DETAILS:

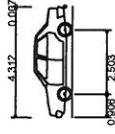

MEDIUM SIZED CAR

Overall Length 4.312m
Overall Width 1.686m
Overall Body Height 1.466m
Min Body Ground Clearance 0.228m
Max Track Width 1.591m
Lock to Lock Time 4.00s
Kerb to Kerb Turning Radius 5.042m



FORWARD MOVEMENTS ARE SHOWN IN BLACK
(design speed for all forward movements - 5kph)



REVERSE MOVEMENTS ARE SHOWN IN RED
(design speed for all reverse movements - 2.5kph)

Client

The Linton Group

Project

Redington Road

Drawing Title

Swept Path Analysis using a Medium Size Car (Groundfloor Lift)

Scale 1:250

Size A3

Drawn AS

Checked DF

04.09.15

04.09.15







111 - 113 Great Portland Street
London
W1W 6QQ
Tel. No. 0207 1000 753

Drawing Number

2015-2538-AT-004

Rev

C

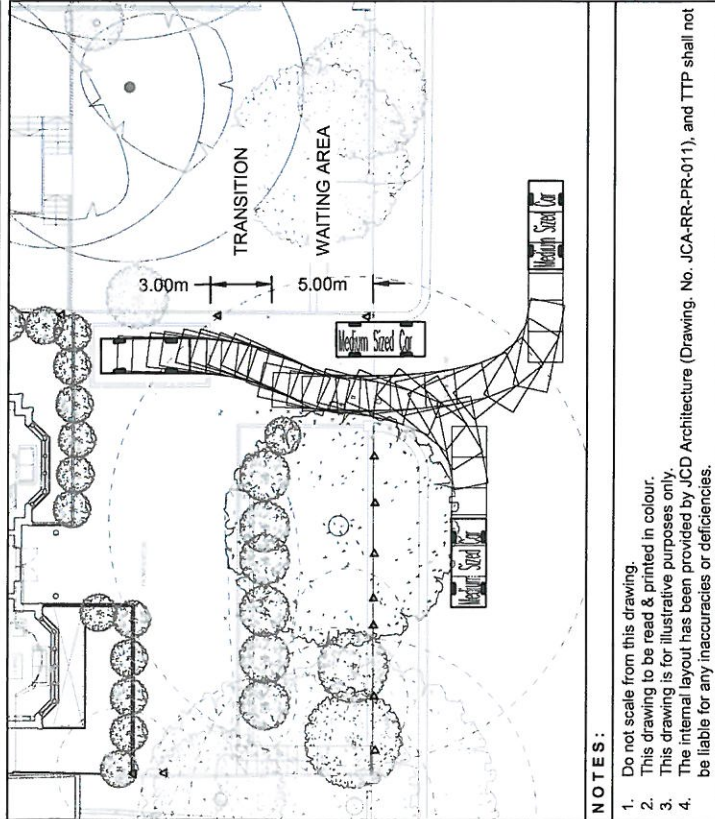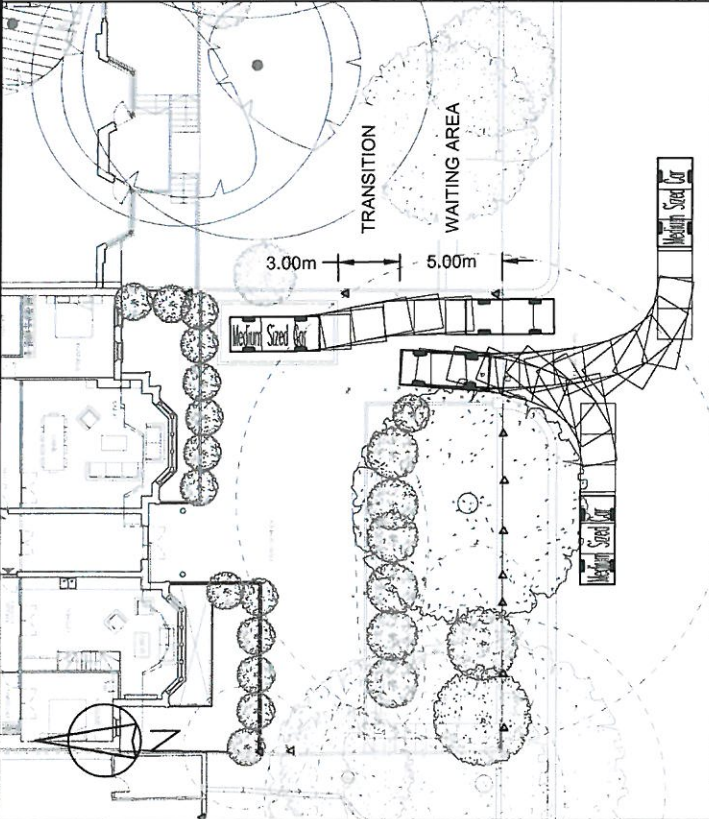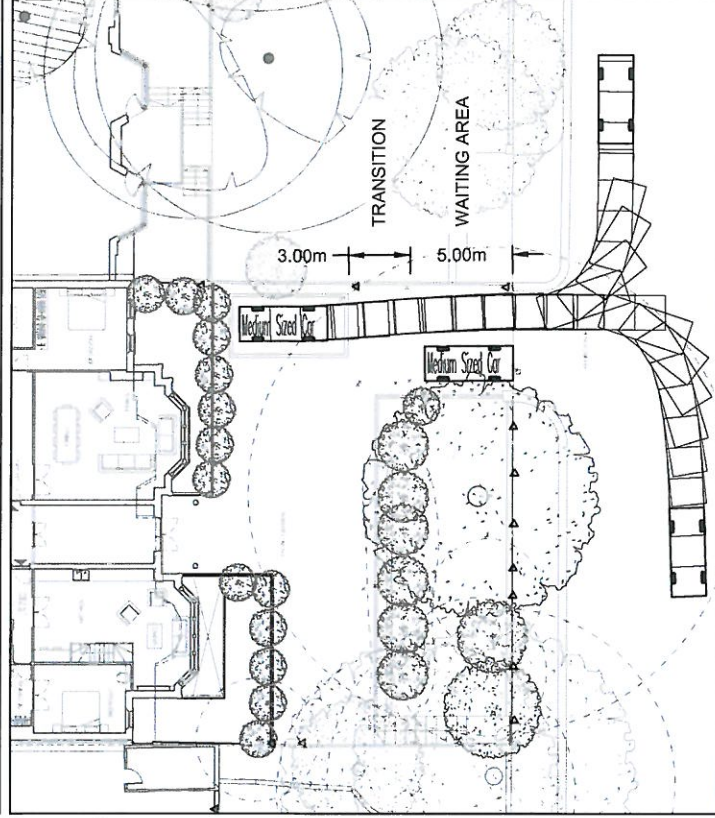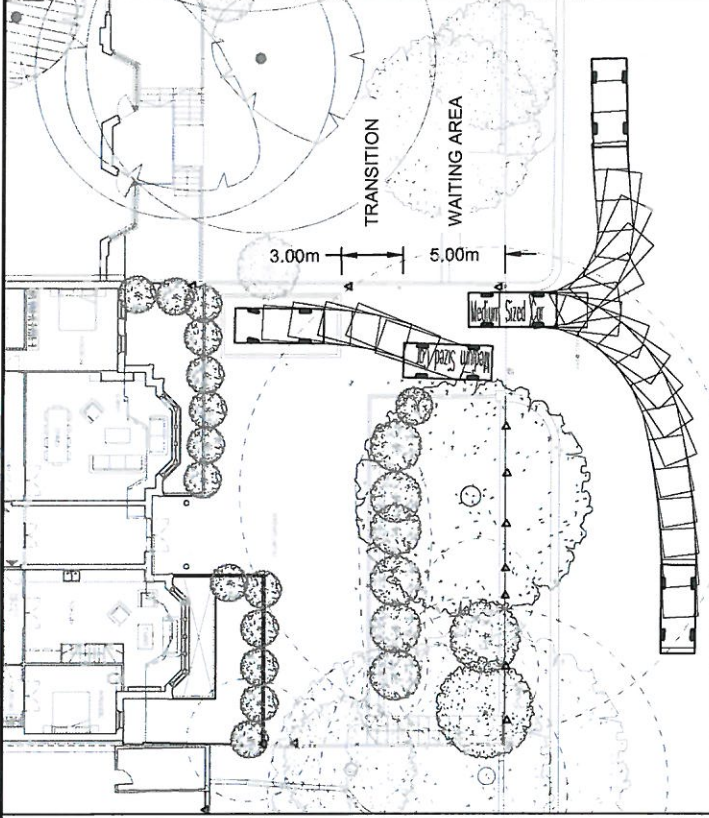

NOTES:

1. Do not scale from this drawing.
2. This drawing is to be read & printed in colour.
3. This drawing is for illustrative purposes only.
4. The internal layout has been provided by JCD Architecture (Drawing No. JCA-RR-PR-011), and TTP shall not be liable for any inaccuracies or deficiencies.

NOTE: THE PROPERTY OF THIS DRAWING AND DESIGN IS VESTED IN TTP CONSULTING LTD. IT MUST NOT BE COPIED OR REPRODUCED IN ANY WAY WITHOUT THEIR PRIOR WRITTEN CONSENT. © TTP Consulting. All rights reserved.