

# NOT FOR CONSTRUCTION

© COPYRIGHT

ONCE THE ENGINEER HAS RECORDED THE INFORMATION IN THE AREAS OPENED UP THE CONTRACTOR IS TO MAKE GOOD FINISHES TO THE CLIENT'S REQUIREMENTS, WHERE AREAS HAVE BEEN LEFT EXPOSED THE CONTRACTOR IS TO MAKE THE AREA SAFE IN ACCORDANCE WITH H&S REGULATIONS.


**NOTES:**

1. THIS DRAWING IS TO BE READ IN CONJUNCTION WITH ALL RELEVANT ARCHITECT'S & ENGINEER'S DRAWINGS.
2. DO NOT SCALE FROM THIS DRAWING.
3. THE INFORMATION ON THIS DRAWING HAS BEEN BASED ON:
  - ABA SITE VISIT, AUG 2016.
  - LONDON BOROUGH OF CAMDEN PLANNING APPLICATION FORM PL/9501711, SEPT 1995
  - LONDON BOROUGH OF CAMDEN PLANNING APPLICATION FORM PSX0204063, JAN 2001
  - ARCHITECT'S JOURNAL ARTICLE: 'MODERNISING MODERNISM', J DUNNETT, APRIL 1990.
 AND HAS NOT BEEN COMPLETED USING OPENING UP WORKS. (SEE ALSO NOTES FOR S.I.)

EXISTING PARTITION, SHOWN INDICATIVELY & ASSUMED NONSTRUCTURAL

ASSUMED STEEL FRAME APPEARS TO TRANSFER LOADS INTO MASONRY PILES AT BASEMENT LEVEL.

TP01

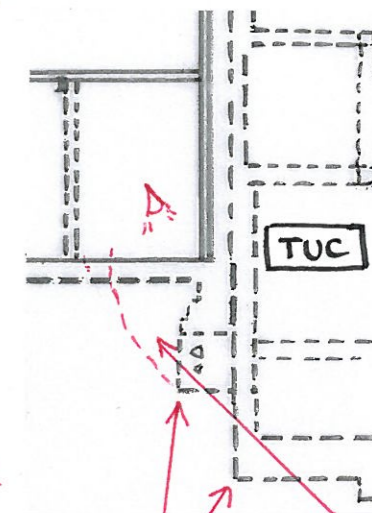

SECTION U-U

DO NOT UNDERMINE ASSUMED EXISTING ADJACENT FOOTINGS, SHOWN INDICATIVELY.

FOR MIN. AIR STRIP, CAREFULLY BREAK OUT THE EXISTING SLAB AND EXCAVATE TO EXPOSE THE FULL DEPTH OF THE EXISTING FOOTINGS. PROVIDE SAFE ACCESS FOR AN ENGINEER TO VIEW & RECORD THE EXISTING FOOTINGS. DO NOT CUT INTO THE EXISTING FOOTINGS.

NOTES FOR S.I.


- THIS DRAWING IS TO BE READ IN CONJUNCTION WITH THE SPECIFICATION.
- FOR DETAILS OF THE EXISTING STRUCTURE REFER TO ABA DRAWINGS 1721/30/111-115.
- THE CONTRACTOR SHALL ENSURE THE STABILITY OF THE SITE IS MAINTAINED AT ALL TIMES DURING INVESTIGATIONS. THE CONTRACTOR IS RESPONSIBLE FOR THE DESIGN, INSTALLATION & MAINTENANCE OF ANY TEMPORARY WORKS.
- THIS SITE HAS LIVE SERVICES. IT IS THE CONTRACTOR'S RESPONSIBILITY TO CONFIRM THE LOCATION OF EXISTING SERVICES & THEY SHALL AGREE WITH THE ENGINEER HOW TO PROCEED IF EXISTING SERVICES ARE FOUND TO OBSTRUCT THE WORKS. THE CONTRACTOR SHALL REPAIR ANY SERVICES WHICH HE DAMAGES AT HIS OWN EXPENSE.
- THE CONTRACTOR IS REMINDED THAT THE BUILDING IS OF HISTORICAL IMPORTANCE. THESE INVESTIGATIONS MUST BE CARRIED OUT CAREFULLY WITH THE MINIMUM DISTURBANCE & DAMAGE TO THE EXISTING FABRIC.

PART PLAN AT CONFERENCE LEVEL (~1:200)

date Aug '16	drawn MN	checked TB	scale (original - A4) 1:200 / A3	19/8/16 ISSUED FOR COMMENT. MN
job <b>THE BLOOMSBURY HOTEL</b>	dwg. EXISTING STRUCTURE PART PLAN - TAVIS TOLL ROOM, CONFERENCE LEVEL. MARKED UP WITH PROPOSED TRAIL PTS.	drg. no. 1721/30/111-501	rev. -	19/8/16 ISSUED FOR INFORMATION AM
			<b>Alan Baxter</b> 75 Cowcross Street London EC1M 6EL tel 020 7250 1555 email aba@alanbaxter.co.uk www.alanbaxter.co.uk	

TP02

FOLLOWING TP03:  
FOR A 1m STRIP CAREFULLY BREAK OUT THE EXISTING SLAB AND EXCAVATE TO ~1.0m BELOW FFL. PROVIDE SAFE ACCESS FOR AN ENGINEER TO VIEW AND RECORD THE EXISTING FOOTINGS. DO NOT CUT INTO THE EXISTING FOOTINGS.

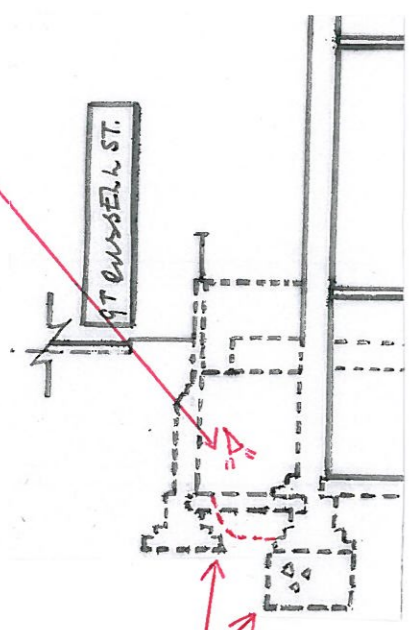


DO NOT UNDERMINE ASSUMED EXISTING ADJACENT FOOTINGS, SHOWN INDICATIVELY.

SECTION X-X

TP03

LOCALLY BREAK OUT THE EXISTING SLAB TO DETERMINE IF THE EXISTING RETAINING WALL HAS FOUNDATIONS USING A SHALLOW EXCAVATION PRIOR TO COMMENCING TP02.

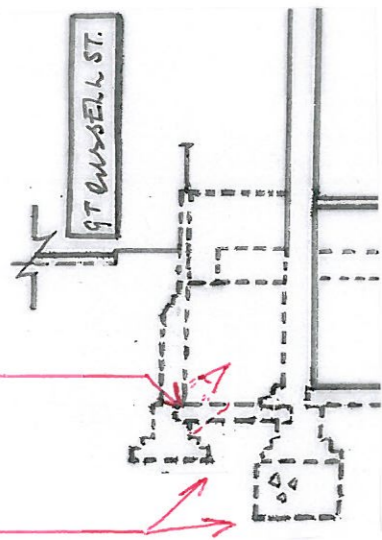

DO NOT UNDERMINE THE EXISTING STRUCTURE.