



1. ALL MEASUREMENTS/DIMENSIONS TO BE CHECKED ON SITE PRIOR TO UNDERTAKING ANY WORKS.

NEW ATM INSTALLED TO LHS OF ENTRANCE THROUGH PANEL WITH COMPOSITE. INTERNAL SHUTTER MODIFIED

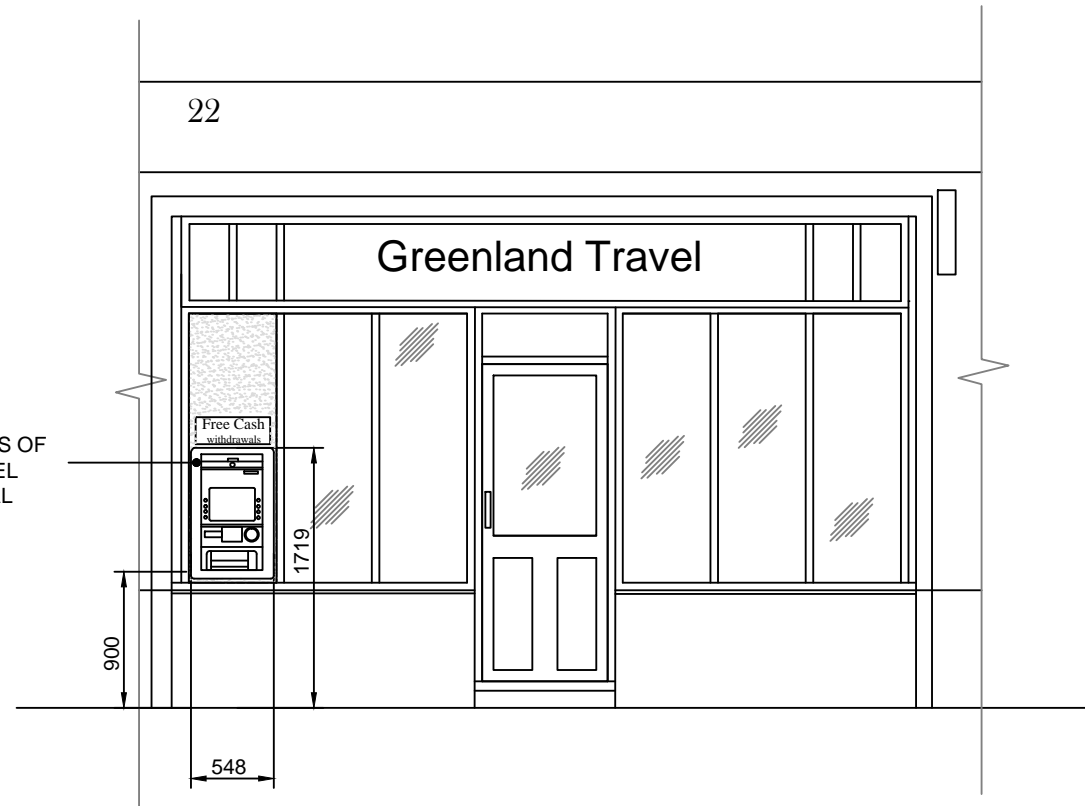

AS INSTALLED FRONT ELEVATION
SCALE 1:50

NOTE: HATCHED AREA DENOTES SERVICE ZONE

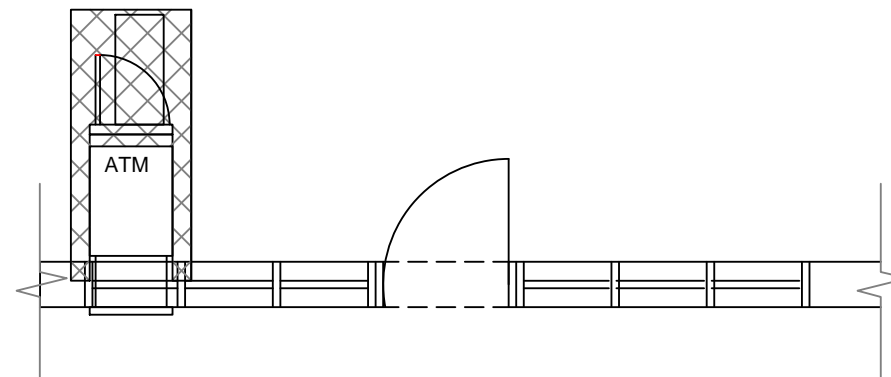

AS INSTALLED PART PLAN
SCALE 1:50

REV.	DATE	BY	DESCRIPTION



NoteMachine UK Ltd

Elvicta Business Park, Crickhowell, Powys, NP8 1DF
Tel: 01873 811 634 Fax: 01873 811 552

CLIENT
Greenland Travel (TTW)

TITLE
**AS INSTALLED ELEVATION AND PLAN
CONVENIENCE STORE
22 Charlton St, Kings Cross
London, NW1 1JH**

DRAWN BY JML/CAD	DATE 16/08/16	SCALE 1:50	SHEET SIZE A3
---------------------	------------------	---------------	------------------

CHECKED BY	DATE	APPROVED BY	DATE
------------	------	-------------	------

DRAWING No. 32048-54-002	REVISION 0
------------------------------------	----------------------