


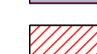



BUILDING DESIGN PARTNERSHIP LTD SHALL HAVE NO RESPONSIBILITY FOR ANY USE MADE OF THIS DOCUMENT OTHER THAN FOR THAT WHICH IT WAS PREPARED AND ISSUED.  
 ALL DIMENSIONS SHOULD BE CHECKED ON SITE.  
 DO NOT SCALE FROM THIS DRAWING.  
 ANY DRAWING ERRORS OR DIVERGENCES SHOULD BE BROUGHT TO THE ATTENTION OF BUILDING DESIGN PARTNERSHIP LTD AT THE ADDRESS SHOWN BELOW.



**NOTES**

EXISTING BUILDING SURVEY INFORMATION BY PLOWMAN CRAVEN, TO BE READ IN CONJUNCTION WITH ALL RELEVANT PROJECT INFORMATION.

REFER TO SERVICES ENGINEERS DRAWINGS FOR DETAILS OF PROPOSED PLANT INC. RISERS, DUCTS, FLUES, EXTRACT GRILLES, LOUVRES, ETC. AND ASSOCIATED BUILDERS WORK.

**KEY:**

-  GREY TONE INDICATES EXISTING STRUCTURE RETAINED
-  RED HATCH INDICATES AREA DEMOLISHED / REMOVED. REMAINING ADJACENT STRUCTURE TO BE REPAIRED
-  RED CROSS HATCH INDICATES DUCTWORK TO BE REMOVED.
-  RED LINE INDICATES FIXED FURNITURE, FITTINGS SANITARY WEAR AND TO BE REMOVED
-  RED LINE HATCH INDICATES ROOF TO BE REMOVED.

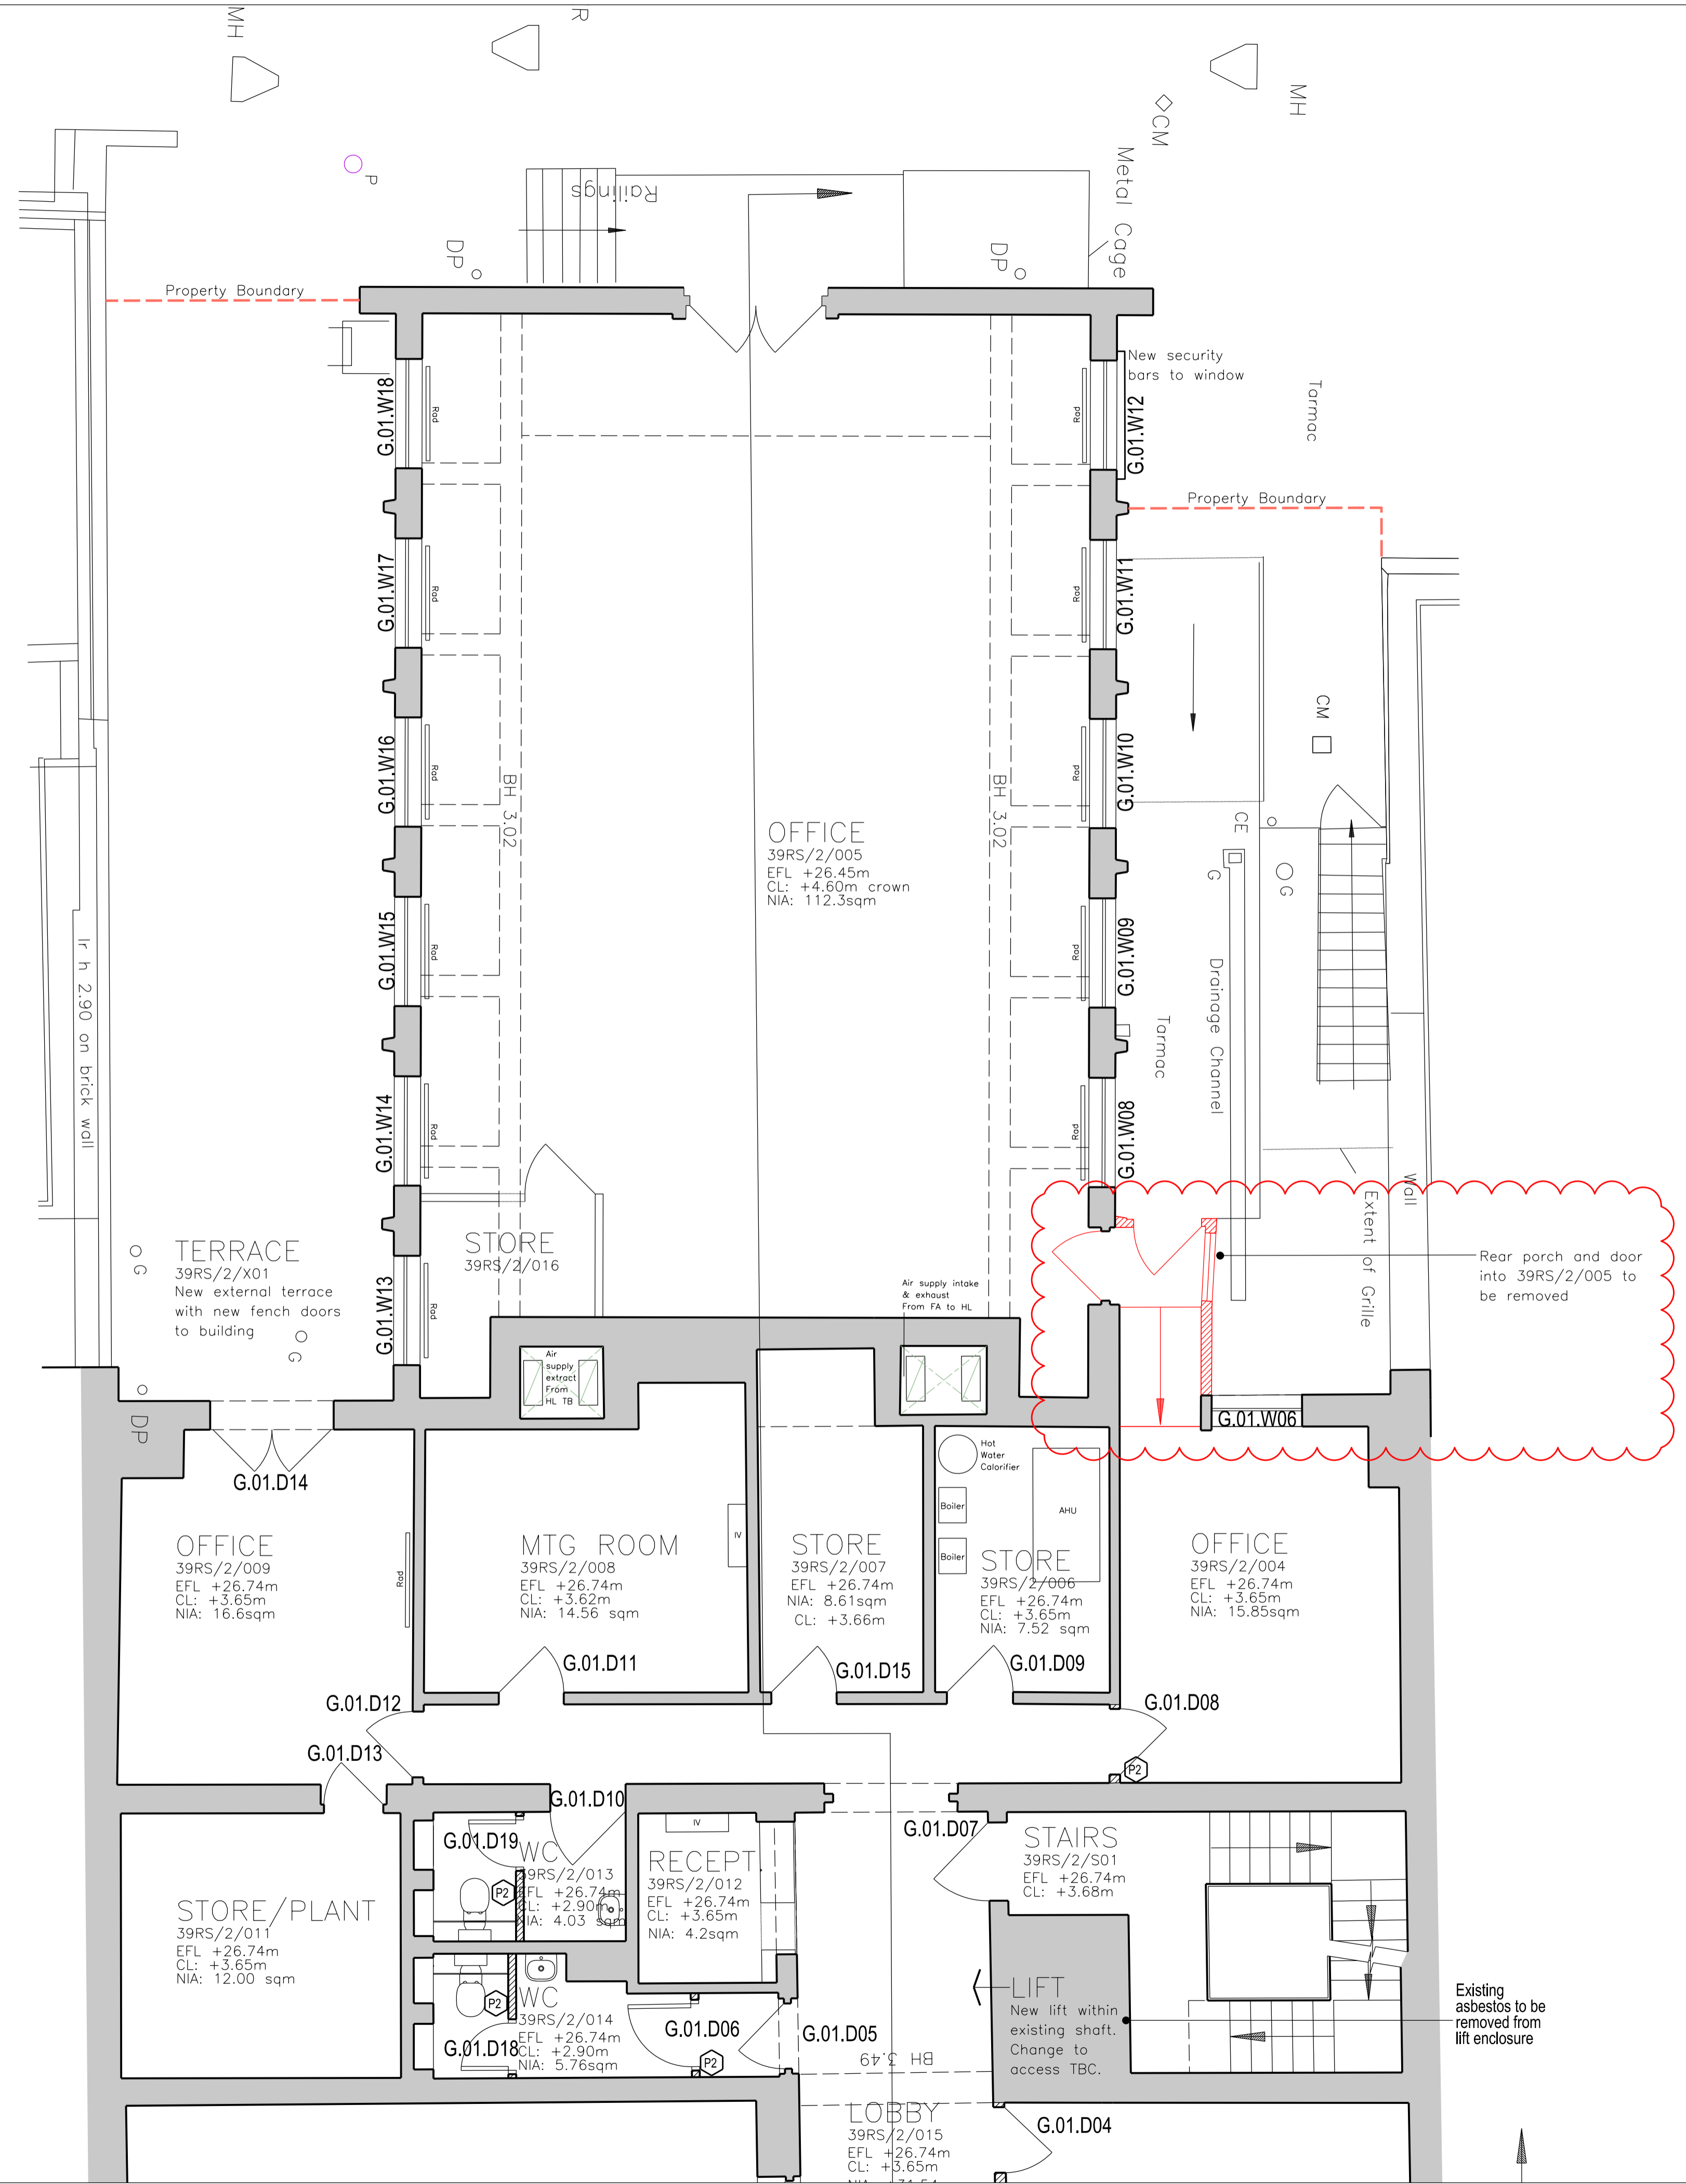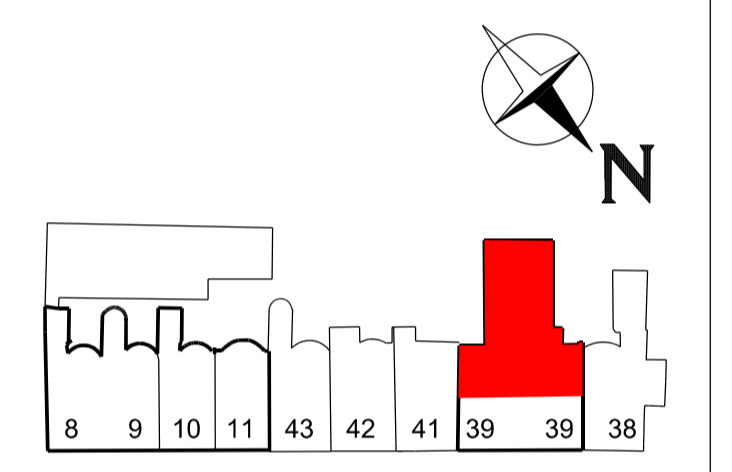

REVISION / DESCRIPTION	DRAWN	CHECKED	DATE
Non material amendment to planning permission	RC	JT	31/05/16



**BDP.**

16 Brewhouse Yard  
 Clerkenwell  
 London EC1V 4LJ  
 United Kingdom  
 T +44 (0)20 7812 8000  
 F +44 (0)20 7812 8399  
 www.bdp.com

PROJECT TITLE British Museum Perimeter Properties Refurbishment	
PROJECT NUMBER P2002323	
APPROVED BY No.39 Russell Square Fabric Stripping Out Series Ground Floor Plan - Level 2 of 2	SCALE 1:50 @ A1 1:100 @ A3
Non Material Amendment to Planning Permission	DATE 31/05/2016
DRAWING NO. (18)A0213	REVISION






BUILDING DESIGN PARTNERSHIP LTD SHALL HAVE NO RESPONSIBILITY FOR ANY USE MADE OF THIS DOCUMENT OTHER THAN FOR THAT WHICH IT WAS PREPARED AND ISSUED.  
 ALL DIMENSIONS SHOULD BE CHECKED ON SITE.  
 DO NOT SCALE FROM THIS DRAWING.  
 ANY DRAWING ERRORS OR DIVERGENCES SHOULD BE BROUGHT TO THE ATTENTION OF BUILDING DESIGN PARTNERSHIP LTD AT THE ADDRESS SHOWN BELOW.



**NOTES**

EXISTING BUILDING SURVEY INFORMATION BY PLOWMAN CRAVEN, TO BE READ IN CONJUNCTION WITH ALL RELEVANT PROJECT INFORMATION.

REFER TO SERVICES ENGINEERS DRAWINGS FOR DETAILS OF PROPOSED PLANT INC. RISERS, DUCTS, FLUES, EXTRACT GRILLES, LOUVRES, ETC. AND ASSOCIATED BUILDERS WORK.

**KEY:**

-  GREY TONE INDICATES EXISTING STRUCTURE RETAINED
-  RED HATCH INDICATES AREA DEMOLISHED / REMOVED. REMAINING ADJACENT STRUCTURE TO BE REPAIRED
-  RED CROSS HATCH INDICATES DUCTWORK TO BE REMOVED.
-  RED LINE INDICATES FIXED FURNITURE, FITTINGS SANITARY WEAR AND TO BE REMOVED
-  RED LINE HATCH INDICATES ROOF TO BE REMOVED.

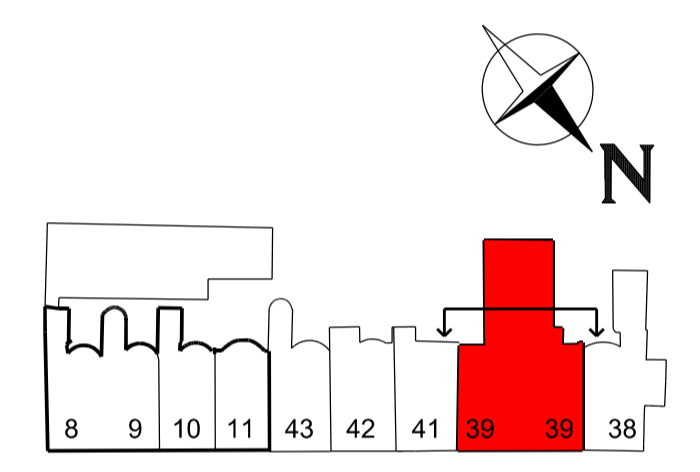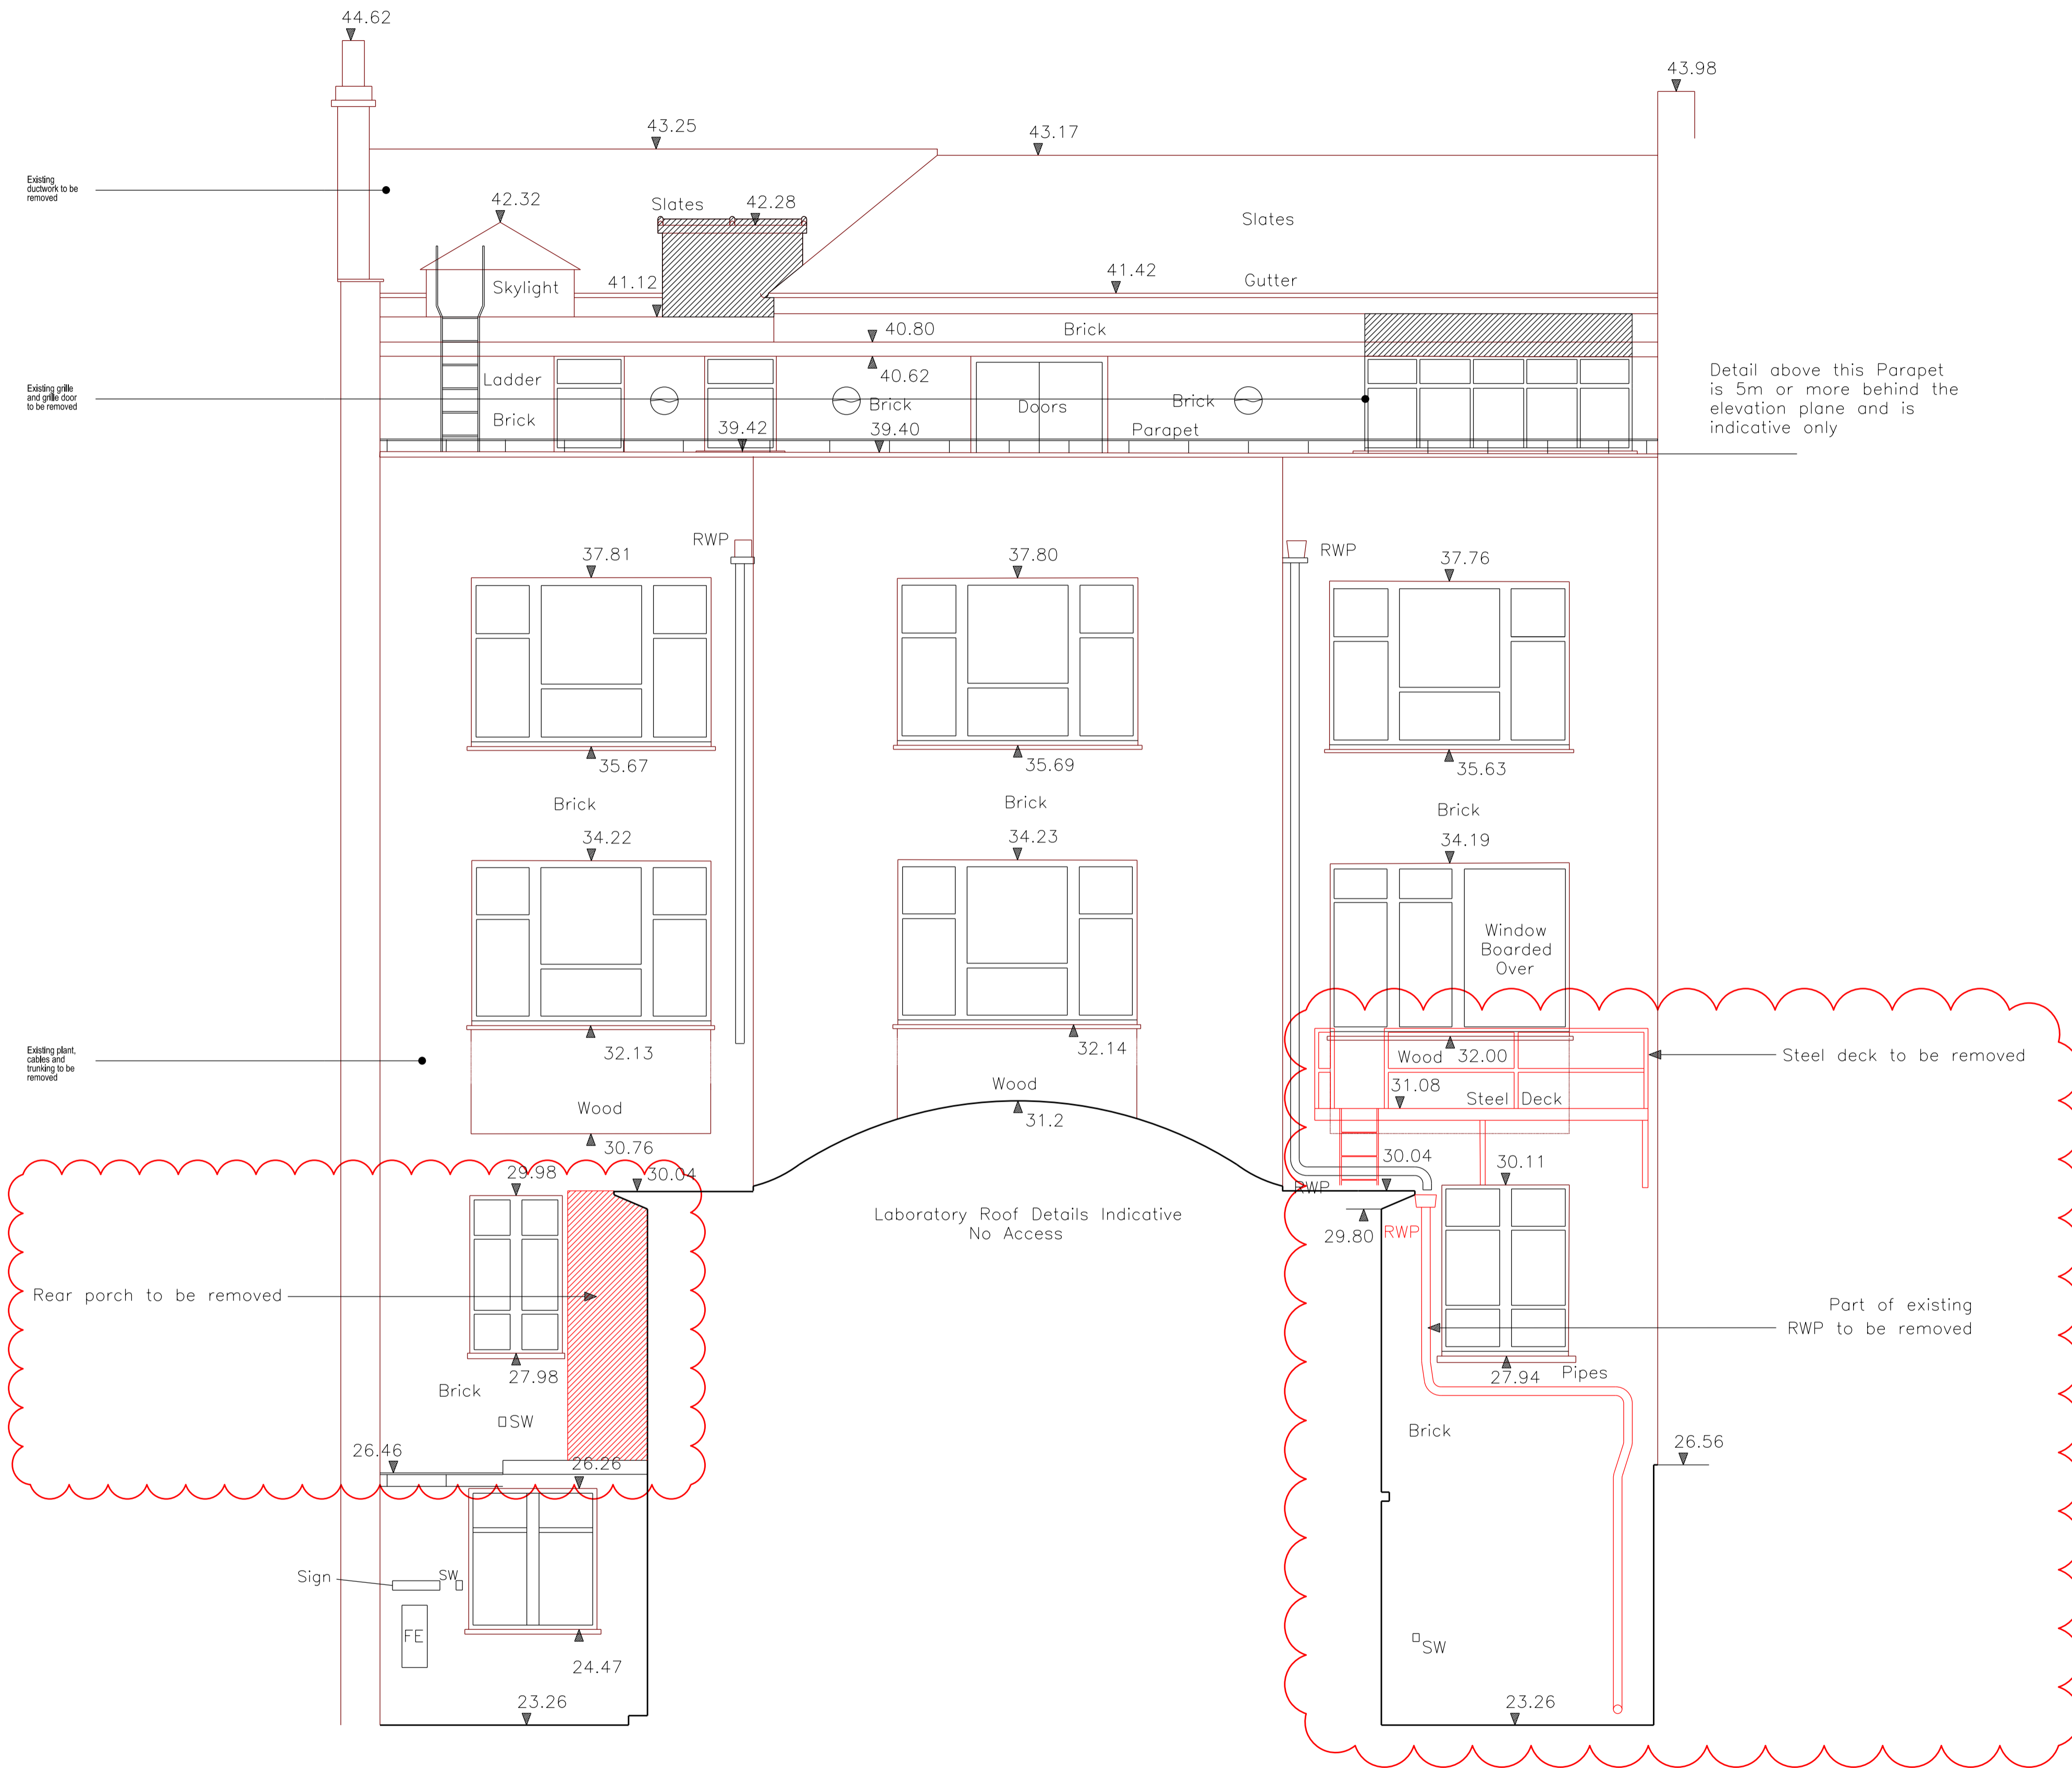

REVISION / DESCRIPTION	DRAWN	CHECKED	DATE
Non material amendment to planning permission	RC	JT	31/05/16



**BDP.**

16 Brewhouse Yard  
 Clerkenwell  
 London EC1V 4LJ  
 United Kingdom  
 T +44 (0)20 7812 8000  
 F +44 (0)20 7812 8399  
 www.bdp.com

PROJECT TITLE <b>British Museum Perimeter Properties Refurbishment</b>	
PROJECT NUMBER <b>P2002323</b>	
DRAWING TITLE <b>39 Russell Square Fabric Stripping Out Series Sectional Rear Elevation</b>	SCALE <b>1:50 @ A1 1:100 @ A3</b>
PROJECT DESCRIPTION <b>Non Material Amendment to Planning Permission</b>	DATE <b>31/05/2016</b>
PROJECT NUMBER <b>(18)AE002</b>	REVISION



BUILDING DESIGN PARTNERSHIP LTD SHALL HAVE NO RESPONSIBILITY FOR ANY USE MADE OF THIS DOCUMENT OTHER THAN FOR THAT WHICH IT WAS PREPARED AND ISSUED.  
 ALL DIMENSIONS SHOULD BE CHECKED ON SITE.  
 DO NOT SCALE FROM THIS DRAWING.  
 ANY DRAWING ERRORS OR DIVERGENCES SHOULD BE BROUGHT TO THE ATTENTION OF BUILDING DESIGN PARTNERSHIP LTD AT THE ADDRESS SHOWN BELOW.



**NOTES**

EXISTING BUILDING SURVEY INFORMATION BY PLOWMAN CRAVEN, TO BE READ IN CONJUNCTION WITH ALL RELEVANT PROJECT INFORMATION.

REFER TO SERVICES ENGINEERS DRAWINGS FOR DETAILS OF PROPOSED PLANT INC. RISERS, DUCTS, FLUES, EXTRACT GRILLES, LOUVRES, ETC. AND ASSOCIATED BUILDERS WORK.

**KEY:**

-  GREY TONE INDICATES EXISTING STRUCTURE RETAINED
-  HATCH INDICATES AREA OF NEW CONSTRUCTION

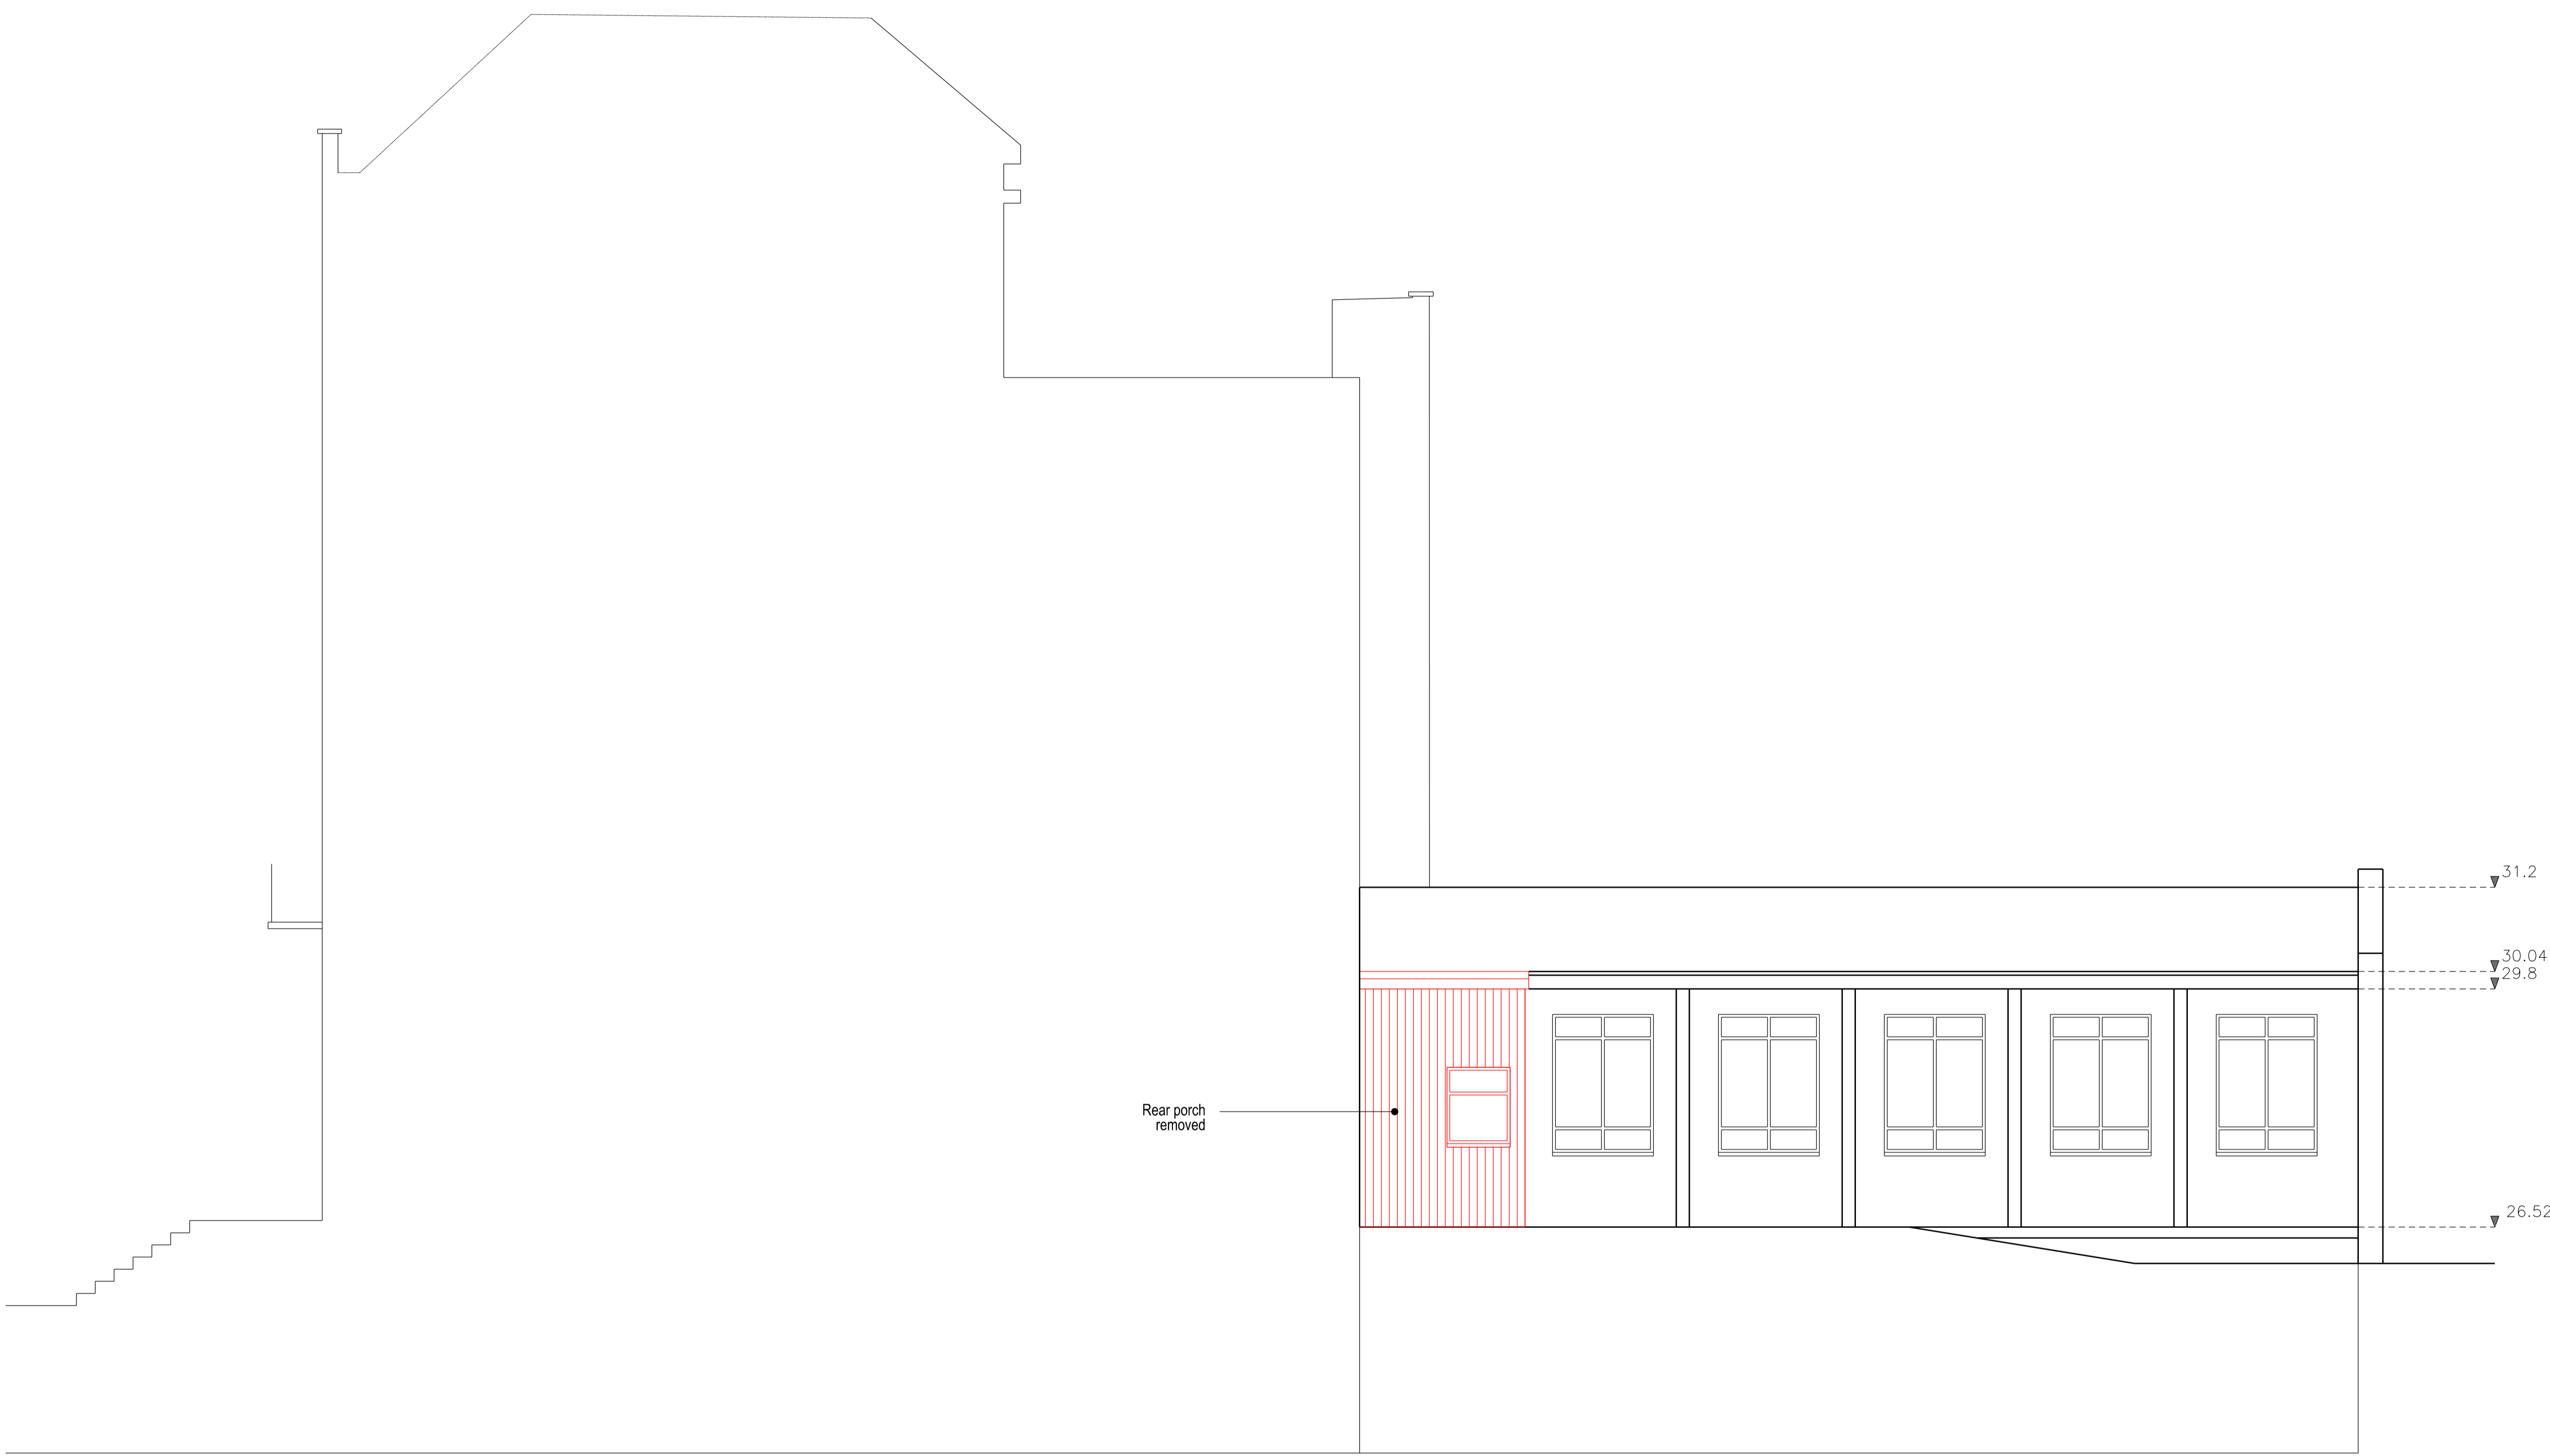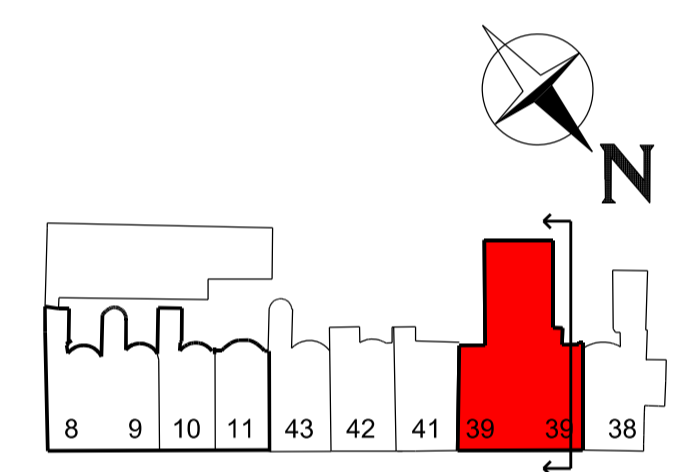

REVISION / DESCRIPTION	DRAWN	CHECKED	DATE
Non material amendment to planning permission	RC	JT	31/05/16



**BDP.**

16 Brewhouse Yard  
 Clerkenwell  
 London EC1V 4LJ  
 United Kingdom  
 T +44 (0)20 7812 8000  
 F +44 (0)20 7812 8399  
 www.bdp.com

<b>PROJECT TITLE</b> British Museum Perimeter Properties Refurbishment	
<b>PROJECT NUMBER</b> P2002323	
<b>DRAWING TITLE</b> 39 Russell Square Fabric Stripping Out Series Side Elevation of Rear Extension Non Material Amendment to Planning Permission	<b>SCALE</b> 1:50 @ A1 1:100 @ A3
<b>DATE</b> 31/05/16	<b>REVISION</b> -
<b>FORM NO.</b> (18)AE003	

 

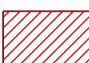
BUILDING DESIGN PARTNERSHIP LTD SHALL HAVE NO RESPONSIBILITY FOR ANY USE MADE OF THIS DOCUMENT OTHER THAN FOR THAT WHICH IT WAS PREPARED AND ISSUED.  
 ALL DIMENSIONS SHOULD BE CHECKED ON SITE.  
 DO NOT SCALE FROM THIS DRAWING.  
 ANY DRAWING ERRORS OR DIVERGENCES SHOULD BE BROUGHT TO THE ATTENTION OF BUILDING DESIGN PARTNERSHIP LTD AT THE ADDRESS SHOWN BELOW.



**NOTES**

EXISTING BUILDING SURVEY INFORMATION BY PLOWMAN CRAVEN, TO BE READ IN CONJUNCTION WITH ALL RELEVANT PROJECT INFORMATION.

REFER TO SERVICES ENGINEERS DRAWINGS FOR DETAILS OF PROPOSED PLANT INC. RISERS, DUCTS, FLUES, EXTRACT GRILLES, LOUVRES, ETC. AND ASSOCIATED BUILDERS WORK.

**KEY:**

-  GREY TONE INDICATES EXISTING STRUCTURE RETAINED
-  HATCH INDICATES AREA OF NEW CONSTRUCTION
-  NO WORKS TO BE CARRIED OUT TO THIS AREA

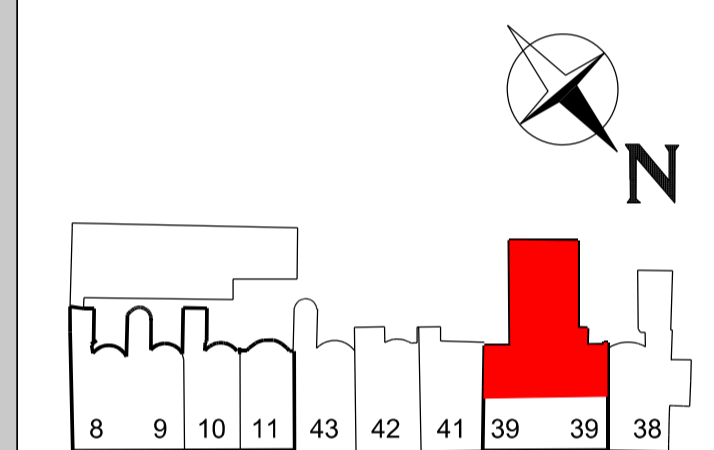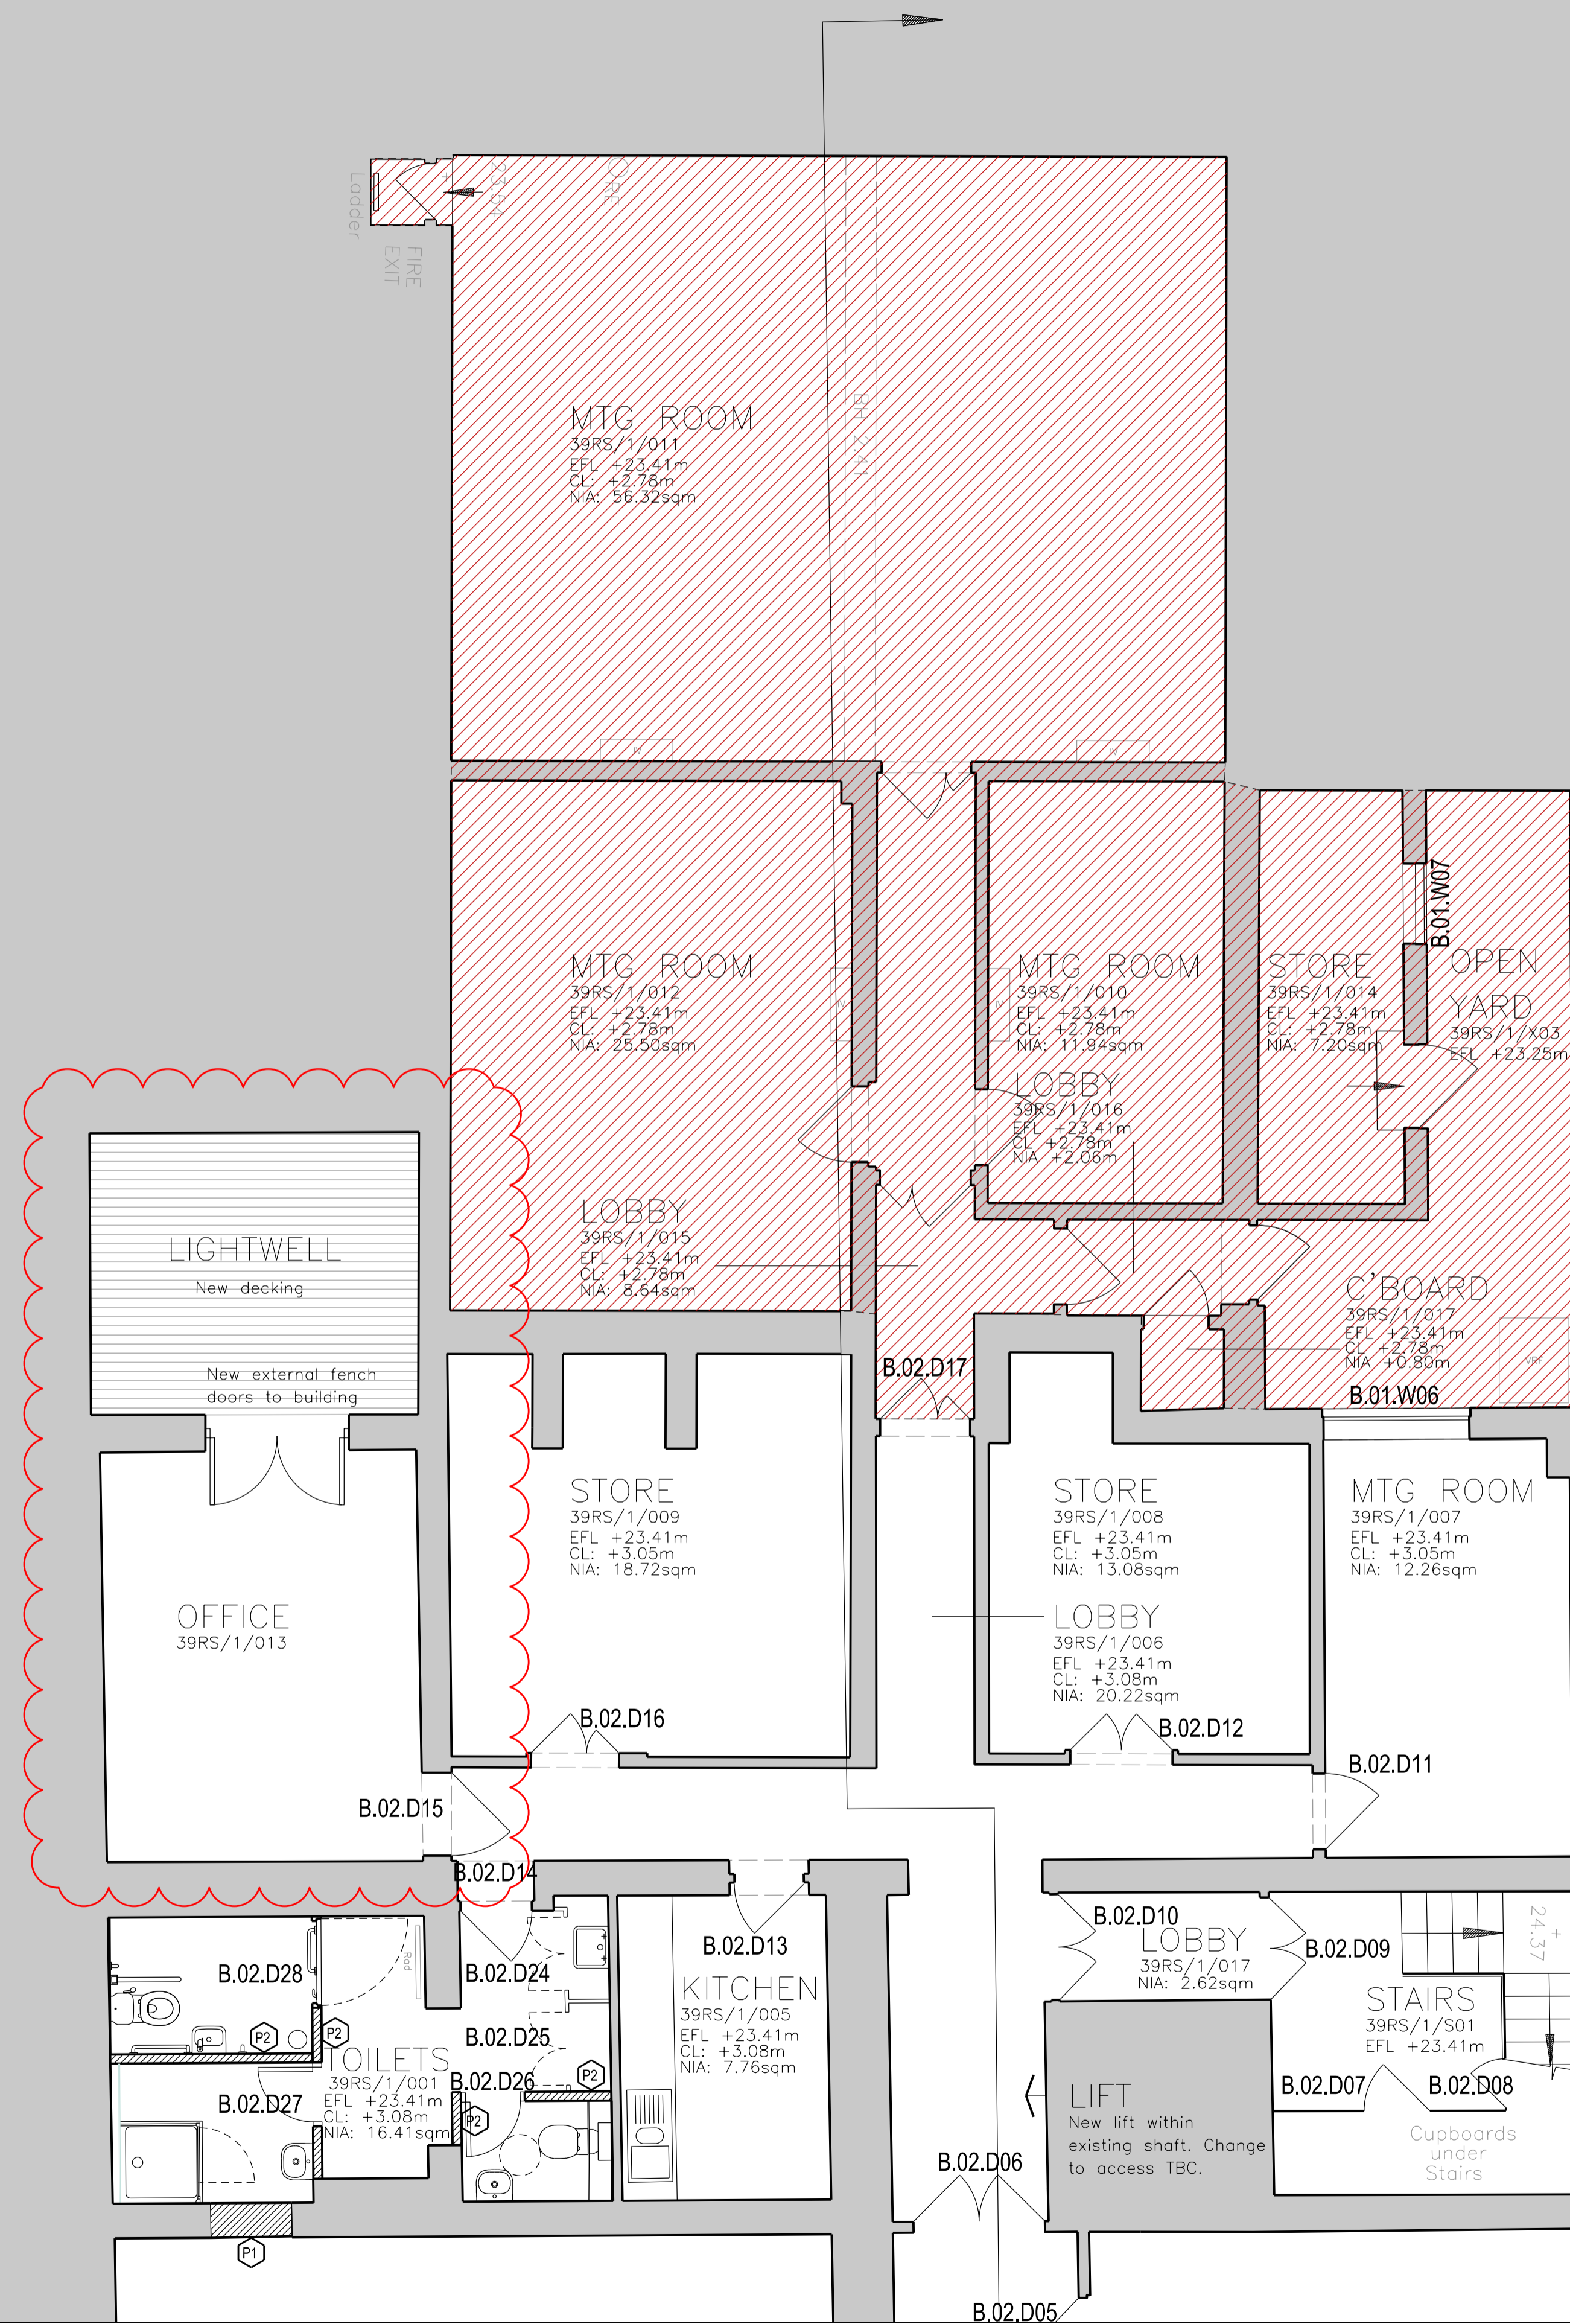

REVISION DESCRIPTION	DRAWN	CHECKED	DATE
Issue for Construction	JT	JT	19/01/16
Issue for Construction - Rev A	RC	JT	09/03/16

- Existing lightwell to remain with proposed decking
- Proposed french door into building from lightwell
- Existing store 39RS/1/013 converted into office



**BDP.**

16 Brewhouse Yard  
 Clerkenwell  
 London EC1V 4LJ  
 United Kingdom  
 T +44 (0)20 7812 8000  
 F +44 (0)20 7812 8399  
 www.bdp.com

PROJECT TITLE  
**British Museum  
 Perimeter Properties Refurbishment**

PROJECT NUMBER  
**P2002323**

DRAWING TITLE  
**No.39 Russell Square  
 Proposed Series  
 Plan  
 Basement Level 2 of 2  
 Issue for Construction**

SCALE  
**1:50 @ A1  
 1:100 @ A3**

DATE  
**19/01/2016**

REVISION  
**REV A**

 

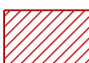
BUILDING DESIGN PARTNERSHIP LTD SHALL HAVE NO RESPONSIBILITY FOR ANY USE MADE OF THIS DOCUMENT OTHER THAN FOR THAT WHICH IT WAS PREPARED AND ISSUED.  
 ALL DIMENSIONS SHOULD BE CHECKED ON SITE.  
 DO NOT SCALE FROM THIS DRAWING.  
 ANY DRAWING ERRORS OR DIVERGENCES SHOULD BE BROUGHT TO THE ATTENTION OF BUILDING DESIGN PARTNERSHIP LTD AT THE ADDRESS SHOWN BELOW.


**NOTES**

EXISTING BUILDING SURVEY INFORMATION BY PLOWMAN CRAVEN, TO BE READ IN CONJUNCTION WITH ALL RELEVANT PROJECT INFORMATION.

REFER TO SERVICES ENGINEERS DRAWINGS FOR DETAILS OF PROPOSED PLANT INC. RISERS, DUCTS, FLUES, EXTRACT GRILLES, LOUVRES, ETC. AND ASSOCIATED BUILDERS WORK.

**KEY:**

-  GREY TONE INDICATES EXISTING STRUCTURE RETAINED
-  HATCH INDICATES AREA OF NEW CONSTRUCTION
-  NO WORKS TO BE CARRIED OUT TO THIS AREA

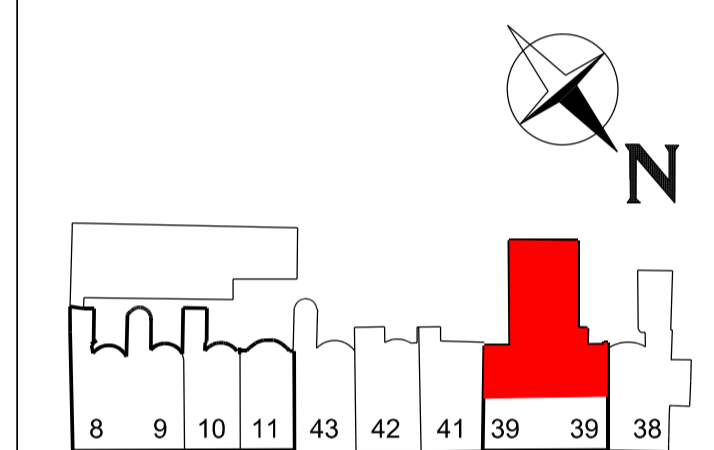

REVISION DESCRIPTION	DRAWN	CHECKED	DATE
Issue for Construction	JT	JT	19/01/16
Issue for Construction - Rev A	RC	JT	09/03/16


- Rear porch at ground level removed
- Existing opening from 39RS/2/004 into rear porch blocked up
- Existing door opening to rear extension (39RS/2/005) blocked up
- Existing lightwell to basement level to remain
- Proposed Juliet balcony with new french doors (as existing proposal) at ground level



**BDP.**

16 Brewhouse Yard  
 Clerkenwell  
 London EC1V 4LJ  
 United Kingdom  
 T +44 (0)20 7812 8000  
 F +44 (0)20 7812 8399  
 www.bdp.com

PROJECT TITLE	
British Museum Perimeter Properties Refurbishment	
PROJECT NUMBER	
P2002323	
DRAWING TITLE	SCALE
No.39 Russell Square Proposed Series Plan	1:50 @ A1 1:100 @ A3
DATE	
19/01/2016	
ISSUE FOR	
Ground Floor Level 2 of 2 Issue for Construction	
FORM NO.	REVISION
(20)AP019	REV A

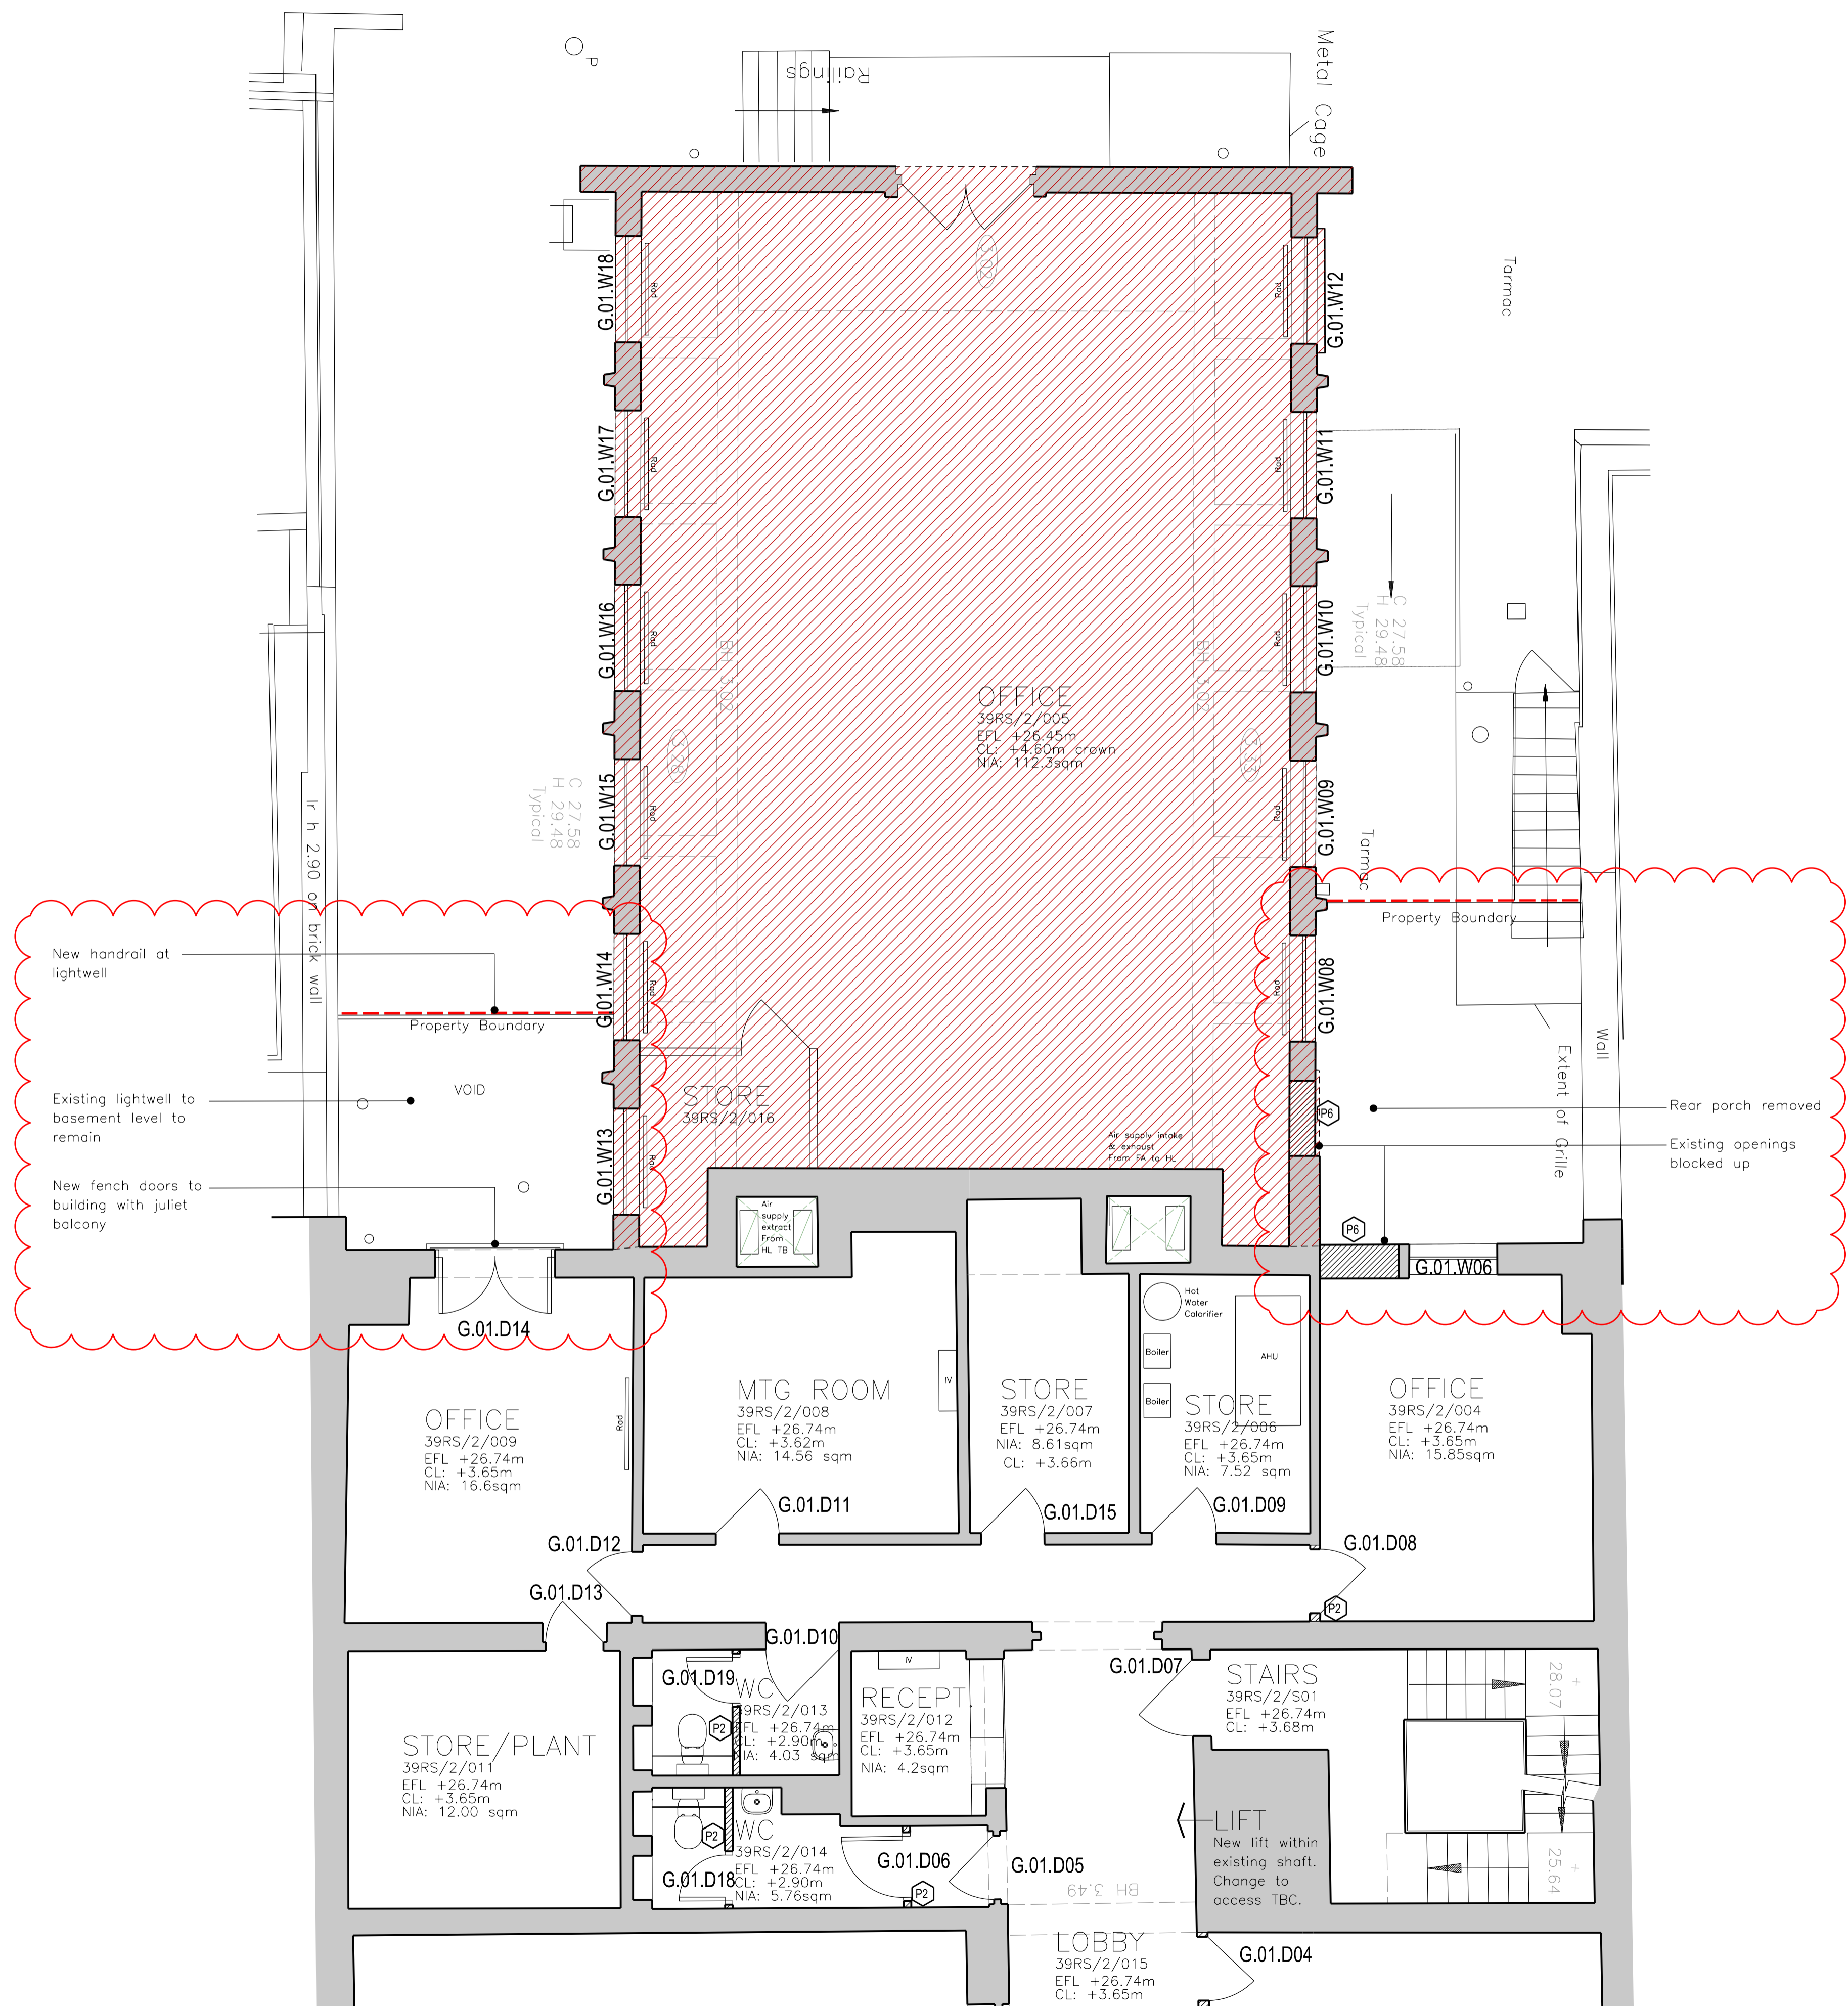

BUILDING DESIGN PARTNERSHIP LTD SHALL HAVE NO RESPONSIBILITY FOR ANY USE MADE OF THIS DOCUMENT OTHER THAN FOR THAT WHICH IT WAS PREPARED AND ISSUED.  
 ALL DIMENSIONS SHOULD BE CHECKED ON SITE.  
 DO NOT SCALE FROM THIS DRAWING.  
 ANY DRAWING ERRORS OR DIVERGENCES SHOULD BE BROUGHT TO THE ATTENTION OF BUILDING DESIGN PARTNERSHIP LTD AT THE ADDRESS SHOWN BELOW.



**NOTES**

EXISTING BUILDING SURVEY INFORMATION BY PLOWMAN CRAVEN, TO BE READ IN CONJUNCTION WITH ALL RELEVANT PROJECT INFORMATION.

REFER TO SERVICES ENGINEERS DRAWINGS FOR DETAILS OF PROPOSED PLANT INC. RISERS, DUCTS, FLUES, EXTRACT GRILLES, LOUVRES, ETC. AND ASSOCIATED BUILDERS WORK.

**KEY:**

- GREY TONE INDICATES EXISTING STRUCTURE RETAINED
- HATCH INDICATES AREA OF NEW CONSTRUCTION

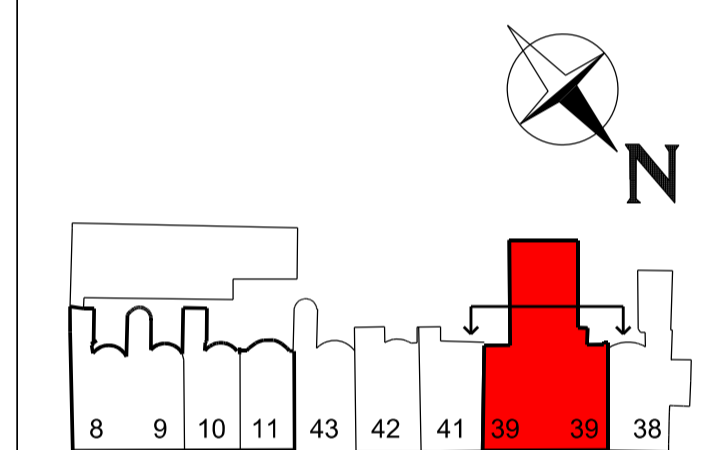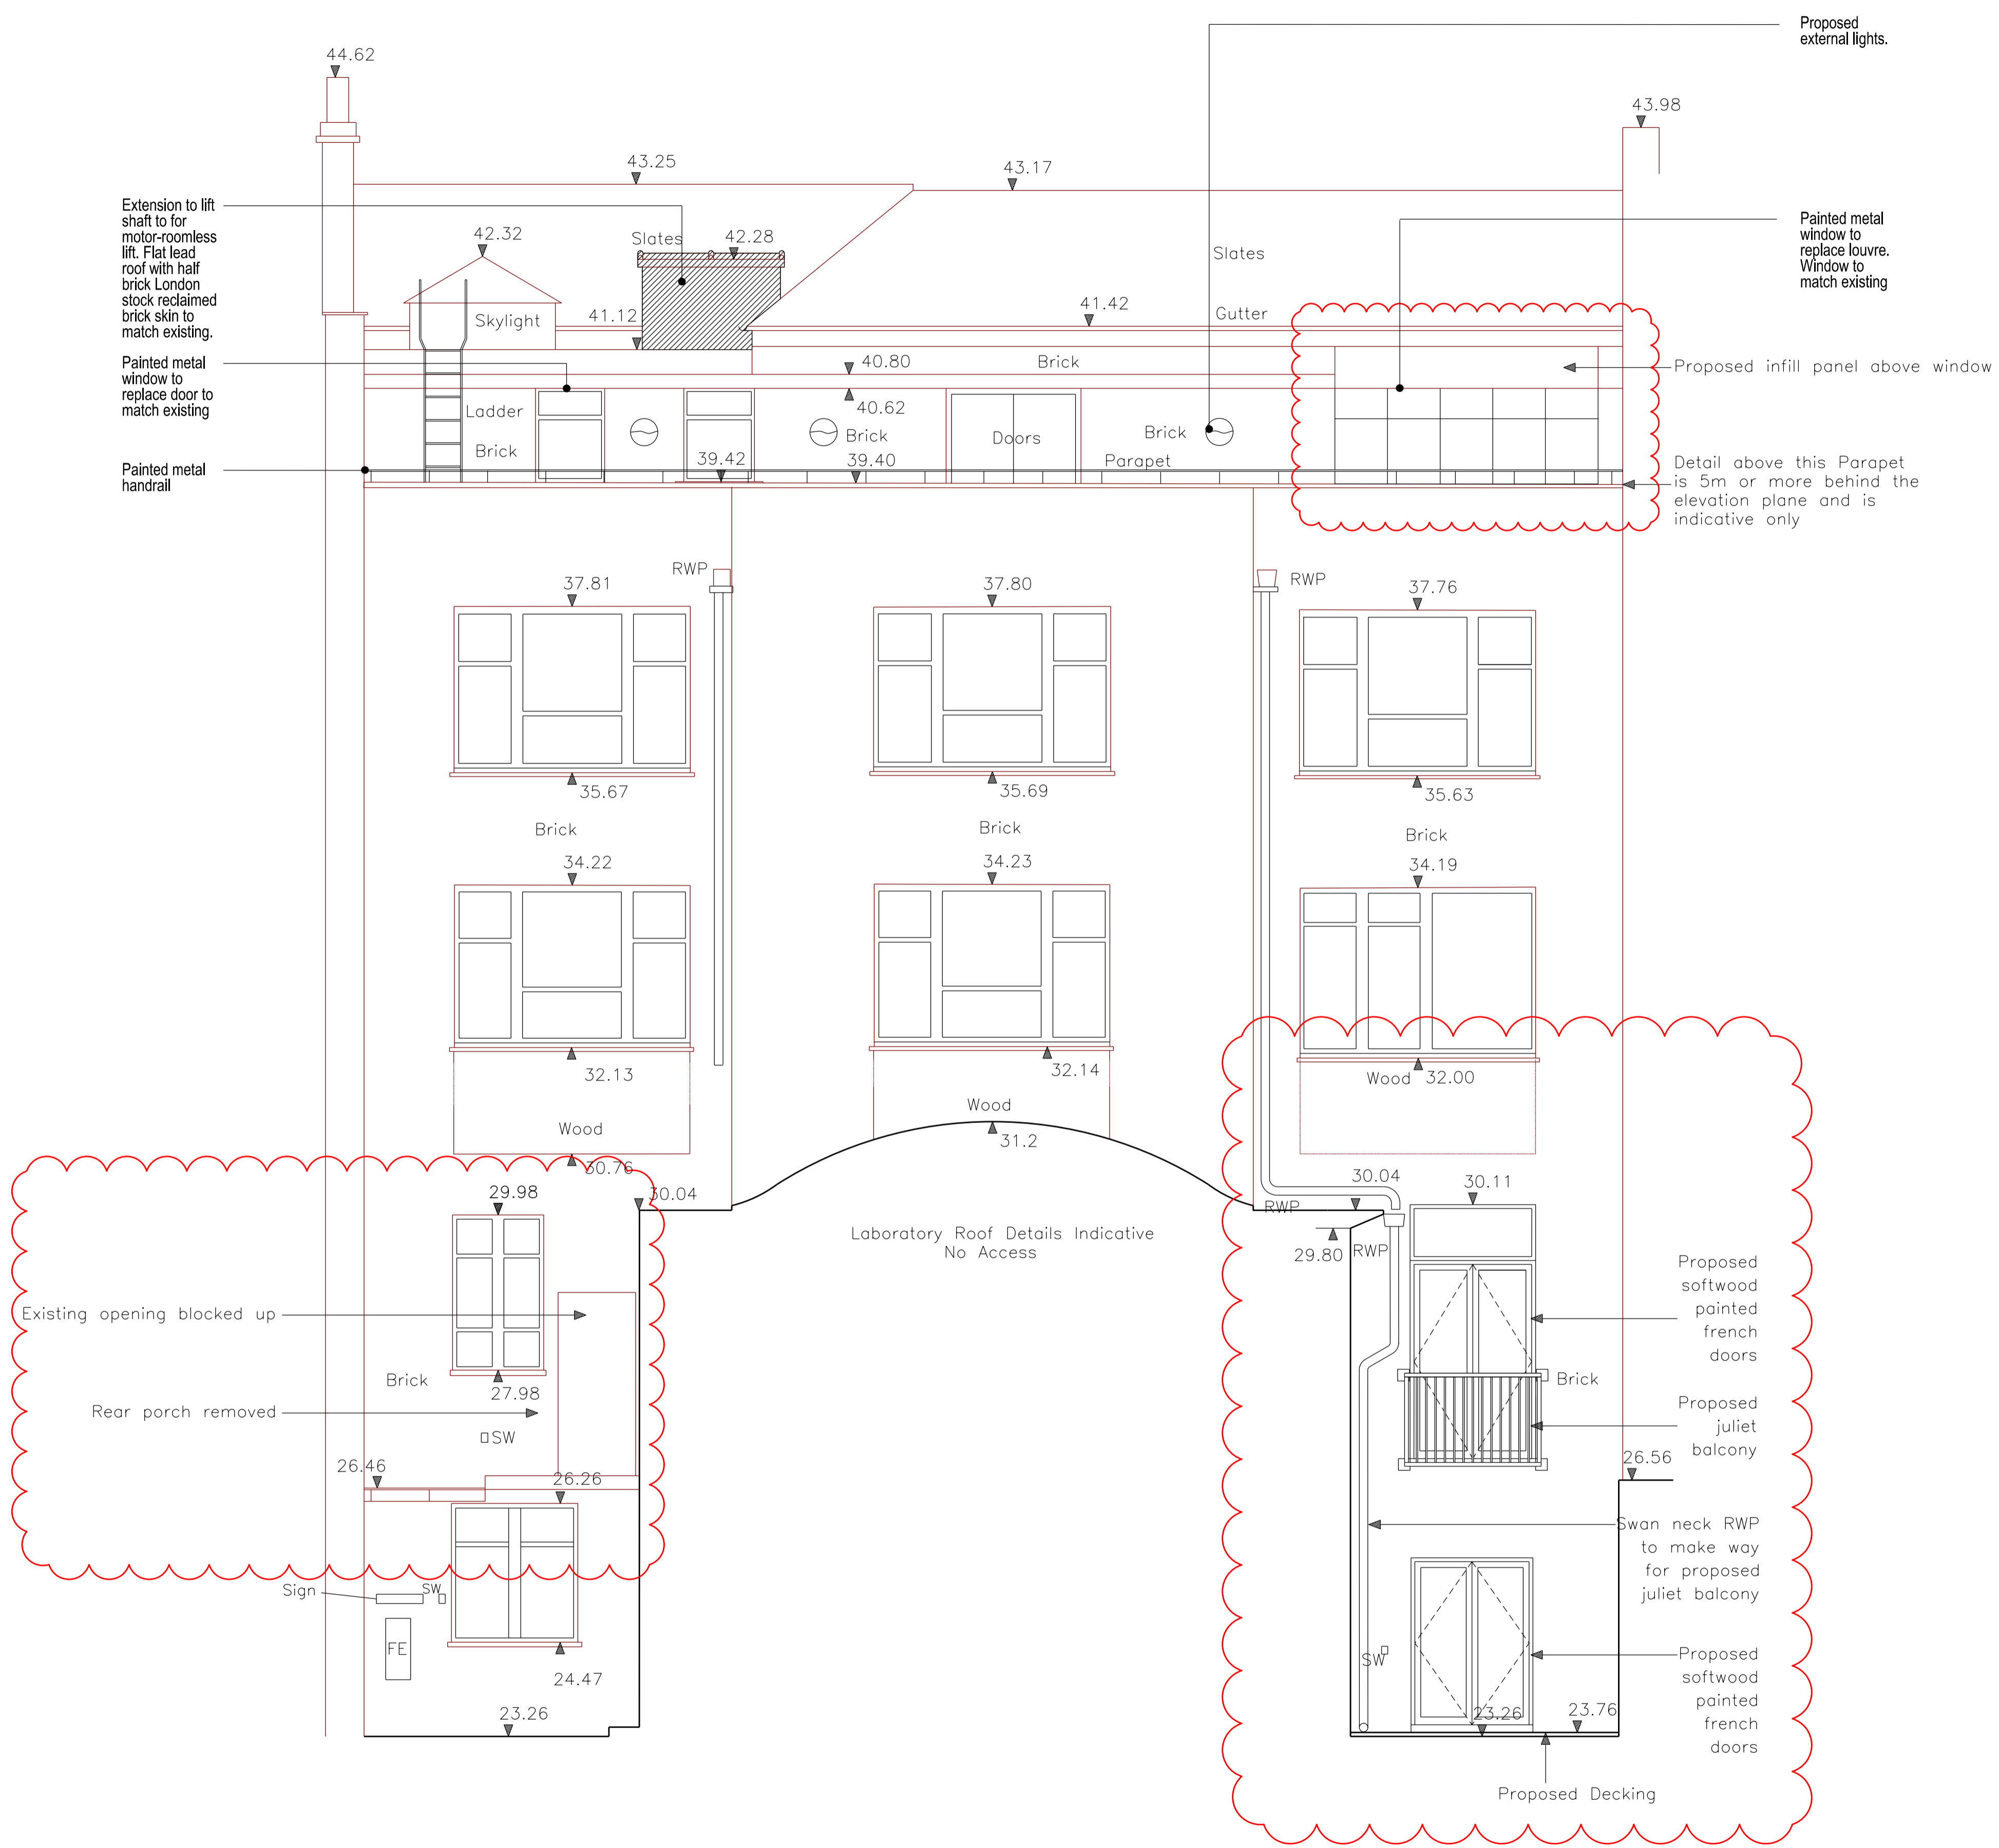

REVISION / DESCRIPTION	DRAWN	CHECKED	DATE
Issue for Construction	JT	JT	19/01/16
Issue for Construction - Rev A	RC	JT	09/03/16

- Rear porch at ground level removed
- Existing opening from 39RS/2/004 into rear porch blocked up
- Existing lightwell to basement level to remain
- Proposed french door into building at basement level in lightwell
- Proposed Juliet balcony with new french doors (as existing proposal) at ground level
- Steel deck removed at first floor level
- Proposed infill panel above window at third level



**BDP.**

16 Brewhouse Yard  
 Clerkenwell  
 London EC1V 4LJ  
 United Kingdom  
 T +44 (0)20 7812 8000  
 F +44 (0)20 7812 8399  
 www.bdp.com

PROJECT TITLE	
British Museum Perimeter Properties Refurbishment	
PROJECT NUMBER	
P2002323	
DRAWING TITLE	SCALE
39 Russell Square Proposed Series Rear Elevation	1:50 @ A1 1:100 @ A3
Issue for Construction	DATE
(20)AE002	19/01/2016
REVISION	
- REV A	



BUILDING DESIGN PARTNERSHIP LTD SHALL HAVE NO RESPONSIBILITY FOR ANY USE MADE OF THIS DOCUMENT OTHER THAN FOR THAT WHICH IT WAS PREPARED AND ISSUED.  
 ALL DIMENSIONS SHOULD BE CHECKED ON SITE.  
 DO NOT SCALE FROM THIS DRAWING.  
 ANY DRAWING ERRORS OR DIVERGENCES SHOULD BE BROUGHT TO THE ATTENTION OF BUILDING DESIGN PARTNERSHIP LTD AT THE ADDRESS SHOWN BELOW.



**NOTES**

EXISTING BUILDING SURVEY INFORMATION BY PLOWMAN CRAVEN, TO BE READ IN CONJUNCTION WITH ALL RELEVANT PROJECT INFORMATION.

REFER TO SERVICES ENGINEERS DRAWINGS FOR DETAILS OF PROPOSED PLANT INC. RISERS, DUCTS, FLUES, EXTRACT GRILLES, LOUVRES, ETC. AND ASSOCIATED BUILDERS WORK.

**KEY:**

-  GREY TONE INDICATES EXISTING STRUCTURE RETAINED
-  HATCH INDICATES AREA OF NEW CONSTRUCTION

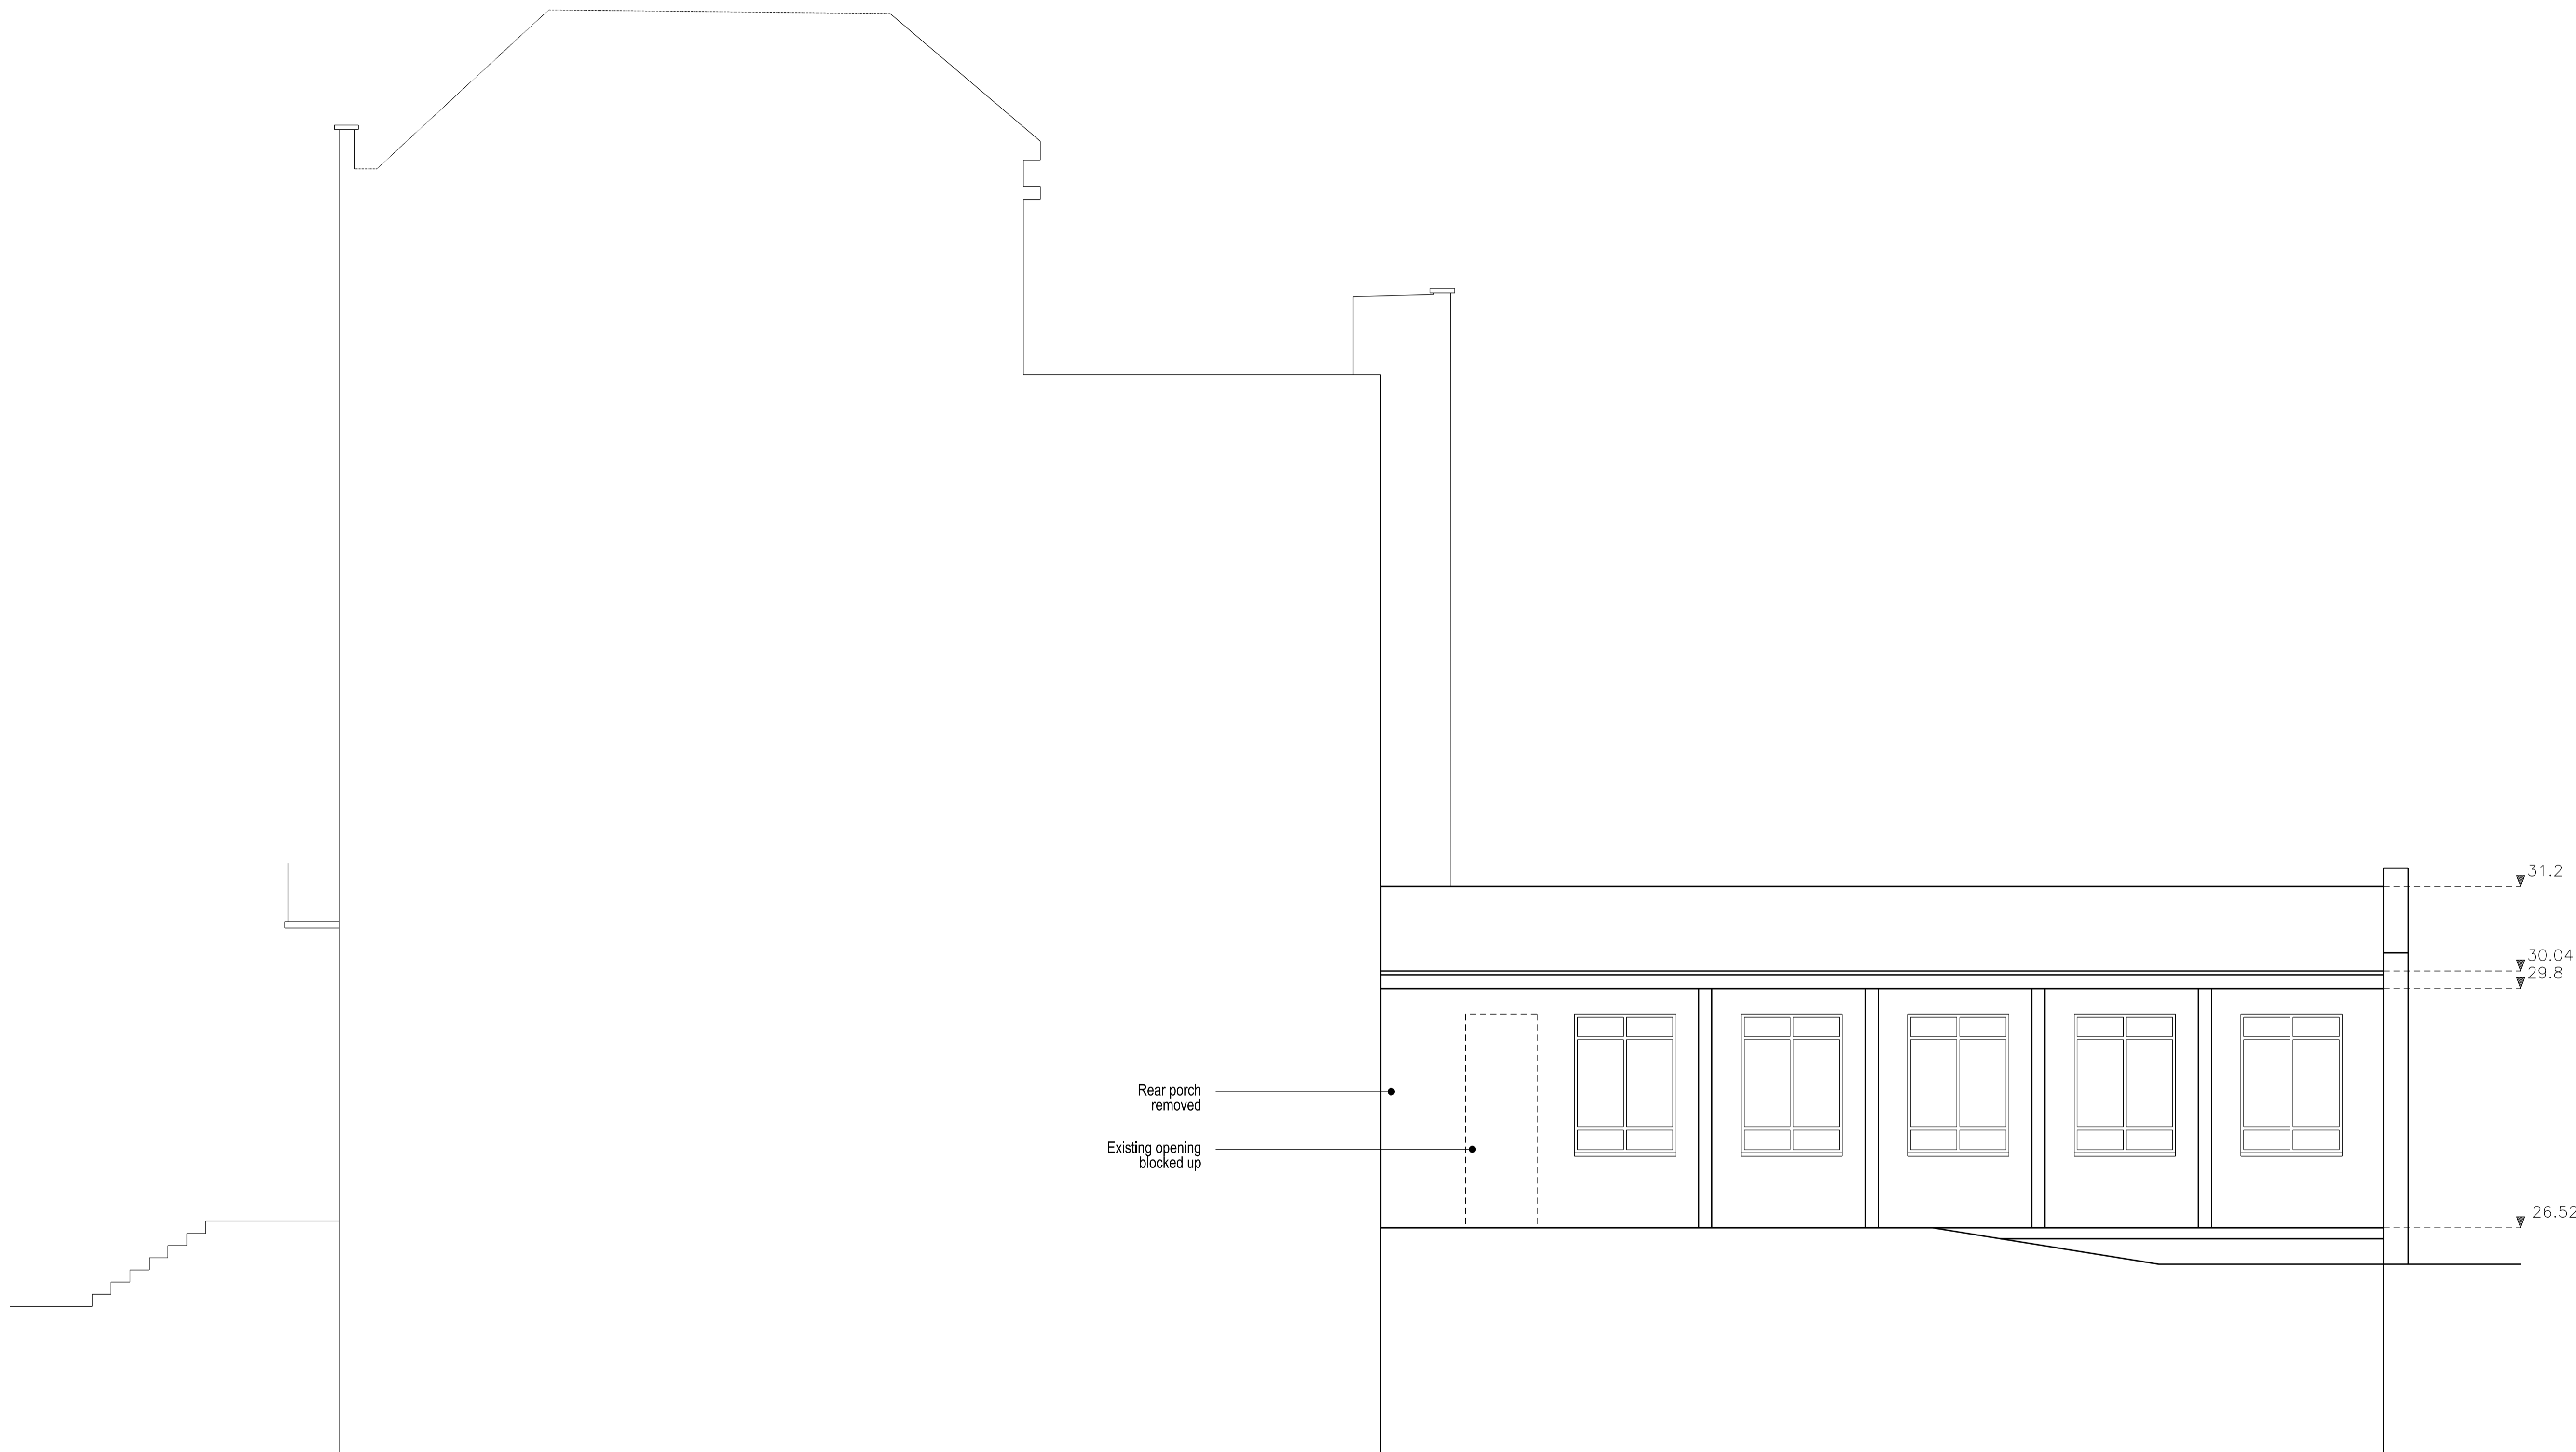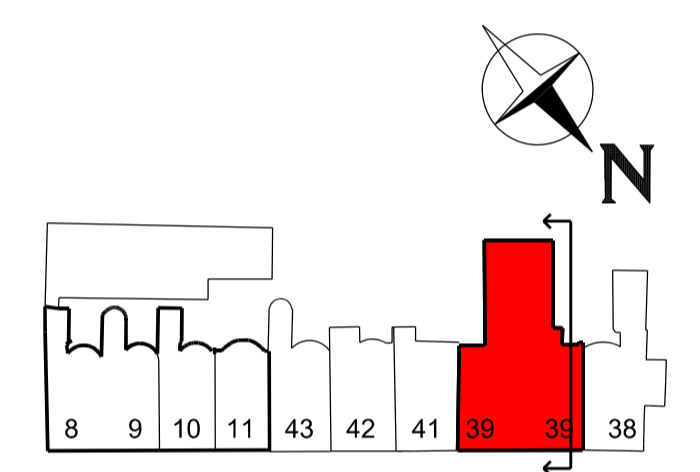

REVISION / DESCRIPTION	DRAWN	CHECKED	DATE



**BDP.**

16 Brewhouse Yard  
 Clerkenwell  
 London EC1V 4LJ  
 United Kingdom  
 T +44 (0)20 7812 8000  
 F +44 (0)20 7812 8399  
 www.bdp.com

<b>PROJECT TITLE</b> British Museum Perimeter Properties Refurbishment	
<b>PROJECT NUMBER</b> P2002323	
<b>DRAWING TITLE</b> 39 Russell Square Proposed Series Side Elevation of Rear Extension	<b>SCALE</b> 1:50 @ A1 1:100 @ A3
<b>DRAWING No.</b> (20)AE003	<b>DATE</b> 31/05/16
<b>DESIGNED BY</b> 	<b>REVISION</b> 