

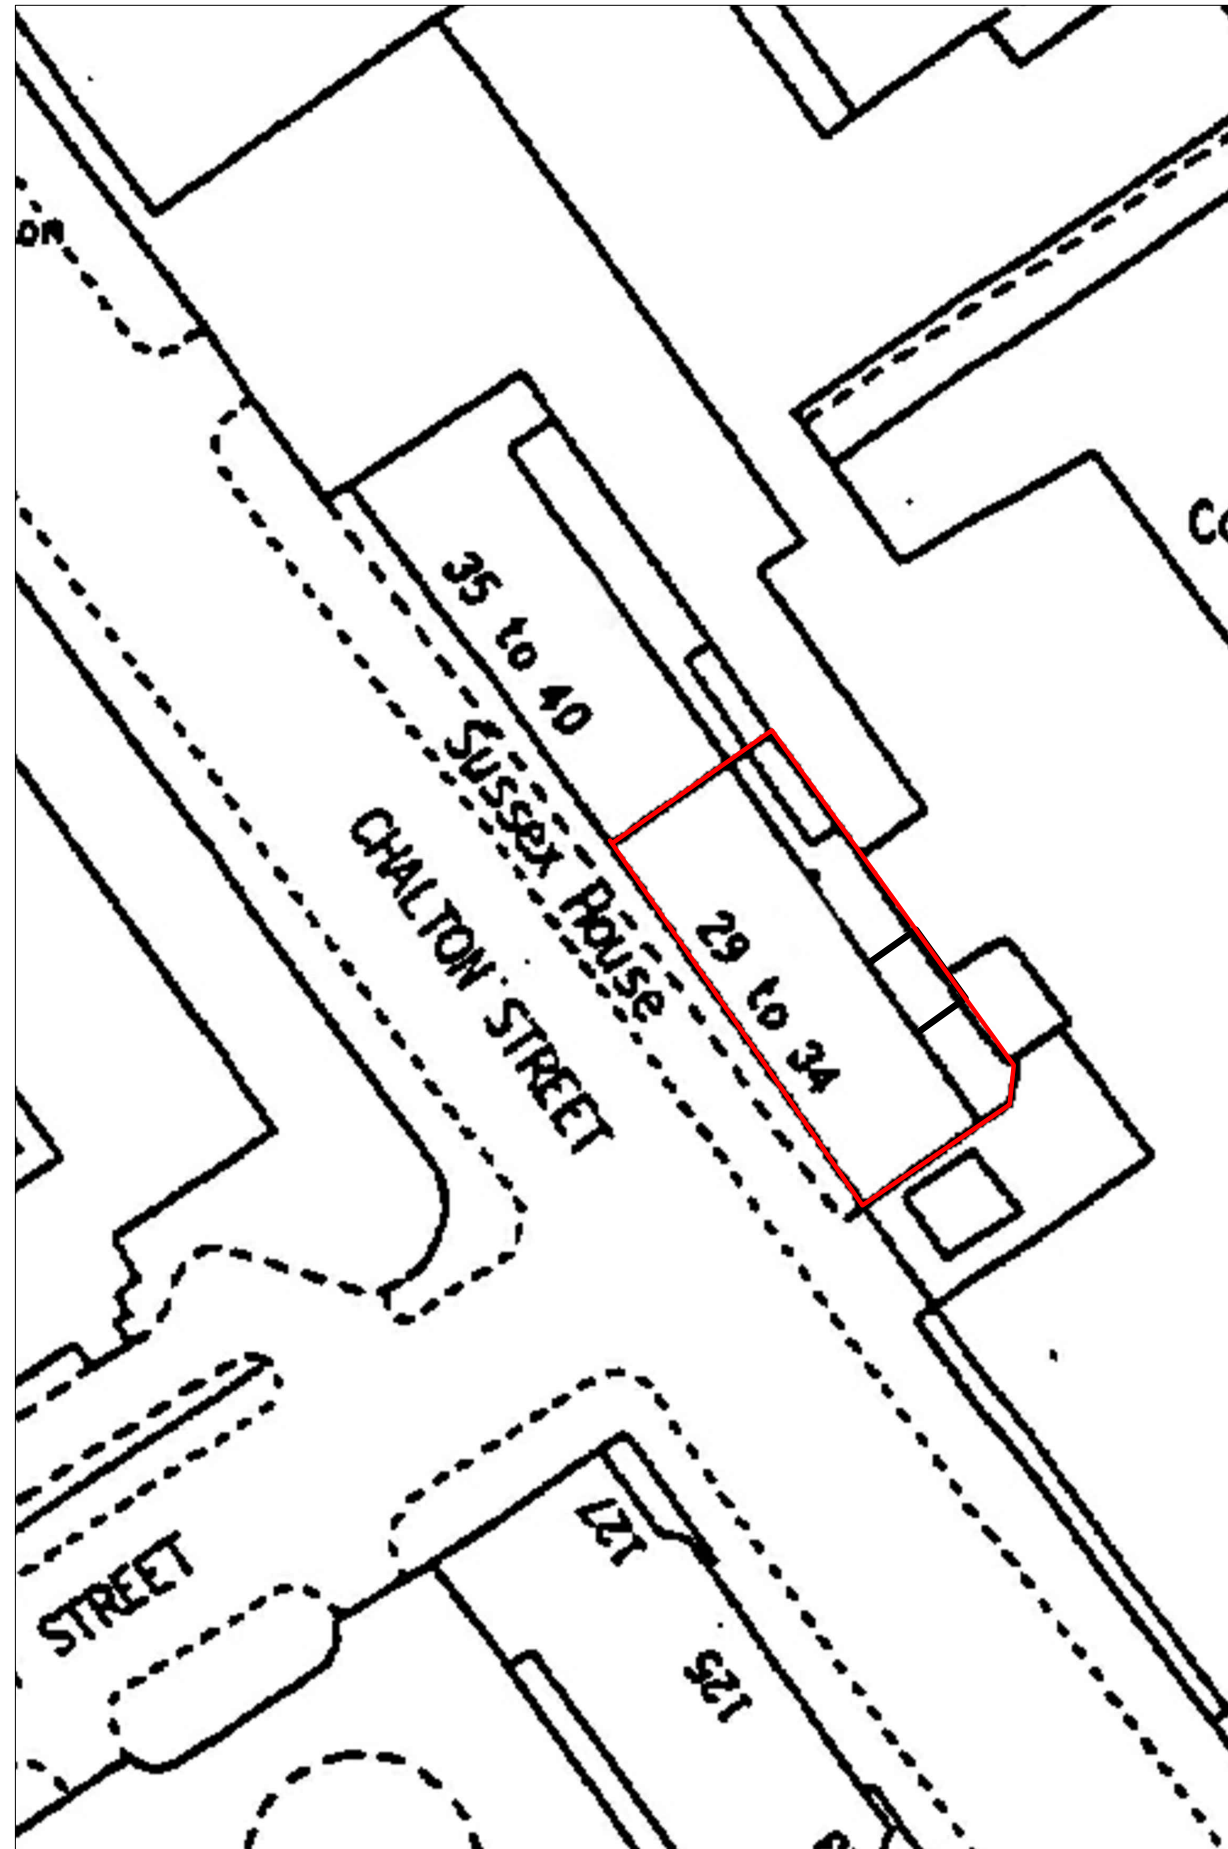


1 Existing Block Plan
1:500

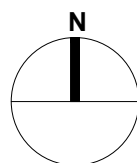

2 Block Plan As Built
1:500

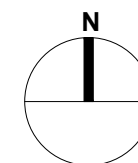

1:500

dpa ARCHITECTS
INTERIOR DESIGNERS
PARTY WALL SURVEYORS
PLANNING CONSULTANTS

Hertfordshire Office
25 Tudor Hall
Brewery Road
Hoddesdon, Herts
EN11 8FP

London Office
9 Devonshire square
London
EC2M 4YF

RIBA 01992 469001
info@dpa-architects.co.uk
www.dpa-architects.co.uk

Client	Redcourt Limited of 1-2 Temple Fortune Parade, Bridge Lane London NW11 0QN.
Site address	Sussex House Charlton Street NW11 1RB
Project Description	Proposed Bike Store in Sussex House
Drawing Title	Existing and Block Plan and Block Plan as built
Drawn	LP
Checked by	DP
Issued for	Planning Submission
Scale	1:500@A3
Drawing No.	1245 002
Date	2016 10 03
Revisions	