







2 **Rear Elevation As Built**
1:100

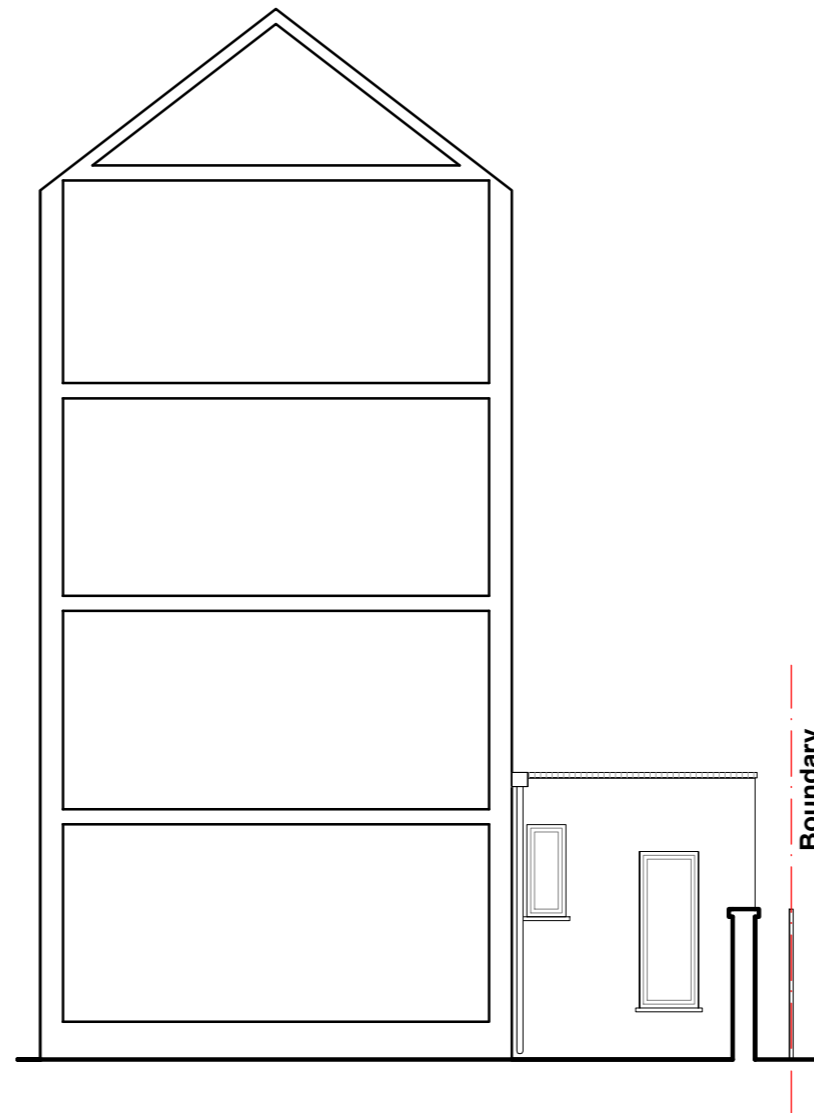


3 **Proposed Flank Elevation As Built**
1:100

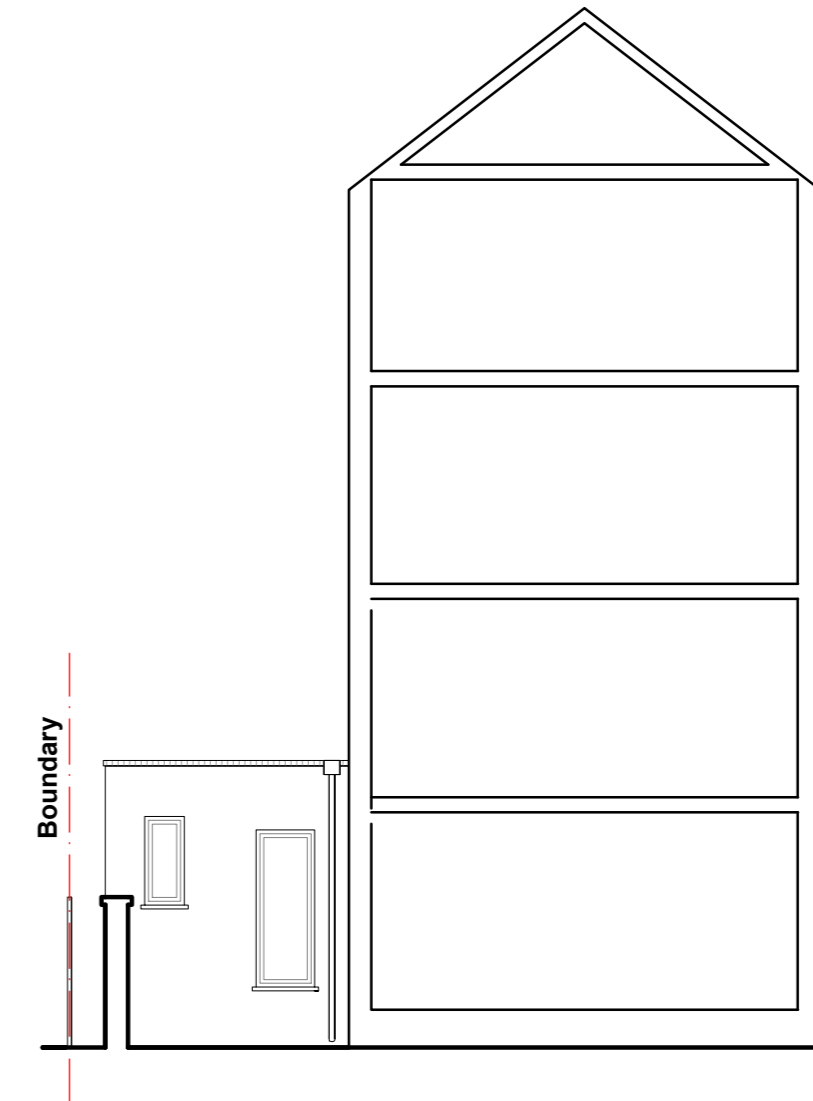

4 **Proposed Flank Elevation As Built**
1:100

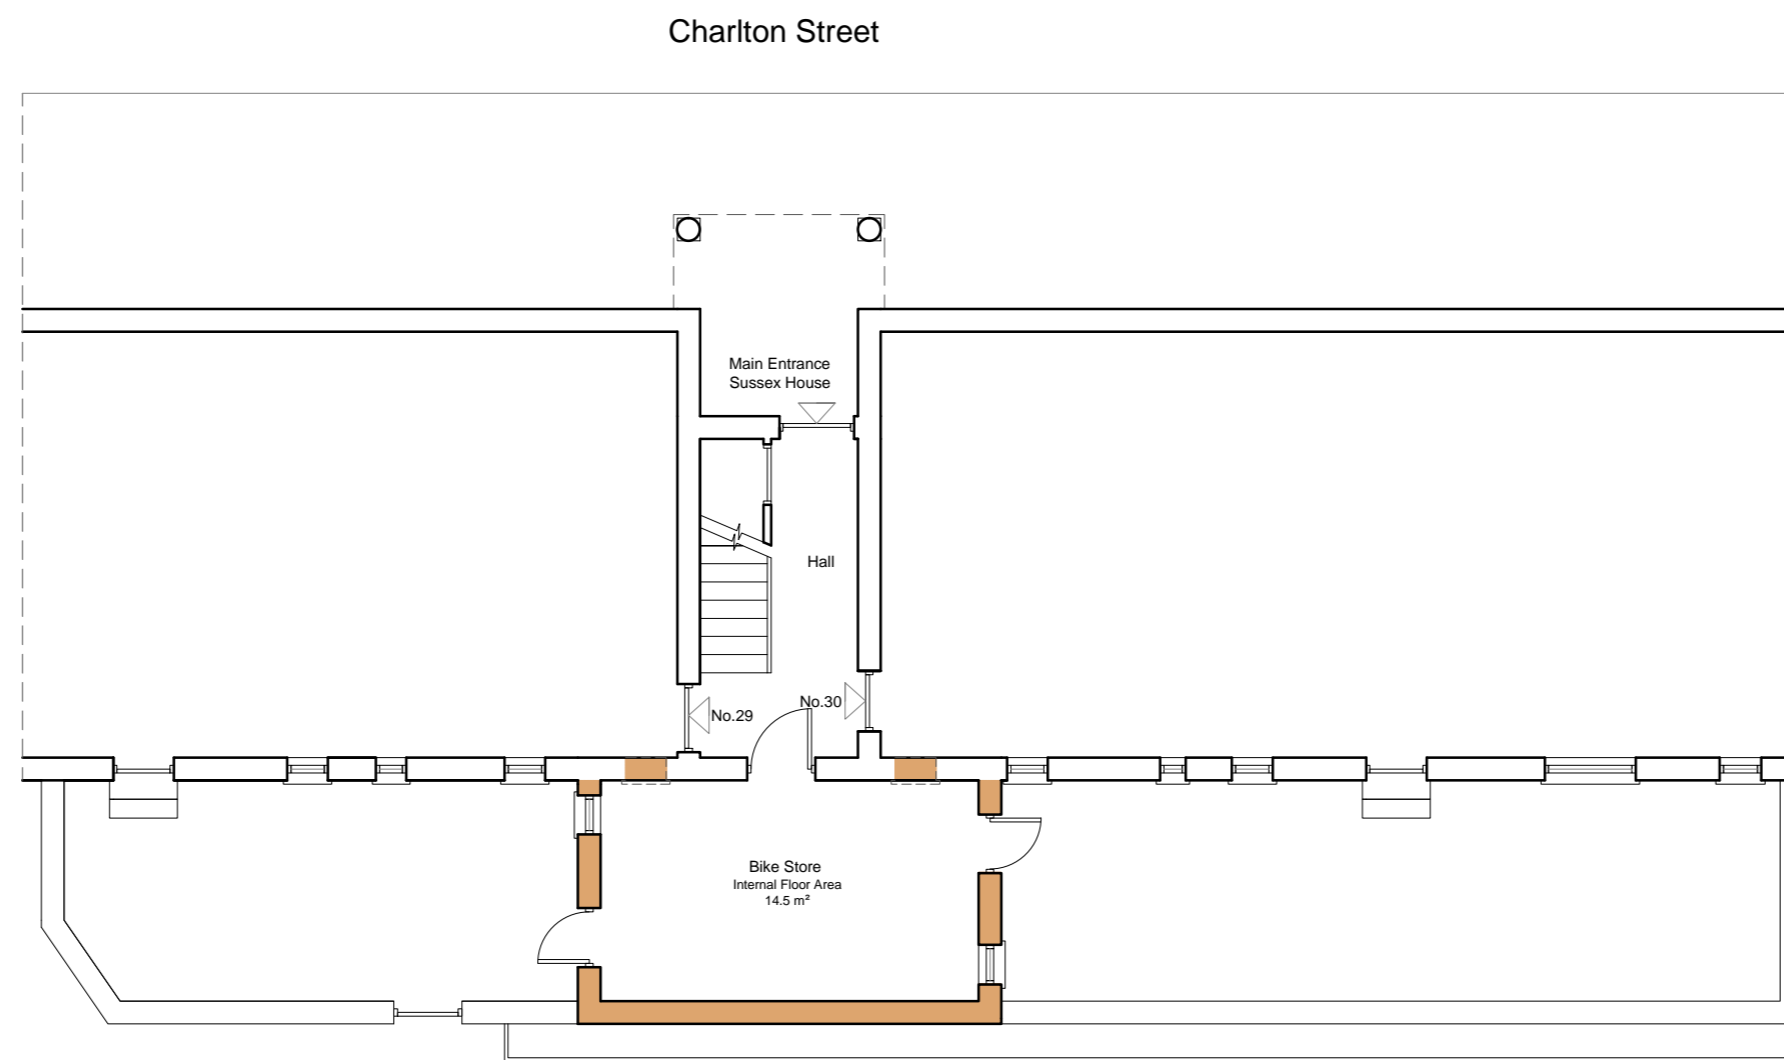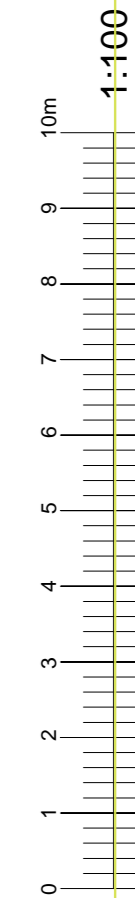

1 **Ground Floor Plan As Built**
1:100

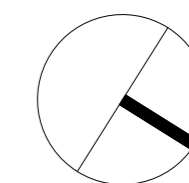

dpa
ARCHITECTS
INTERIOR DESIGNERS
PARTY WALL SURVEYORS
PLANNING CONSULTANTS

Hertfordshire Office
25 Tudor Hall
Brewery Road
Hoddesdon, Herts
EN11 8FP

London Office
9 Devonshire square
London
EC2M 4YF

RIBA

01992 469001
info@dpa-architects.co.uk
www.dpa-architects.co.uk

Client	Redcourt Limited of 1-2 Temple Fortune Parade, Bridge Lane London NW11 0QN.
Site address	Sussex House Charlton Street NW1 1RB
Project Description	Proposed Bike Store in Sussex House
Drawing Title	Ground Floor Plan and Elevations As built
Drawn	LP
Checked by	DP
Issued for	Planning Submission
Scale	1:100@A2
Drawing No.	1245 004
Date	2016 10 03
Revision	