

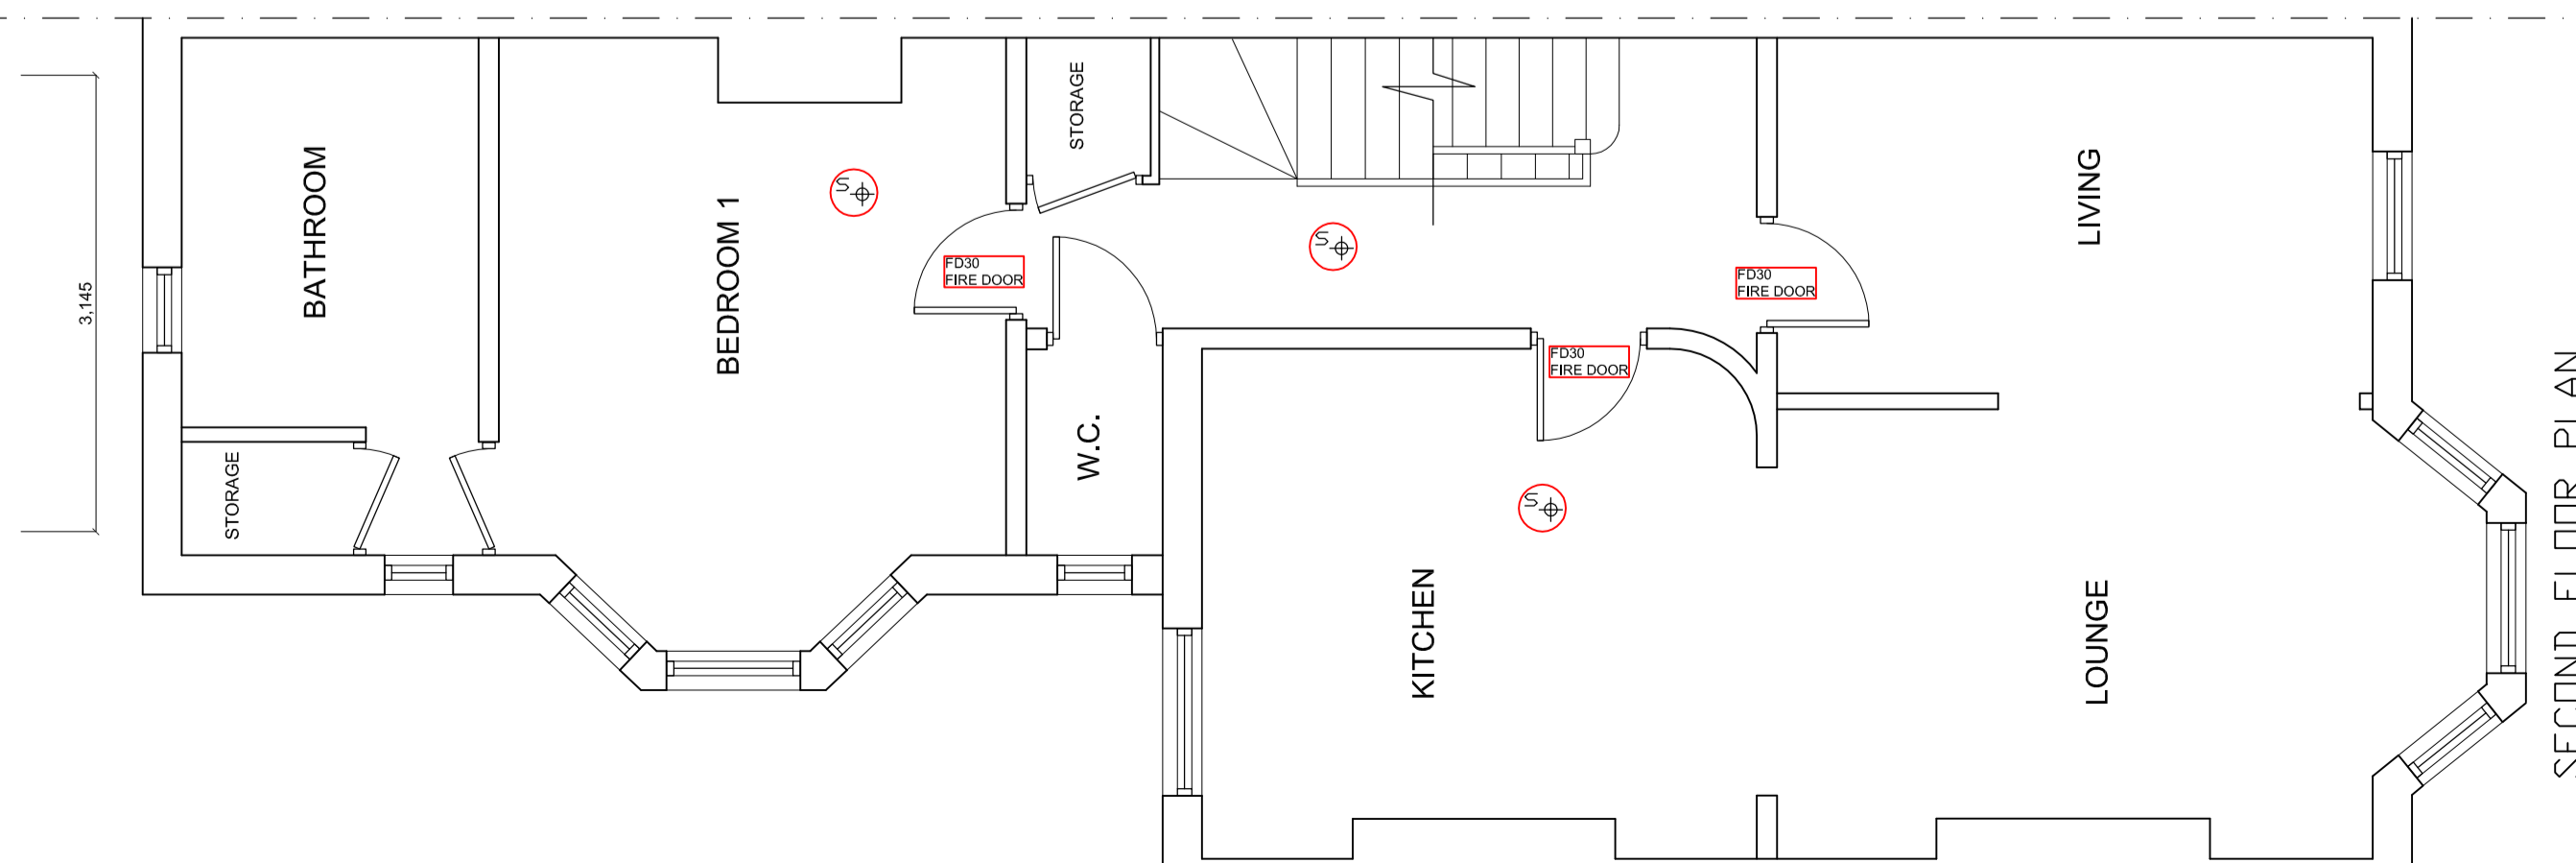


# AS-BUILT 1:100

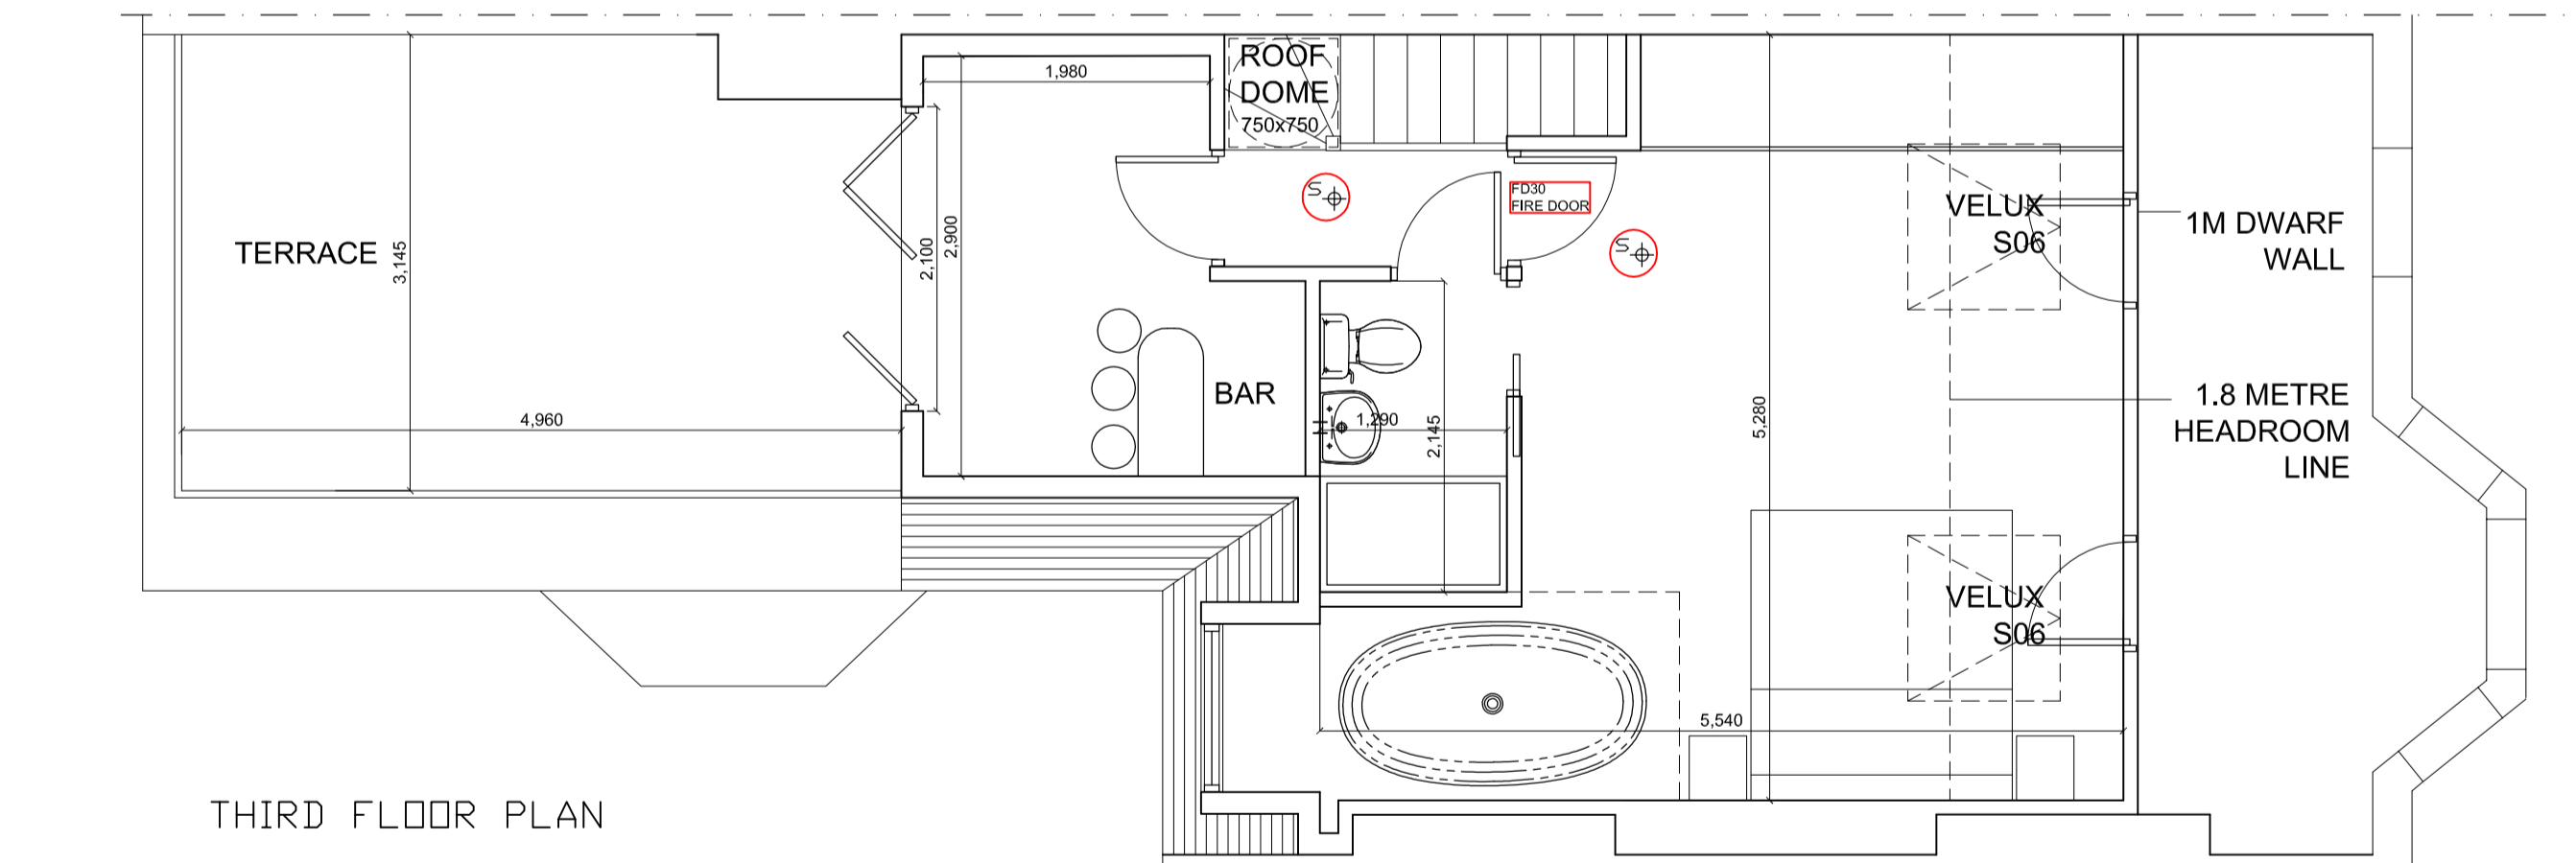

# AS-BUILT 1:50

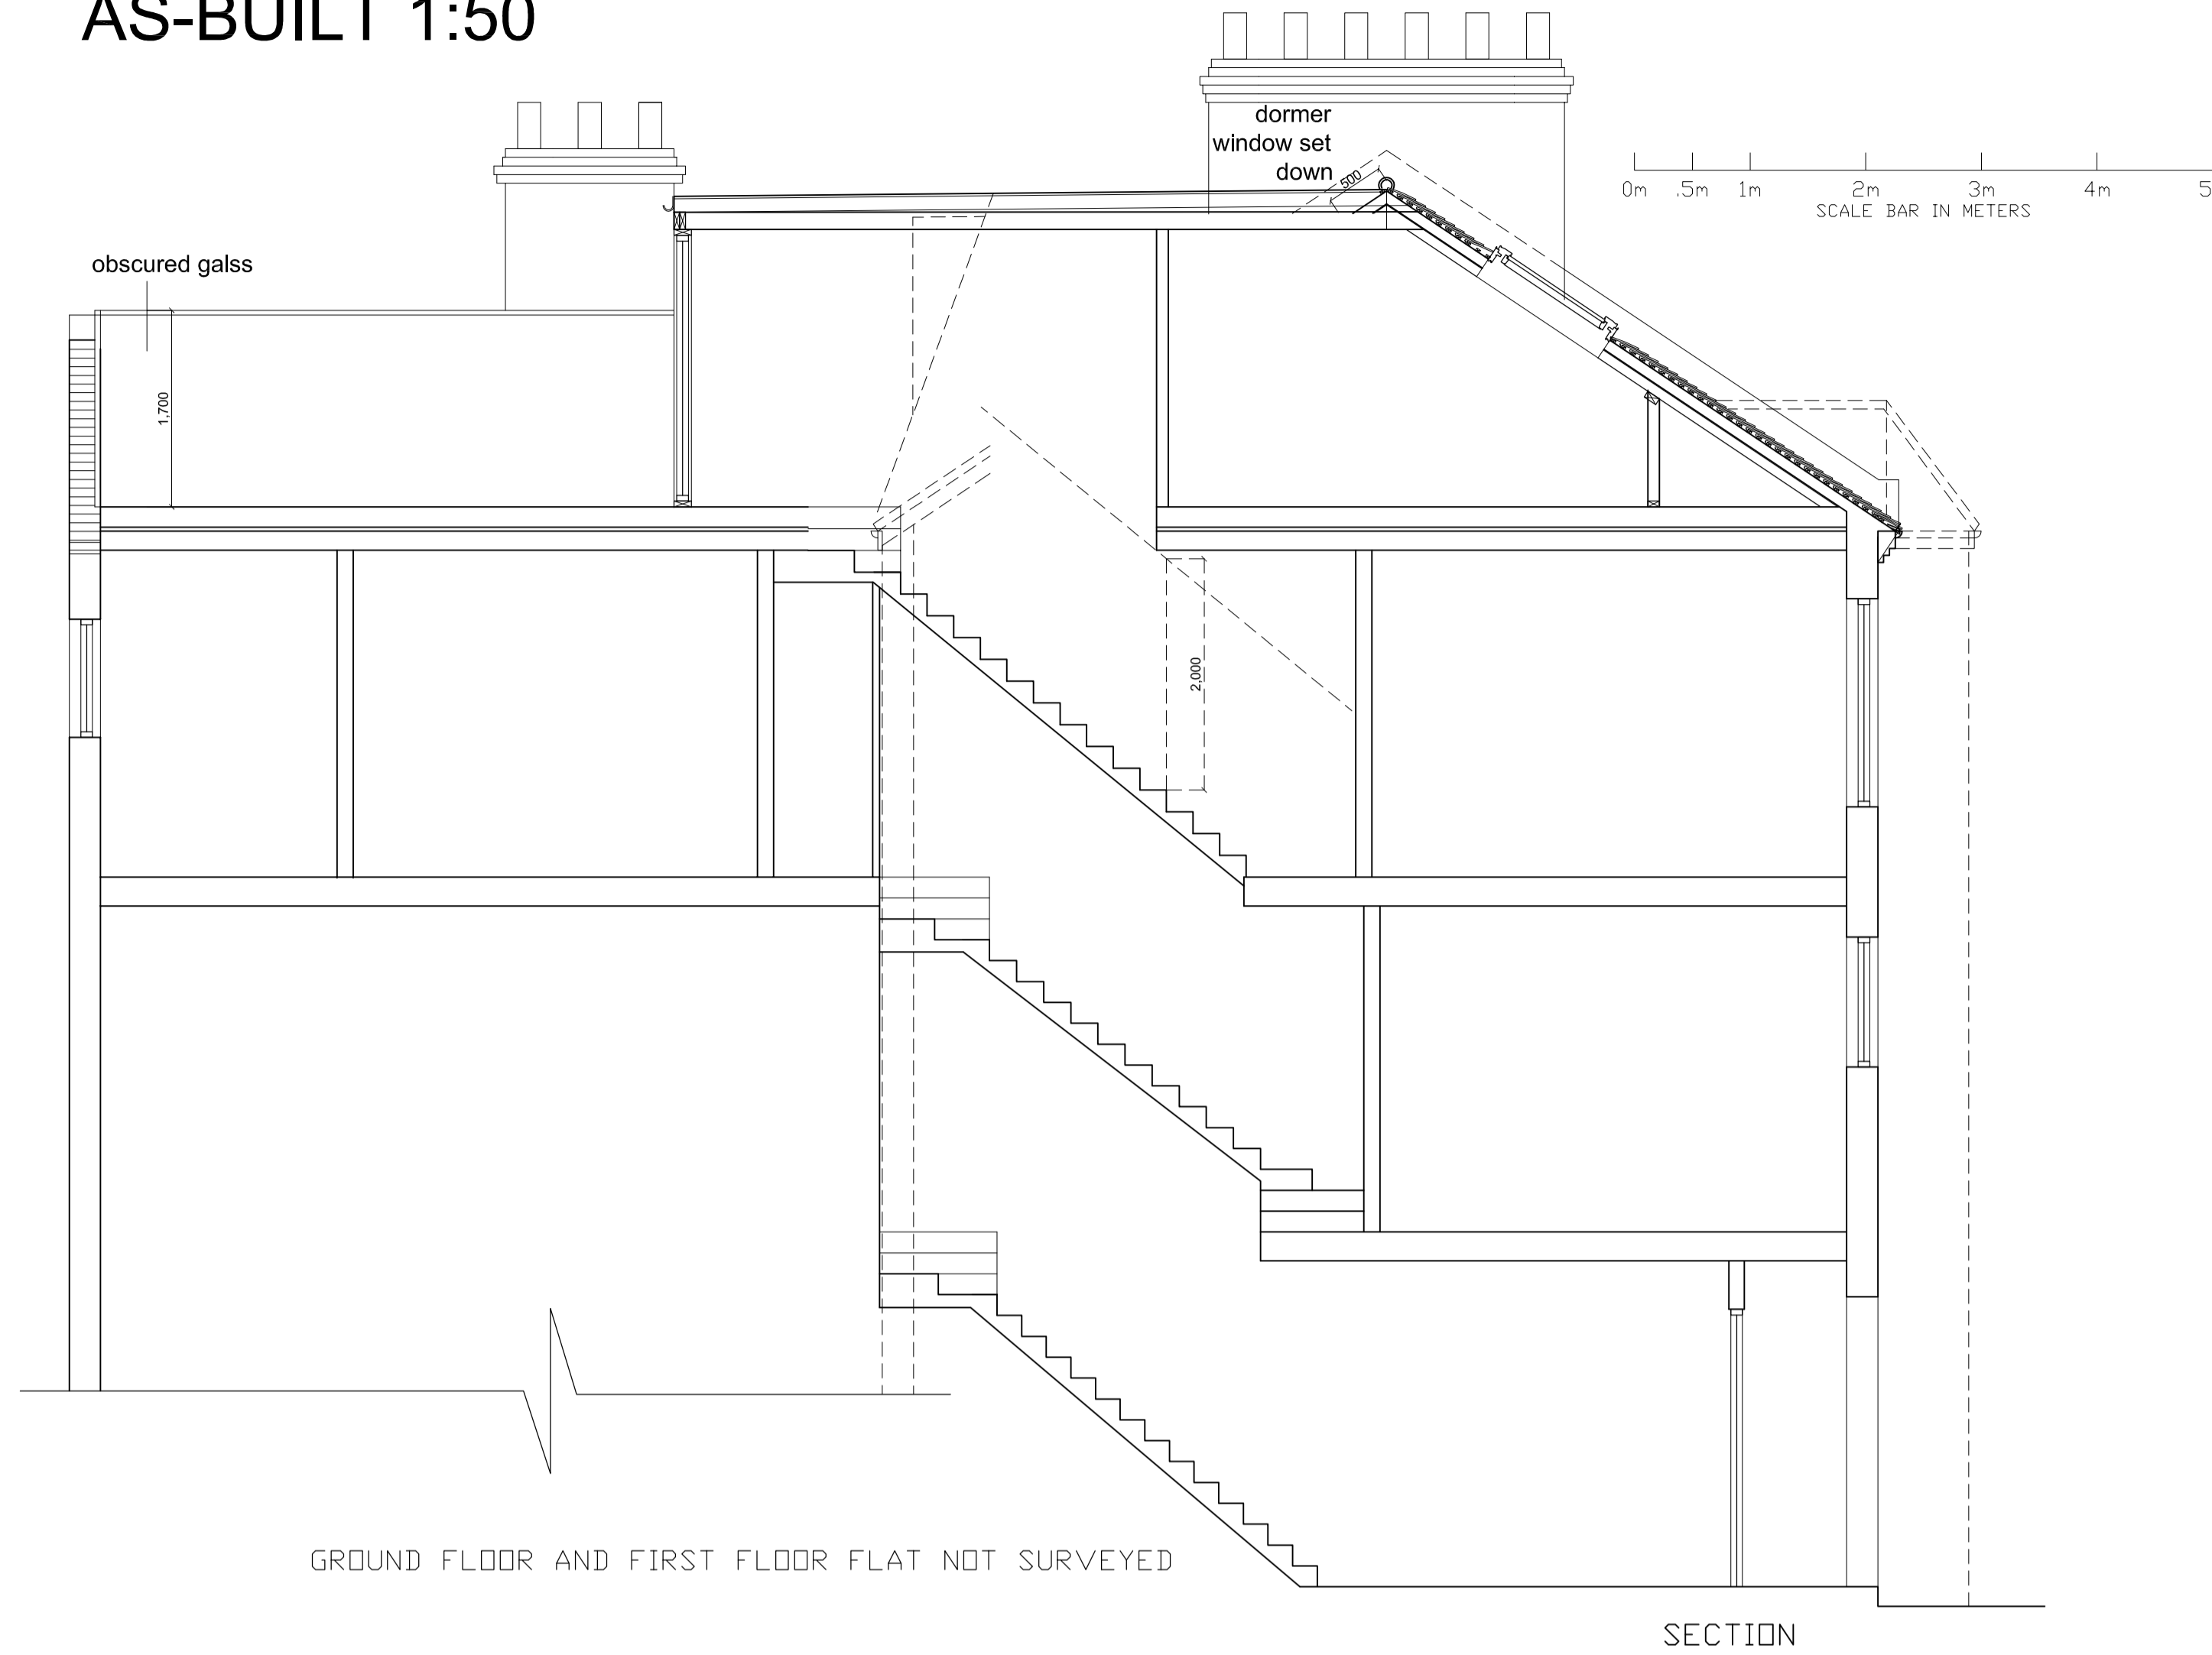

Copyright © Absolute Lofts  
 This drawing which is the property of Absolute Lofts is the subject of Intellectual Property Rights including copyright and design right and shall not be reproduced, copied, loaned or submitted to any other party without the written consent of Absolute Lofts.

This drawing is not to be scaled. Only figured dimensions to be taken. Any discrepancies to be reported to Absolute Lofts prior to setting out or ordering of any materials



Godiva House, 1 Connaught Ave Loughton, Essex IG10 4DP  
 Tel/Fax 020 8907 7131 Email: www.absolute-lofts.com

Project

LOFT CONVERSION AT  
 94C COLLEGE PLACE

Client

Drawing Title  
 DRAWING TITLE  
 EXISTING AND PROPOSED  
 PLANS, SECTION  
 AND ELEVATIONS

Scale	Drawn	Checked	Authorised
1:100, 1:50 @ A1	-	-	-
	FEB.2014	-	-

Drawing Number	Rev
AL_14_94cCOL_001	L