



1. ALL MEASUREMENTS/DIMENSIONS TO BE CHECKED ON SITE PRIOR TO UNDERTAKING ANY WORKS.

NEW ATM INSTALLED TO LHS OF ENTRANCE THROUGH PANEL WITH COMPOSITE. INTERNAL SHUTTER MODIFIED. ATM TO INCLUDE PIN SHIELD, MIRRORS & PRIVACY ZONE WITH OVERHEAD CCTV CAMERA

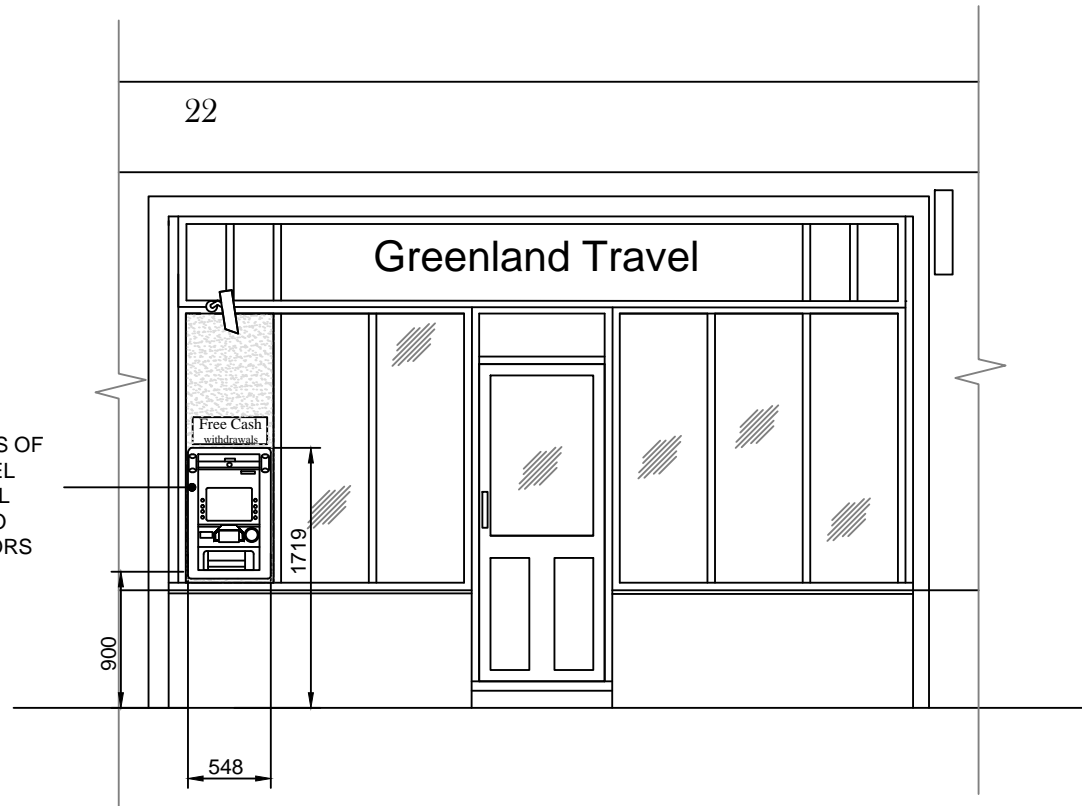

AS INSTALLED FRONT ELEVATION
SCALE 1:50

NOTE: HATCHED AREA DENOTES SERVICE ZONE

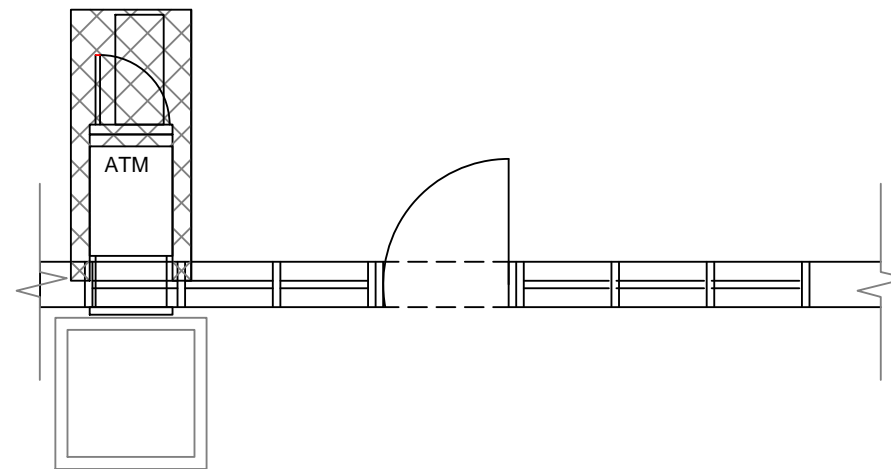

NOTE: AREA DENOTES CUSTOMER PRIVACY ZONE

AS INSTALLED PART PLAN
SCALE 1:50

REV.	DATE	BY	DESCRIPTION
3	04.11.16	JML	CCTV relocated to window frame
2	03.11.16	JML	CCTV added
1	01.11.16	JML	Mirrors, privacy zone & pin shield

NOTE MACHINE

NoteMachine UK Ltd

Elvicta Business Park, Crickhowell, Powys, NP8 1DF
Tel: 01873 811 634 Fax: 01873 811 552

CLIENT

Greenland Travel (TTW)

TITLE
AS INSTALLED ELEVATION AND PLAN
CONVENIENCE STORE
22 Charlton St, Kings Cross
London, NW1 1JH

DRAWN BY	DATE	SCALE	SHEET SIZE
JML/CAD	16/08/16	1:50	A3
CHECKED BY	DATE	APPROVED BY	DATE

DRAWING No.	REVISION
32048-54-002	3