


AS BUILT ELEVATION OF NO 46.

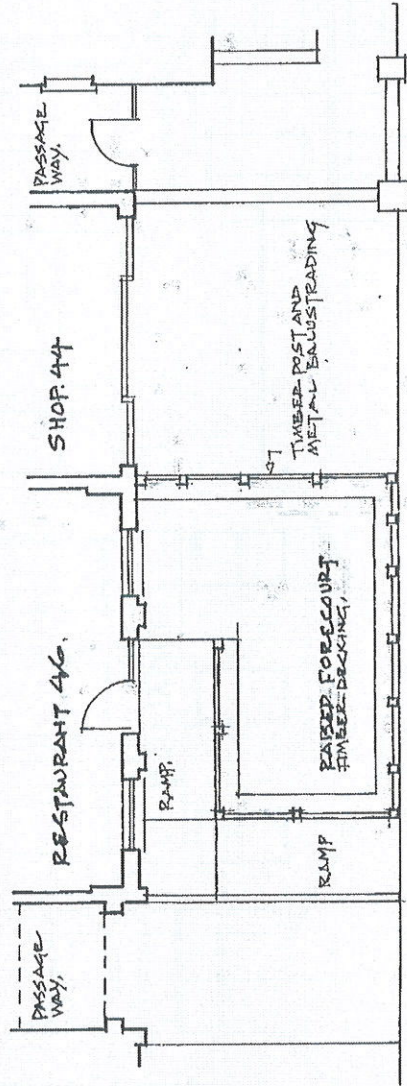

AS BUILT PLAN OF FRONTAGE NO 46

NO 46. BIRCHINGTON ROAD
KILBURN. LONDON NWS 4LJ

CLYSA

PLAN AND ELEVATION OF AS BUILT
SHOP FRONT AND FORECOURT.
SCALE 1:100
DATE JANUARY 2016

