

COLUMN SCHEDULE

REF.	SIZE
C1	250x700 RC COLUMN
C3	300x1200 RC COLUMN
C4	300x1200 RC COLUMN
C5	300x600 RC COLUMN
C6	400x400 RC COLUMN
C8	450x650 RC COLUMN
C9	500x500 RC COLUMN
C11	200x600 RC COLUMN
C12	7500 RC COLUMN
C13	300x600 RC COLUMN
C14	300x1000 RC COLUMN
C15	400x450 RC COLUMN
C20	650x650 RC COLUMN

INTERFACE WITH EXISTING RAMP TO BE DEVELOPED DURING DETAILED DESIGN AND WITH POST DEMOLITION SITE INVESTIGATION

POTENTIAL FOR PARTIAL REUSE OF EXISTING RETAINING WALLS AND BASEMENT SLAB TO BE REVIEWED DURING DEMOLITION

SLAB LEVELS UNDER REVIEW BY ARCHITECT IN THIS AREA, TO BE CONFIRMED DURING STAGE 4. POTENTIAL REQUIREMENT FOR LOWERING BY 150mm WITH RECESSED AREA TO EDGE OF ADJACENT RAFT SLAB

FOUNDATION FOR POTENTIAL ATTENUATION TANK ALLOW FOR 12 No. 600 Dia. PILES

INDICATIVE STRUCTURAL LAYOUT FOR LUL ENTRANCE AREA TO BE DEVELOPED DURING STAGE 4

INDICATIVE LUL STAIR/LIFT LOCATIONS TO BE DEVELOPED

APPROXIMATE OUTLINE OF EXISTING LUL STRUCTURE BASED ON INTERNAL SURVEY & LIMITED RECORD DRAWINGS

PROXIMITY TO EXISTING LUL STRUCTURE TO BE CONFIRMED DURING DEMOLITION

WALL DESIGNED AS POTENTIAL FUTURE KNOCKOUT PANEL

BASEMENT SLAB, WALLS AND GROUND FLOOR SLAB ACT INTEGRARLY AS DEEP I-BEAMS

750 THICK FULL-HEIGHT RC WALL

350 THICK RC RETAINING WALL

325 THICK RC SLAB

2000mm FOUNDATION

300 THICK RC WALL

300 THICK RC WALL

Project Management Initials: Designer: Checker: Approver: Approver/Drawn by: Author: ISO A0 (841mm x 1189mm)

Last Printed: 19/10/2016 17:48:40
Filename: C:\Users\mccreel\Documents\SC_ACS_0-S_Main_Model_michael.stn

This drawing has been prepared for the use of AECOM's client. It may not be used, modified, reproduced or relied upon by third parties, except as agreed by AECOM. AECOM accepts no responsibility and disclaims any liability for any loss or damage, howsoever caused, arising from the use of this drawing without AECOM's express written consent. Do not scale this document. All measurements must be obtained from the stated dimensions.

STABILITY OF LUL DEMISE DURING DEMOLITION AND CONSTRUCTION. DETAILED CONTRACTOR'S METHOD STATEMENT AND ENGINEERING APPRAISAL REQUIRED.

REFER TO MEP DRAWINGS FOR SERVICES THROUGH BASEMENT RETAINING WALLS. ALLOW FOR WATERPROOFING TREATMENT TO PENETRATIONS.

REFER TO MEP DRAWINGS FOR FLOOR GULLIES




INTERFACE WITH LUL PROPERTY AND TUNNELS. SEE AECOM LUL DEMISE REPORT.

ALL RC WALLS TO BE 300 THICK IN BUILDING A & 250 THICK IN BUILDING B UNLESS NOTED OTHERWISE

ISSUE/REVISION

NO.	DATE	DESCRIPTION
P1	19/10/16	UPDATED STAGE 3 INFORMATION FOR BASEMENT TENDER
P2	19/10/16	REVISED STAGE 3
P3	30/09/16	STAGE 3
1/R		

KEY PLAN

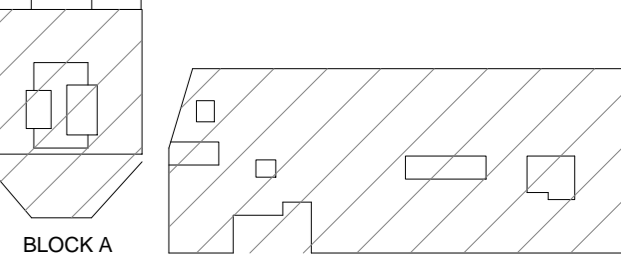

PURPOSE OF ISSUE

STAGE 3

PROJECT NUMBER

47066169

SHEET TITLE

BASEMENT SITE PLAN


SHEET NUMBER

SC-ACS-0-S-03030

SCALE: 1 : 100 @ A0

REV: P3

REF.	SIZE
C1	250x750 RC COLUMN
C3	300x1200 RC COLUMN
C4	350x1200 RC COLUMN
C5	350x600 RC COLUMN
C6	400x600 RC COLUMN
C8	450x650 RC COLUMN
C9	500x650 RC COLUMN
C11	200x800 RC COLUMN
C12	750x750 RC COLUMN
C13	300x600 RC COLUMN
C14	300x1000 RC COLUMN
C15	400x650 RC COLUMN
C20	650x650 RC COLUMN

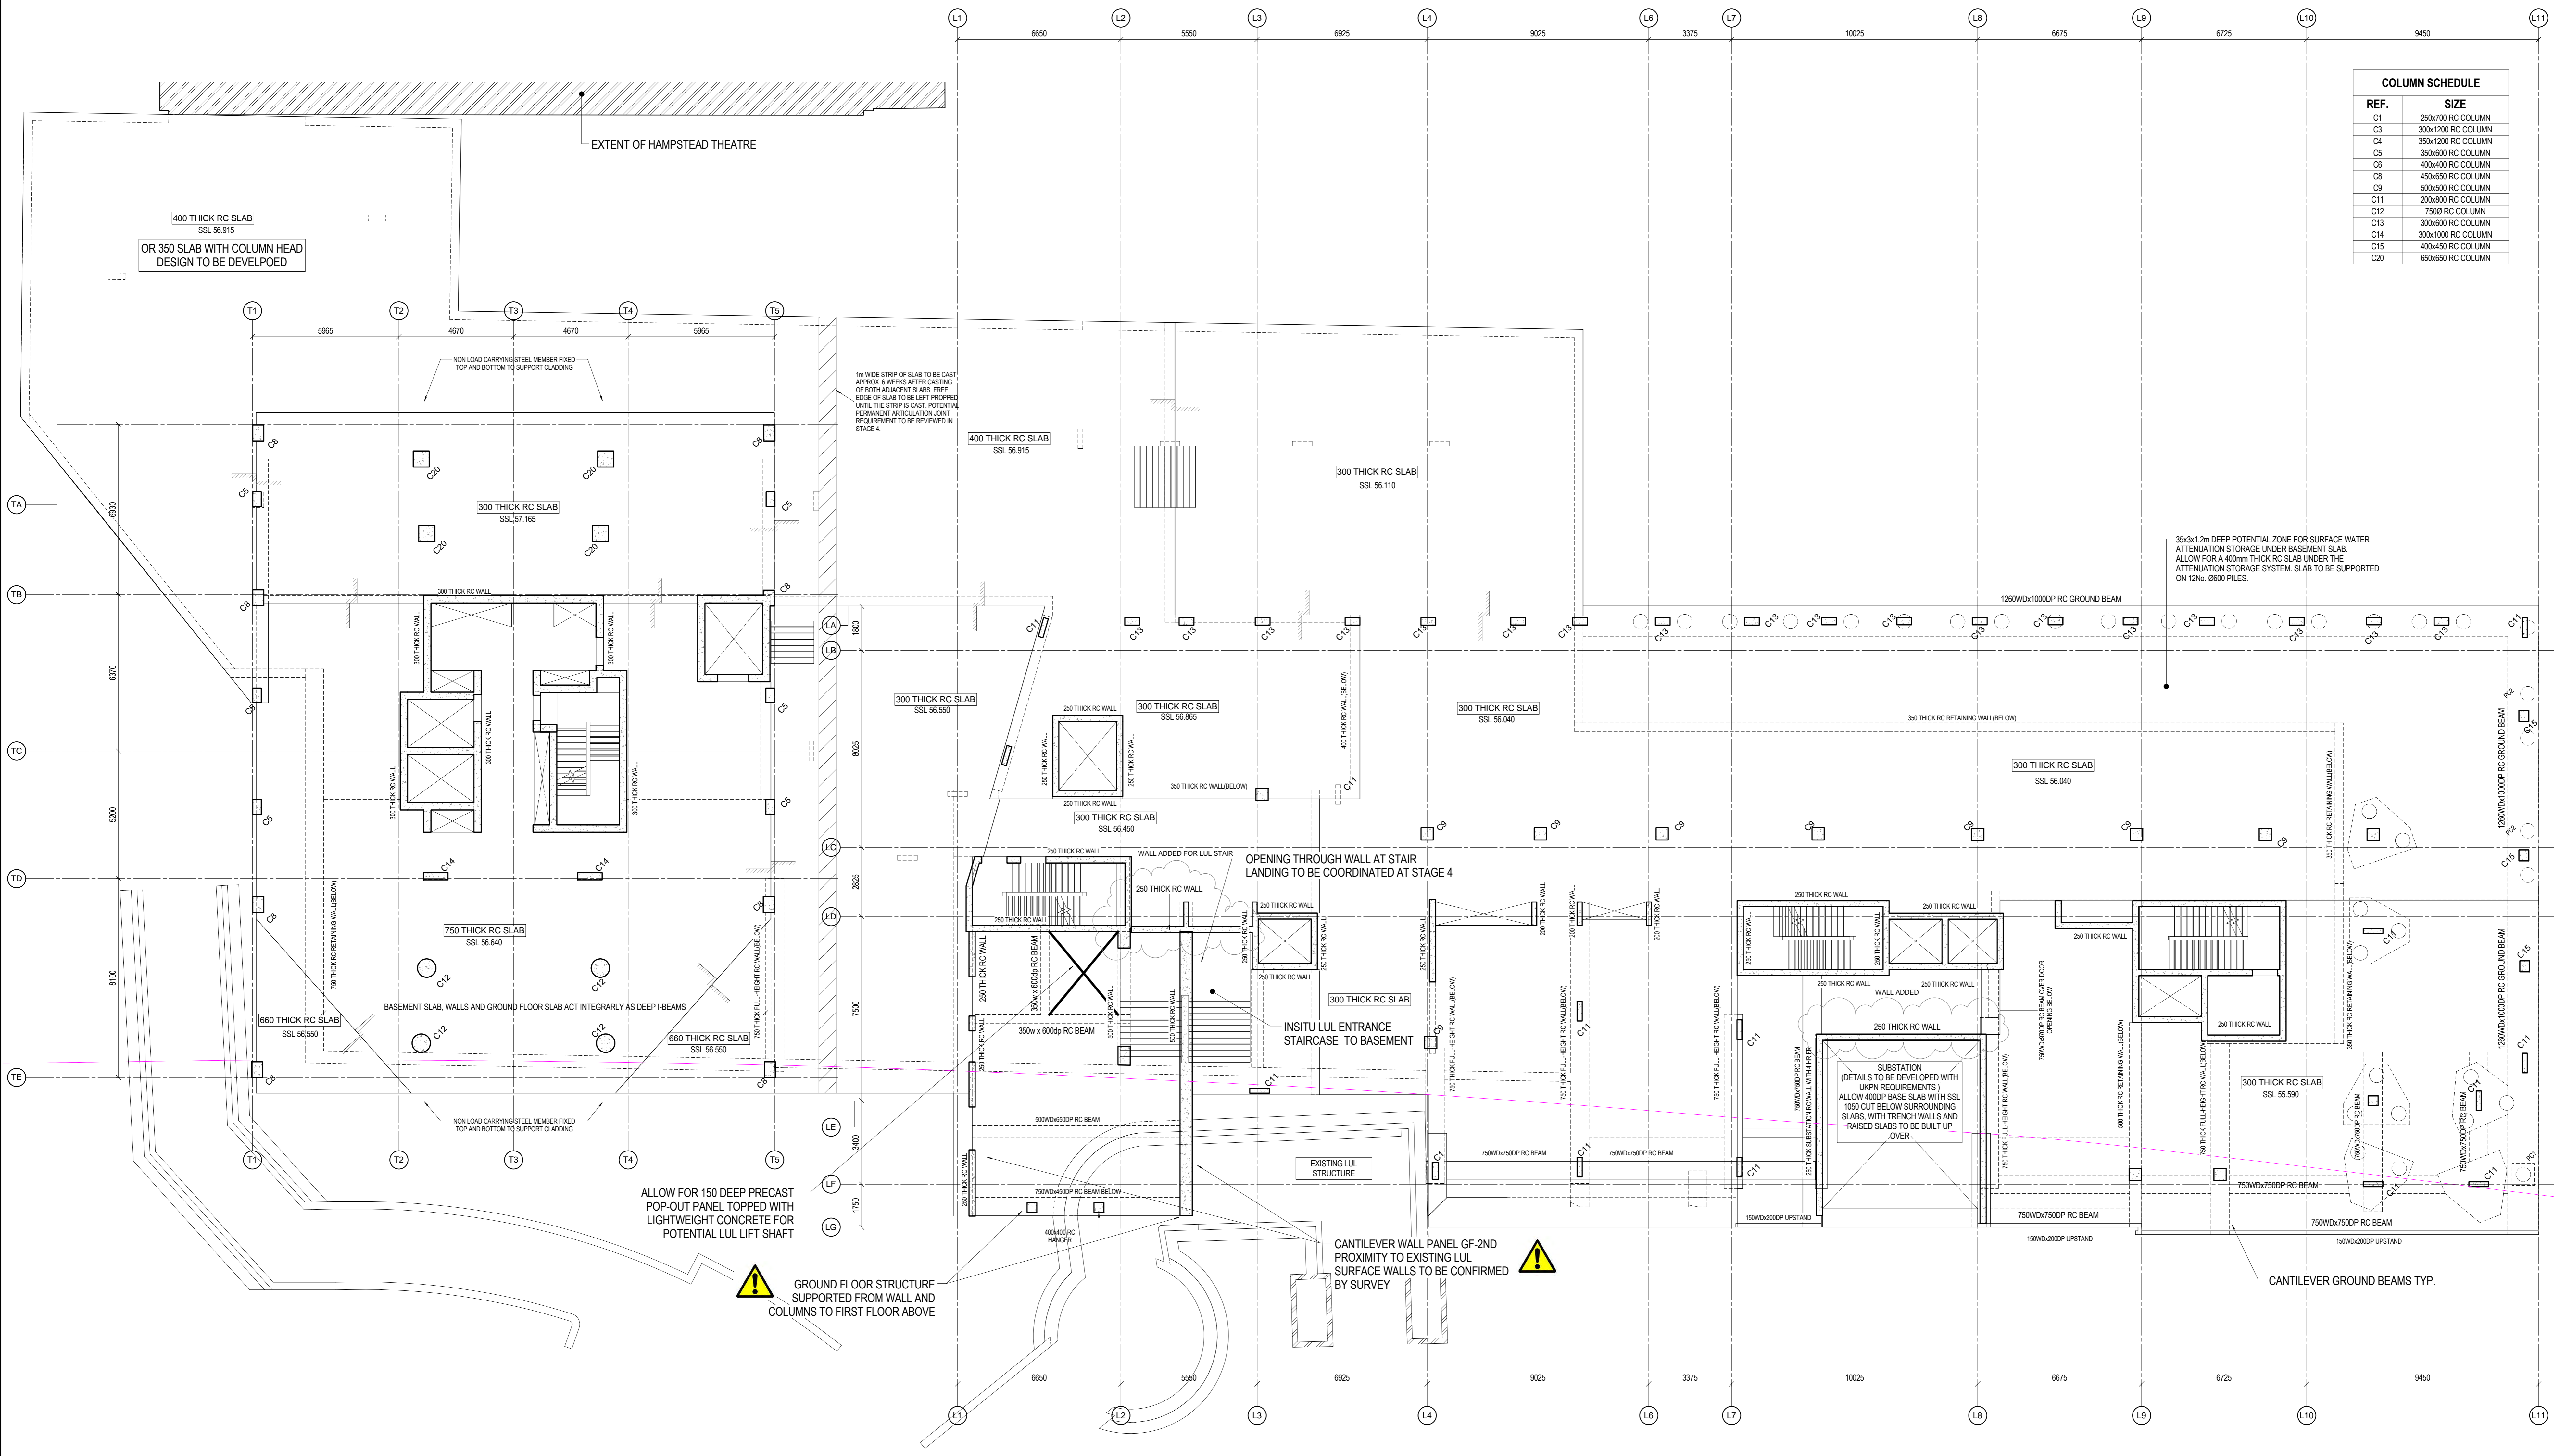

GROUND FLOOR SITE PLAN 1:100

STABILITY OF RETAINED STRUCTURE DURING DEMOLITION AND CONSTRUCTION. TEMPORARY WORKS REQUIRED FOR DEMOLITION TO REMAIN DURING CONSTRUCTION PERIOD

DEEP EXCAVATIONS ADJACENT TO SITE BOUNDARIES AND PUBLIC AREAS. SEE AECOM DRAWINGS SC-ACS-0-S-00500 FOR CONCEPTUAL RECOMMENDATIONS. DETAILED DESIGN AND METHOD STATEMENT TO BE PROVIDED BY THE TEMPORARY WORKS ENGINEER AND CONTRACTOR RESPECTIVELY.

ALL RC WALLS TO BE 300 THICK IN BUILDING A & 250 THICK IN BUILDING B UNLESS NOTED OTHERWISE

NEW STRUCTURE AROUND EXISTING LUL STAIRS WILL HAVE ELEMENTS THAT ARE HUNG FROM STRUCTURE ABOVE. THE CONTRACTOR'S SEQUENCE AND TEMPORARY WORKS DESIGN TO TAKE COGNISANCE OF THIS MATTER. THE BUILDING H&S PLAN TO RECORD THIS STRUCTURAL ARRANGEMENT FOR FUTURE BUILDING WORKS AND EVENTUAL DEMOLITION.

ALL RC WALLS TO BE 300 THICK IN BUILDING A & 250 THICK IN BUILDING B UNLESS NOTED OTHERWISE


ALLOW FOR FLOOR PENETRATIONS IN ACCORDANCE WITH MEP DRAWINGS

ALLOW FOR PERIMETER UPSTANDS TO PERIMETER OF EACH BUILDING

ISSUE/REVISION

NO.	DATE	DESCRIPTION
P1	28/10/16	UPDATED STAGE 3 INFORMATION FOR BASEMENT TENDER
P2	10/11/16	REVISED STAGE 3
P3	30/01/17	STAGE 3
U/R		DATE DESCRIPTION

KEY PLAN

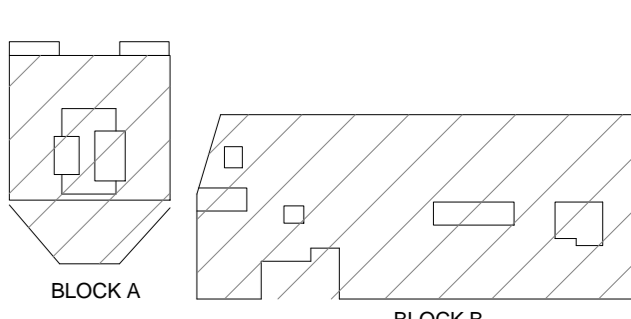

PURPOSE OF ISSUE

STAGE 3

PROJECT NUMBER

47066169

SHEET TITLE

GROUND FLOOR SITE PLAN

SHEET NUMBER

SC-ACS-0-S-03040

SCALE: 1:100@A0

REV: P4