


DO NOT SCALE FROM THIS DRAWING.  
ALL DIMENSIONS TO BE CHECKED ON SITE.


**NOTES:**

1. Drawings to be read in conjunction with Structural Engineers information.
2. Drawings to be read in conjunction with information from specialist sub-contractors for facade panels and glazing systems.
3. For 'hidden' terrace elevations refer to drawings BD4122 - A - 20-305 and 20-442.

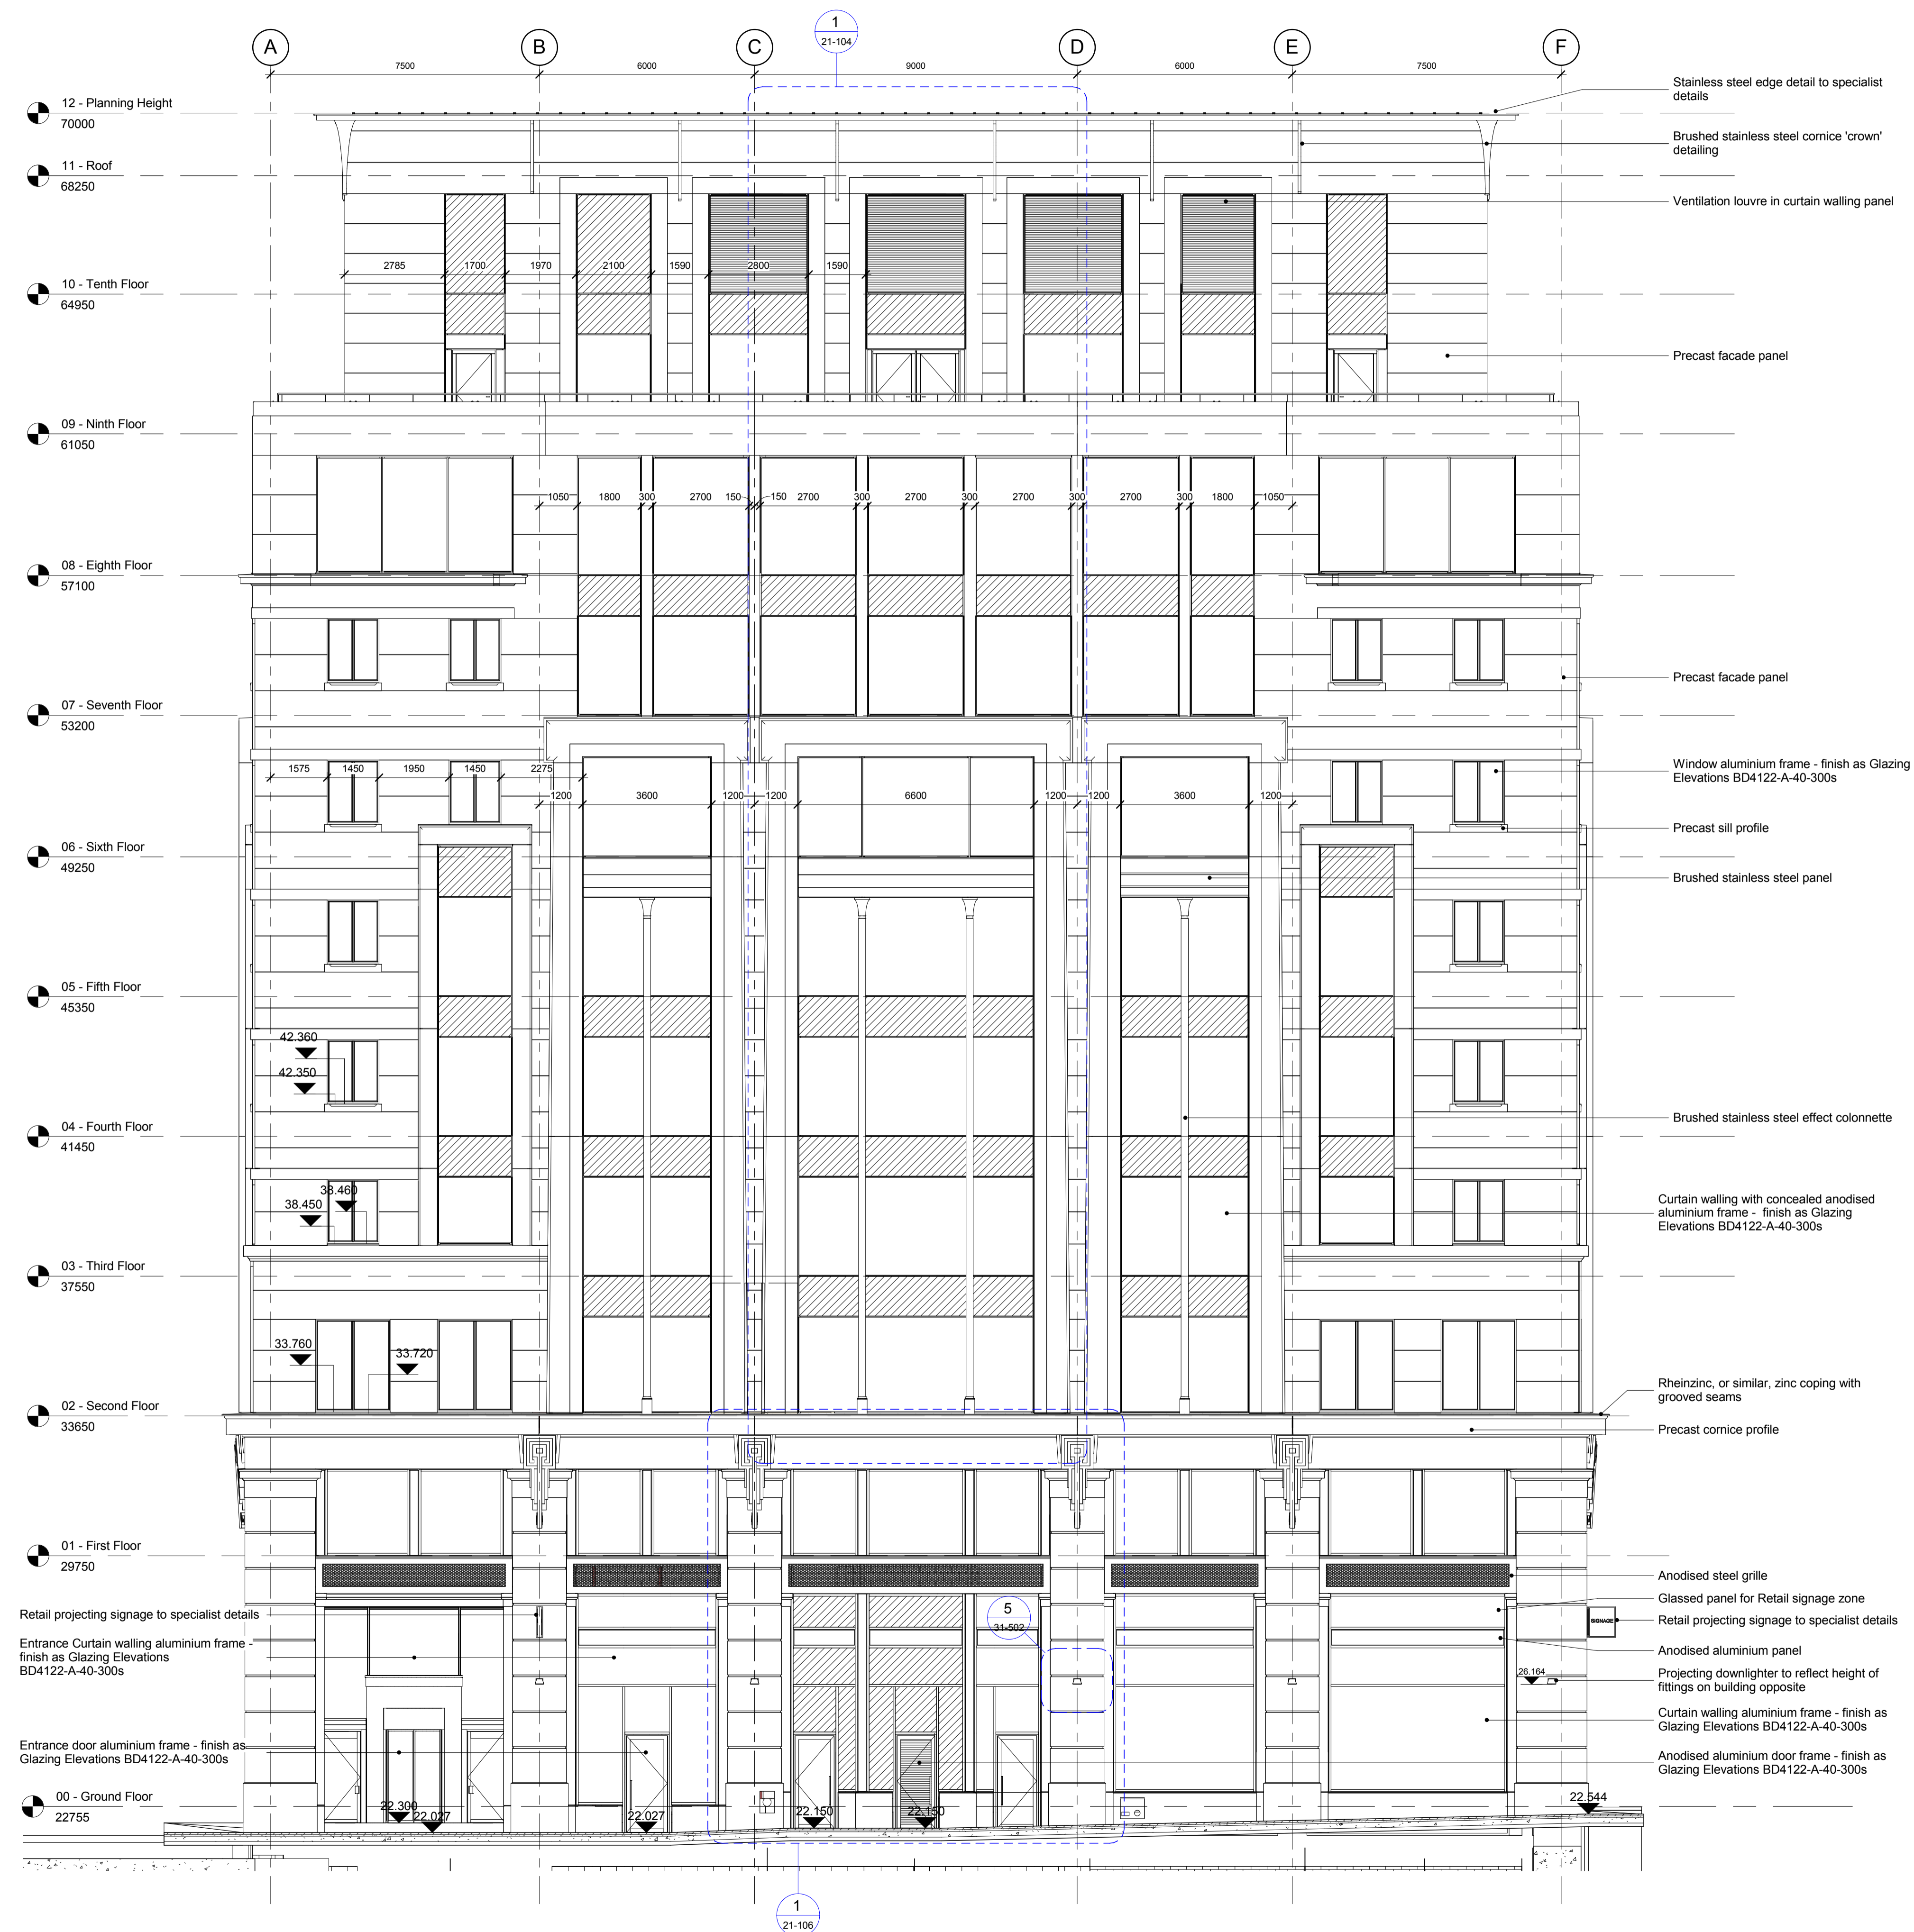

**RECORD DRAWING**  
This Record Drawing is based upon the last revision of the Construction Drawing. It is not based upon an As-Built survey and may therefore not be an accurate record of the completed works.

rev	by	date	chkd	amendments
004	IAW	25.02.16	IAW	RECORD DRAWING ISSUE

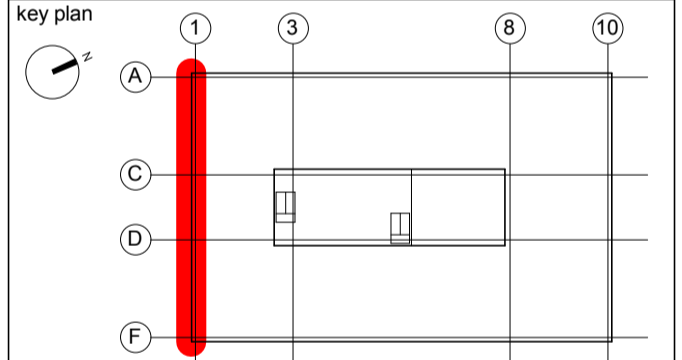

**BAM Design Ltd**  
An operating company of  
BAM Construct UK Ltd  
Architecture  
Structural Engineering  
Environmental Services  
Interior Design  
Feasibility Studies  
3D Visualisation  
Building Information Modelling  
Centrum Business Park  
Griffins Way, St Albans  
Hertfordshire, AL1 2SD  
T 01727 894200  
E design@bam.co.uk  
W www.bam.co.uk

project  
**KINGS CROSS ZONE B  
3 PANCRAS SQUARE**  
title  
**GA Elevation - South**

drawing title		drawing no.	
RECORD DRAWING		BD4122	A
contract no.	scale	date	rev
—	As indicated @ A1	09/02/14	004
client ref.	date	drawn by	checked by
KXC-B6-001	09/02/14	KD	JC
drawing no.	sheet	drawing no.	sheet
BD4122	A	20-202	004

Former Drawing Number: 20-303