


**BASEMENT**  
Gross Area: 1,249 sq.ft.


**PAKENHAM ARMS,  
1 PAKENHAM STREET,  
LONDON WC1X 0LA**

**BASEMENT PLAN  
AS BUILT**

**BRILL ■ OWEN**  
*CHARTERED ARCHITECTS*  
Grove House, 2B Lichfield Grove, London N3 2JP  
Telephone: 020 8349 0037 Fax: 020 8349 0092  
E-mail: architects@brillowen.co.uk

SCALE 1:50@A3	
DATE Jun 15	DRAWN SCM
DRG.NO. 13/808/C11	

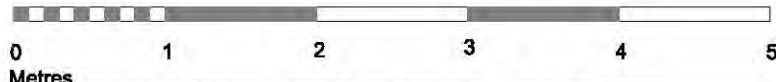


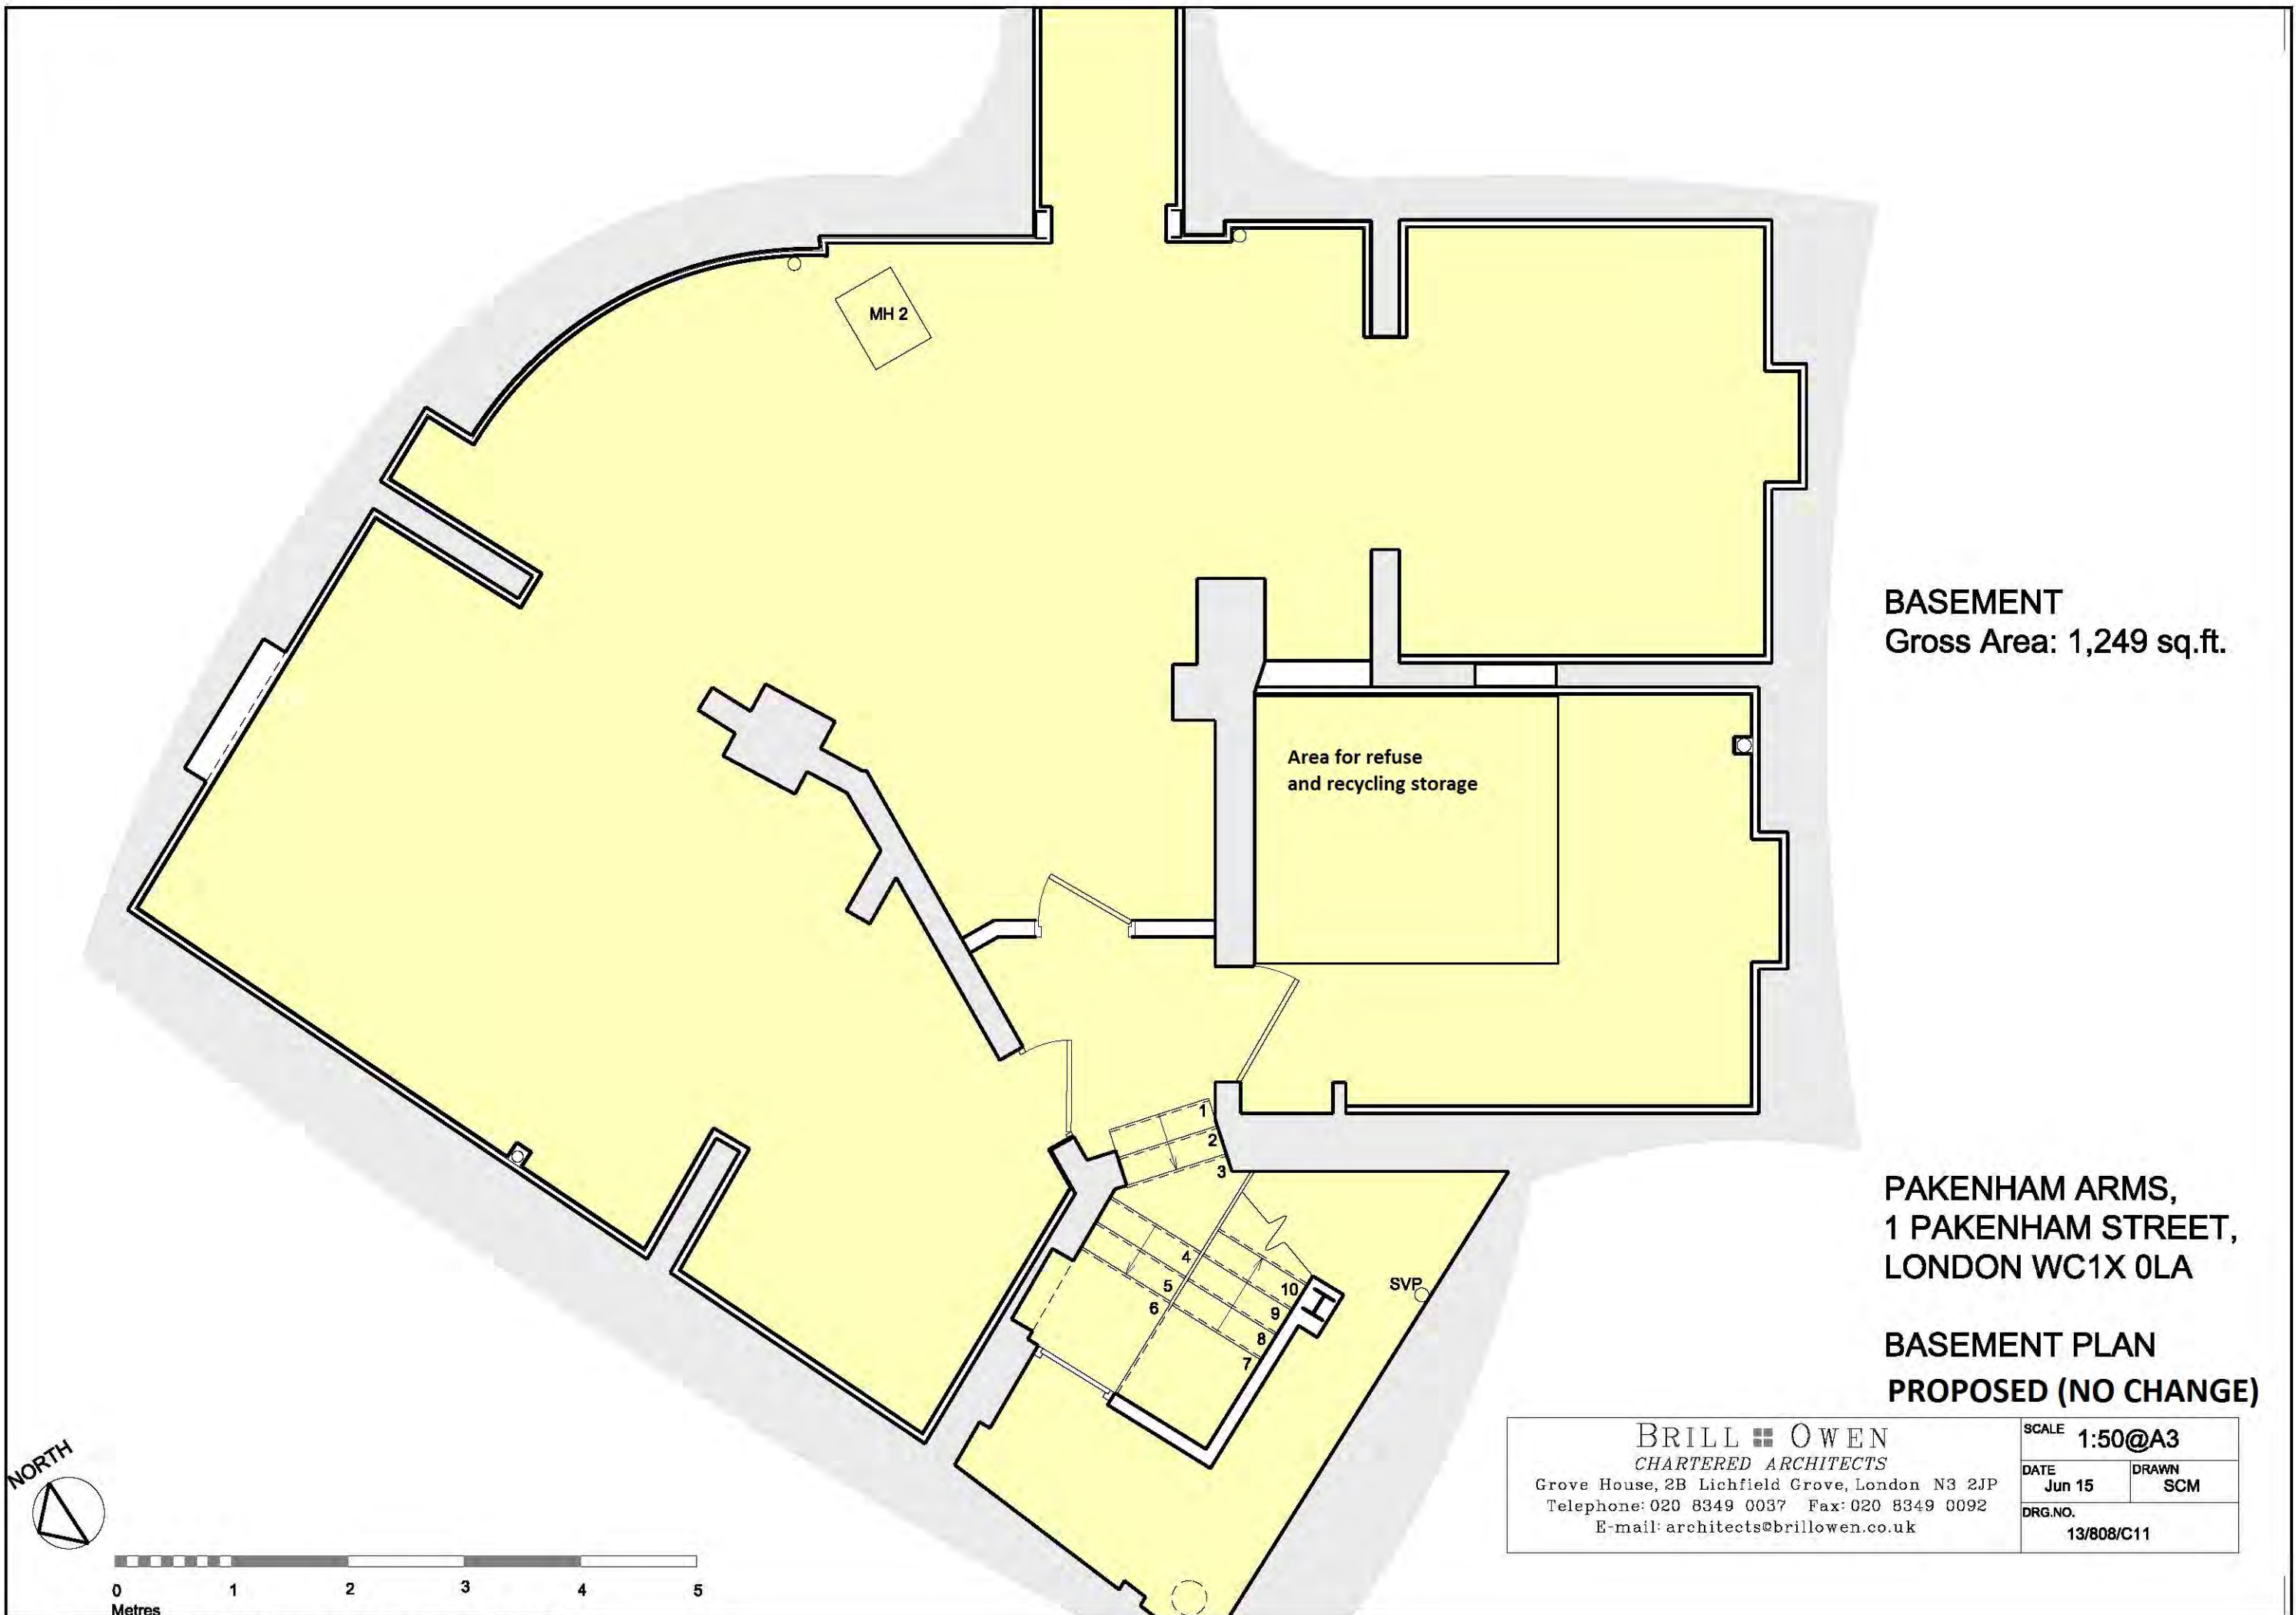


**BASEMENT**  
Gross Area: 1,249 sq.ft.


**PAKENHAM ARMS,  
1 PAKENHAM STREET,  
LONDON WC1X 0LA**

**BASEMENT PLAN  
PROPOSED (NO CHANGE)**

BRILL ■ OWEN CHARTERED ARCHITECTS Grove House, 2B Lichfield Grove, London N3 2JP Telephone: 020 8349 0037 Fax: 020 8349 0092 E-mail: architects@brillowen.co.uk		SCALE 1:50@A3	
DATE	Jun 15	DRAWN	SCM
DRG.NO.	13/808/C11		

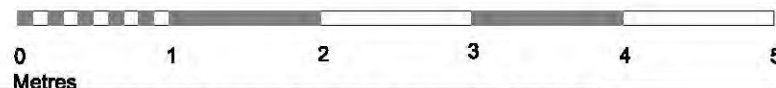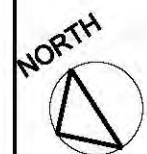



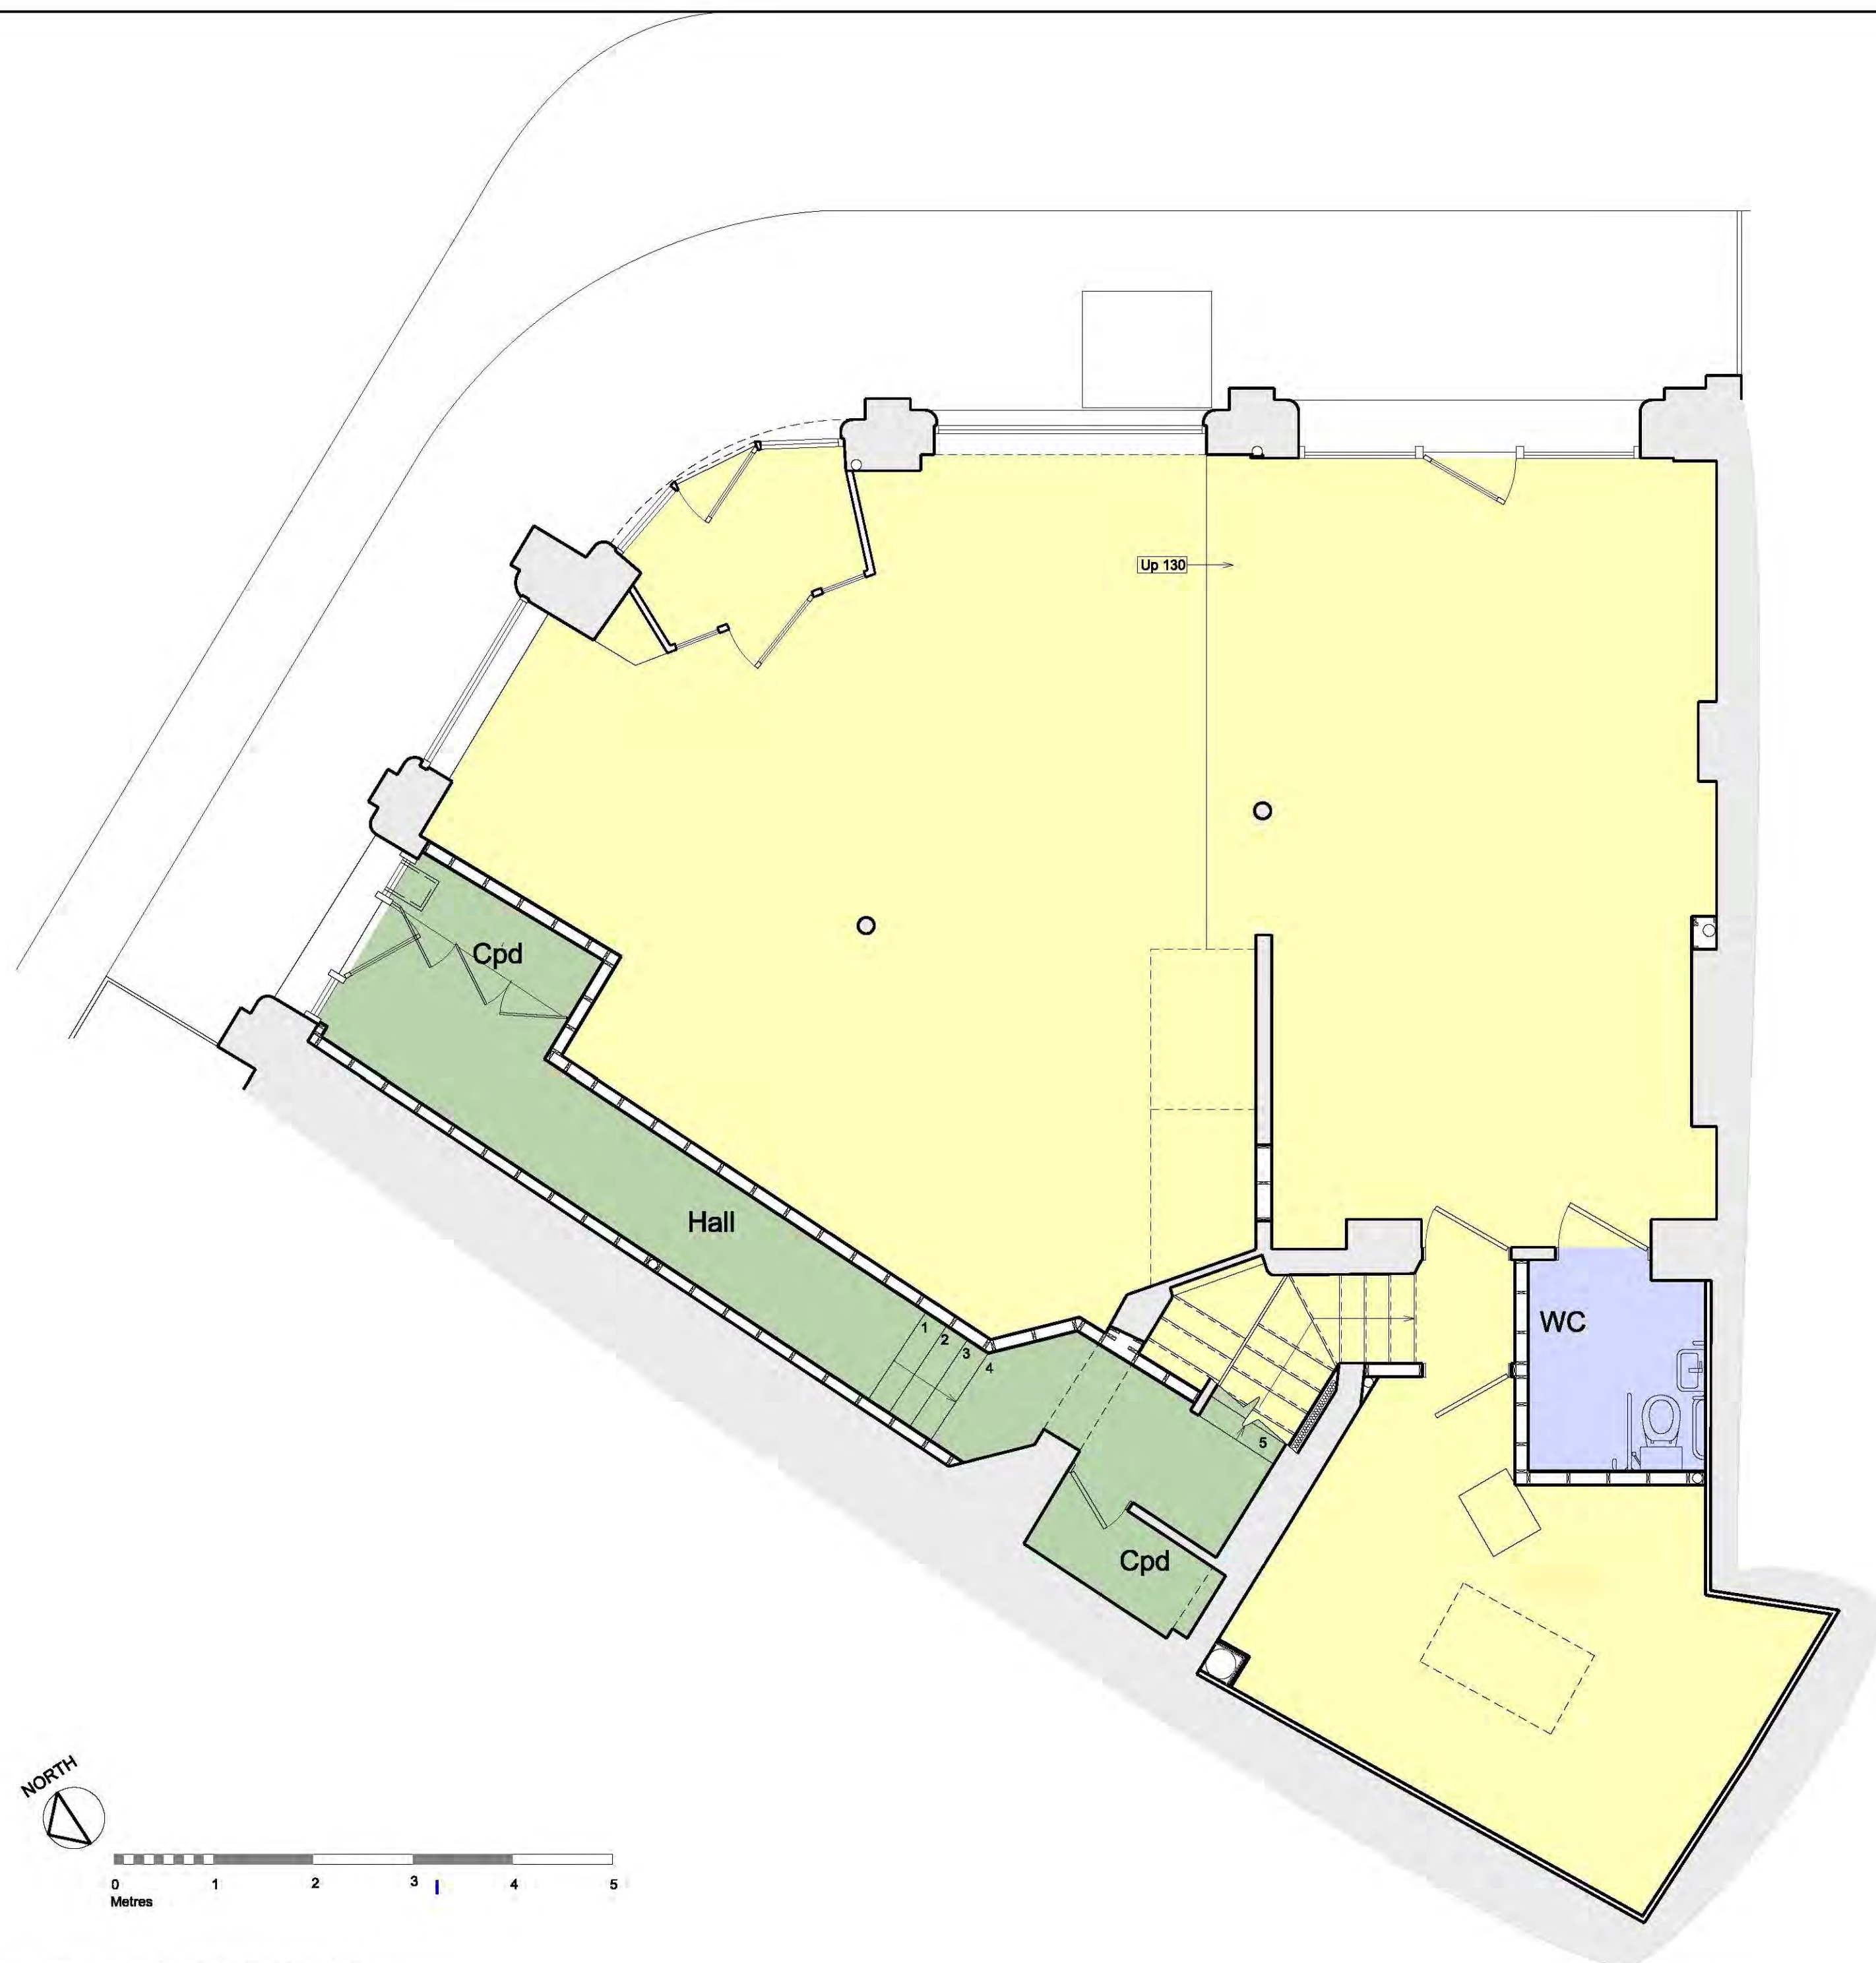

BASEMENT:  
Gross Area: 1,249 sq. ft.

GROUND FLOOR:  
Gross Area: 1,496 sq. ft.  
Commercial Unit: 1,249 sq. ft.


PAKENHAM ARMS,  
1 PAKENHAM STREET,  
LONDON WC1X 0LA

GROUND FLOOR PLAN  
AS BUILT

BRILL ■ OWEN  
CHARTERED ARCHITECTS  
Grove House, 2B Lichfield Grove, London N3 2JP  
Telephone: 020 8349 0037 Fax: 020 8349 0092  
E-mail: architects@brillowen.co.uk

SCALE	1:50 @ A2
DATE	JUN 15
DRAWN	SCM
DRG. NO.	13/808/C12



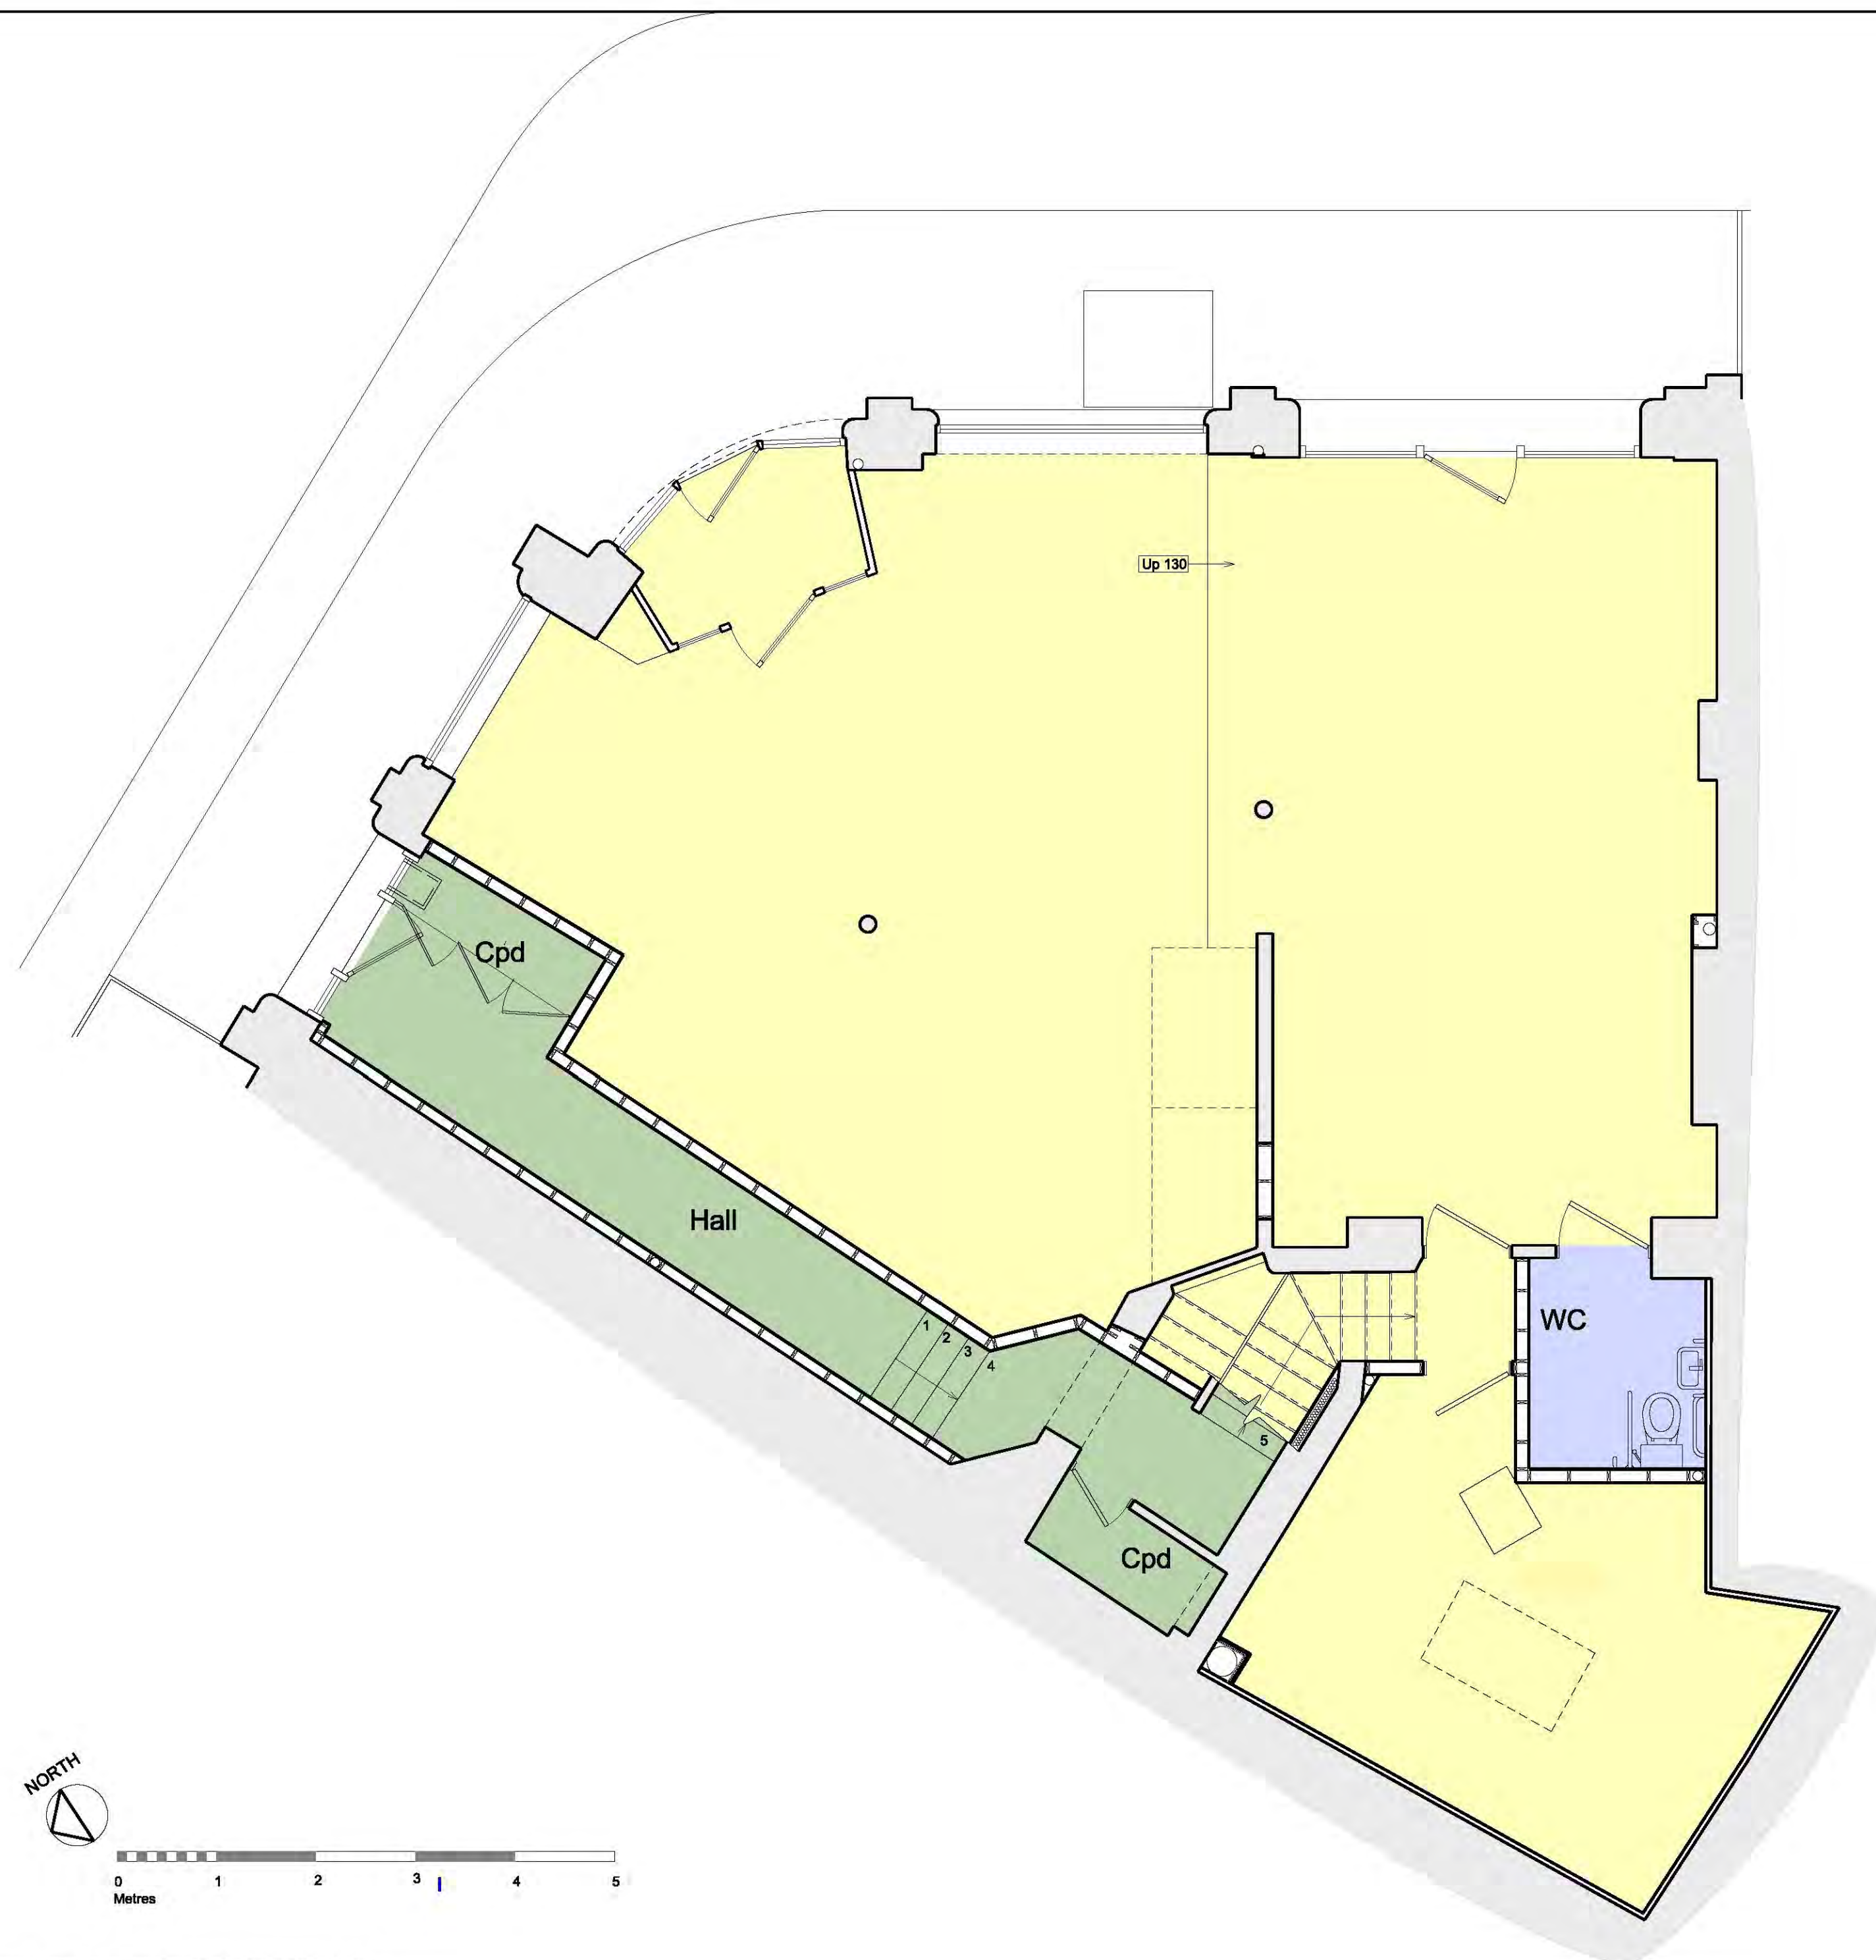

BASEMENT:  
Gross Area: 1,249 sq. ft.

GROUND FLOOR:  
Gross Area: 1,496 sq. ft.  
Commercial Unit: 1,249 sq. ft.

PAKENHAM ARMS,  
1 PAKENHAM STREET,  
LONDON WC1X 0LA

GROUND FLOOR PLAN  
AS PROPOSED (NO CHANGE)

BRILL ■ OWEN CHARTERED ARCHITECTS Grove House, 2B Lichfield Grove, London N3 2JP Telephone: 020 8349 0037 Fax: 020 8349 0092 E-mail: architects@brillowen.co.uk		SCALE 1:50 @ A2
DATE Jun 15	DRAWN SCM	DRG. NO. 13/808/C12