




General Notes:

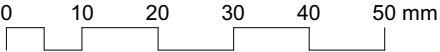

Paper Scale

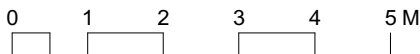

Drawing Scale

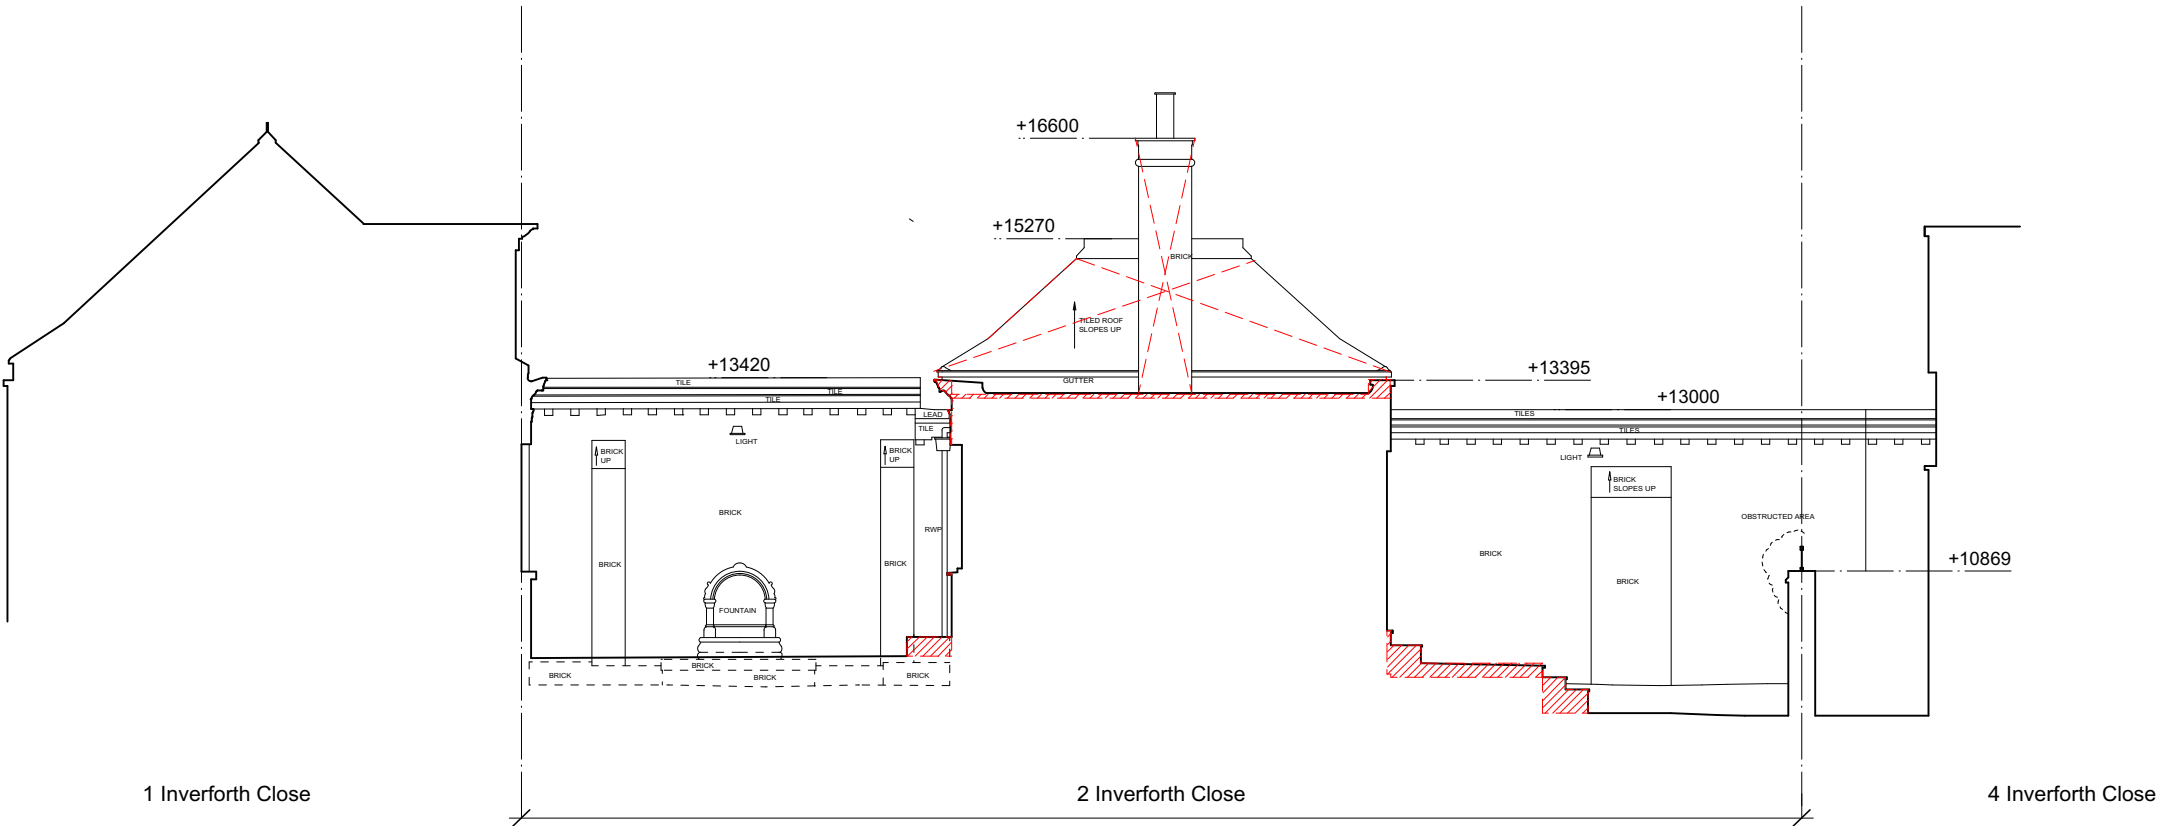

REV A: 02/11/16 Scheme Revised for Planning

No. Date. Revision.

PLANNING

Client. Mr and Mrs Shah

Project. 2 Inverforth Close NW3

Title. Existing Courtyard North Elevation
Demolitions Indicated in RED

Date. June 2016

Drawn By. DR Checked By.

Scale. 1:100 @ A3

Do not scale from this drawing.

Drawing No. FP118_PL010
Revision. A

Found Property Ltd
14-16 Great Pulteney St, London W1F 9ND
Phone +44 (0)20 7734 8400
Fax +44 (0)20 7734 7400

Found.

1 Existing Courtyard North Elevation
Scale: 1:100

