




General Notes:

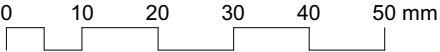

Paper Scale

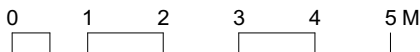

Drawing Scale

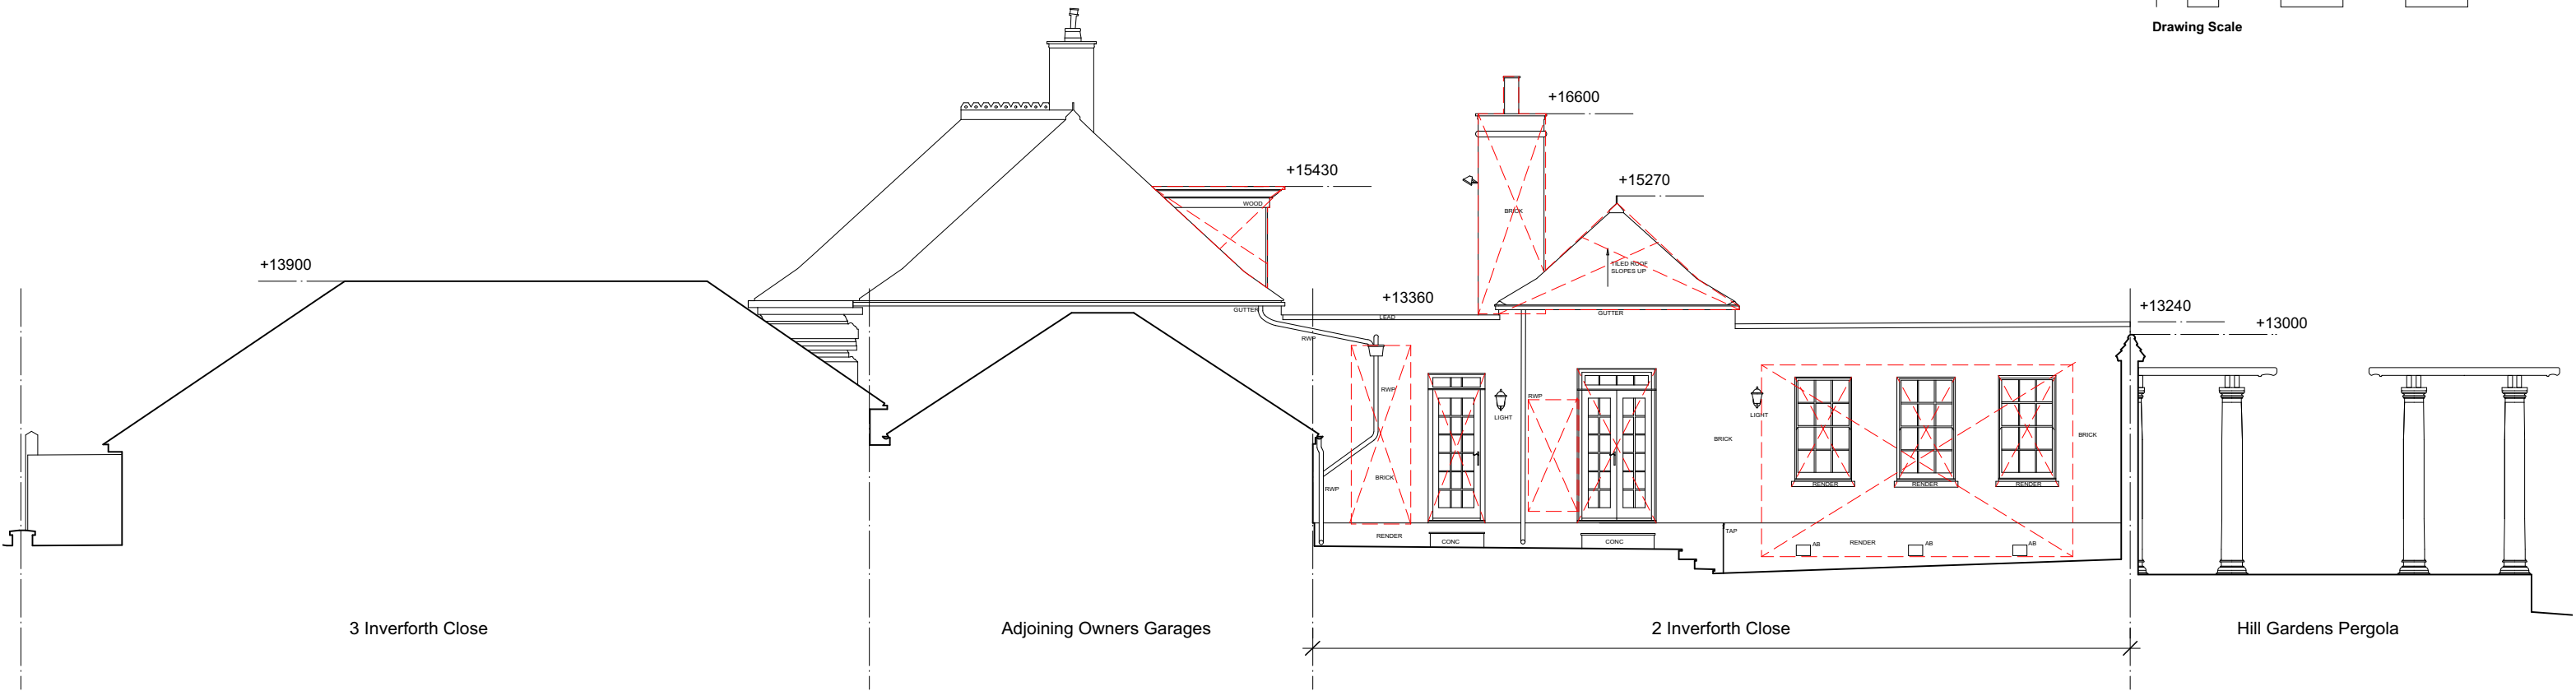

2

Existing Garden West Elevation  
Scale: 1:100

REV A: 02/11/16 Scheme Revised for Planning

No. Date. Revision.

PLANNING

Client. Mr and Mrs Shah

Project. 2 Inverforth Close NW3

Title. Existing Garden West Elevation  
Demolitions Indicated in RED

Date. June 2016


Drawn By. DR Checked By.

Scale. 1:100 @ A3

Do not scale from this drawing.

Drawing No. FP118\_PL011  
Revision. A

Found Property Ltd  
14-16 Great Pulteney St, London W1F 9ND  
Phone +44 (0)20 7734 8400  
Fax +44 (0)20 7734 7400

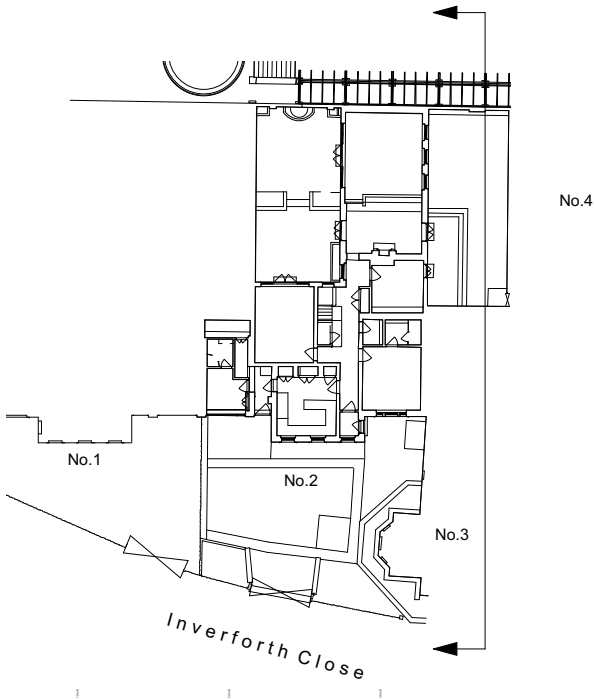

Found.