





SOUTH ELEVATION




WEST ELEVATION

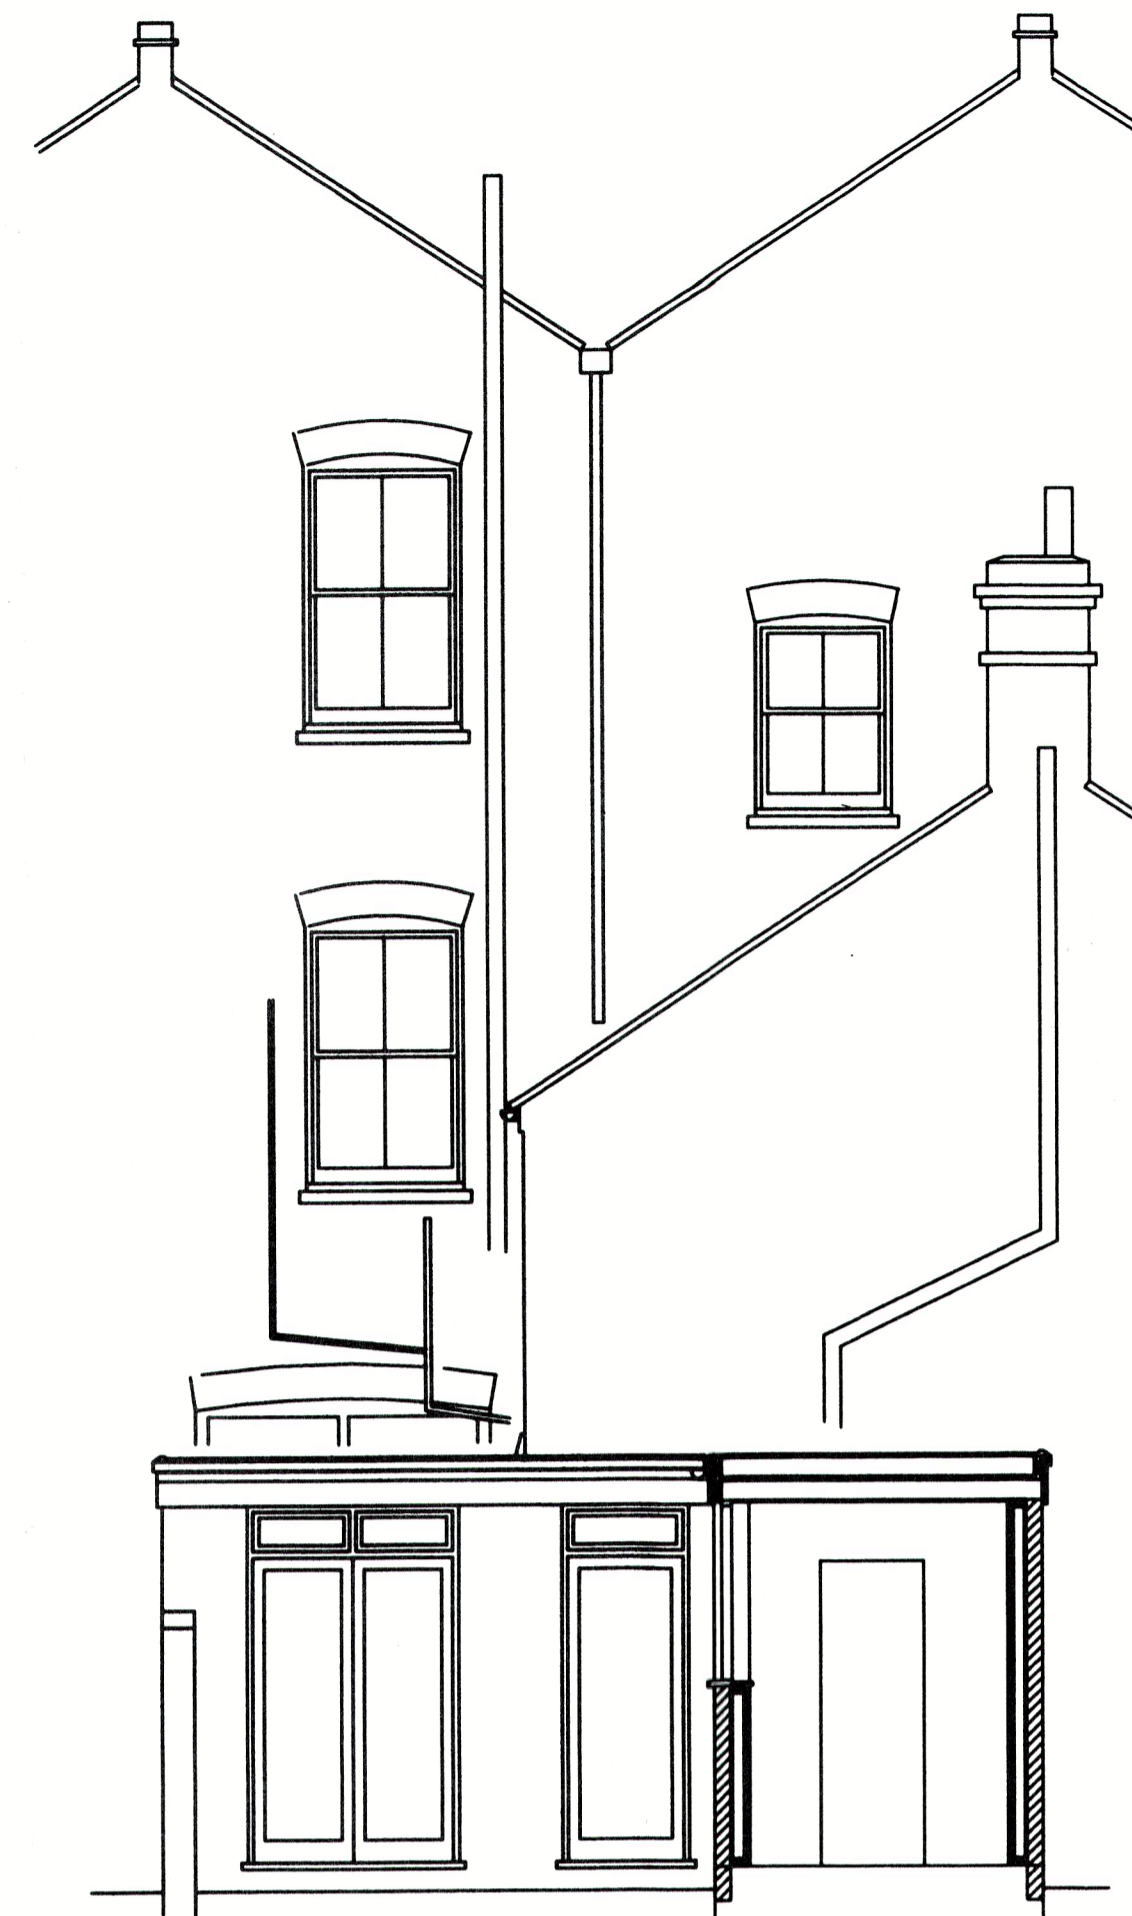


SECTION A-A

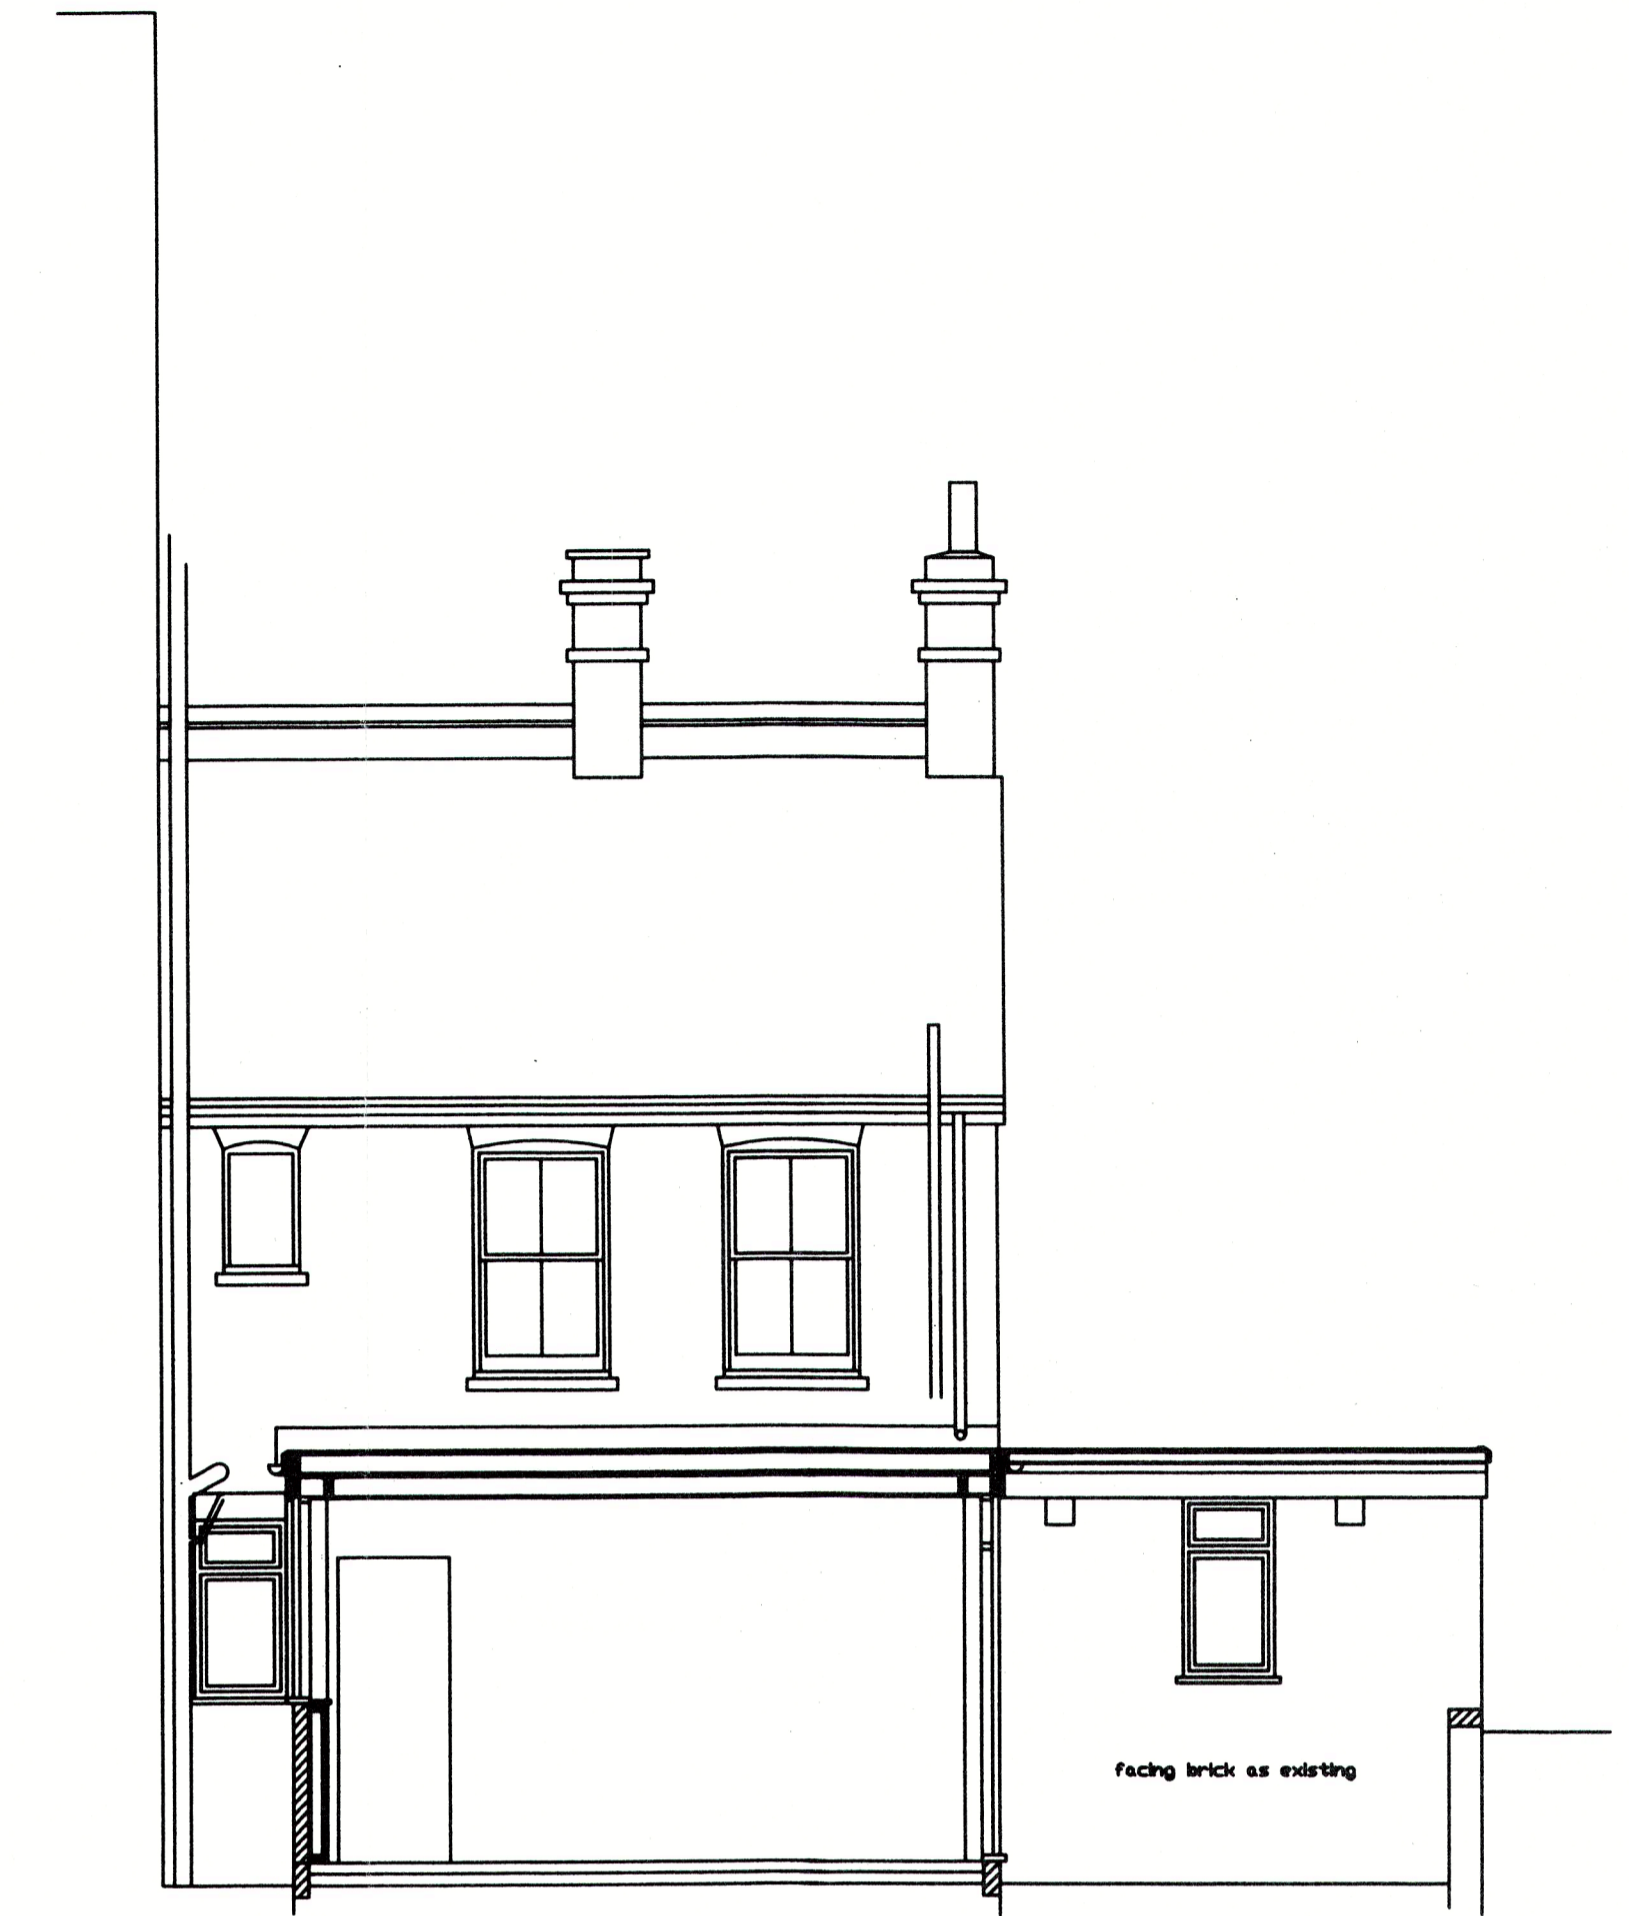

SECTION B-B

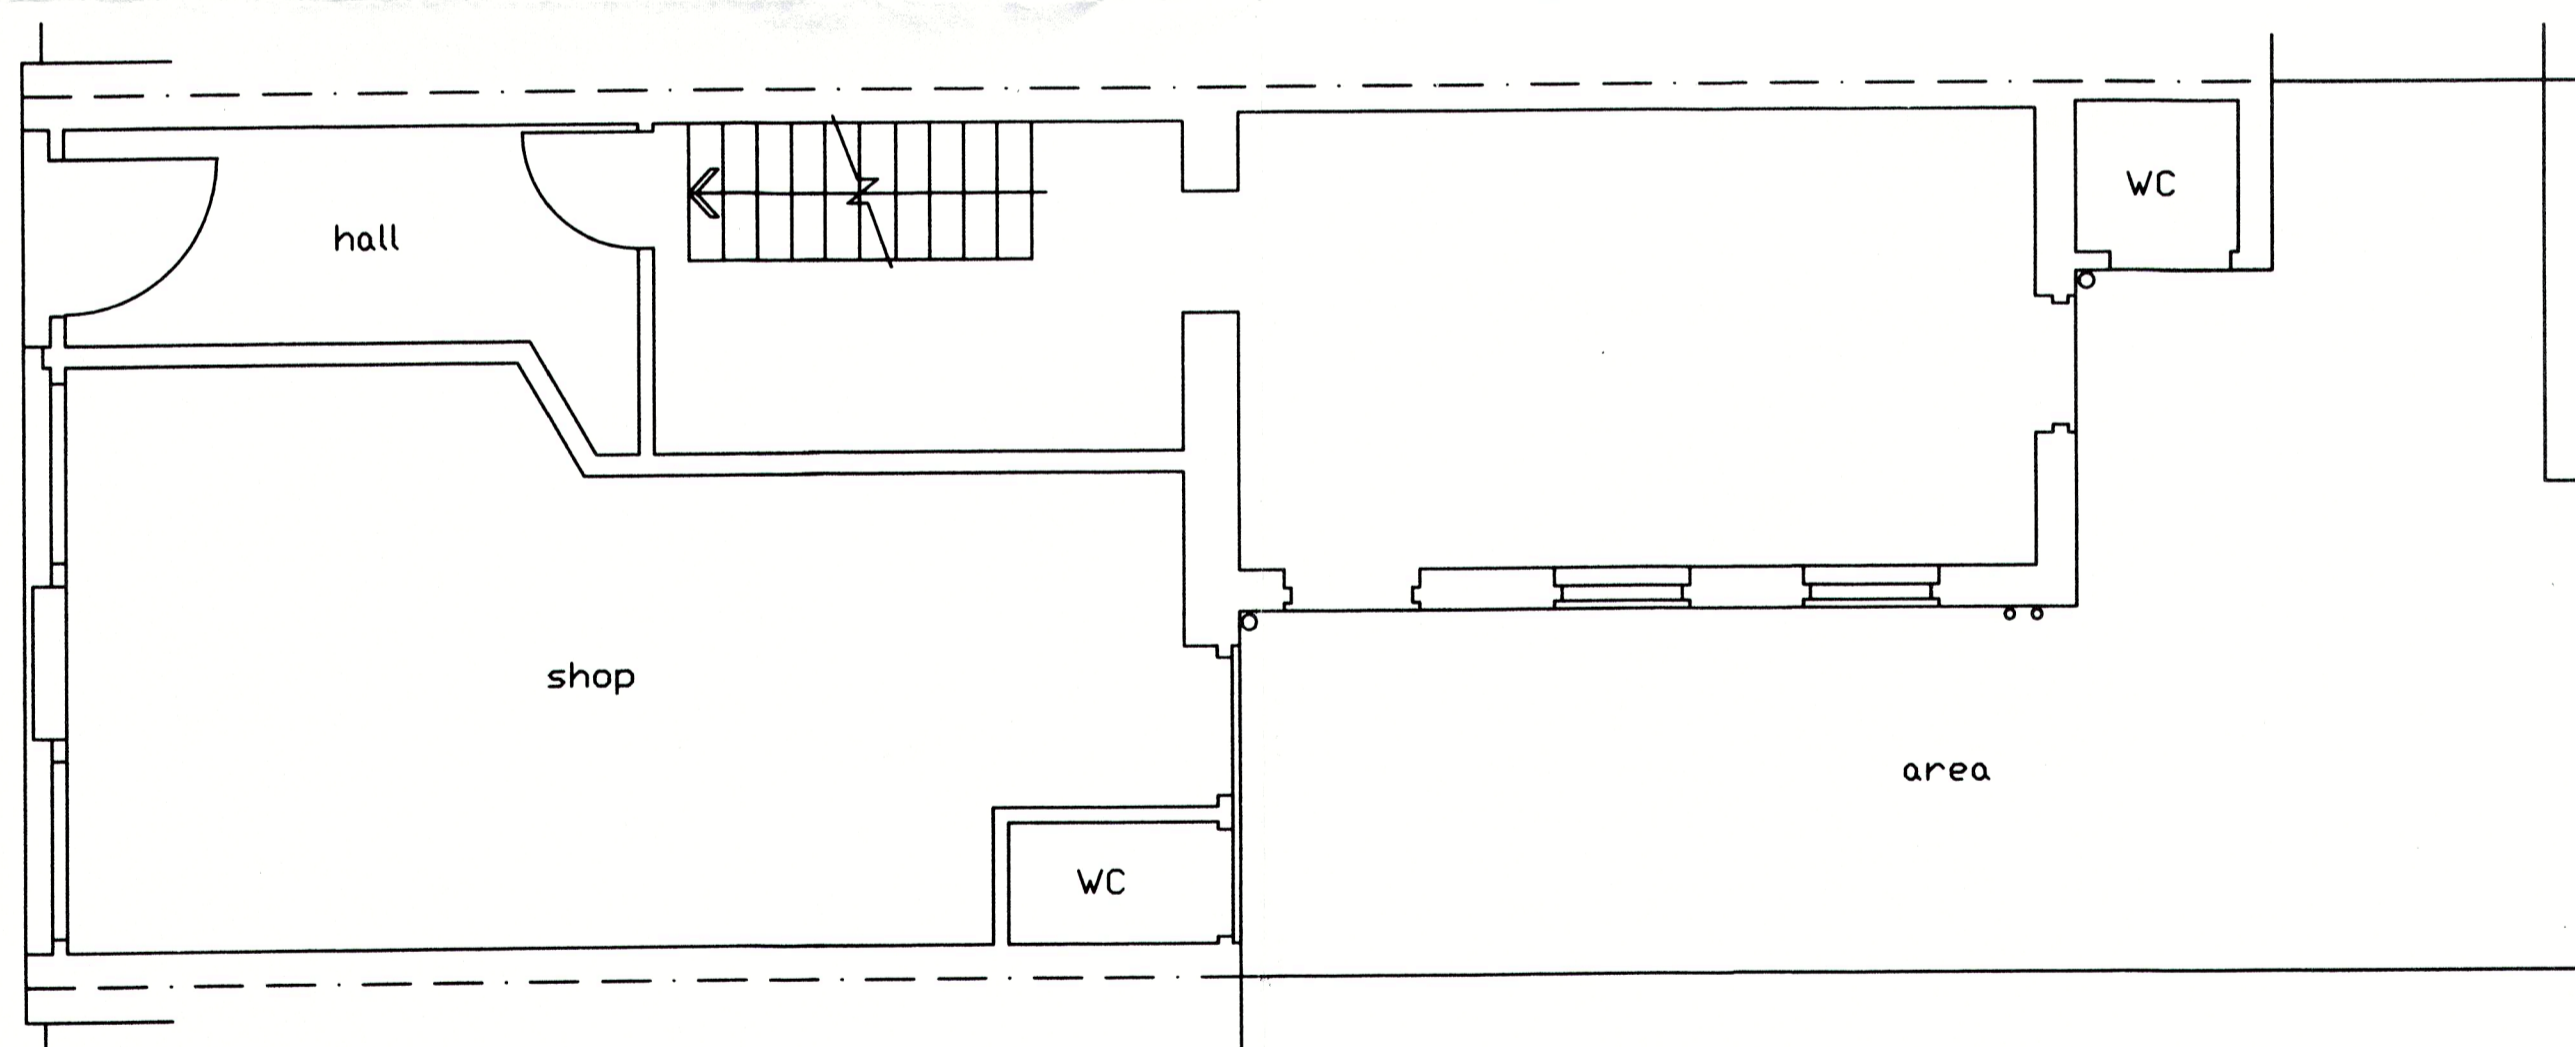

GROUND FLOOR PLAN as existing

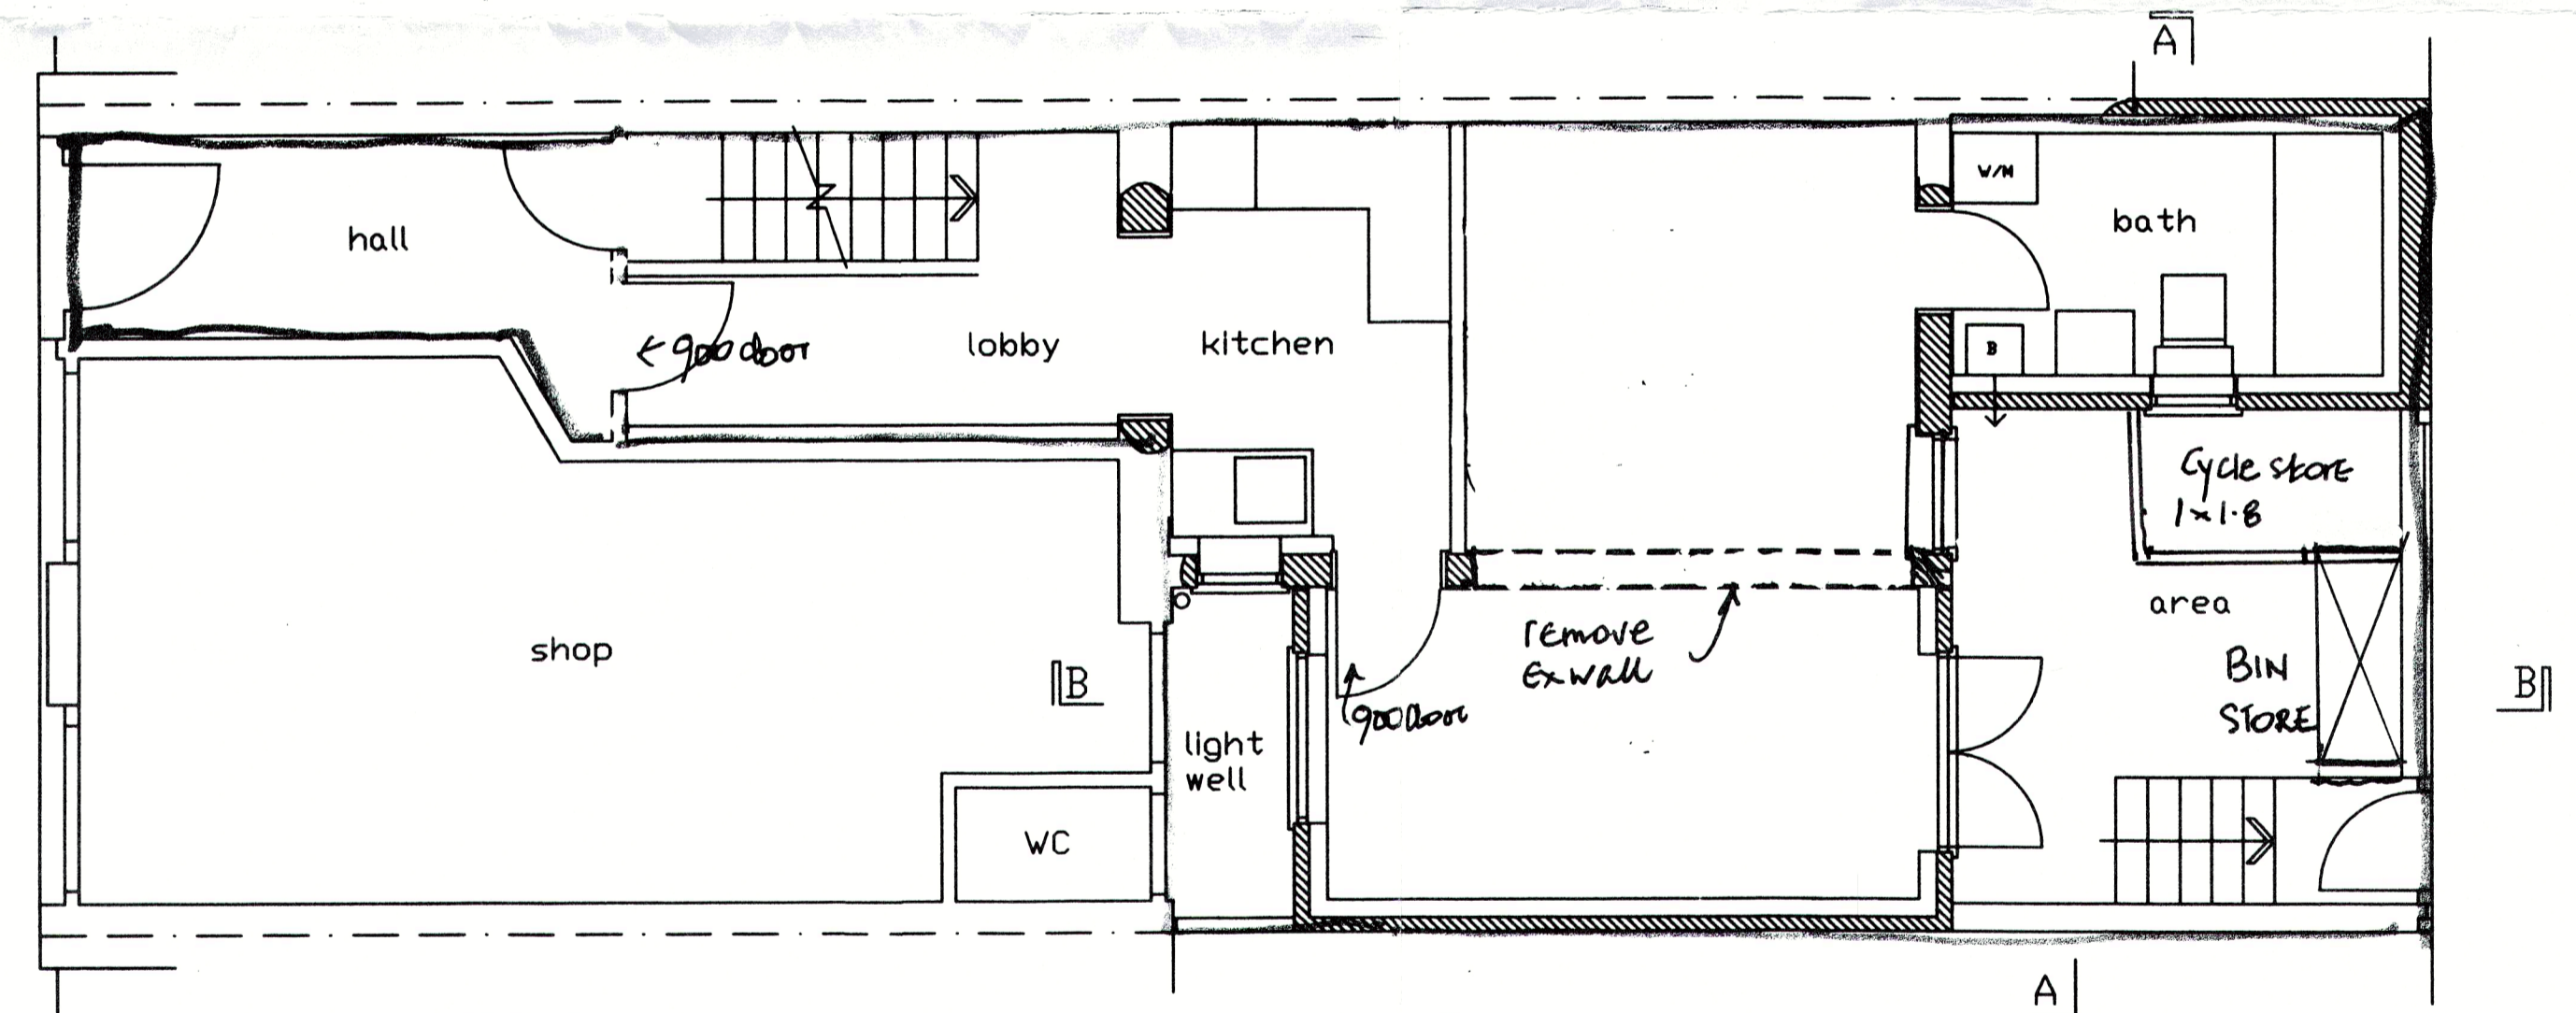

GROUND FLOOR PLAN as proposed

STUDIO FLAT

REV D Jan 2017
 Cycle store added.
 REV C. Sept 2016
 Bin store added
 REV B Sept 2016
 2 WD doors omitted
 Red line extended.
 2ND 900 doors

REV A July 2016
 Studio flat created
 in lieu of 2 rooms.

DO NOT SCALE THIS DRAWING		
67 MILL LANE, W.HAMPSTEAD, LONDON, NW6 1NB.		
for Mr. Dante Mody		
Proposed alterations to form a Ground Floor flat		
Scale: 1:50	Date: Feb. 2016	Drawn: pb
ERDI & RABSON ARCHITECTS & SURVEYORS STUDIO 1 16 BROADFIELDS AVENUE EDGWARE MIDDX. HAB 8PG. tel: 020 8958 2851		
Drwg No.	1154-01 D	