

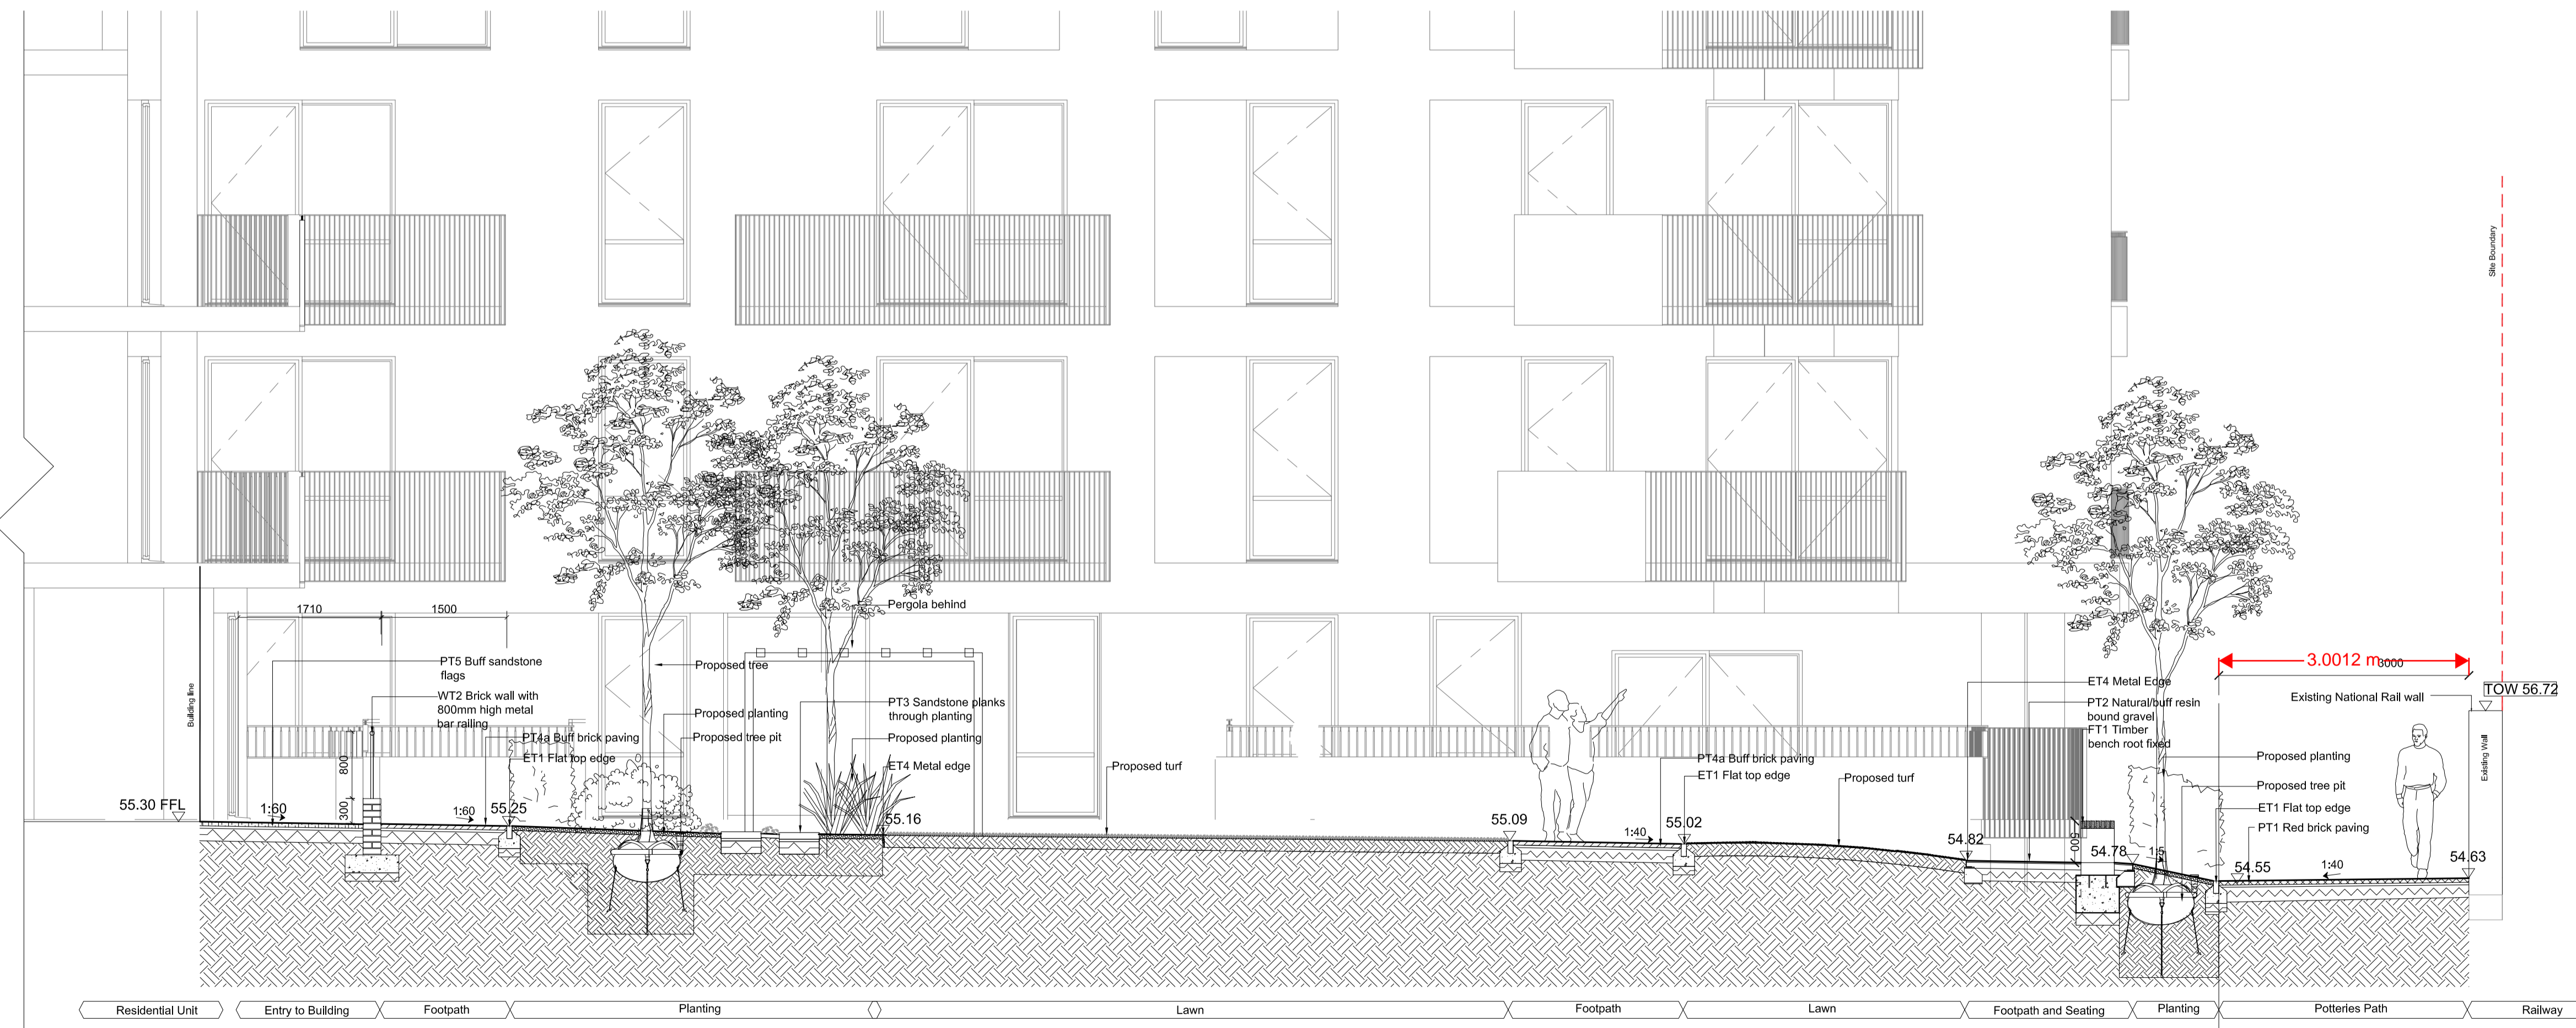
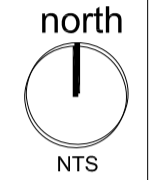


A
L.400
SECTION A-A
SCALE 1:50@A1

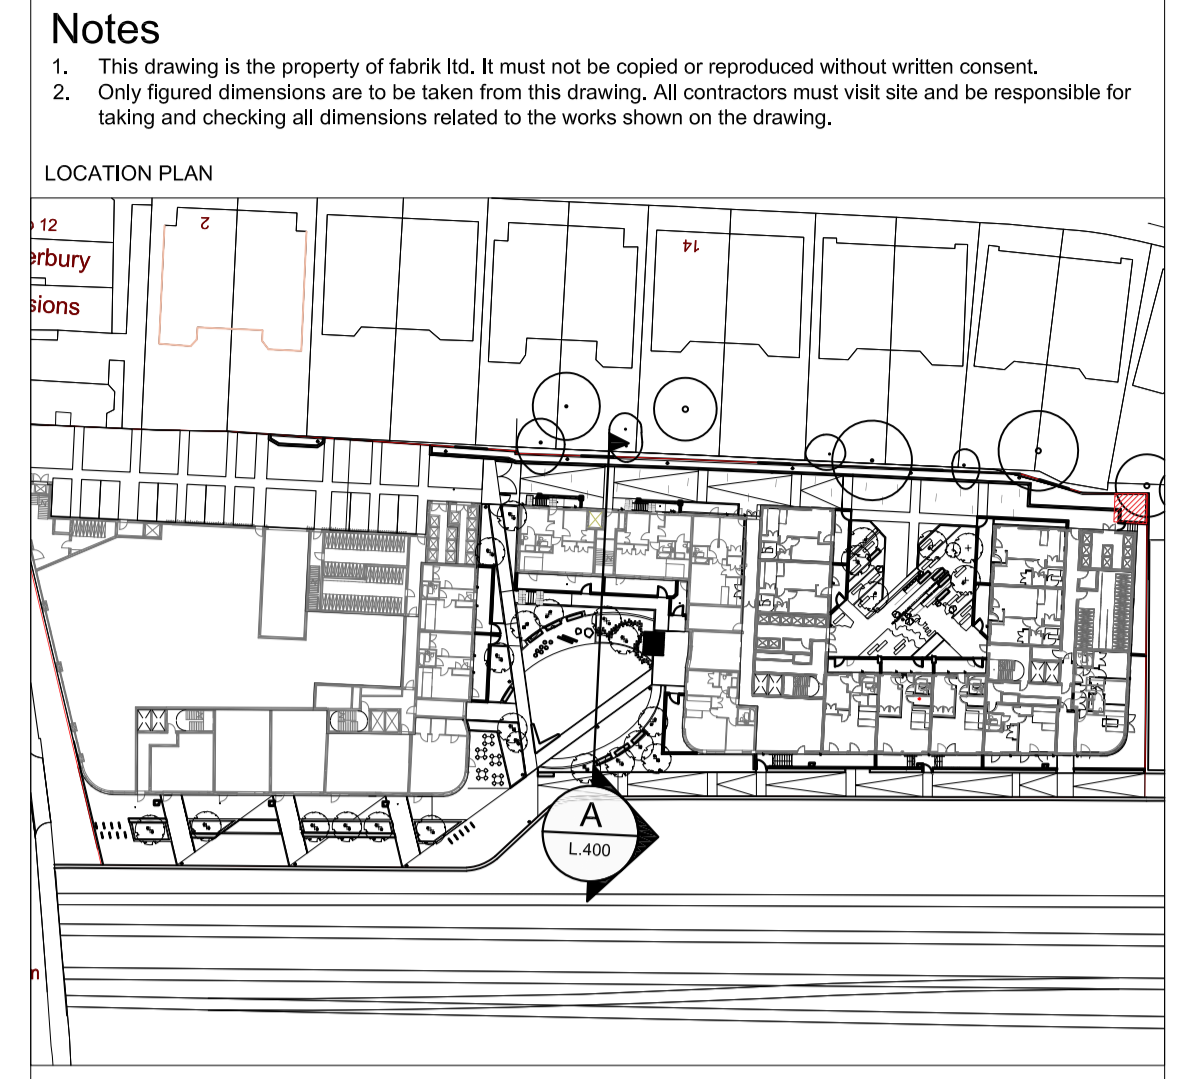

A
L.400
SECTION A-A (continued)
SCALE 1:50@A1

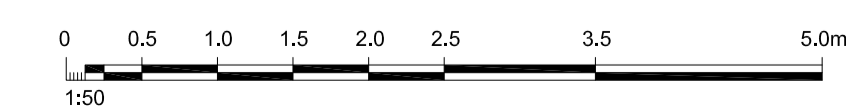

Notes

- This drawing is the property of fabrik ltd. It must not be copied or reproduced without written consent.
- Only figured dimensions are to be taken from this drawing. All contractors must visit site and be responsible for taking and checking all dimensions related to the works shown on the drawing.

No.	Date	Reason	Drawn	Checked
D	17.11.16	Issued for revised planning - Potteries path width amended	CB	CB
C	26.05.16	Issued for revised planning	LM	CB
B	23.05.16	Updates to lower ground courtyard and shared road flat entrances, & issued for planning re-submission	LM	CB
A	13.11.15	Amended in accordance with architect's comments	AB	CB

External References:

fabrik

First Floor
4-8 Emerson Street
London
SE1 9DU

T: 0207 620 1453
E: london@fabrikuk.com
W: www.fabrikuk.com

Project
156 West End Lane, West Hampstead
For A2 Dominion Developments Limited

Drawing
Section A-A Central Courtyard

Scale	Date	Checked	Drawn
1:50 @ A1	Nov '15	CB	AB

Drawing No. **D2313 L.400** Revision **D**

<input type="checkbox"/> Preliminary	<input type="checkbox"/> Issued for Design/Information
<input checked="" type="checkbox"/> Issued for Planning Approval	<input type="checkbox"/> Issued for Tender
<input type="checkbox"/> Issued for Construction	<input type="checkbox"/> As Built

Drawing sheet size - A1

Copyright Reserved ©