

Notes


These drawings are strictly copyright and are not to be used, printed or copied in any form unless expressly permitted by ASB Architects Any scale indicated on the drawing is only correct provided the drawing is printed at the original 'Sheet Size' field. This is typically A1 or A3, printed without reduction, @ 1:100%

This drawing may include information shown in colour as indicated by the 'Printing' field. If the drawing is received incorrectly please refer to the sender or Architects.


Do not scale from these drawings. Refer to figured dimensions only and, where these are missing or cannot be inferred from the given dimensions, refer to the Architect for instruction.

Inform the Architect as soon as possible of any discrepancies found on site.


This drawing is to be read in conjunction with the structural engineers' drawings, all other layout and detail drawings together with the Schedule of Works and Specification.

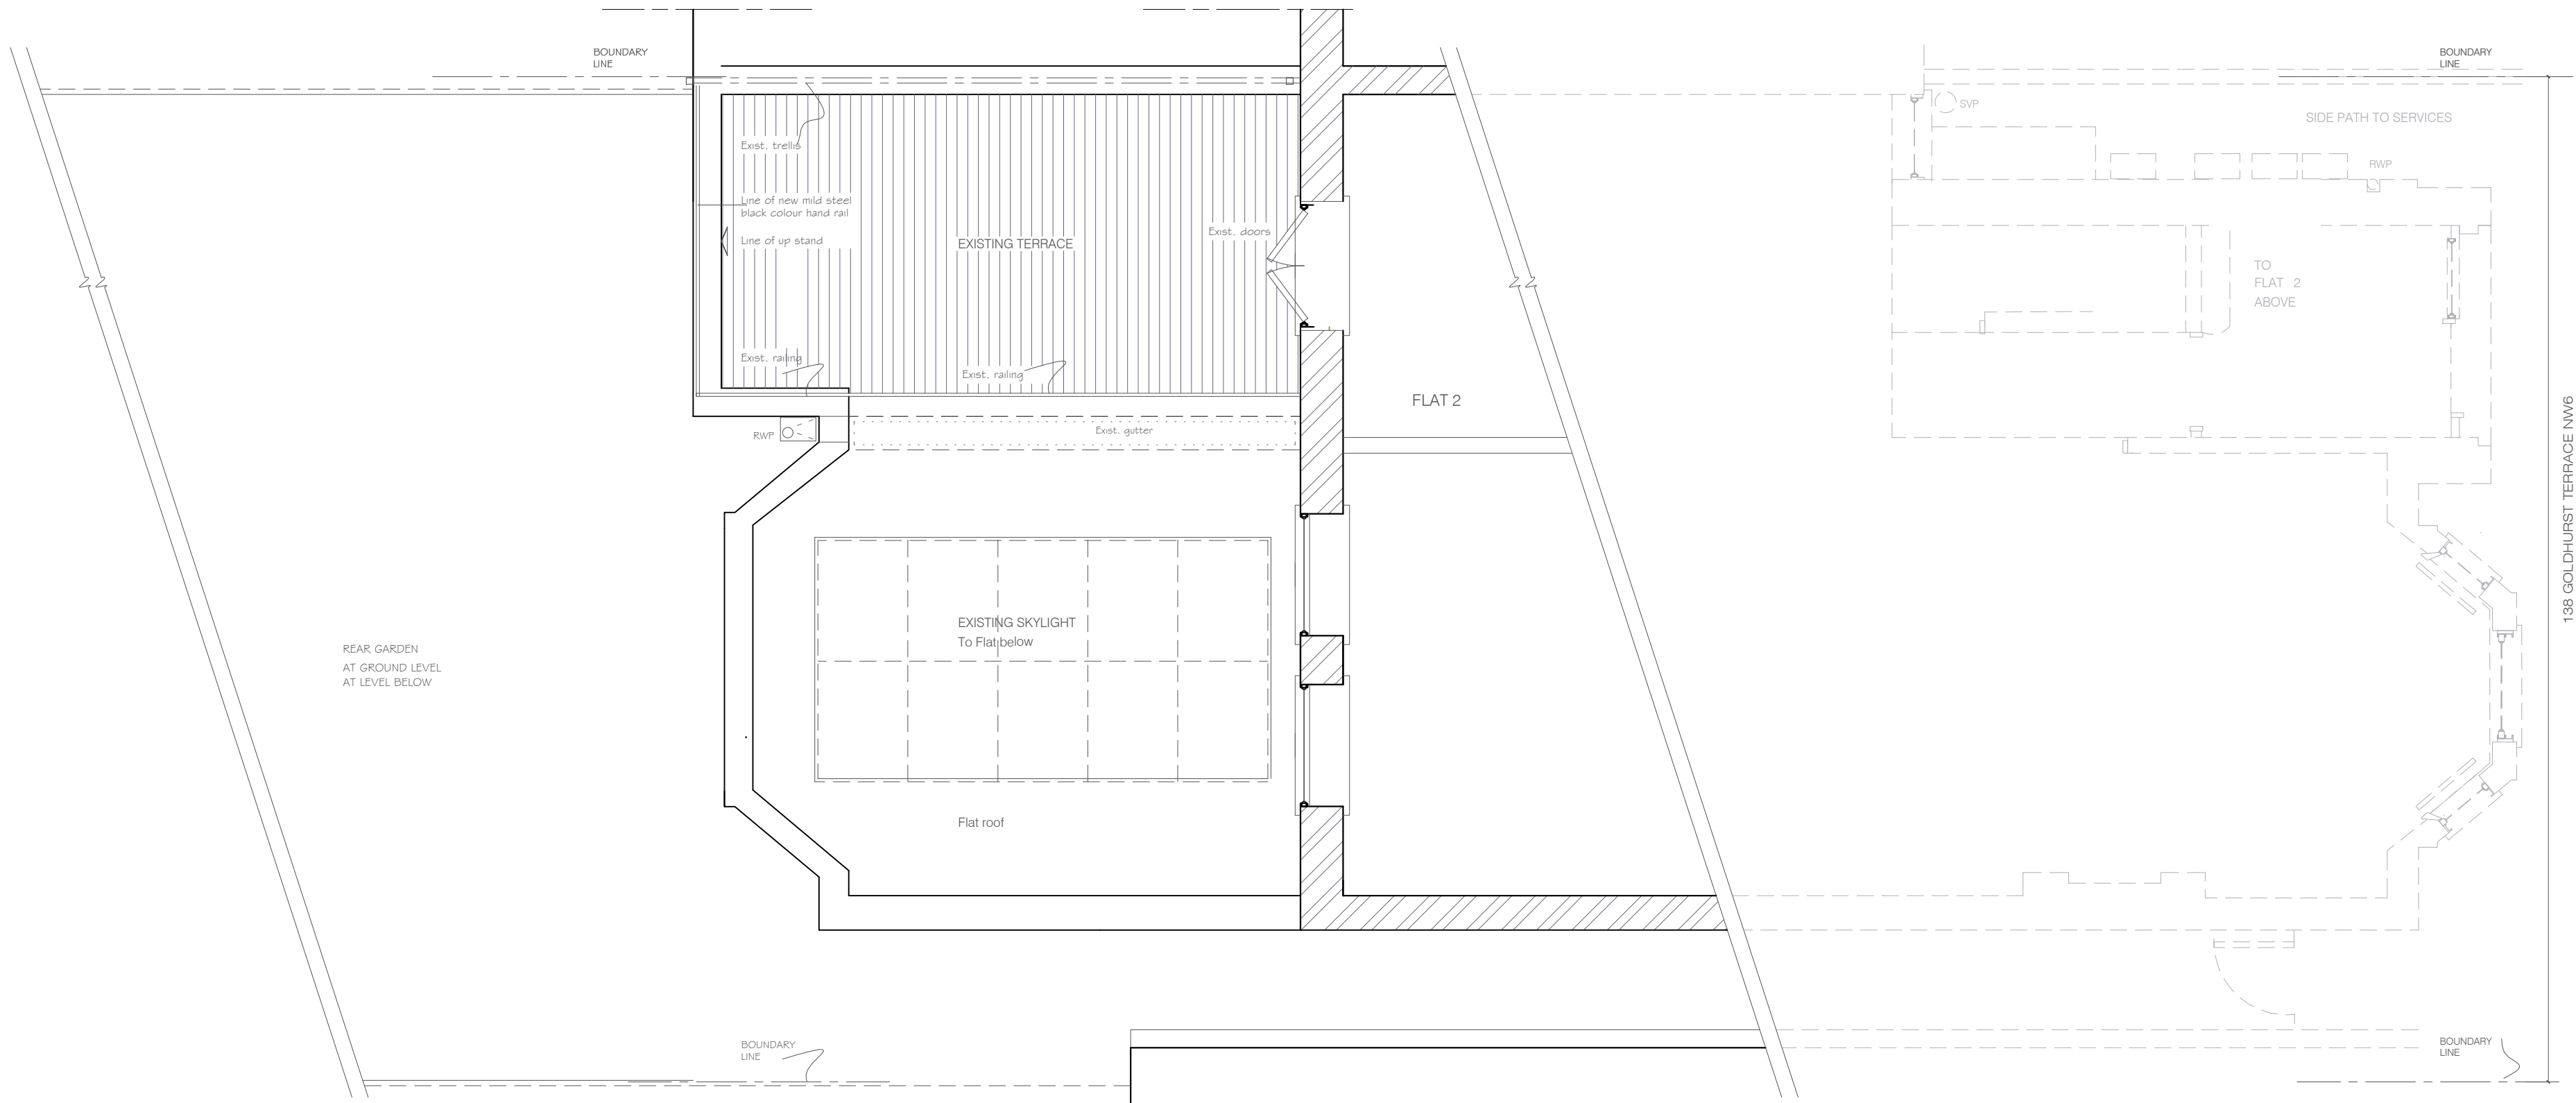

AS BUILT 1st FLOOR REAR TERRACE
AS BUILT REAR ROOF TERRACE

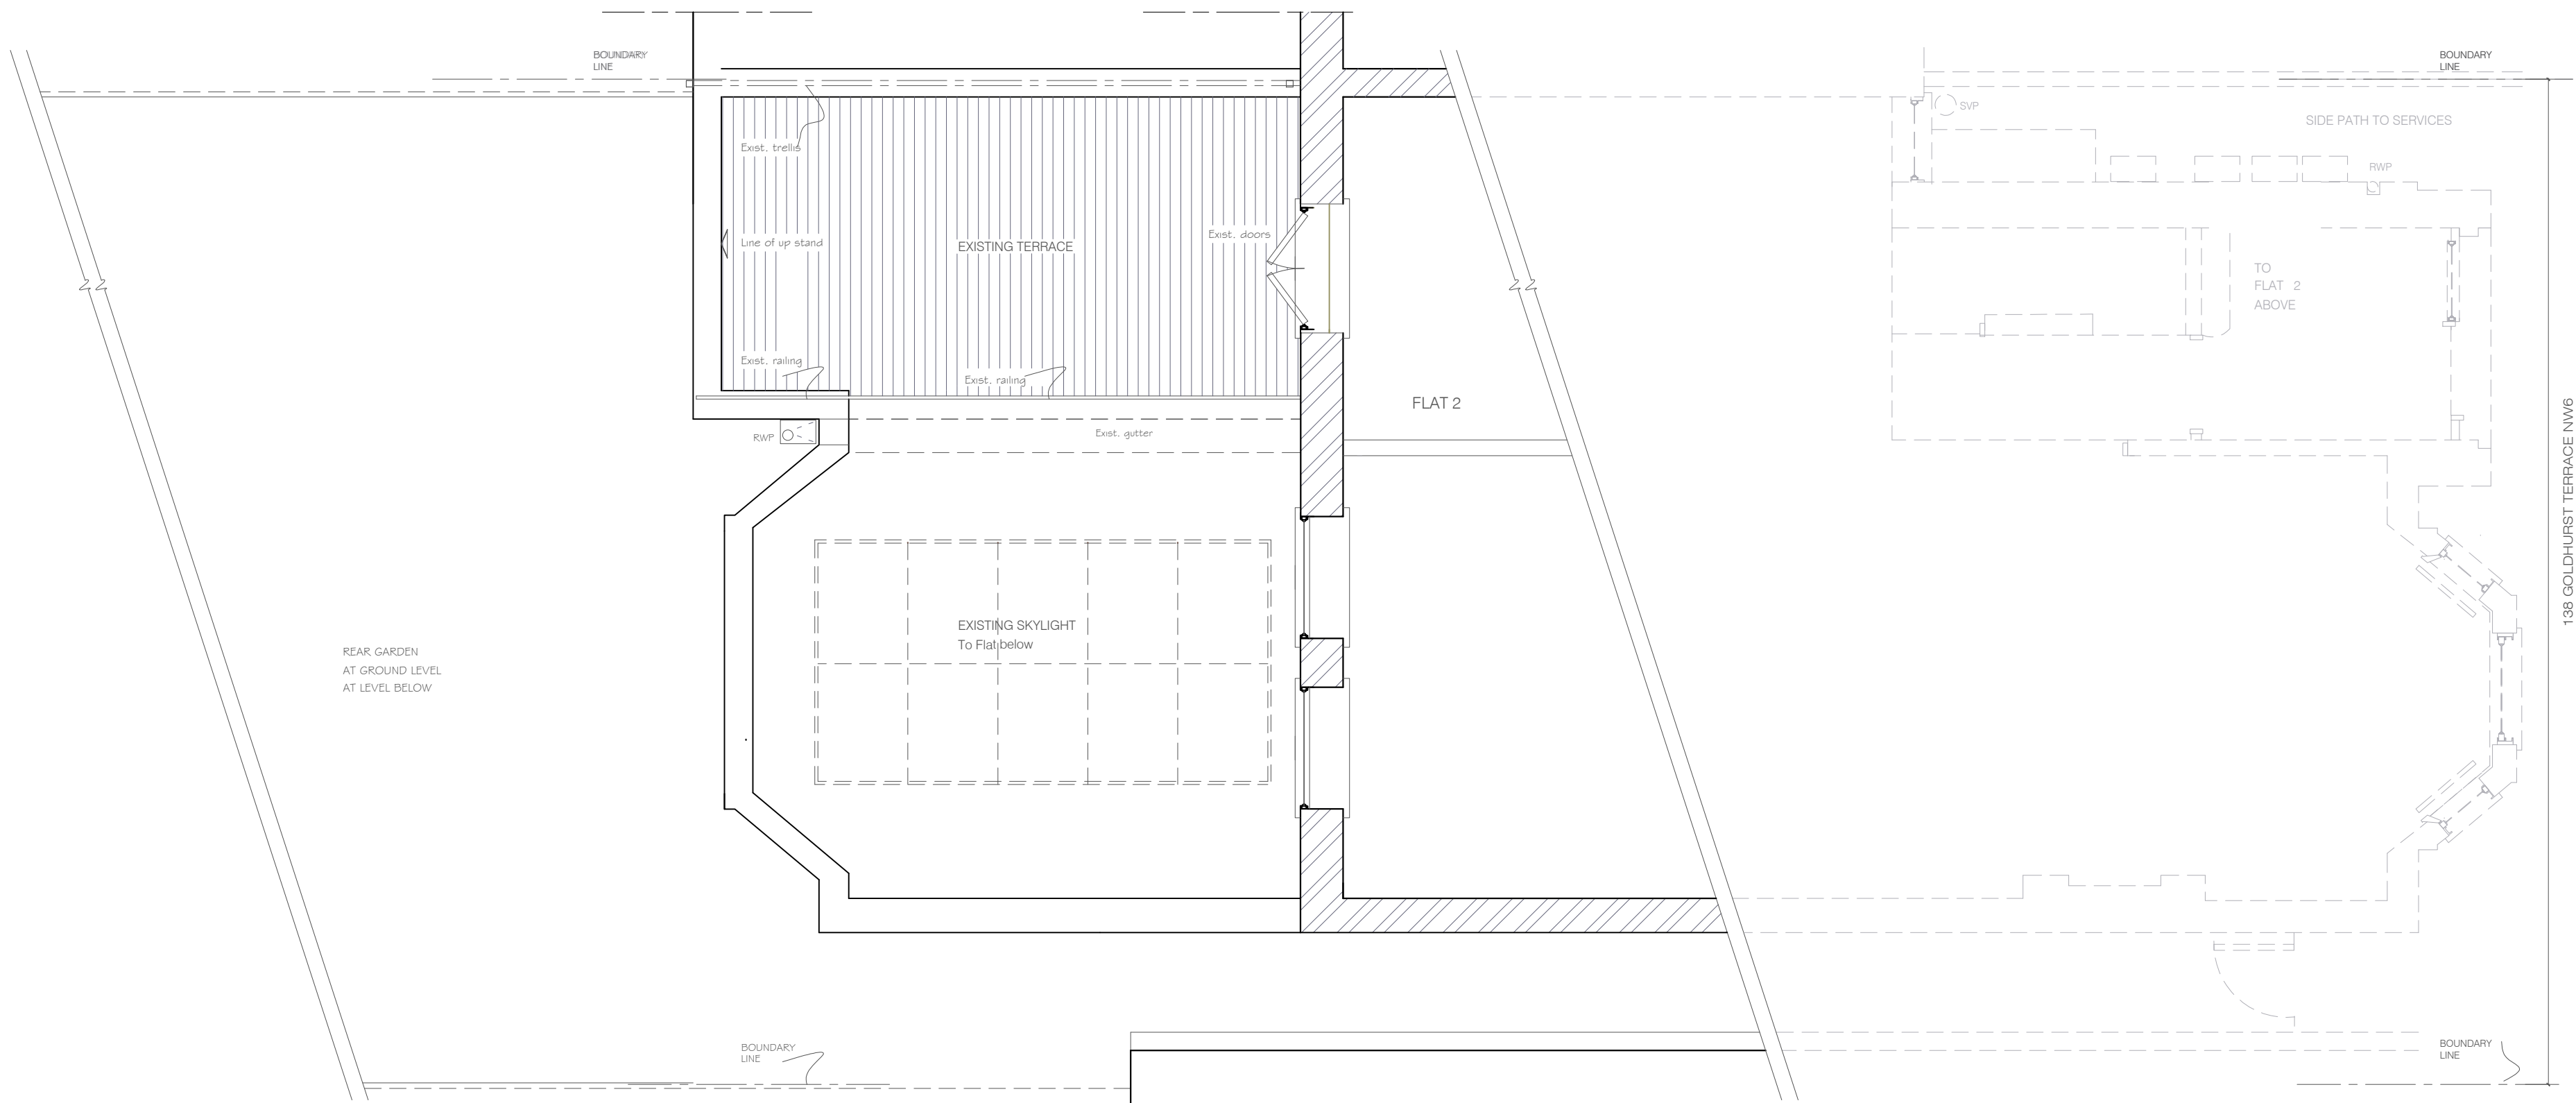

PRE BUILT 1st FLOOR REAR TERRACE
PRE BUILT REAR ROOF TERRACE

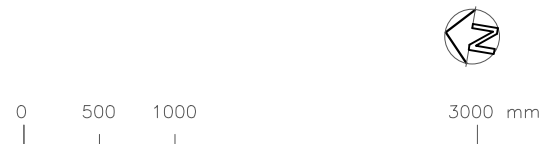

REVISION

16 JANUARY 2017
PLANNING SET
A - 24 JANUARY 2017
DRAWING AMENDED

Rev.	Date	Notes
ASB ARCHITECTS		
215 West End Lane West Hampstead London NW6 1XJ T: 020 7431 5221 F: 02074315114 E: amos@asbarchitects.com		
Project	138 GOLDHURST TERRACE LONDON NW6 3HR	
Drawing	PRE BUILT AND AS BUILT 1st FLOOR REAR TERRACE RAILING	
Dwg status	-	Date © JANUARY 2107
Project Ref	324 / A1	Printing -
SCALE	1: 50	Sheet size A1
Drg No	06	Rev. A