

Interiors Limited and must not be copied or shown to a third party without prior consent.

Whilst the utmost care is taken to ensure the accuracy of the data and information contained herein, the user acknowledges that the user assumes full responsibility for any reliance, expense or loss which may in any degree be attributed to the use or adoption of such data and design details.




- F.E** Fire Exit sign with Emergency Lighting
- SD** Smoke Detector
- BD** Breakglass call point
- FS** Fire sounder/ Free Bell
- FB** Flashing Beacon

FINISHES LEGEND

- CEILING WALLS**
- A** Paint - Dulux 52 B9 15/ 410
- B** Diamond Matt Emulsion
- C** Paint - Dulux 77B5 57/ 234
- D** Diamond Matt Emulsion
- E** Paint - Dulux 40Y 60/ 103
- F** Diamond Matt Emulsion
- G** Paint - Dulux 30B5 33/ 269
- H** Diamond Matt Emulsion

- WALL WALL FINISH**
- A** Paint - Dulux Brilliant White
- B** Diamond Matt Emulsion
- C** Tiles wall finish -
- D** Paint - Johnsons Brilliant White
- E** Acrylic Eggshell
- F** 118 - Plasterboard Ceiling
- G** Paint - MacPhersons
- H** Eclipse Brilliant White

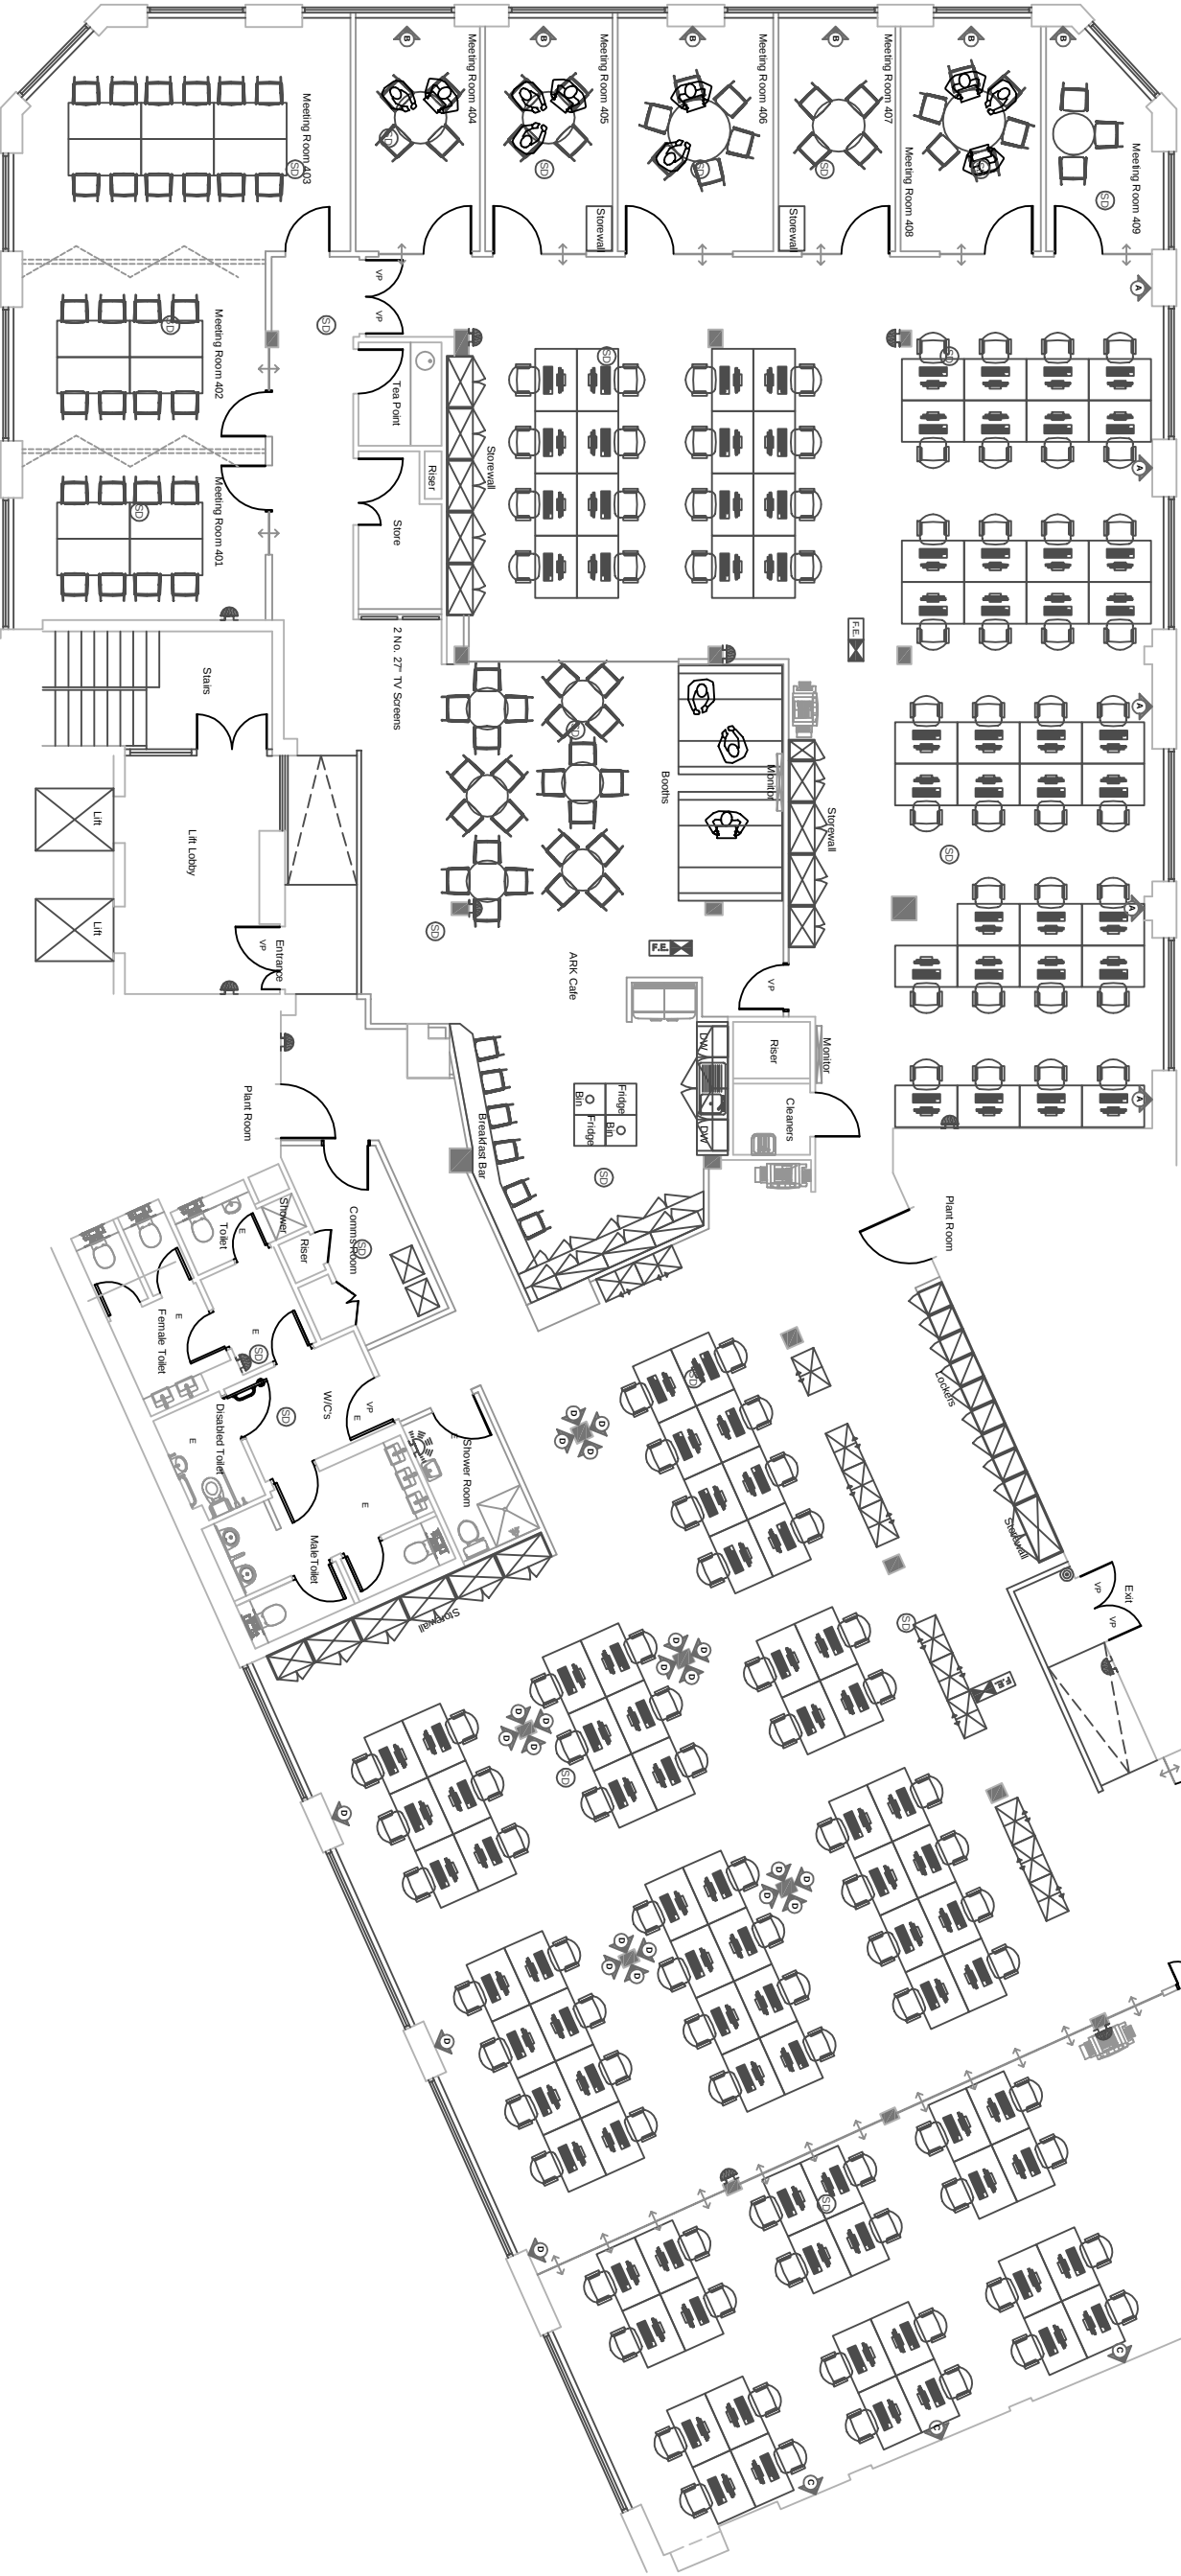

Workspace Interiors Limited
Unit 1, The Old Mill, Church
Farm, Wotton, Surrey, Surrey
GU24 0JY
Tel: 01753 780000
www.workspaceinteriors.co.uk

Client: ABSOLUTE RETURN FOR KIDS (ARK)

Site address: 4TH FLOOR, HOLBORN, LONDON, WC2B 6TD.

Drawing: AS BUILT GENERAL ARRANGEMENT

Drawn by:	K. TAYLOR	Scale:	1:50 @ A0
Project ref:	AS BUILT	Drawing ref:	14654/F04/AB
Date:	04/08/14	Revision:	

AS BUILT DRAWING
August 2014