


EXISTING ROOF PLAN
SCALE 1:100

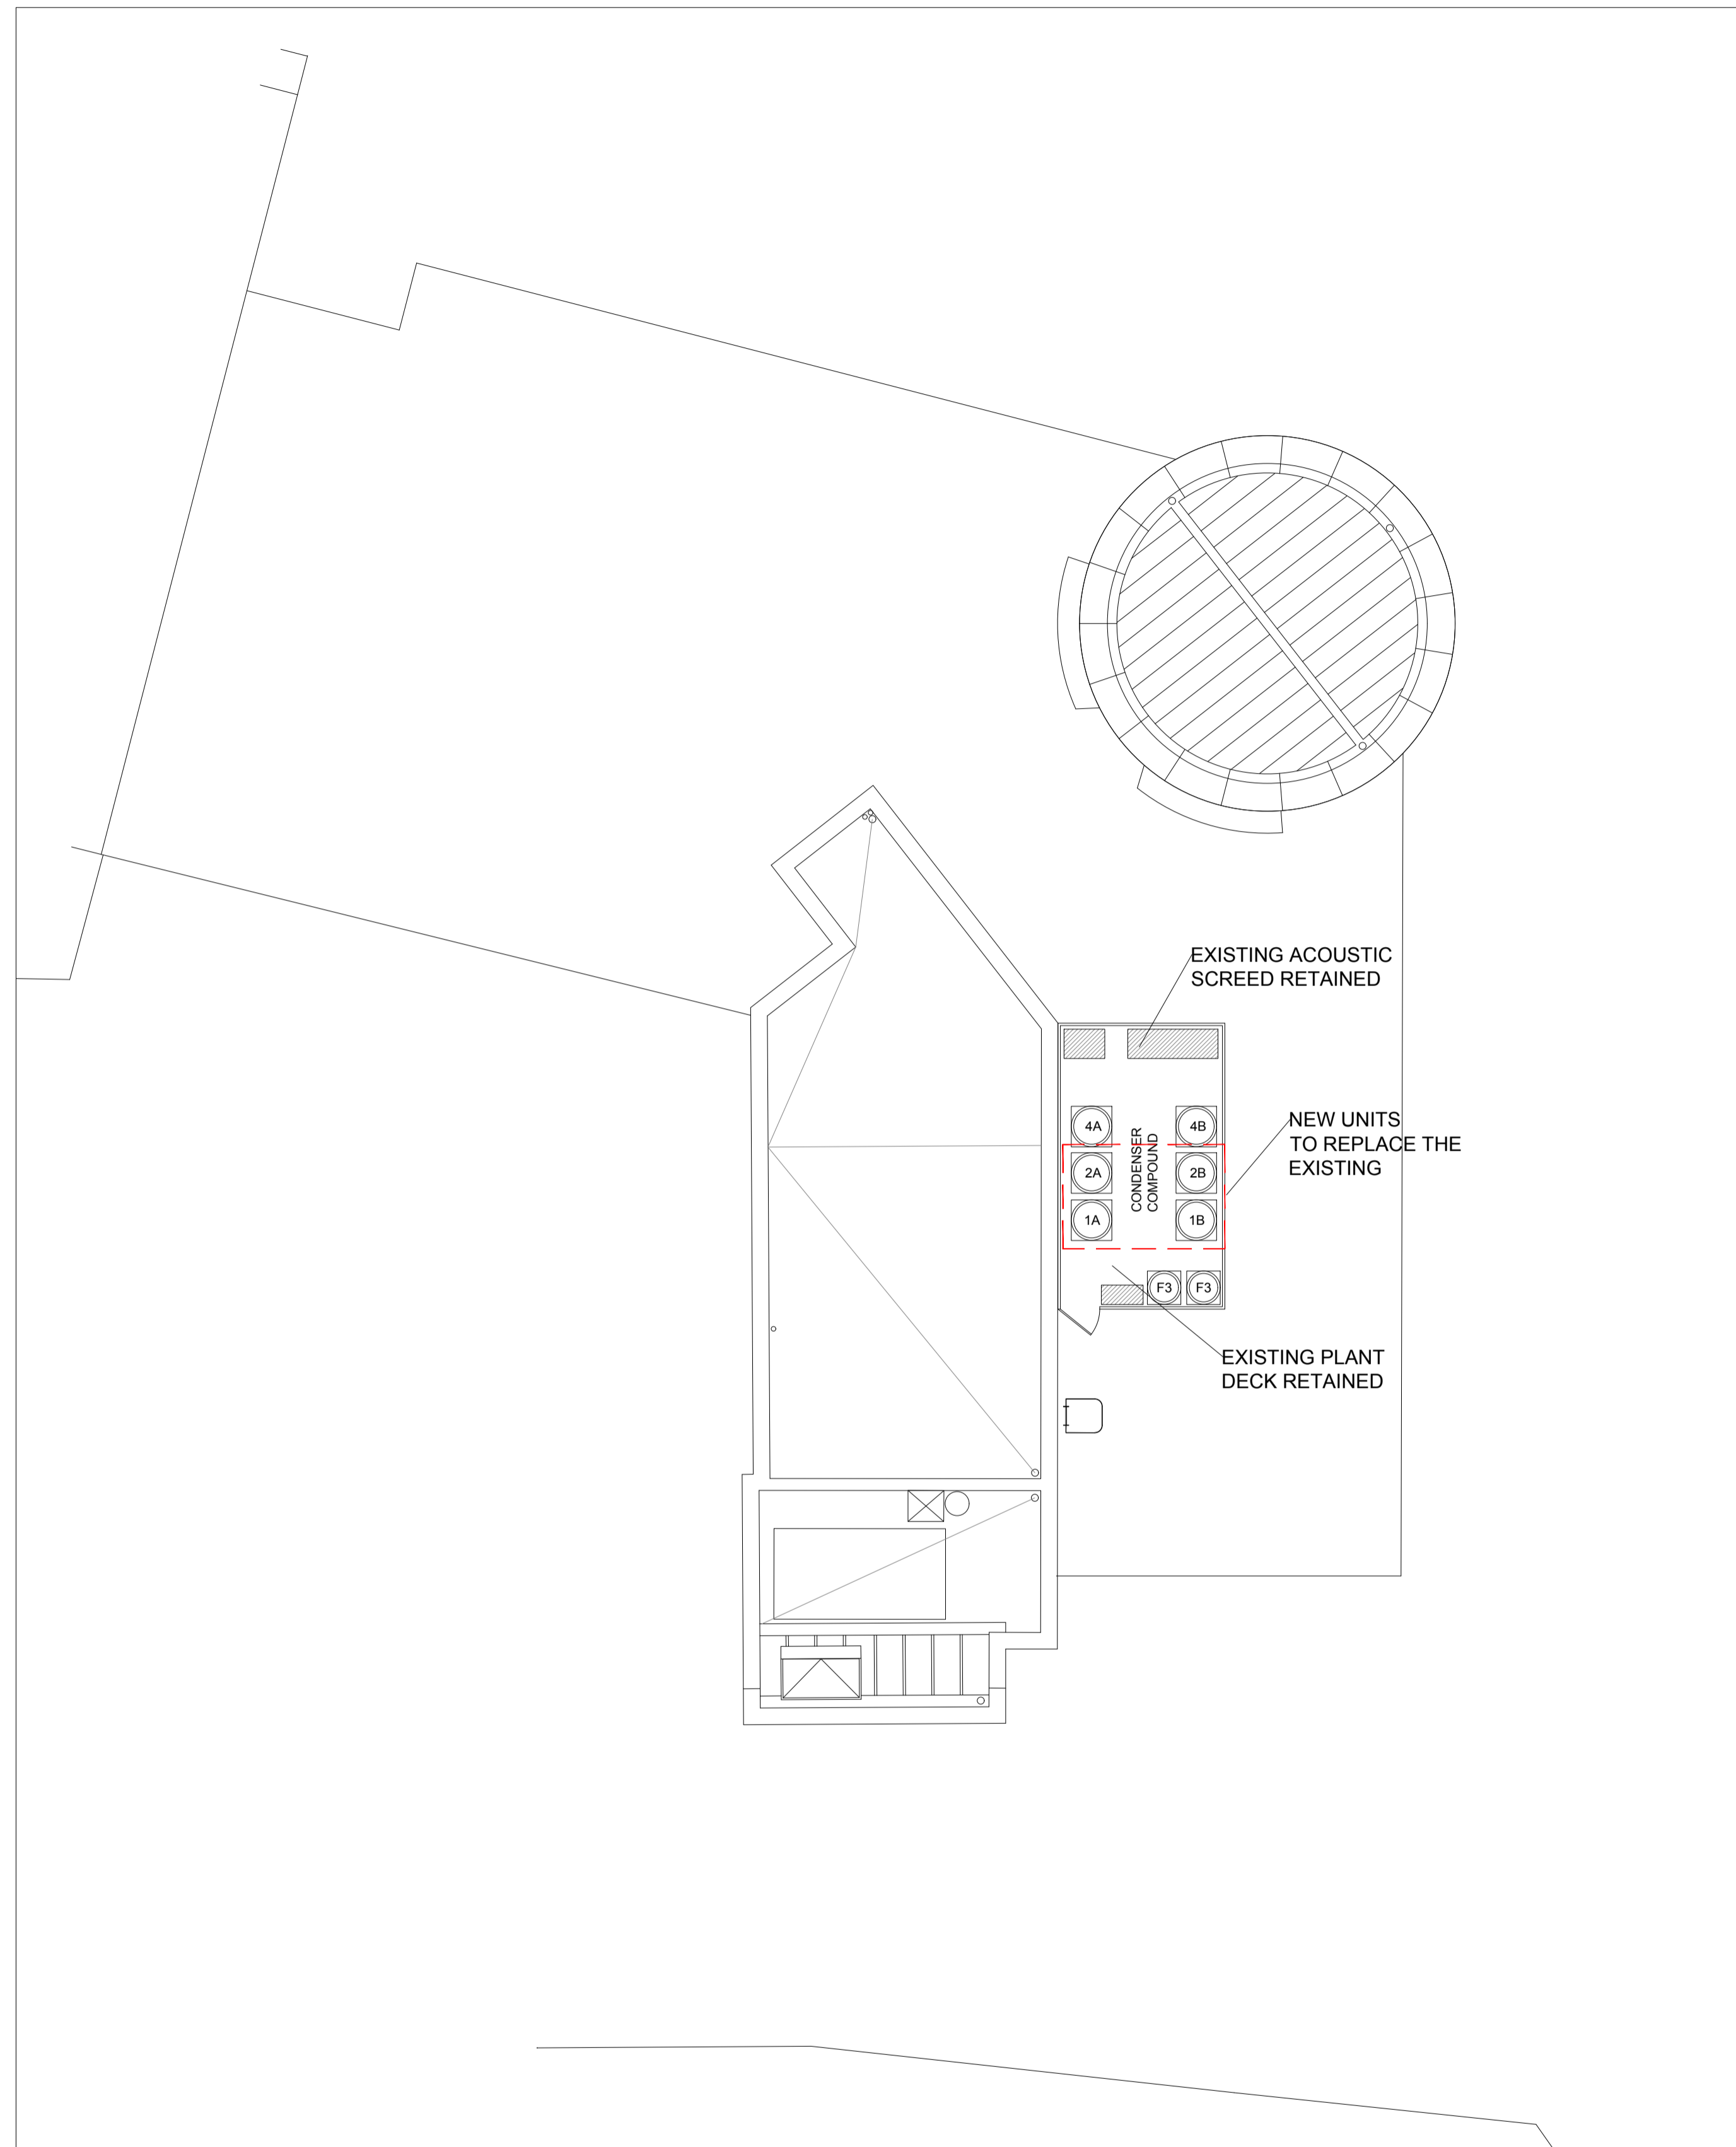

PROPOSED ROOF PLAN
SCALE 1:100

Copyright of this drawing belongs to & is vested in **THIRDWAY INTERIORS** and may not be reproduced or without written consent by **THIRDWAY INTERIORS**. Any persons, firm or company unlawfully reproducing or distributing this drawing or in any way infringing the copyright therein will be prosecuted.

This document is the property of **THIRDWAY INTERIORS**. Copyright is reserved by them, and the drawing is issued on the condition that it is not copied, reproduced or retained by, nor disclosed to any unauthorised person, either wholly or in part, without the consent in writing from **THIRDWAY INTERIORS**.

Note

ALL DIMENSIONS MUST BE CHECKED ON SITE. DO NOT SCALE FROM THIS DRAWING. THIS DRAWING IS FOR DISCUSSION PURPOSES ONLY AND IS SUBJECT TO FIRE OFFICER AND BUILDING REGULATION APPROVALS BEING OBTAINED.

Drawing Approval

Client Signature	
Printed Name	
ThirdWay Signature	
Date	
Specification Ref	

Status

- Preliminary/Info.
- Planning
- Contract
- Construction
- Approval/Comment
- As-Built
- Building Control

Revision Detail

Rev	Detail	By	Date
-----	--------	----	------

PLANNING DRAWING

Client
COLUMBIA THRE ADNEEDLE

Project Title
FARRINGDON POINT
29-35 FARRINGDON ROAD
LONDON
EX1M 3JF

Drawing Title
ROOF PLANS
EXISTING AND PROPOSED
PLANNING APPLICATION

Date: 06.01.17 Drawn By: MS

Scale: 1:100@A1 Rev: C

Drawing No: 13757-ROOF