
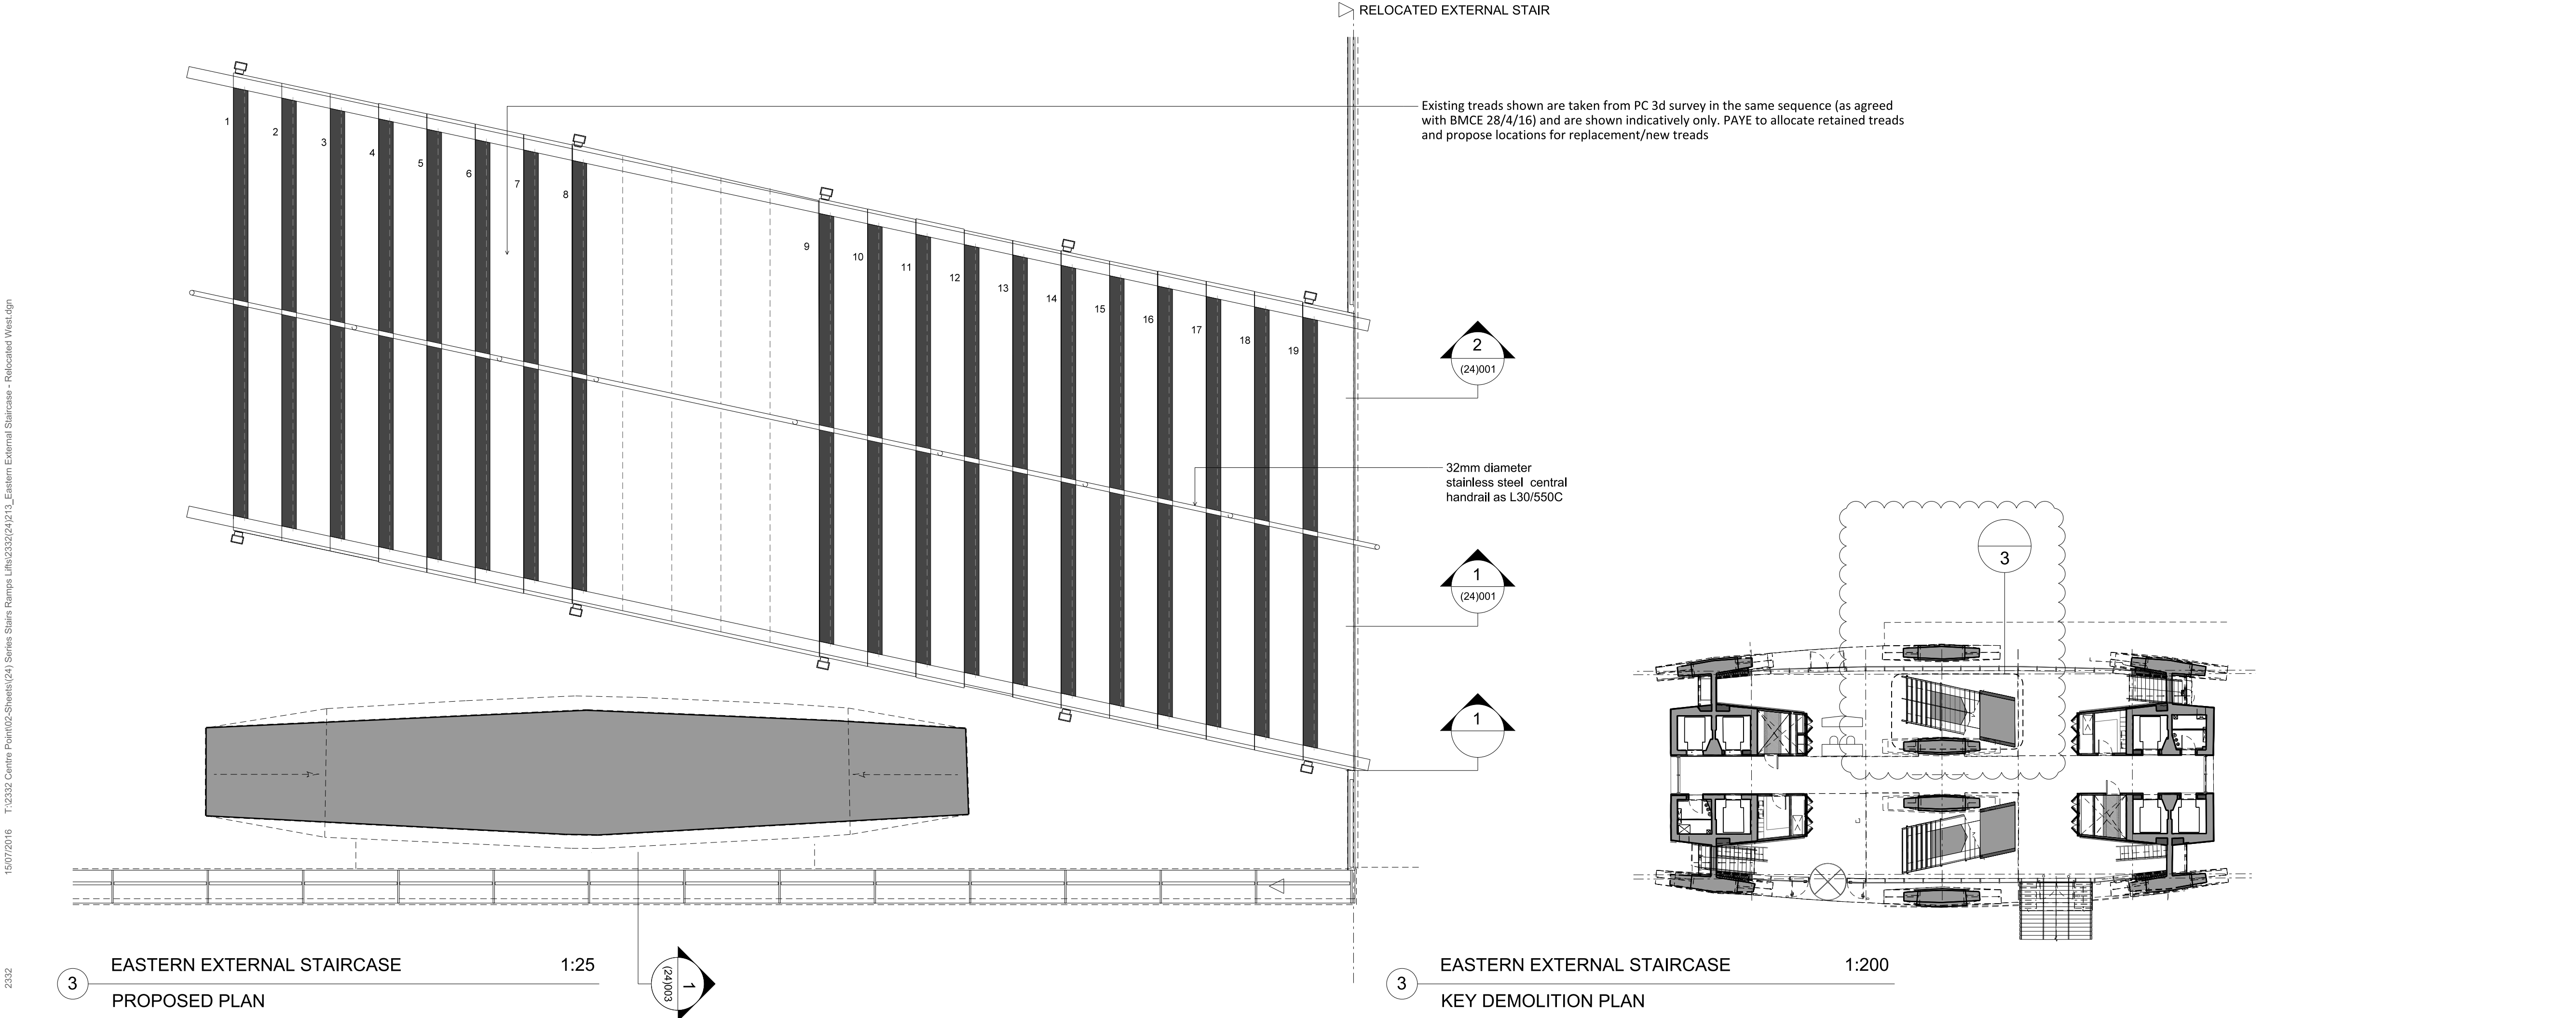


15/07/2016 T:\2332 Centre Point\02-Sheets\24 Series Stairs Ramps Lifts\2332\24\213\_Eastern External Staircase - Relocated West.dgn 2332 Conran

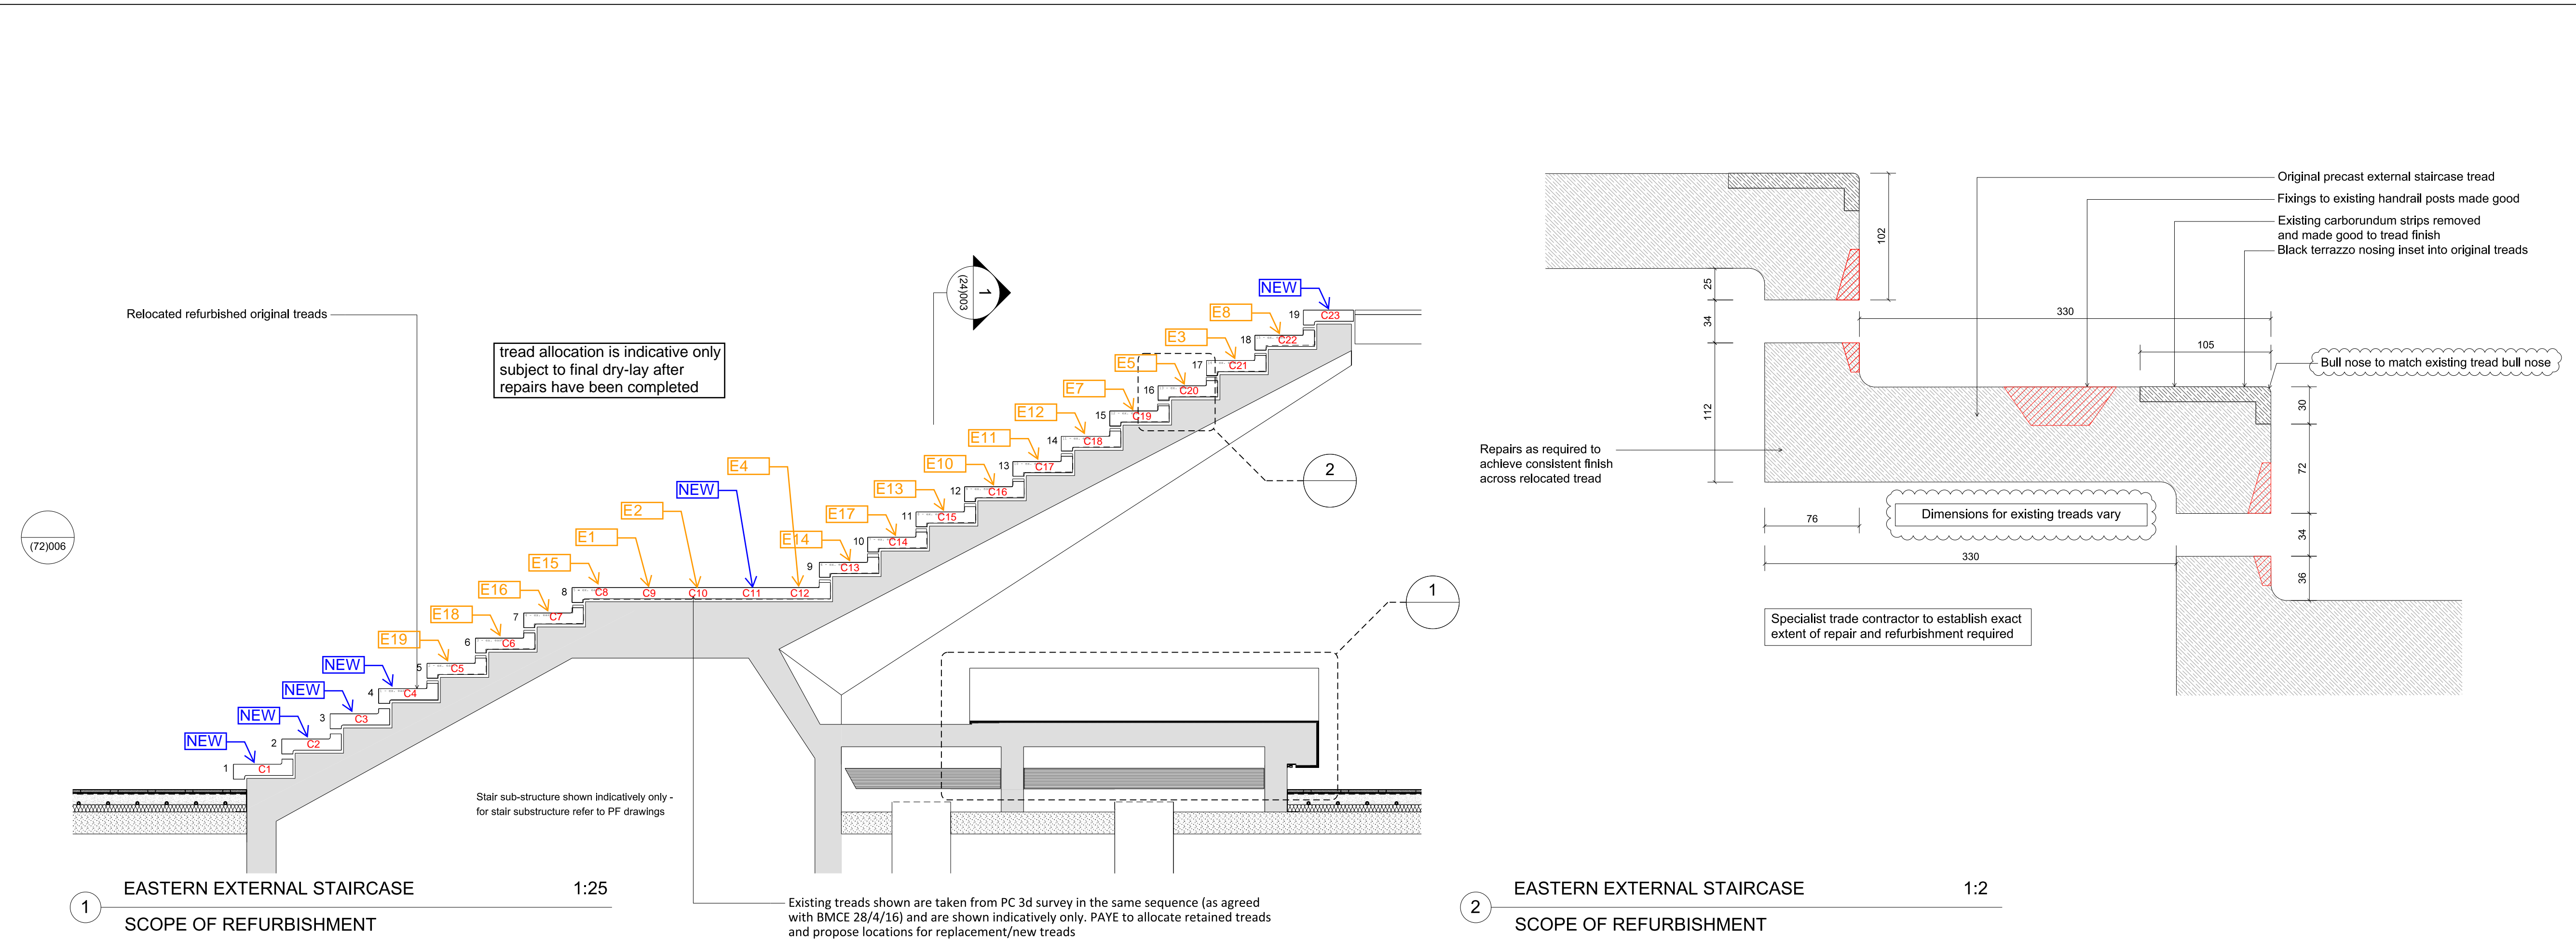

Notes

- REPAIR TO EXISTING TREADS
  - NEW TREADS TO MATCH FINISH AND  
PROFILE OF ORIGINAL
  - RELOCATED REFURBISHED  
ORIGINAL TREADS
- C&P recommend that top treads are new (replaced) to ensure  
that upper tread is consistent and parallel to slab (at 10mm). C&P  
recommend that 1st step is new (replaced) tread to maintain  
offset dim shown in C&P drawings.

**MULTIPLEX**  
Title: NUMBERING MARK UP OF EASTERN  
EXTERNAL STAIRCASE  
Drawing number: 2332-24-213-01  
Date: Aug 2016