



1 WESTERN EXTERNAL STAIRCASE 1:25
SCOPE OF REFURBISHMENT

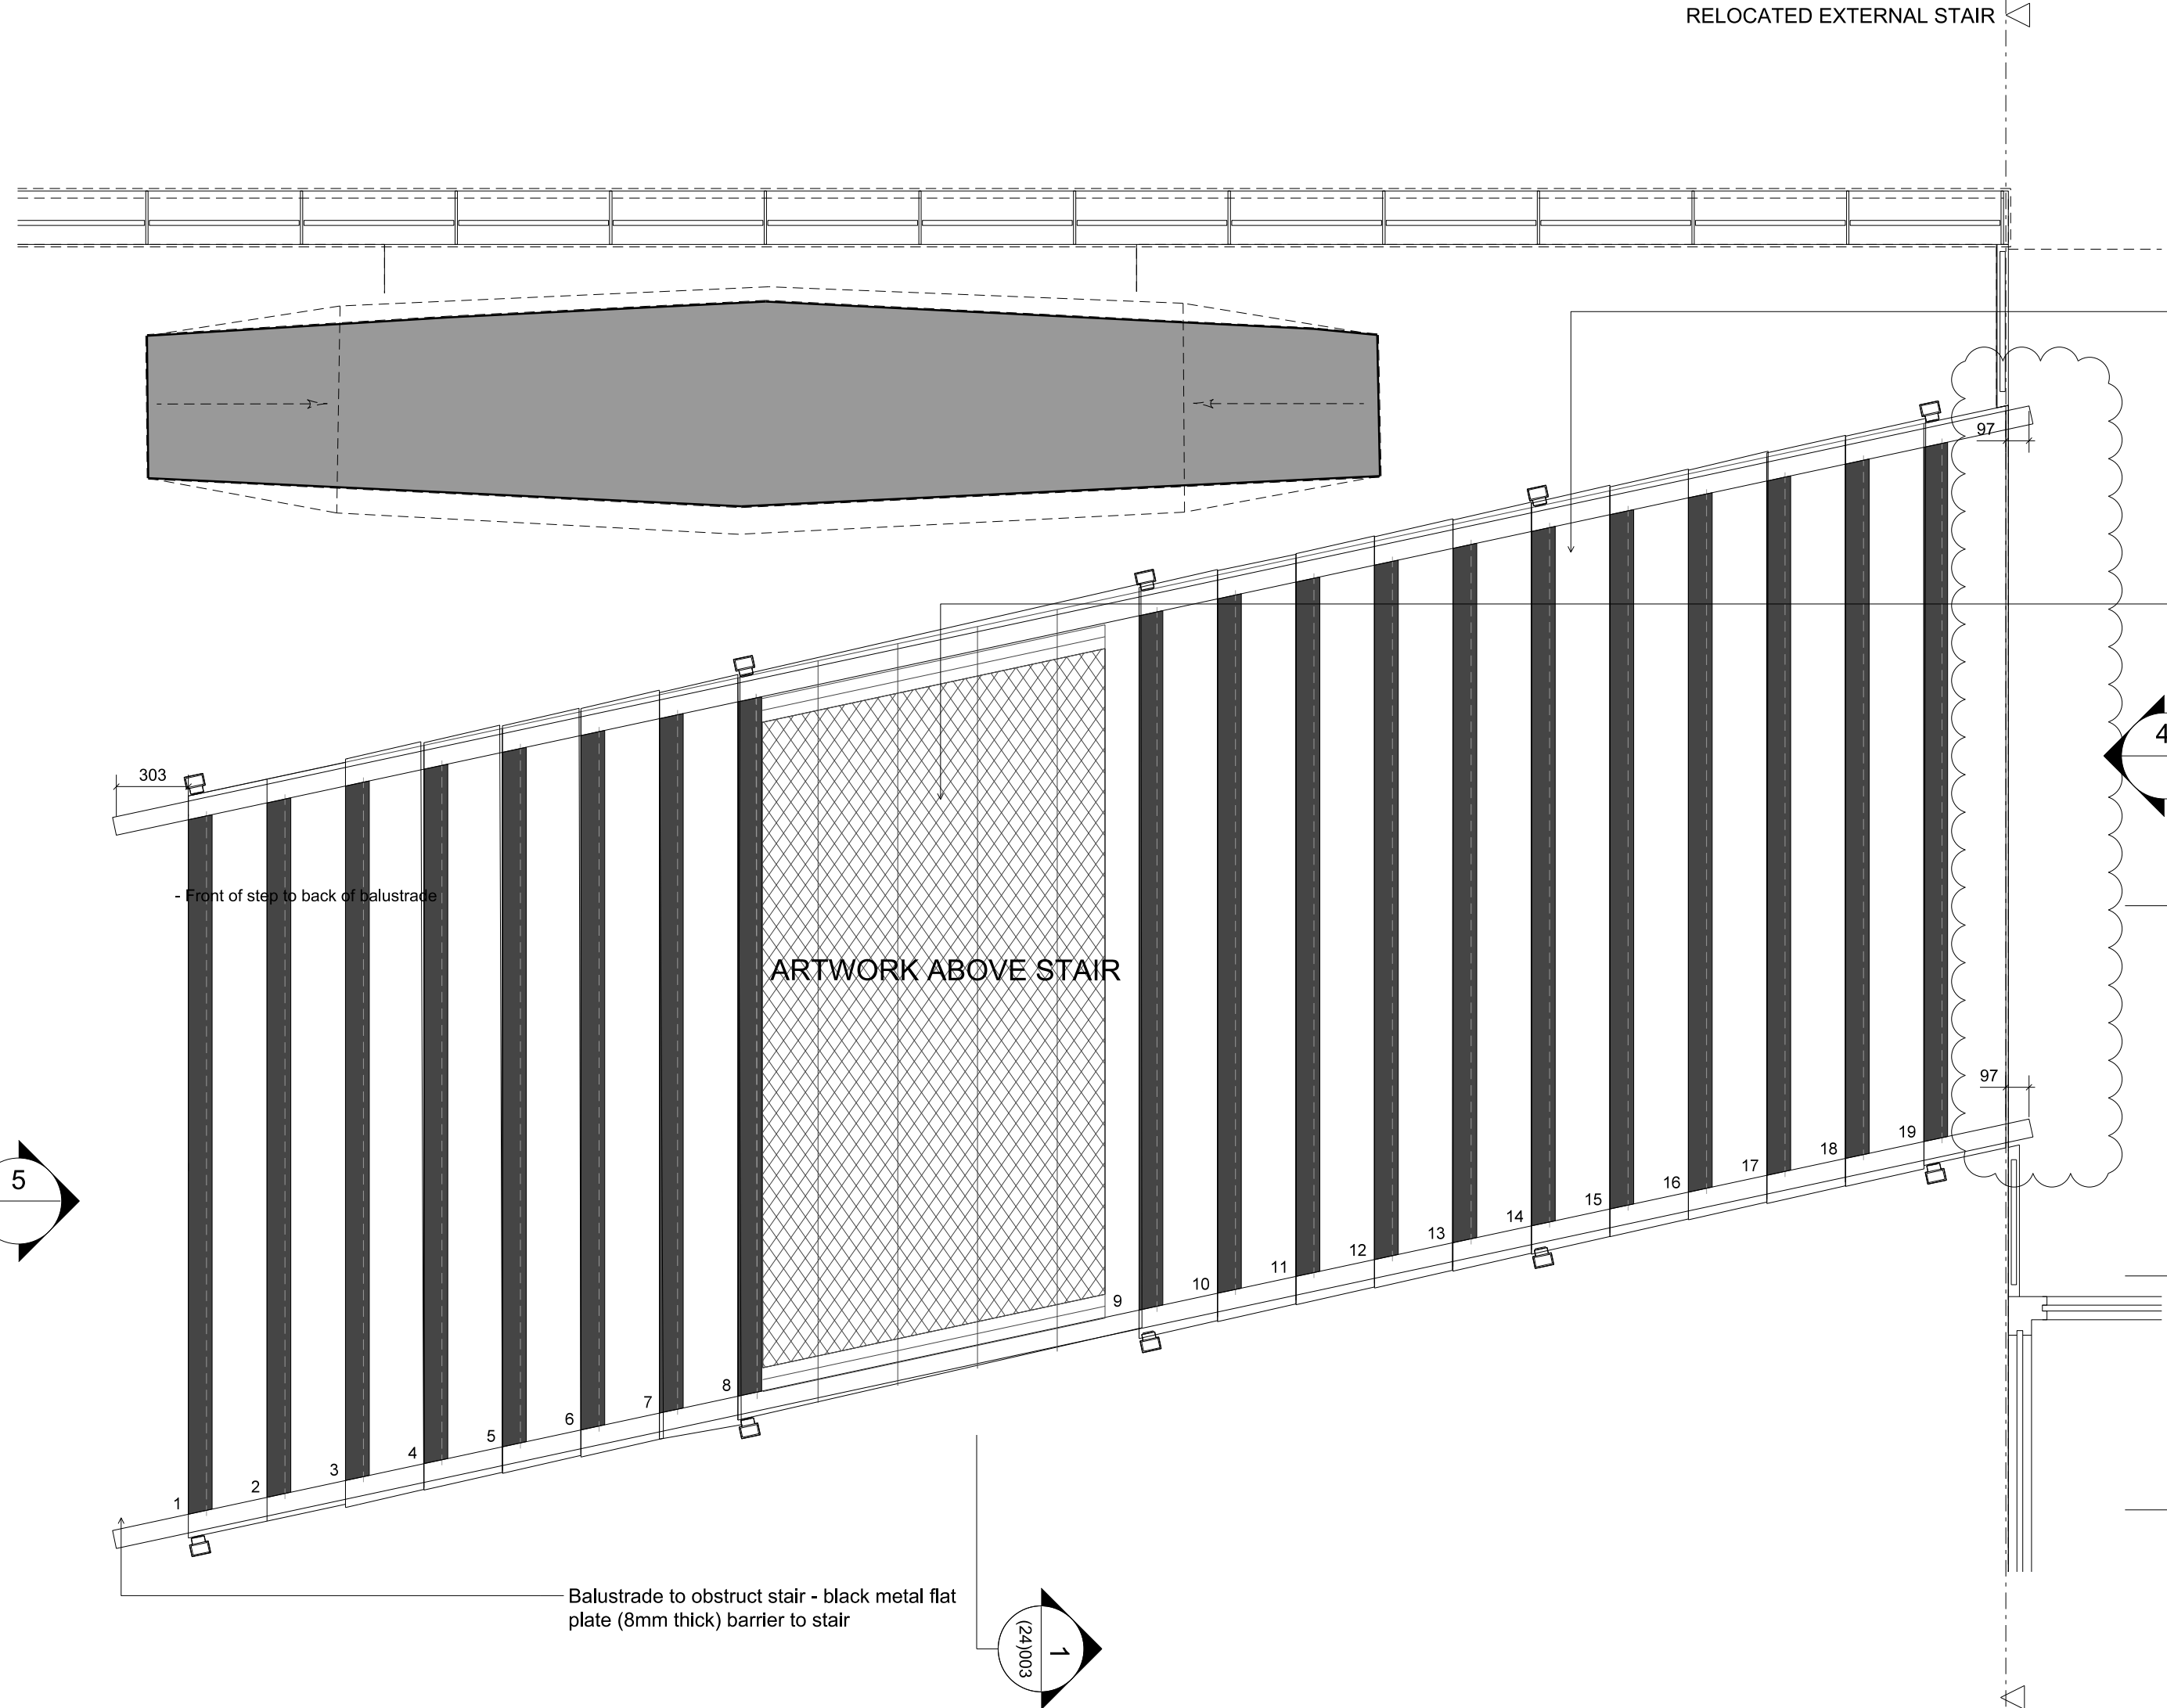

3 WESTERN EXTERNAL STAIRCASE 1:25
PROPOSED PLAN

Existing treads shown are taken from PC 3d survey in the same sequence (as agreed with BMCE 28/4/16) and are shown indicatively only. PAYE to allocate retained treads and propose locations for replacement/new treads

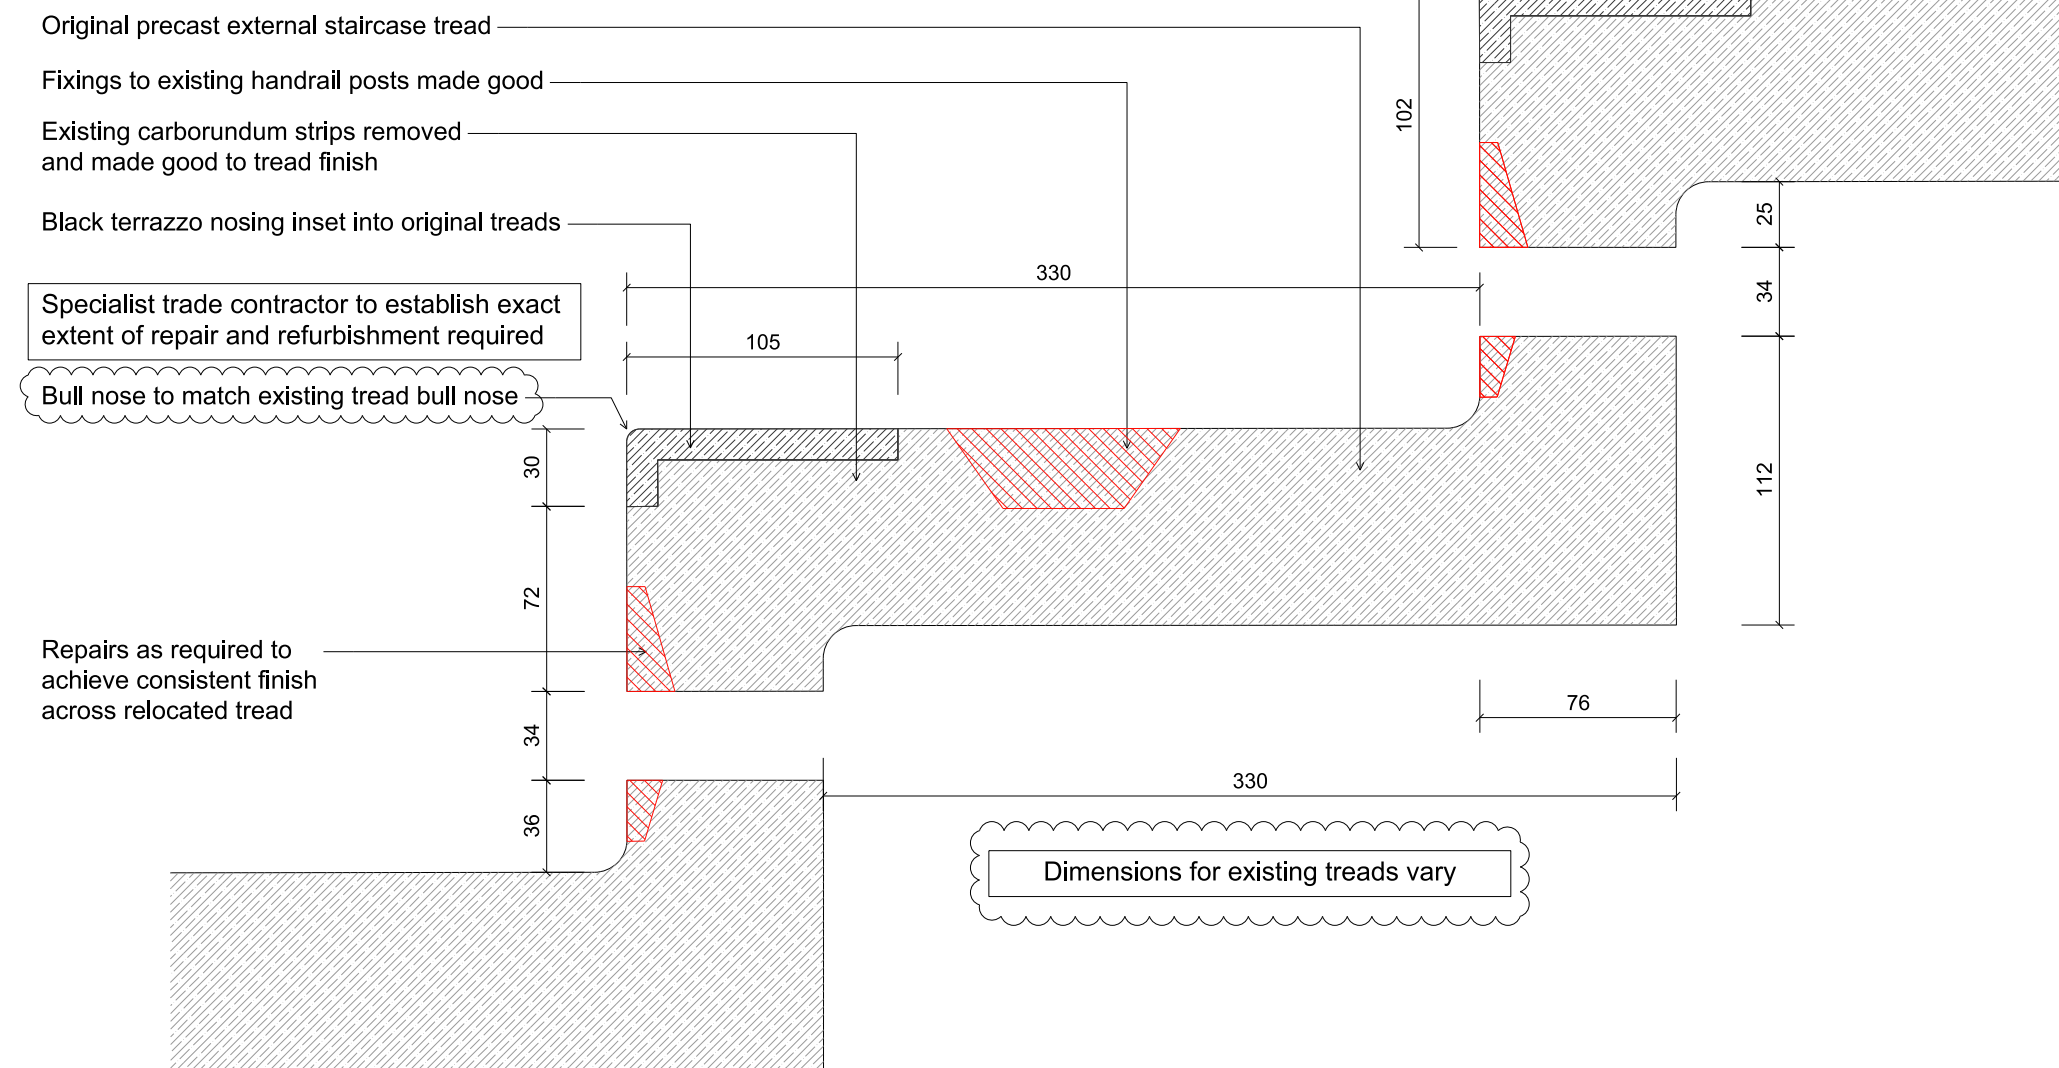

2 WESTERN EXTERNAL STAIRCASE 1:2
SCOPE OF REFURBISHMENT

Existing treads shown are taken from PC 3d survey in the same sequence (as agreed with BMCE 28/4/16) and are shown indicatively only. Treads shown do not reflect the location or quantity to be re-used.

Existing engraved pattern to landing slabs retained and made good to comply with BS 8300, holes to be not greater than 13mm wide

1 (24/001)

1 (24/001)

3 WESTERN EXTERNAL STAIRCASE 1:200
KEY DEMOLITION PLAN

Notes

REPAIR TO EXISTING TREADS

NEW TREADS TO MATCH FINISH AND PROFILE OF ORIGINAL

RELOCATED REFURBISHED ORIGINAL TREADS

C&P recommend that top treads are new (replaced) to ensure that upper tread is consistent and parallel to slab (at 10mm). C&P recommend that 1st step is new (replaced) tread to maintain offset dim shown in C&P drawings.

MULTIPLEX

Title: NUMBERING MARK UP OF WESTERN EXTERNAL STAIRCASE
Drawing number: 2332-24-211-01
Date: Dec 2016