



PREVIOUSLY APPROVED
LIGHTWELL CONFIGURATION

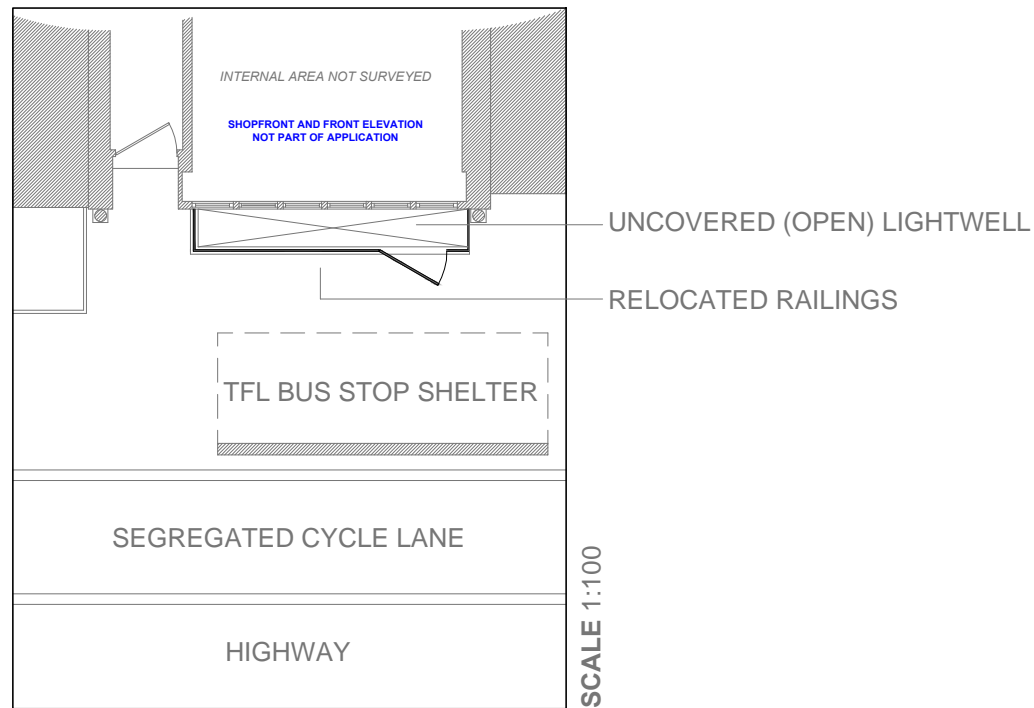

EXISTING (AS BUILT)
LIGHTWELL CONFIGURATION

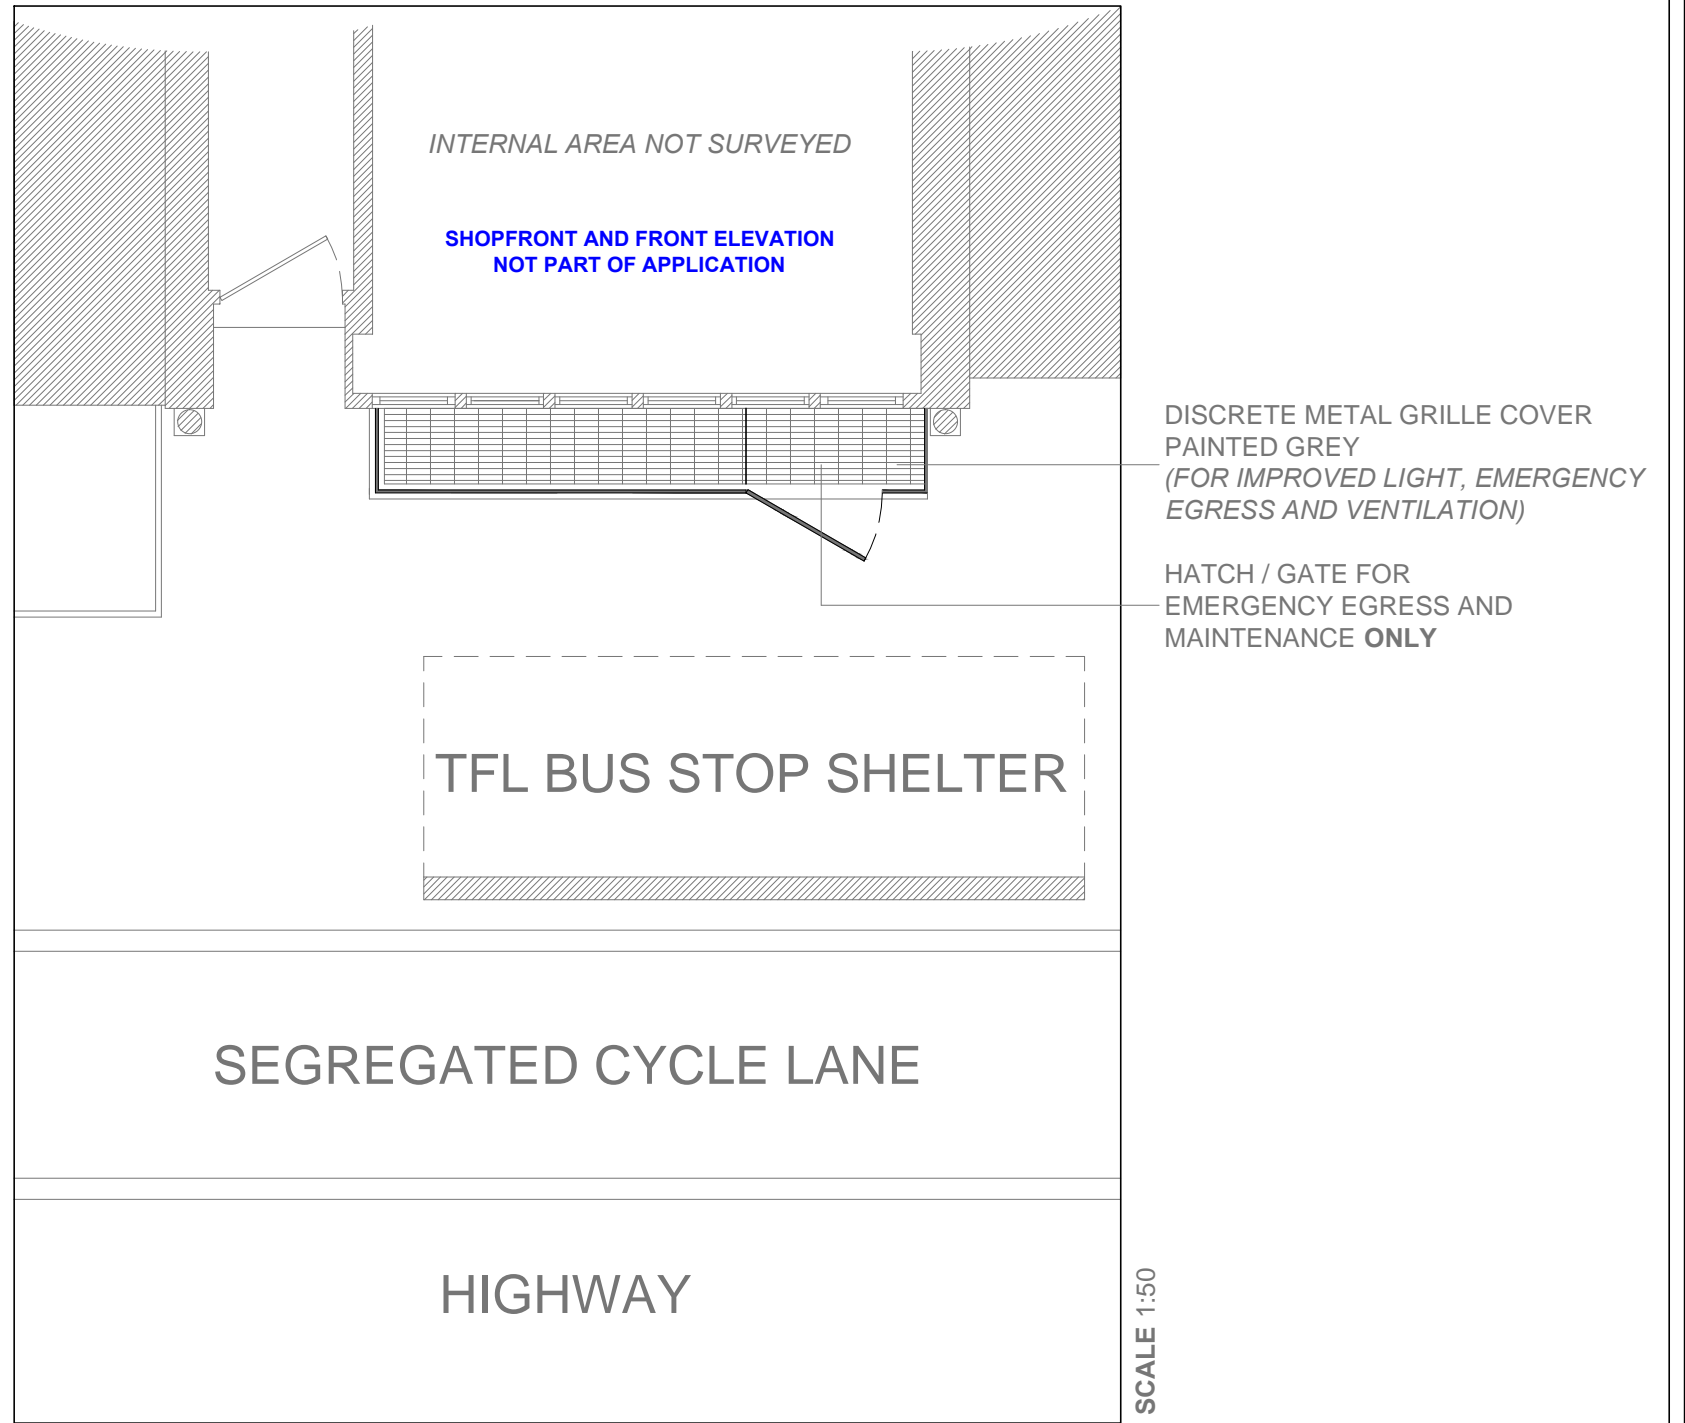

PROPOSED
LIGHTWELL CONFIGURATION

GROUND FLOOR PLAN

Revision notes:		
Rev:	Date:	Notes:
A	20.01.2017	ANNOTATION CHANGES (SHOPFRONT / FRONT ELEVATION NOT PART OF APPLICATION)

Drawn by: GC
Client: Ganeshwaran Velautham 40 Copse Wood Way, London HA6 2UA

Project: Flat 1, 245 Royal College Street, London NW1 9LT Full Planning Application Ref: PP-05241164
Drawing Title: Existing and Proposed Ground Floor Plan DWG-03

Date: 21 June 2016
Scale @ A3: as indicated
Revision: A

BONNYSTREET PLANNING LIMITED

WWW.TOWNPLANNING.LONDON

0m (1:100) 1m 2m 3m 4m 5m

0m (1:50) 1m

2m 3m 4m 5m